


LEGEND

NO	SIZE	BOTANICAL NAME	COMMON NAME
1	BULB	AGAPANTHUS	
2	"	CANNA	
3	"	CROCUS	
4	5GAL	EUONYMUS JAPONICA	EVERGREEN EUONYMUS
5	24"BX	FRAXINUS VELUTINA	ARIZONA ASH
6	BULB	GLADIOLUS	
7	5GAL	HEDERA HELIX	ENGLISH IVY
8	FLAT	"	"
9	1GAL	LANTANA MONTEVIDENSIS	
10	24"BX	LIGUSTRUM TEXANUM (THREE TIERED)	TEXAS PRIVET
11	5GAL	MAYONIA AQUIFOLIUM	OREGON GRAPE HOLLY
12	"	M. A. NANA	DWARF OREGON GRAPE HOLLY
13	"	HANDIA DOMESTICA	HEAVENLY BAMBOO
14	"	NERIUM OLEANDER	'PETITE PINK'
15	"	PHOTINIA FRAXER	FRAXER'S PHOTINIA
16	24"BX	PIHUS HALEPENSIS	ALEPPIC PINE
17	30"BX	"	"
18	36"BX	"	"
19	30"BX	QUERCUS ILEX	HOLLY OAK
20	24"BX	RHUS LANCIA	AFRICAN SUMAC
21	1GAL	TRACHELOSPERUM JAGANNIDES	STAR JASMINE

- 1 PLANT ONE POCKET CONSISTING OF ONE EACH OF 1 2 3 4
- 5/12" O/C SCOTCH ROW THROUGHOUT AREA INDICATED
- ALL NEW PLANT MATERIAL SHALL BE OF HIGHEST QUALITY & SHALL BE ARCHITECTURALLY APPROVED PRIOR TO PLANTING
- ALL EXISTING TREES SHALL BE PRUNED AS DIRECTED
- ALL LAWN SHALL BE PLANTED TO KENTUCKY 31 FESCUE 500 - SOD PER CART 12-5-86
- OVERSEED ALL PLANTERS W/LOBULARIA MARITIMA 'CARPET OF SNOW' AS WEED CONTROL

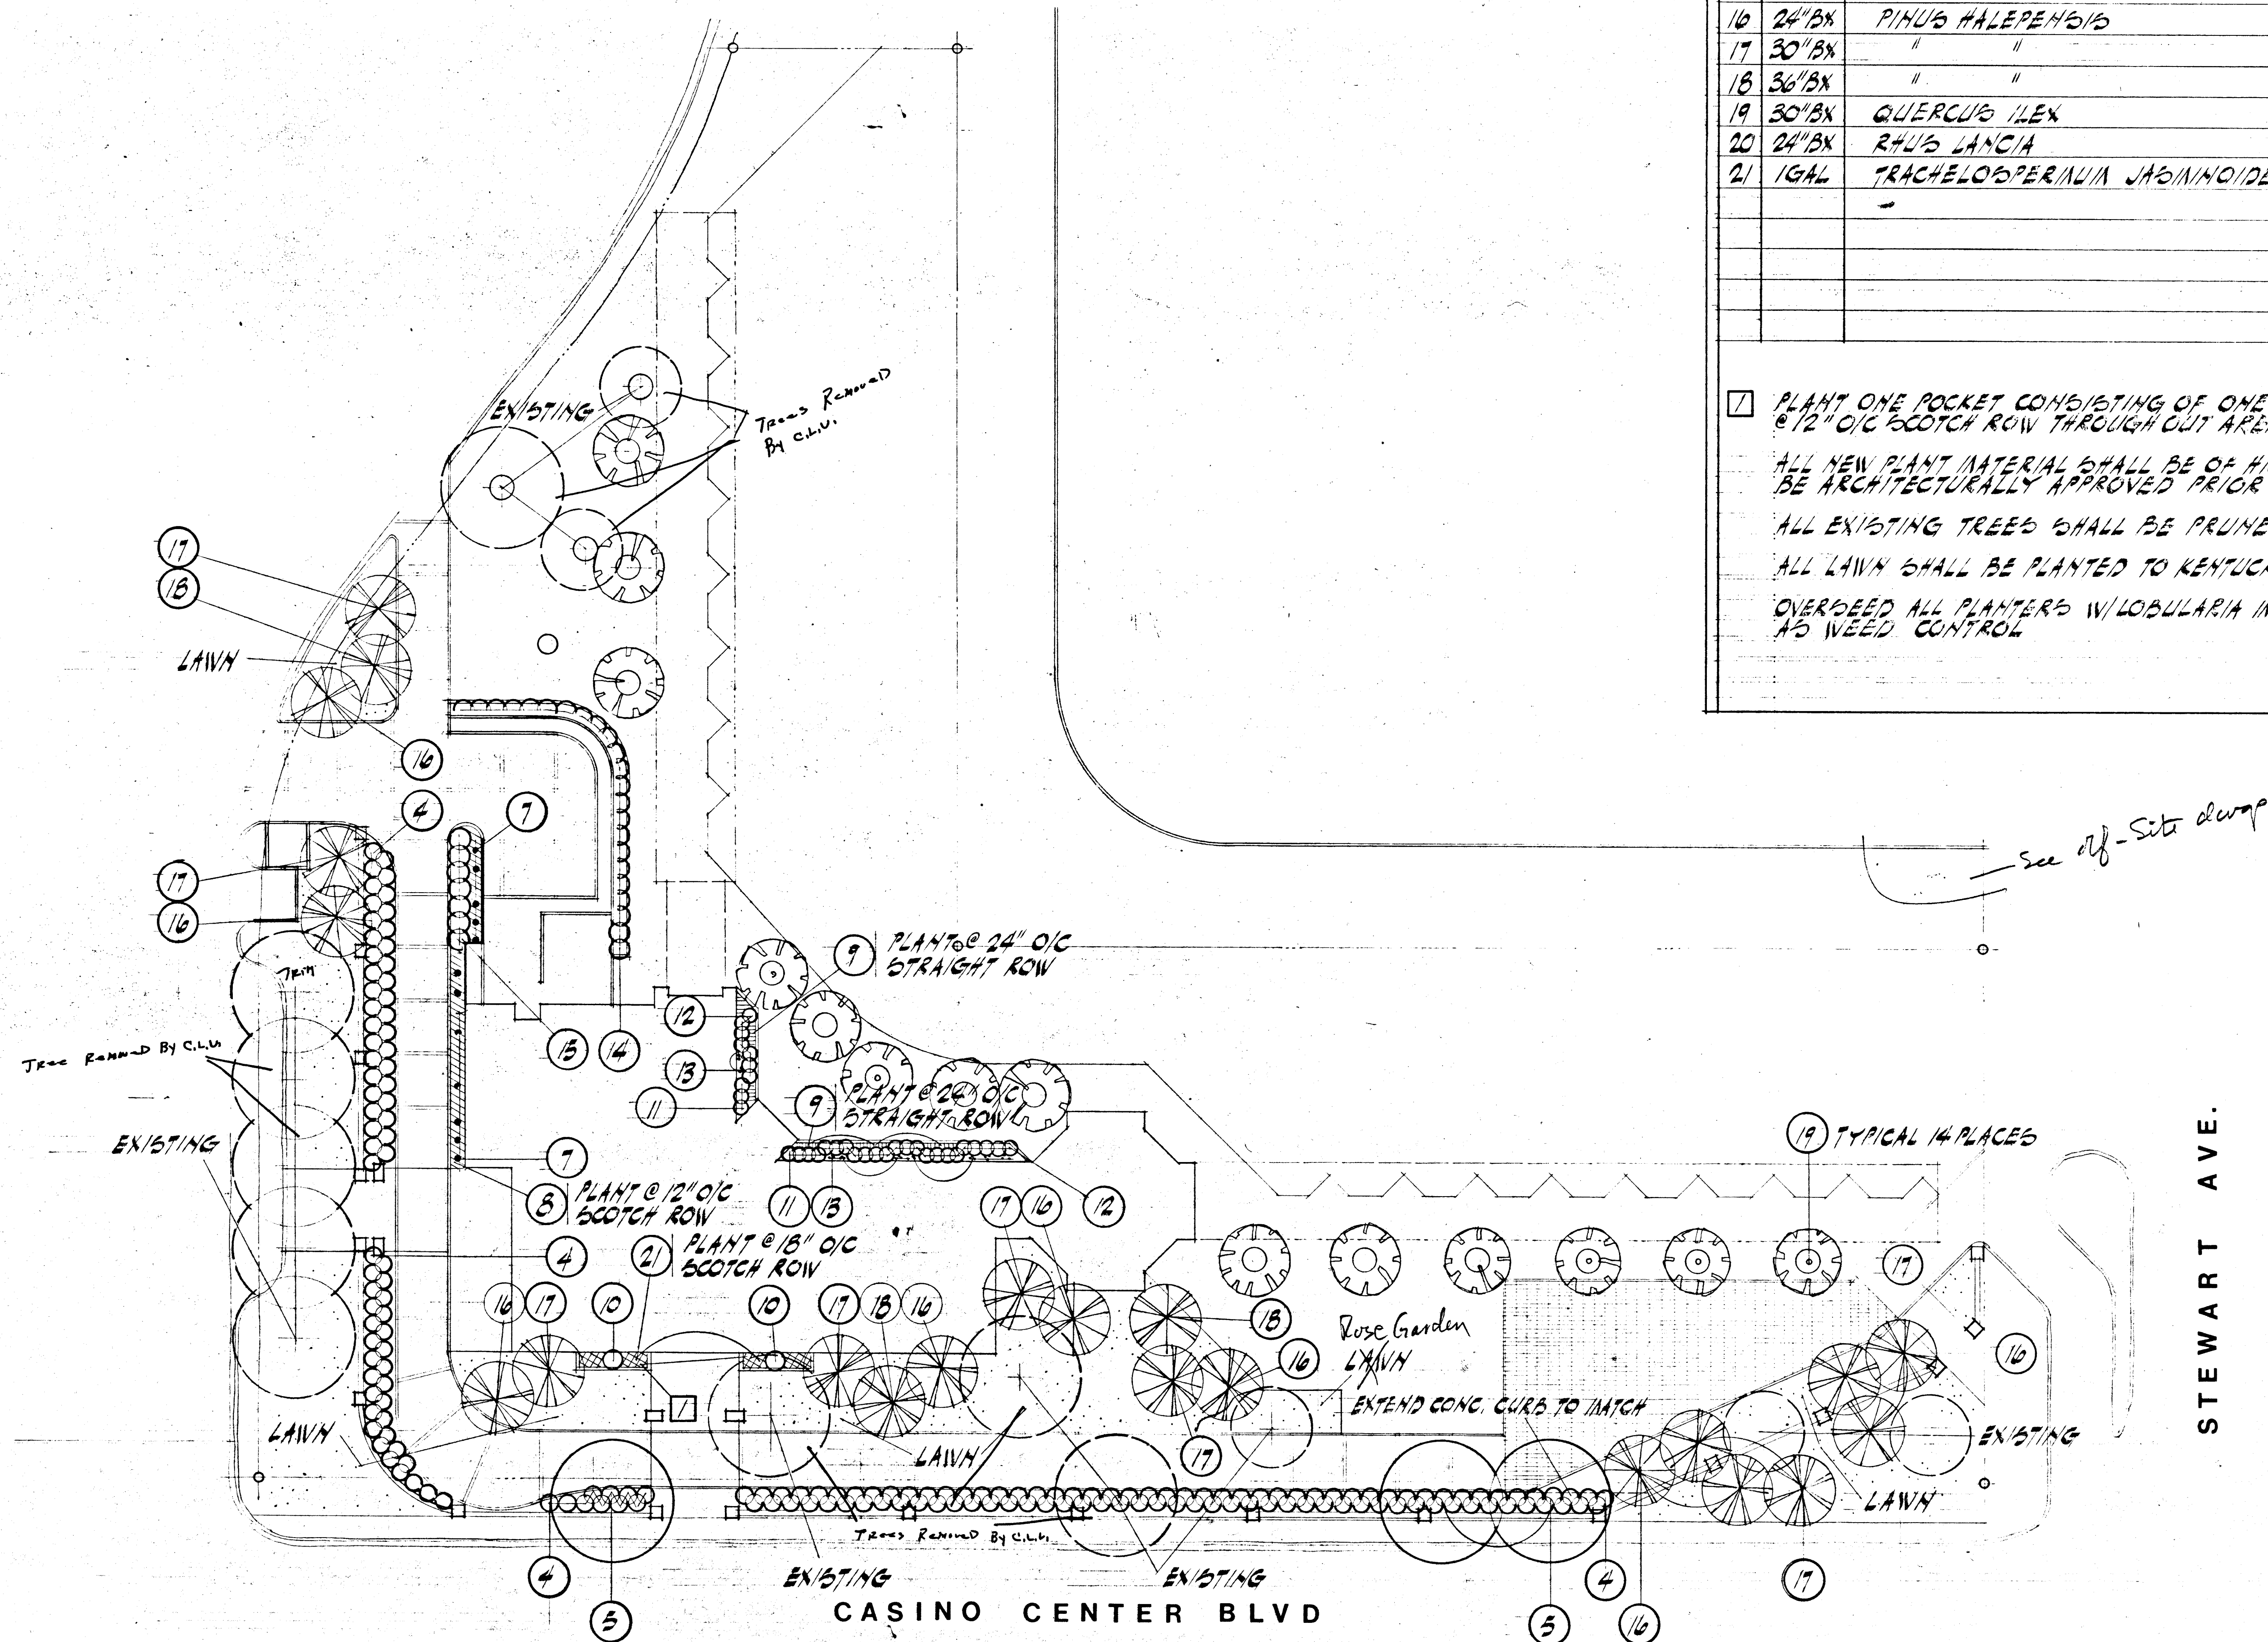

LANDSCAPE

SCALE 1"=20'

STEWART AVE.