L E G E N D

SYM.	DESCRIPTION
	VACUUM BREAKER · RAINBIRD PVB-200 ASSY W/ COPPER OR BRASS MAKE UP
	AUTOMATIC CONTROLLER · RAINBIRD · RC-1260AB PEDESTAL MOUNTED
	GATE VALVE, LINE SIZE · OHIO #2500 SERIES W/ BROOKS #37 VALVE BOX
	AUTOMATIC CONTROL VALVE · RAINBIRD EP-F-PRS W/ BROOKS #37 VALVE BOX
	QUICK COUPLER VALVE · RAINBIRD #33D W/ #33DK KEY & SWIVEL HOSE BIB
	LAWN POP-UP HEAD · RAINBIRD 1804-15 W/ SWING JOINT & FLEX RISER
	" " " " " 1804-12 " " " " " "
	SHRUB " " SPRAY HEAD · RAINBIRD 1802-8 W/ SWING JT & FLEX RISER
	" " " BUBBLER " " 1802-3 " " " " " "
	MAINLINE · 2" SCH 40 PVC
	LATERAL LINE · 2" CL 200 PVC
	" " 1 1/2" " "
	" " 1 1/4" " "
	" " 1" " "
	" " 3/4" " "
	" " 1/2" " "

1" 1 1/2" 2"

IRRIGATION SYSTEM SHOWN IS DIAGRAMMATIC - ALL VALVES AND APPURTENCES SHALL BE LOCATED IN UNPAVED OR PLANTING AREAS.

ALL PVC PIPE LATERAL LINES LAYED UNDER PAVED AREAS SHALL BE ENCASED IN SCH 40 PVC SLEEVES AND SHALL BE SAND BEDDED AND SAND SHADED PRIOR TO BACKFILL REFER TO CLARK COUNTY STANDARD DWG D67B & D67C

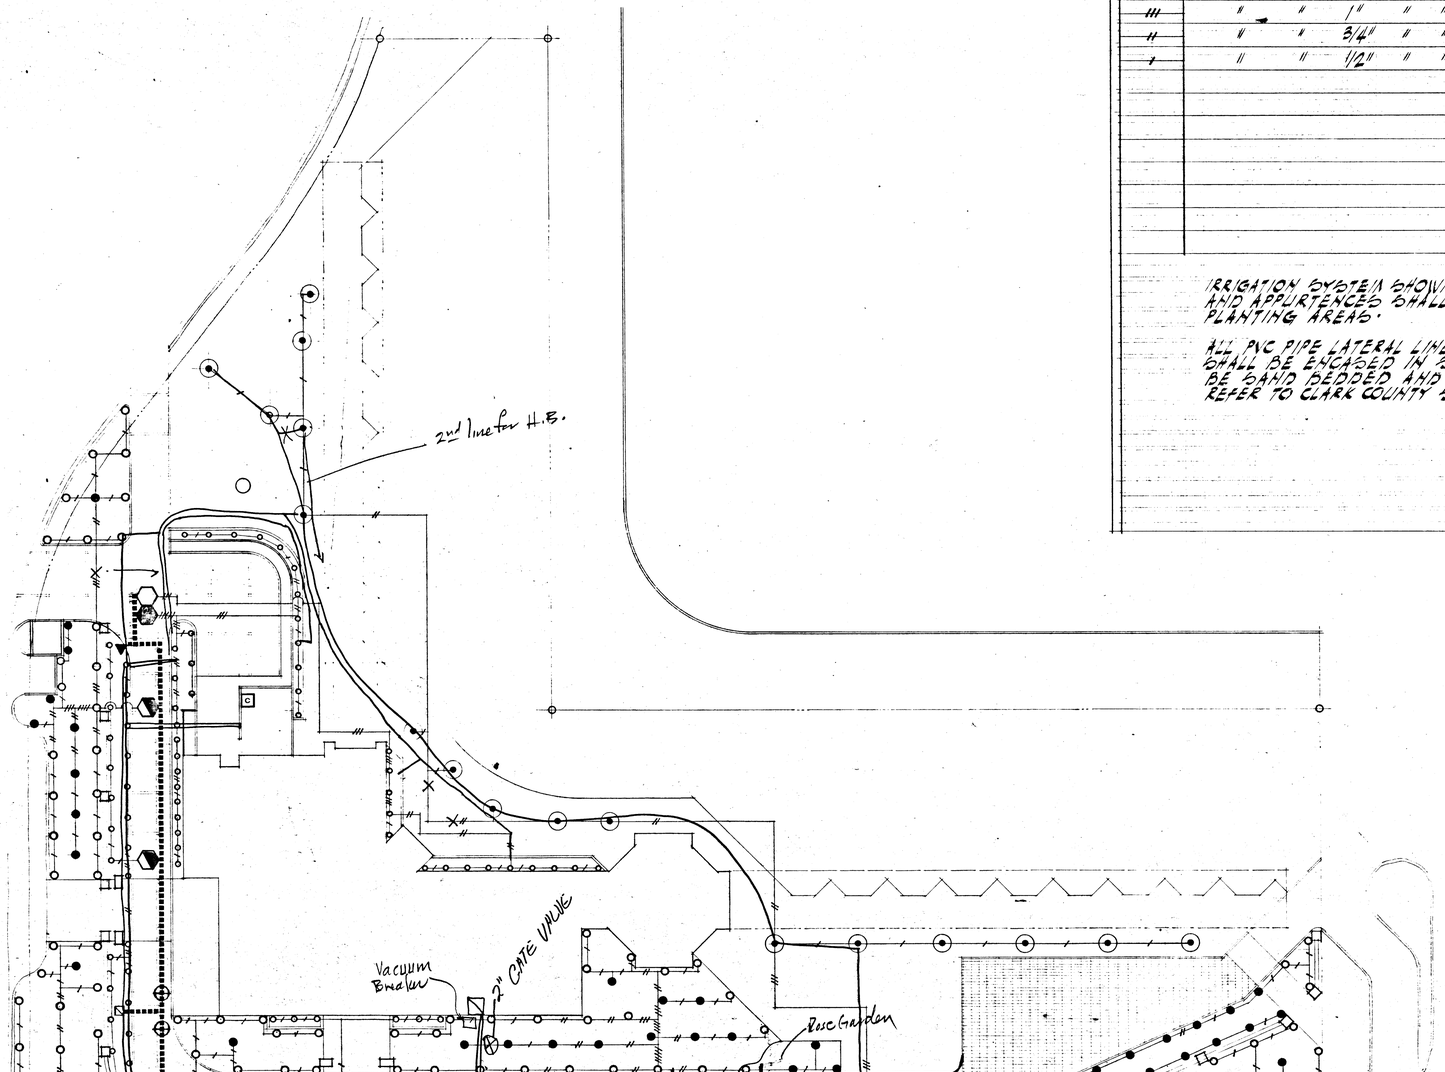

IRRIGATION SYSTEM

SCALE 1" = 20'

DATE 9-14-85
DRAWN
CHECKED FP
JOB NO. 245-141

DOBRUSKY KITTRELL GARLOCK
Architects aia
3295 CAMBRIDGE ST. LAS VEGAS, NEVADA 89109 (702) 735-0433

City of Las Vegas
Downtown Transportation Center
Las Vegas, Nevada

SHEET L-2
OF 8 of 65
SHEET 595-2I

4131