



- NOTES**
1. FOR DEMOLITION OF EXISTING STRUCTURE (S) SEE SHEET A-1.
 2. FOR BUS CIRCULATION PAVING PATTERN SEE CIVIL DRAWINGS
 3. FOR EXISTING TREES TO REMAIN SEE SHEET A-1.
 4. FURNISH AND INSTALL NEW CAST IRON TREE GRATE FOR EXISTING TREES REMAINING IN CONCRETE PAVED AREAS. DETAIL SIM. TO NEW TREE GRATES.

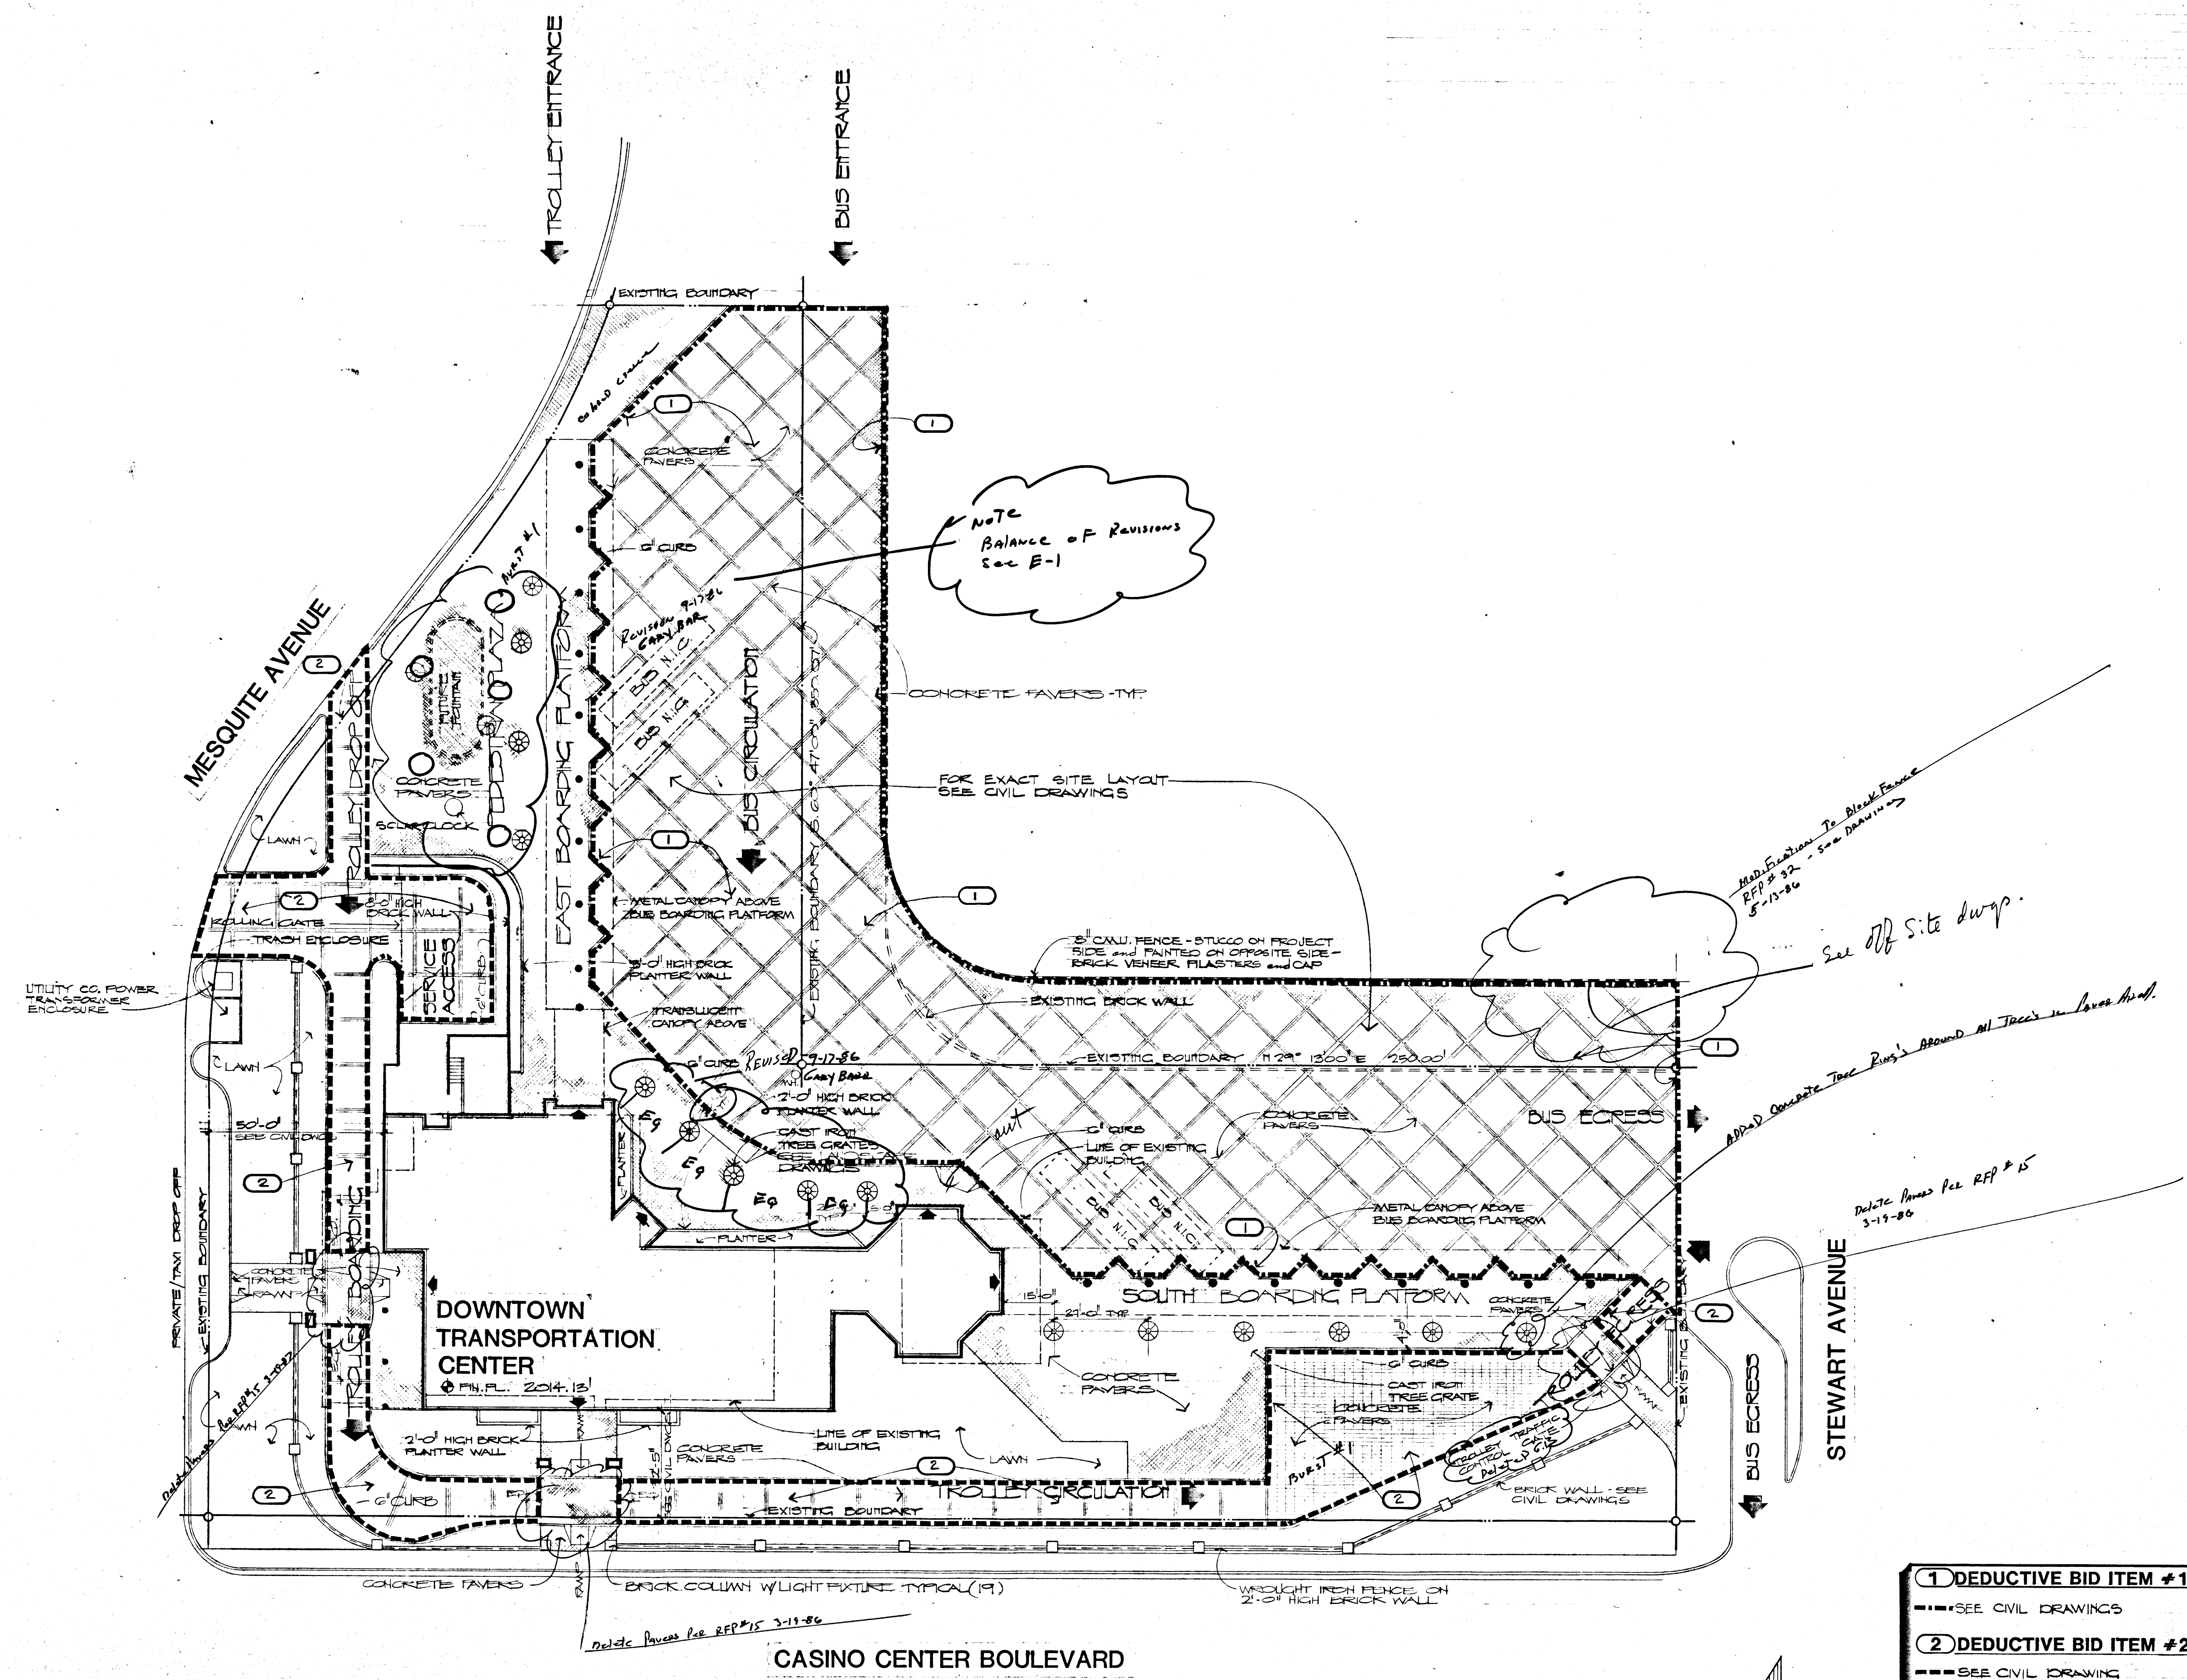

SITE PLAN
SCALE: 1" = 20'-0"

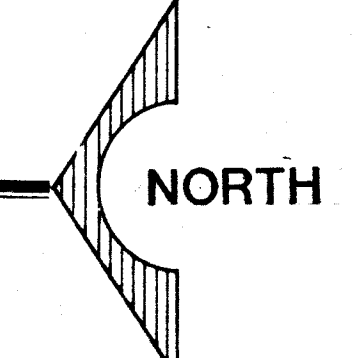

1	DEDUCTIVE BID ITEM #1 (I)
---	SEE CIVIL DRAWINGS
2	DEDUCTIVE BID ITEM #2 (I)
---	SEE CIVIL DRAWING
FOR DETAIL DESCRIPTION SEE SPECIFICATIONS	