
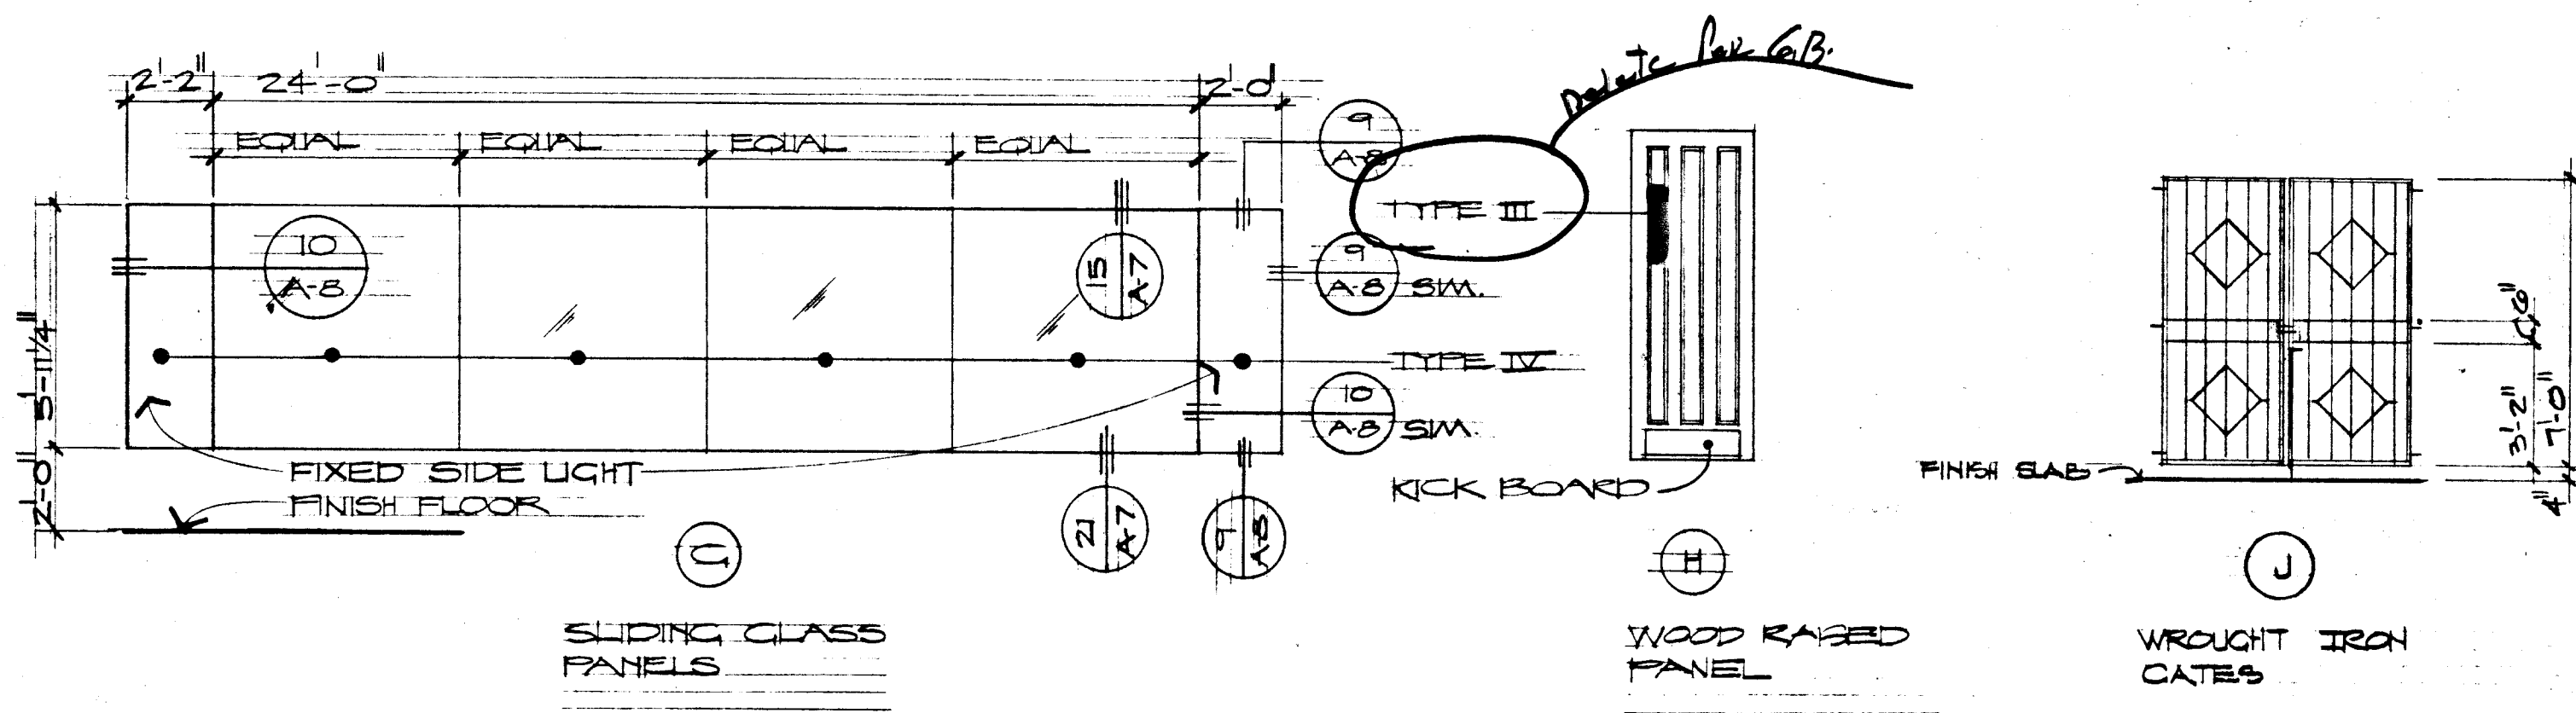


DOOR TYPES

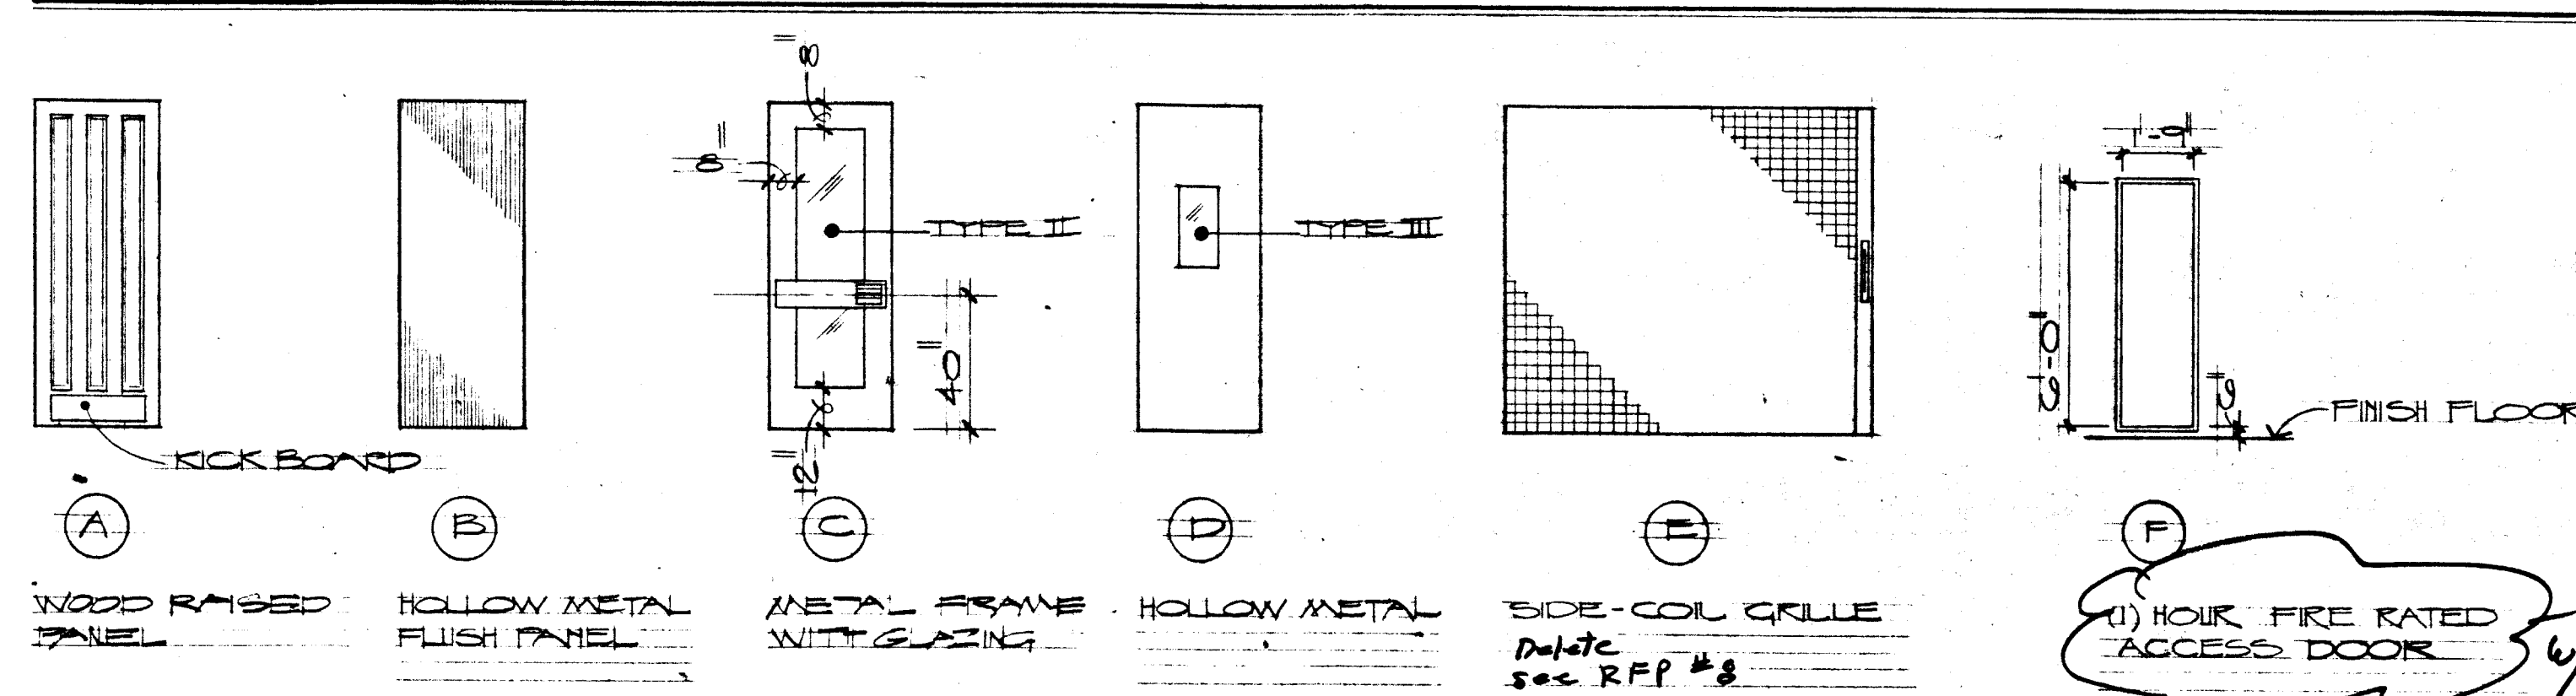


GLASS TYPES

- TYPE I: 1/4" SOLAR BRONZE EXTERIOR
1/2" AIR SPACE
1/4" CLEAR INTERIOR
- TYPE II: 1/4" TEMPERED SOLAR BRONZE
- TYPE III: 1/4" WIRE GLASS
- TYPE IV: 1/2" TEMPERED CLEAR
- TYPE V: .250" LEXAN
- TYPE VI: 1/2" CLEAR GLASS
- TYPE VII: .250" ACRYLIC

WINDOW TYPES

SCALE: 3/8" = 1'-0"

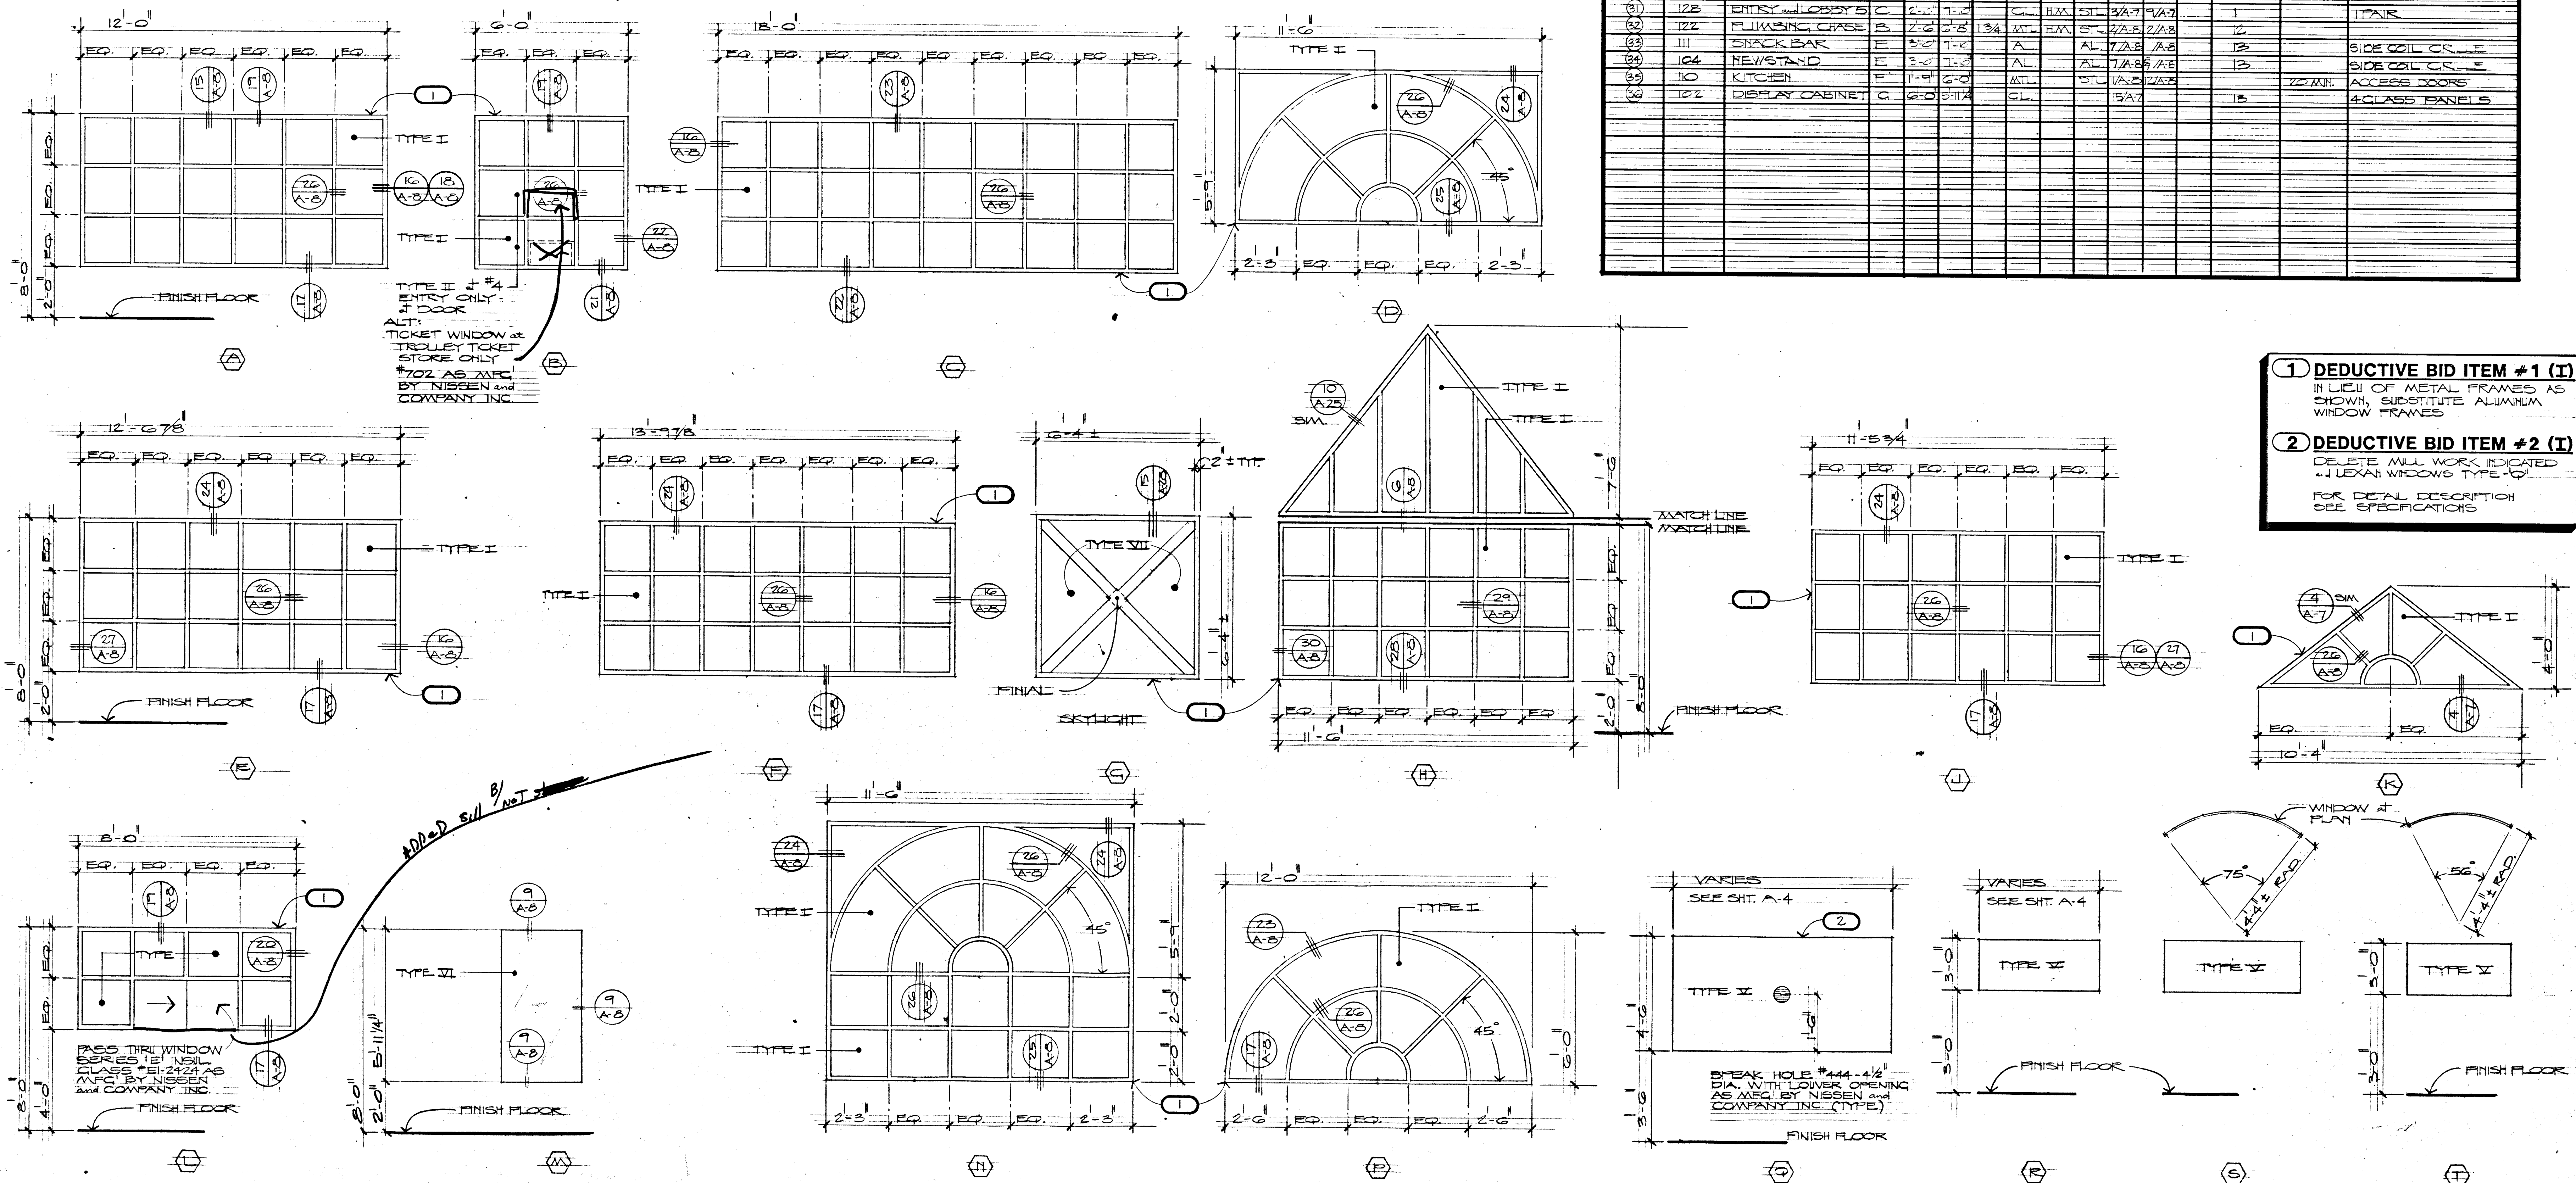

DOOR SCHEDULE

DR. NO.	RM. NO.	ROOM NAME	DOOR				FRAME			HARDWARE	LABEL	REMARKS		
			TYPE	WD.	HT.	THK.	MTL.	TYPE	MTL.				HEAD JAMB BILL	
1	103	ENTRY NO.2	C	2'-0"	7'-2"		CL	H.M.	STL	1/4"	1/4"			IFAIR
2	103	ENTRY NO.2	C	2'-0"	7'-2"		CL	H.M.	STL	1/4"	1/4"			IFAIR
3	105	TROLLEY TICKETS	A	3'-0"	7'-2"	1/4"	WD	H.M.	STL	3/4"	1/4"		2	20 MIN.
4	106	STORAGE	B	2'-0"	6'-2"	1/4"	MTL	H.M.	STL	3/4"	1/4"		3	IFAIR
5	107	ELECTRICAL	B	3'-0"	6'-2"	1/4"	MTL	H.M.	STL	3/4"	1/4"		4	
6	108	MECHANICAL	B	4'-0"	6'-2"	1/4"	MTL	H.M.	STL	3/4"	1/4"		4	
7	109	HALL	B	2'-0"	7'-0"	1/4"	MTL	H.M.	STL	2/4"	1/4"		5	IFAIR
8		COOLING TOWER	U	3'-0"	6'-2"	1/4"	MTL	H.M.	STL				14	IFAIR WROUGHT IRON GATE
9	110	FUTURE KITCHEN	D	2'-0"	6'-2"	1/4"	MTL	H.M.	STL	3/4"	1/4"		3	IFAIR
10	109	HALL	A	3'-0"	7'-2"	1/4"	WD	H.M.	STL	5/4"	1/4"		6	20 MIN. IFAIR
11	110	FUTURE KITCHEN	A	3'-0"	7'-2"	1/4"	WD	H.M.	STL	5/4"	1/4"		7	20 MIN.
12	110	FUTURE KITCHEN	A	3'-0"	7'-2"	1/4"	WD	H.M.	STL	5/4"	1/4"		7	20 MIN.
13	112	ENTRY LOBBY 3	C	2'-0"	7'-2"		CL	H.M.	STL	3/4"	1/4"		1	IFAIR
14	112	ENTRY LOBBY 3	C	2'-0"	7'-2"		CL	H.M.	STL	3/4"	1/4"		1	IFAIR
15	114	ENTRY NO. 4	C	2'-0"	7'-2"		CL	H.M.	STL	4/4"	1/4"		1	IFAIR
16	114	ENTRY NO. 4	C	2'-0"	7'-2"		CL	H.M.	STL	4/4"	1/4"		1	IFAIR
17	115	VESTIBULE	A	3'-0"	6'-2"	1/4"	WD	H.M.	STL	6/4"	1/4"		5	
18	113	ESTUNDA	H	3'-0"	7'-2"	1/4"	WD	H.M.	STL	7/4"	1/4"		9	20 MIN. 4" X 22" X 1/4" WIRE GLASS
19	119	STAIR	H	3'-0"	7'-2"	1/4"	WD	H.M.	STL	7/4"	1/4"		9	20 MIN. 4" X 22" X 1/4" WIRE GLASS
20	118	TROLLEY TICKET	H	3'-0"	7'-2"	1/4"	WD	H.M.	STL	7/4"	1/4"		9	20 MIN. 4" X 22" X 1/4" WIRE GLASS
21	100	ENTRY NO. 1	C	2'-0"	7'-2"		CL	H.M.	STL	7/4"	1/4"		1	IFAIR
22	100	ENTRY NO. 1	C	2'-0"	7'-2"		CL	H.M.	STL	7/4"	1/4"		1	IFAIR
23	123	W. RESTROOM	A	3'-0"	7'-2"	1/4"	WD	H.M.	STL	3/4"	1/4"		10	20 MIN.
24	124	M. RESTROOM	A	3'-0"	7'-2"	1/4"	WD	H.M.	STL	3/4"	1/4"		10	20 MIN.
25	122	JANITOR	A	3'-0"	7'-2"	1/4"	WD	H.M.	STL	3/4"	1/4"		2	20 MIN.
26	127	DRIVERS LOUNGE	A	3'-0"	7'-2"	1/4"	WD	H.M.	STL	4/4"	1/4"		11	20 MIN.
27	126	FIRST AID	A	3'-0"	7'-2"	1/4"	WD	H.M.	STL	4/4"	1/4"		2	20 MIN.
28	128	ENTRY LOBBY 5	C	2'-0"	7'-2"		CL	H.M.	STL	3/4"	1/4"		1	IFAIR
29	128	ENTRY LOBBY 5	C	2'-0"	7'-2"		CL	H.M.	STL	3/4"	1/4"		1	IFAIR
106	128	ENTRY LOBBY 5	C</											