
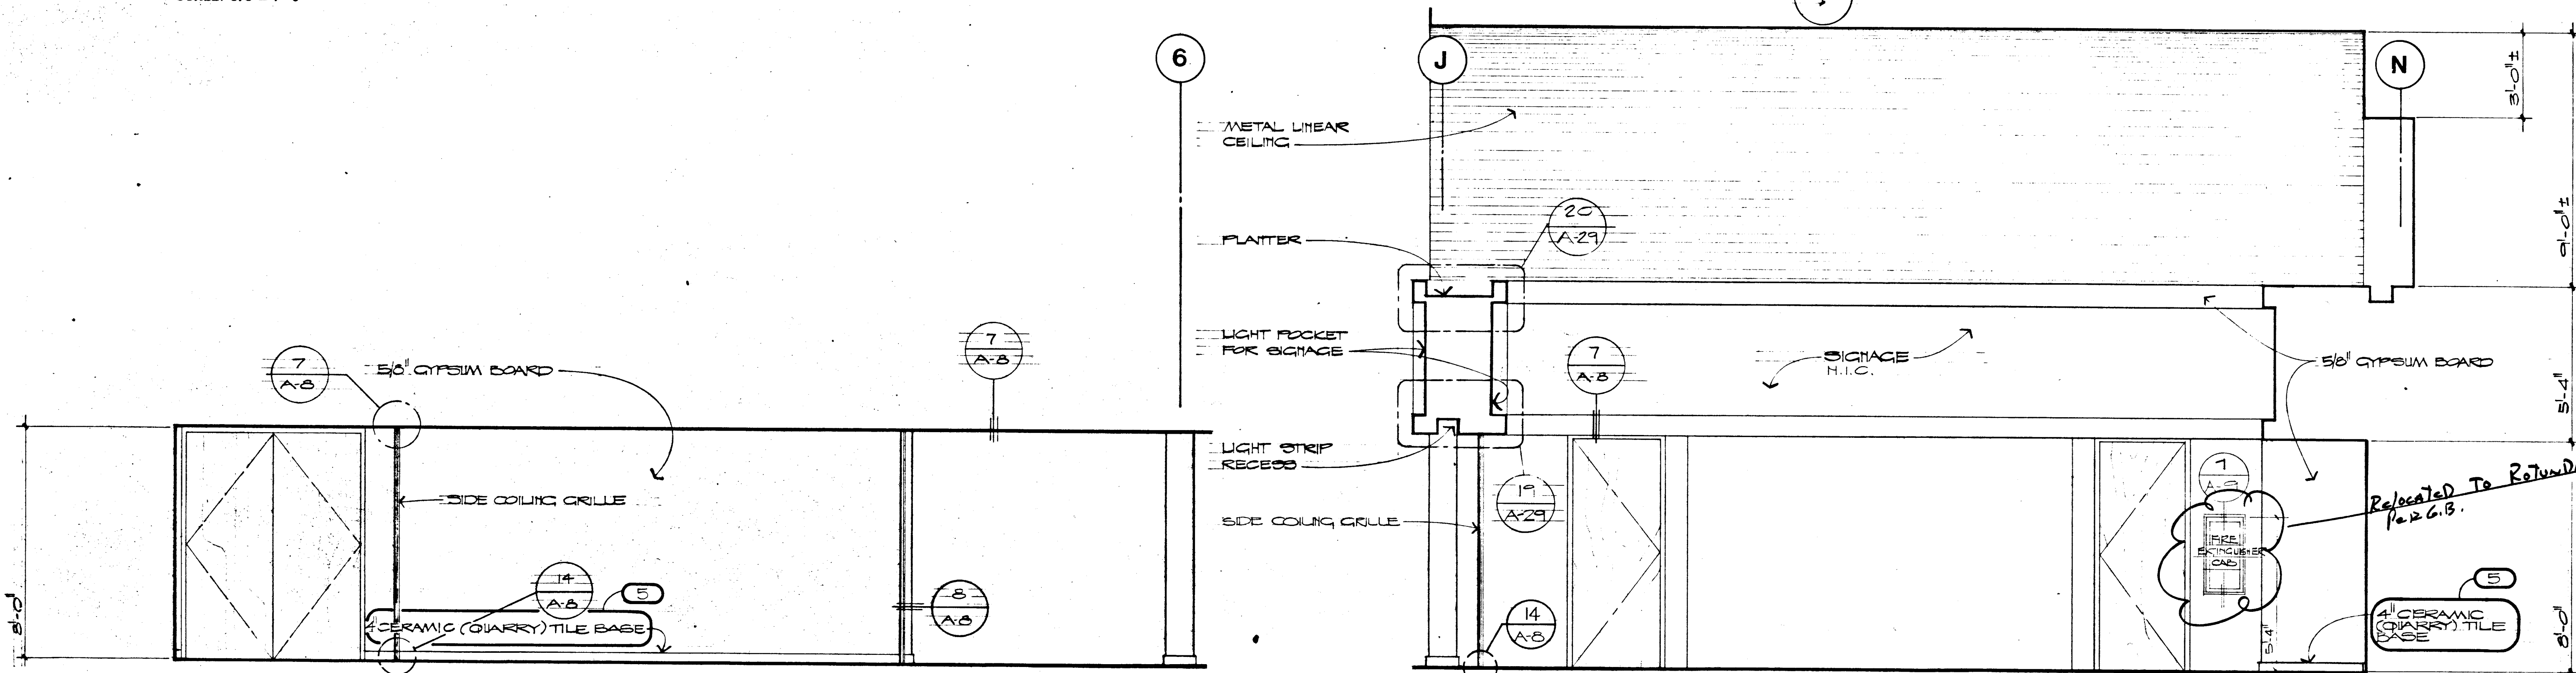


LOBBY #1 and ENTRY #2

SCALE: 3/8" = 1'-0"

FIRE EXTINGUISHER CABINET

SCALE: 1 1/2" = 1'-0"

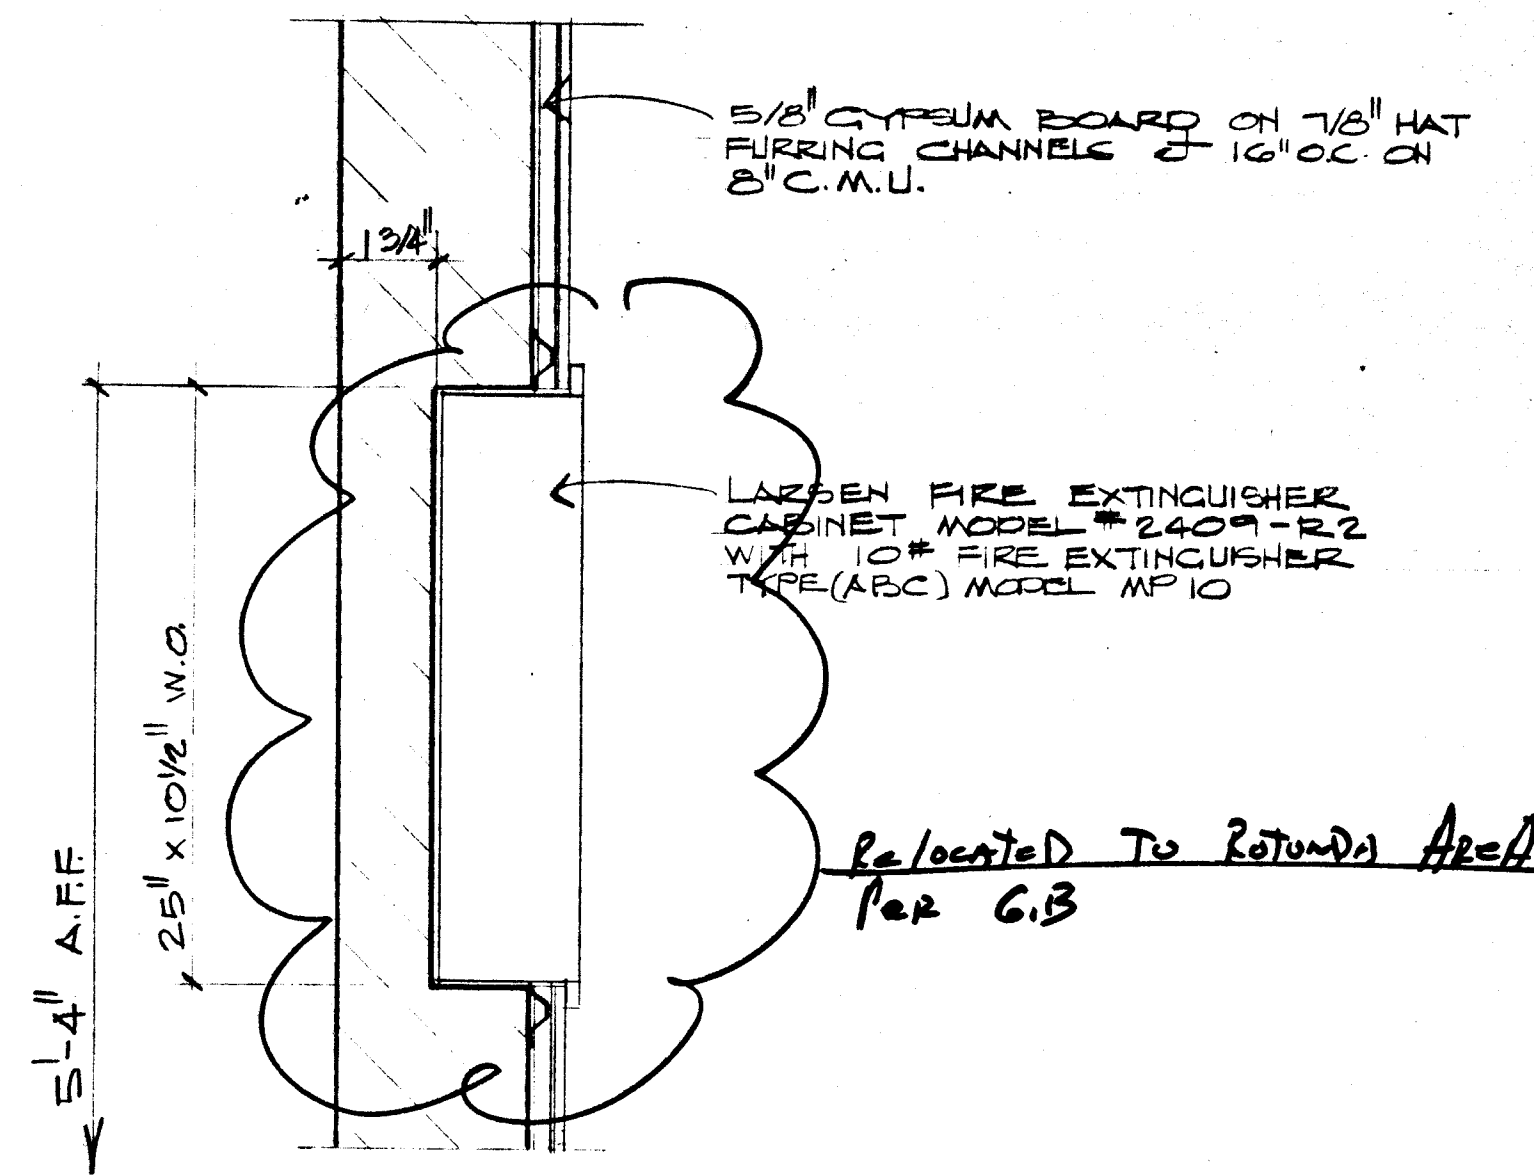


NEWSTAND and SNACK BAR

SCALE: 3/8" = 1'-0"

SNACK BAR

SCALE: 3/8" = 1'-0"

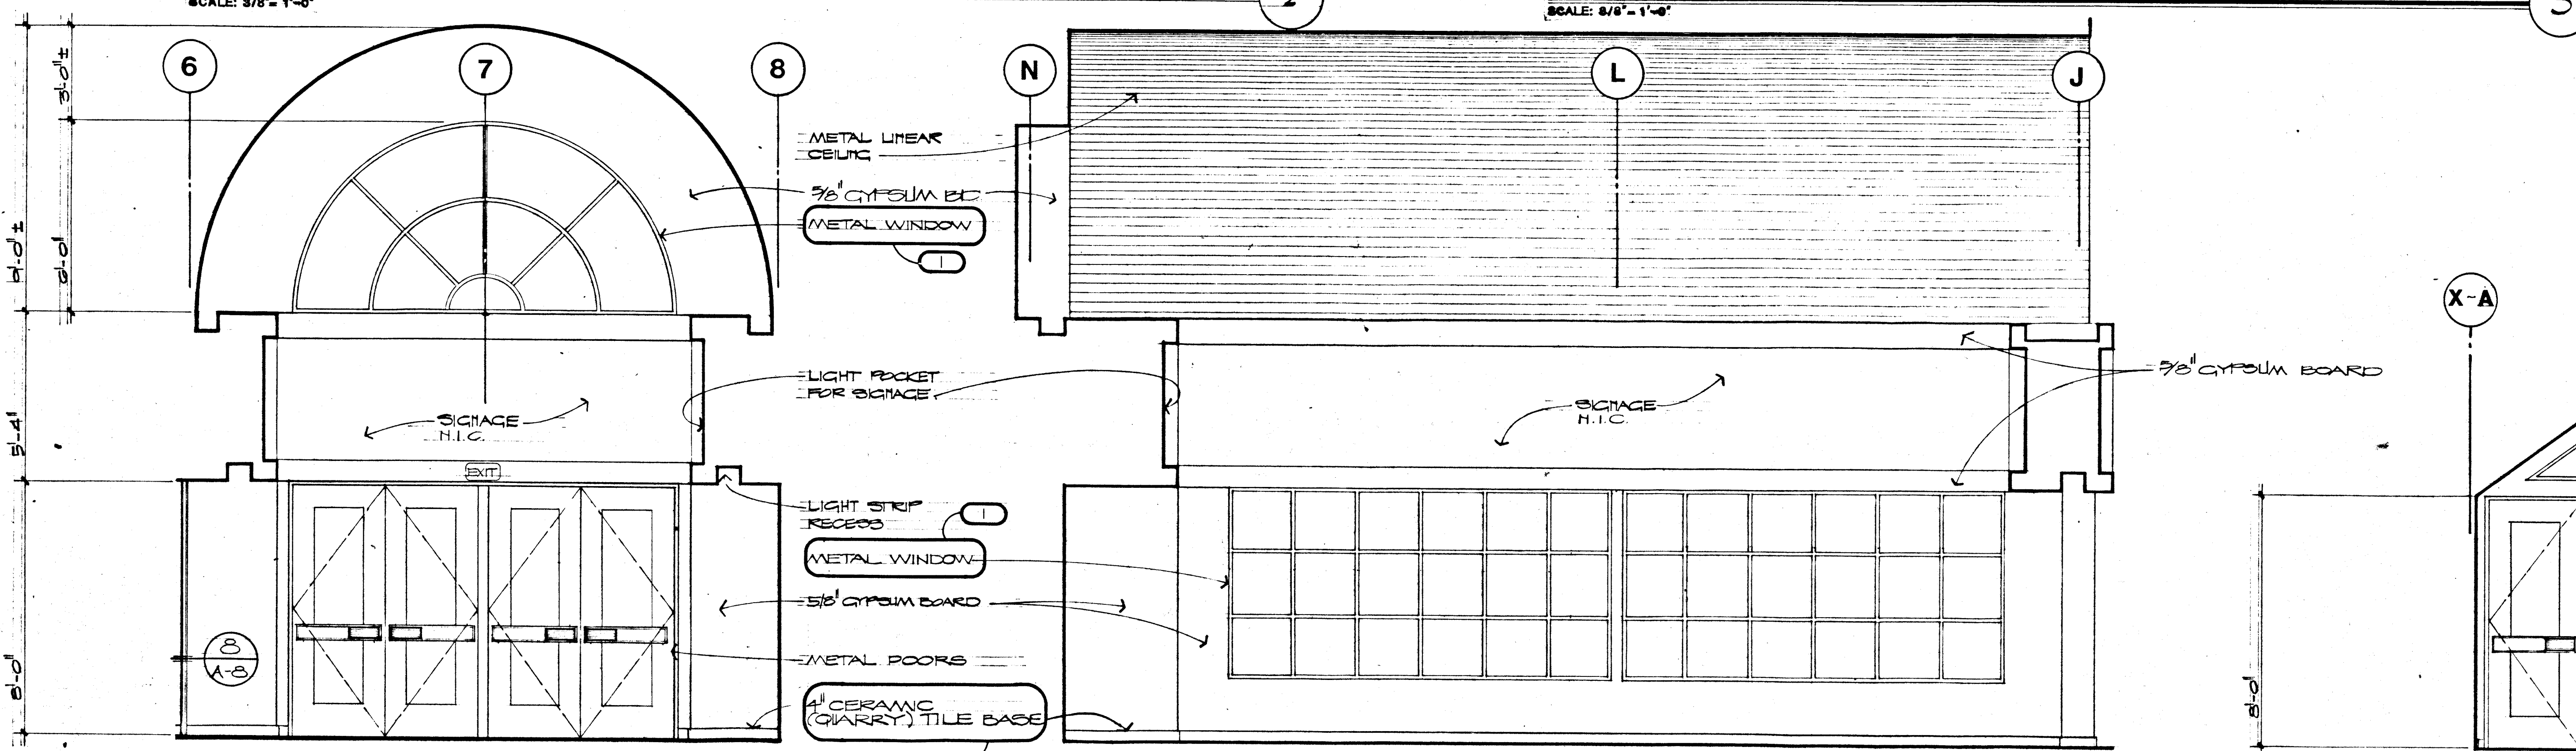


ENTRY and LOBBY #3

SCALE: 3/8" = 1'-0"

ENTRY and LOBBY #3

SCALE: 3/8" = 1'-0"

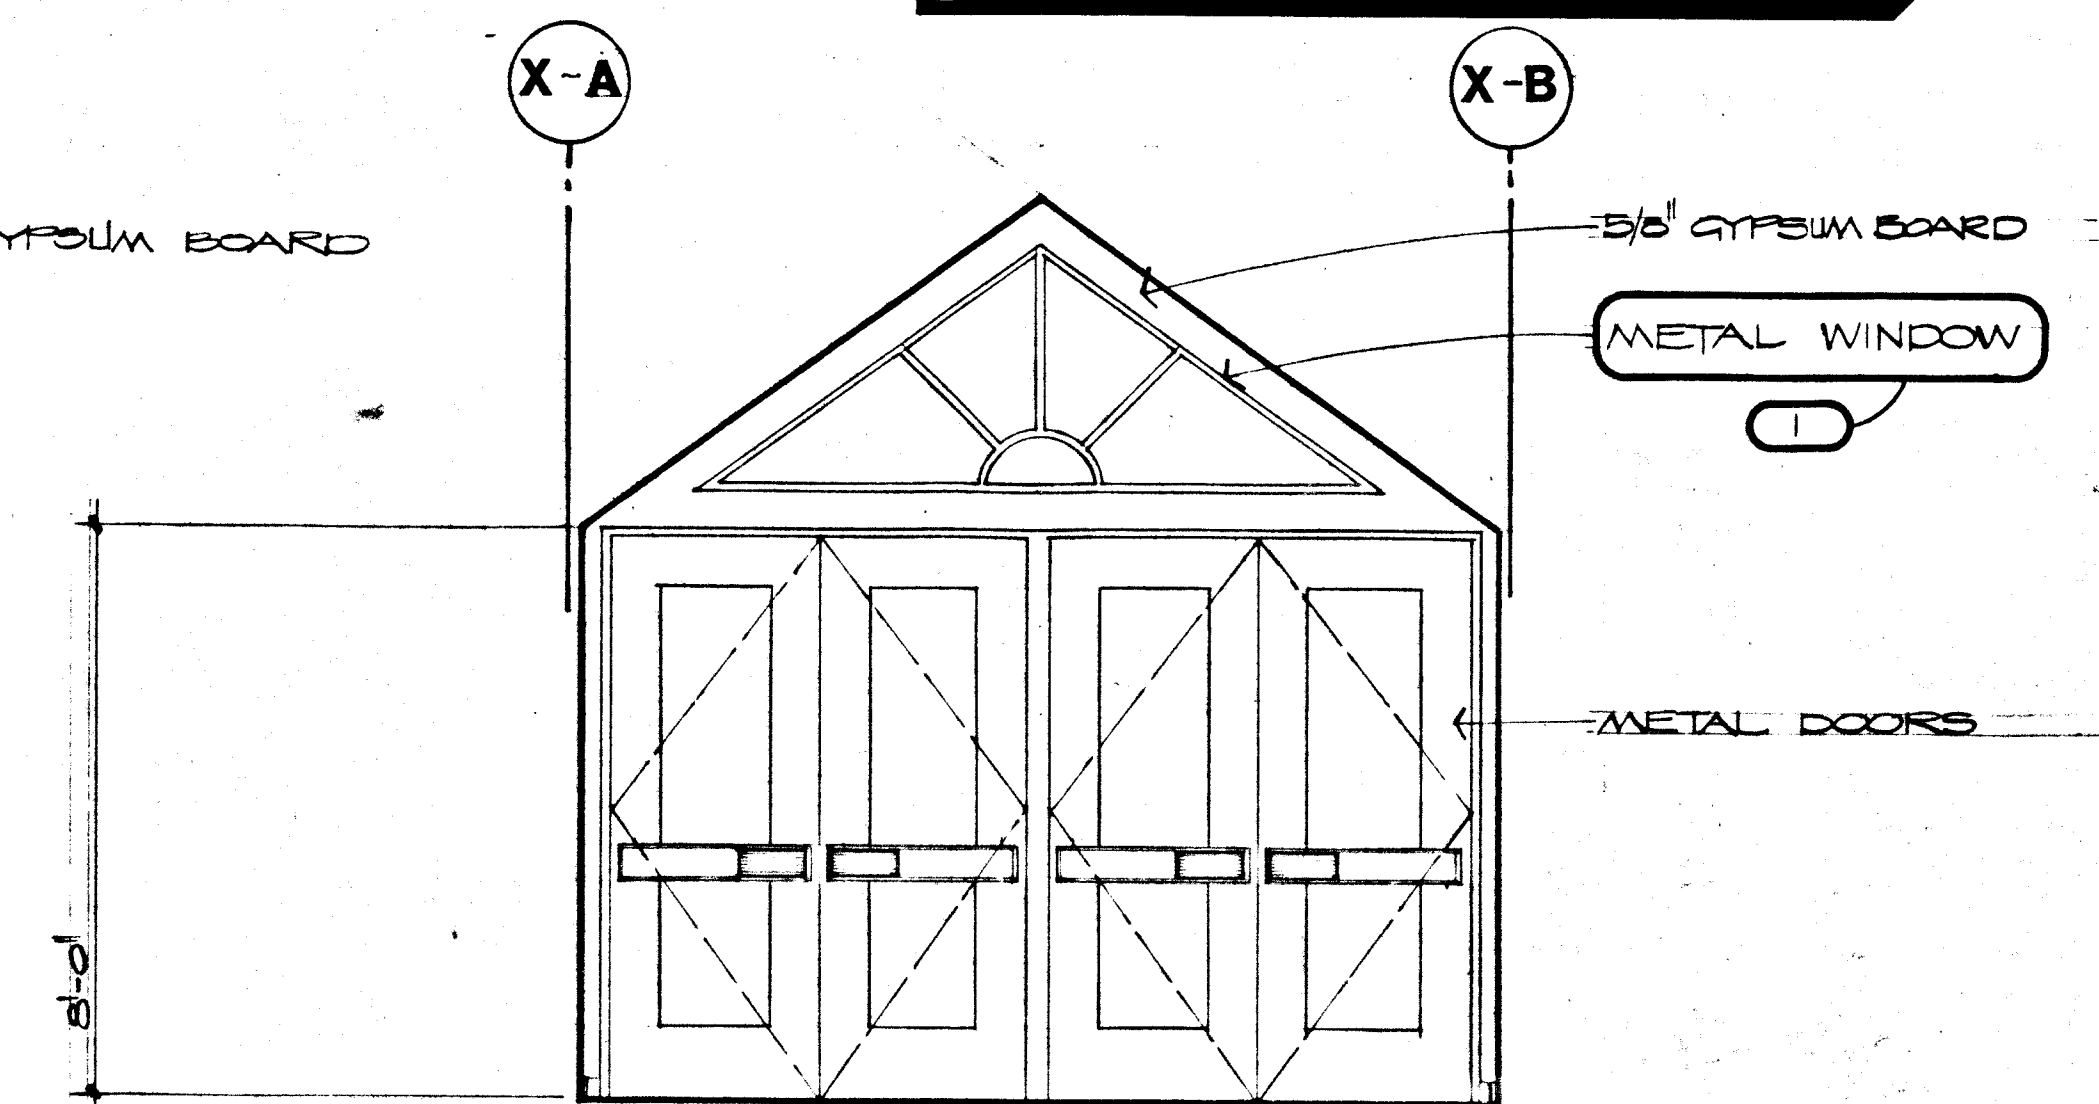

ENTRY #4

SCALE: 3/8" = 1'-0"

1 DEDUCTIVE BID ITEM # 1 (I)
 IN LIEU OF METAL WINDOW FRAMES
 AS SHOWN SUBSTITUTE ALUMINUM
 WINDOW FRAMES

5 DEDUCTIVE BID ITEM # 5 (I)
 IN LIEU OF CERAMIC (QUARRY)
 TILE FLOOR and BASE AS
 SHOWN SUBSTITUTE VINYL TILE
 FLOOR and BASE

FOR DETAILED DESCRIPTION
 SEE SPECIFICATIONS

DATE: 12-1-85
 DRAWN: [Signature]
 CHECKED: [Signature]
 PROJECT: [Signature]
 SHEET NO.: 508-227

DOBRUSKY KITTRELL GARLOCK
 Architects
 818
 3000 CHARLESTON ST. LAS VEGAS, NEVADA 89109 (702) 735-0435

Center
 Downtown
 City of Las Vegas
 Transportation
 Las Vegas, Nevada

SHEET
A-9
 12/1/85
 508-227

1/8" = 1'-0" DRAWING FROM