


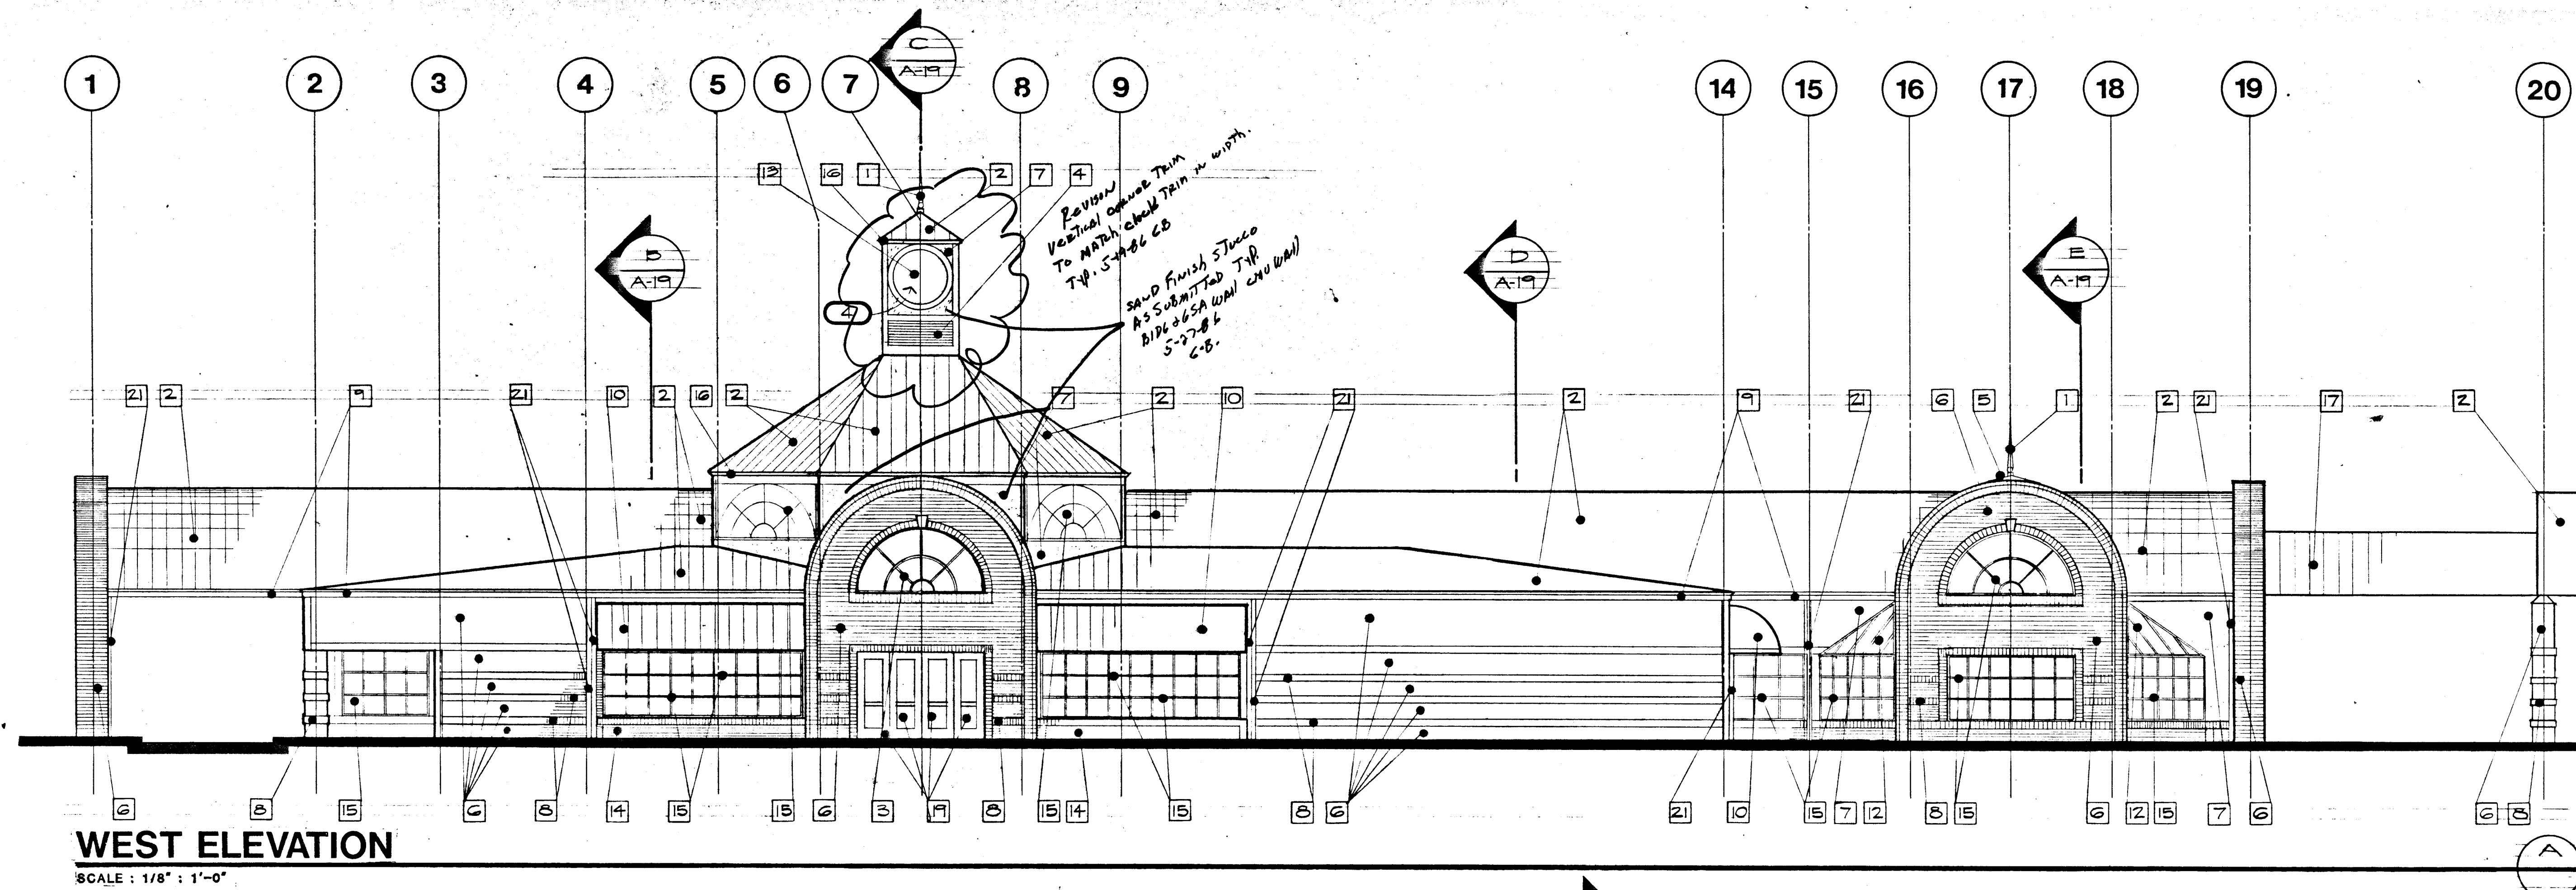




EXTERIOR FINISH LEGEND

- 1 METAL FINISH
- 2 STANDING SEAM METAL ROOF
- 3 PREFINISHED METAL FRAME
- 4 PREFINISHED METAL VENT
- 5 SKYLIGHT
- 6 BRICK VENEER
- 7 STUCCO
- 8 BRICK SOLDIER COURSE
- 9 PREFINISHED SHEET METAL GUTTER
- 10 METAL AWNING
- 11 METAL INTAKE LOUVER
- 12 GLAZED ROOF
- 13 CLOCK (4)
- 14 BRICK PLANTER
- 15 PREFINISHED METAL WINDOWS
- 16 SHEET METAL CORNICE
- 17 TRANSLUCENT ACRYLIC ROOF
- 18 STEEL STAIR
- 19 METAL FRAME WITH GLASS DOORS
- 20 METAL DOOR
- 21 DOWN SPOITS

(4) DEDUCTIVE BID ITEM #4 (I)

DELETE THE FOUR (4) CLOCKS SHOWN ON THE DRAWINGS AND ADD METAL FRAMING AND STUCCO REQUIRED TO FILL VOID FOR DETAILED DESCRIPTION SEE SPECIFICATIONS.

clocks approved per RFP #2 - 2-14-86
5 RFP #30 - 4-17-86

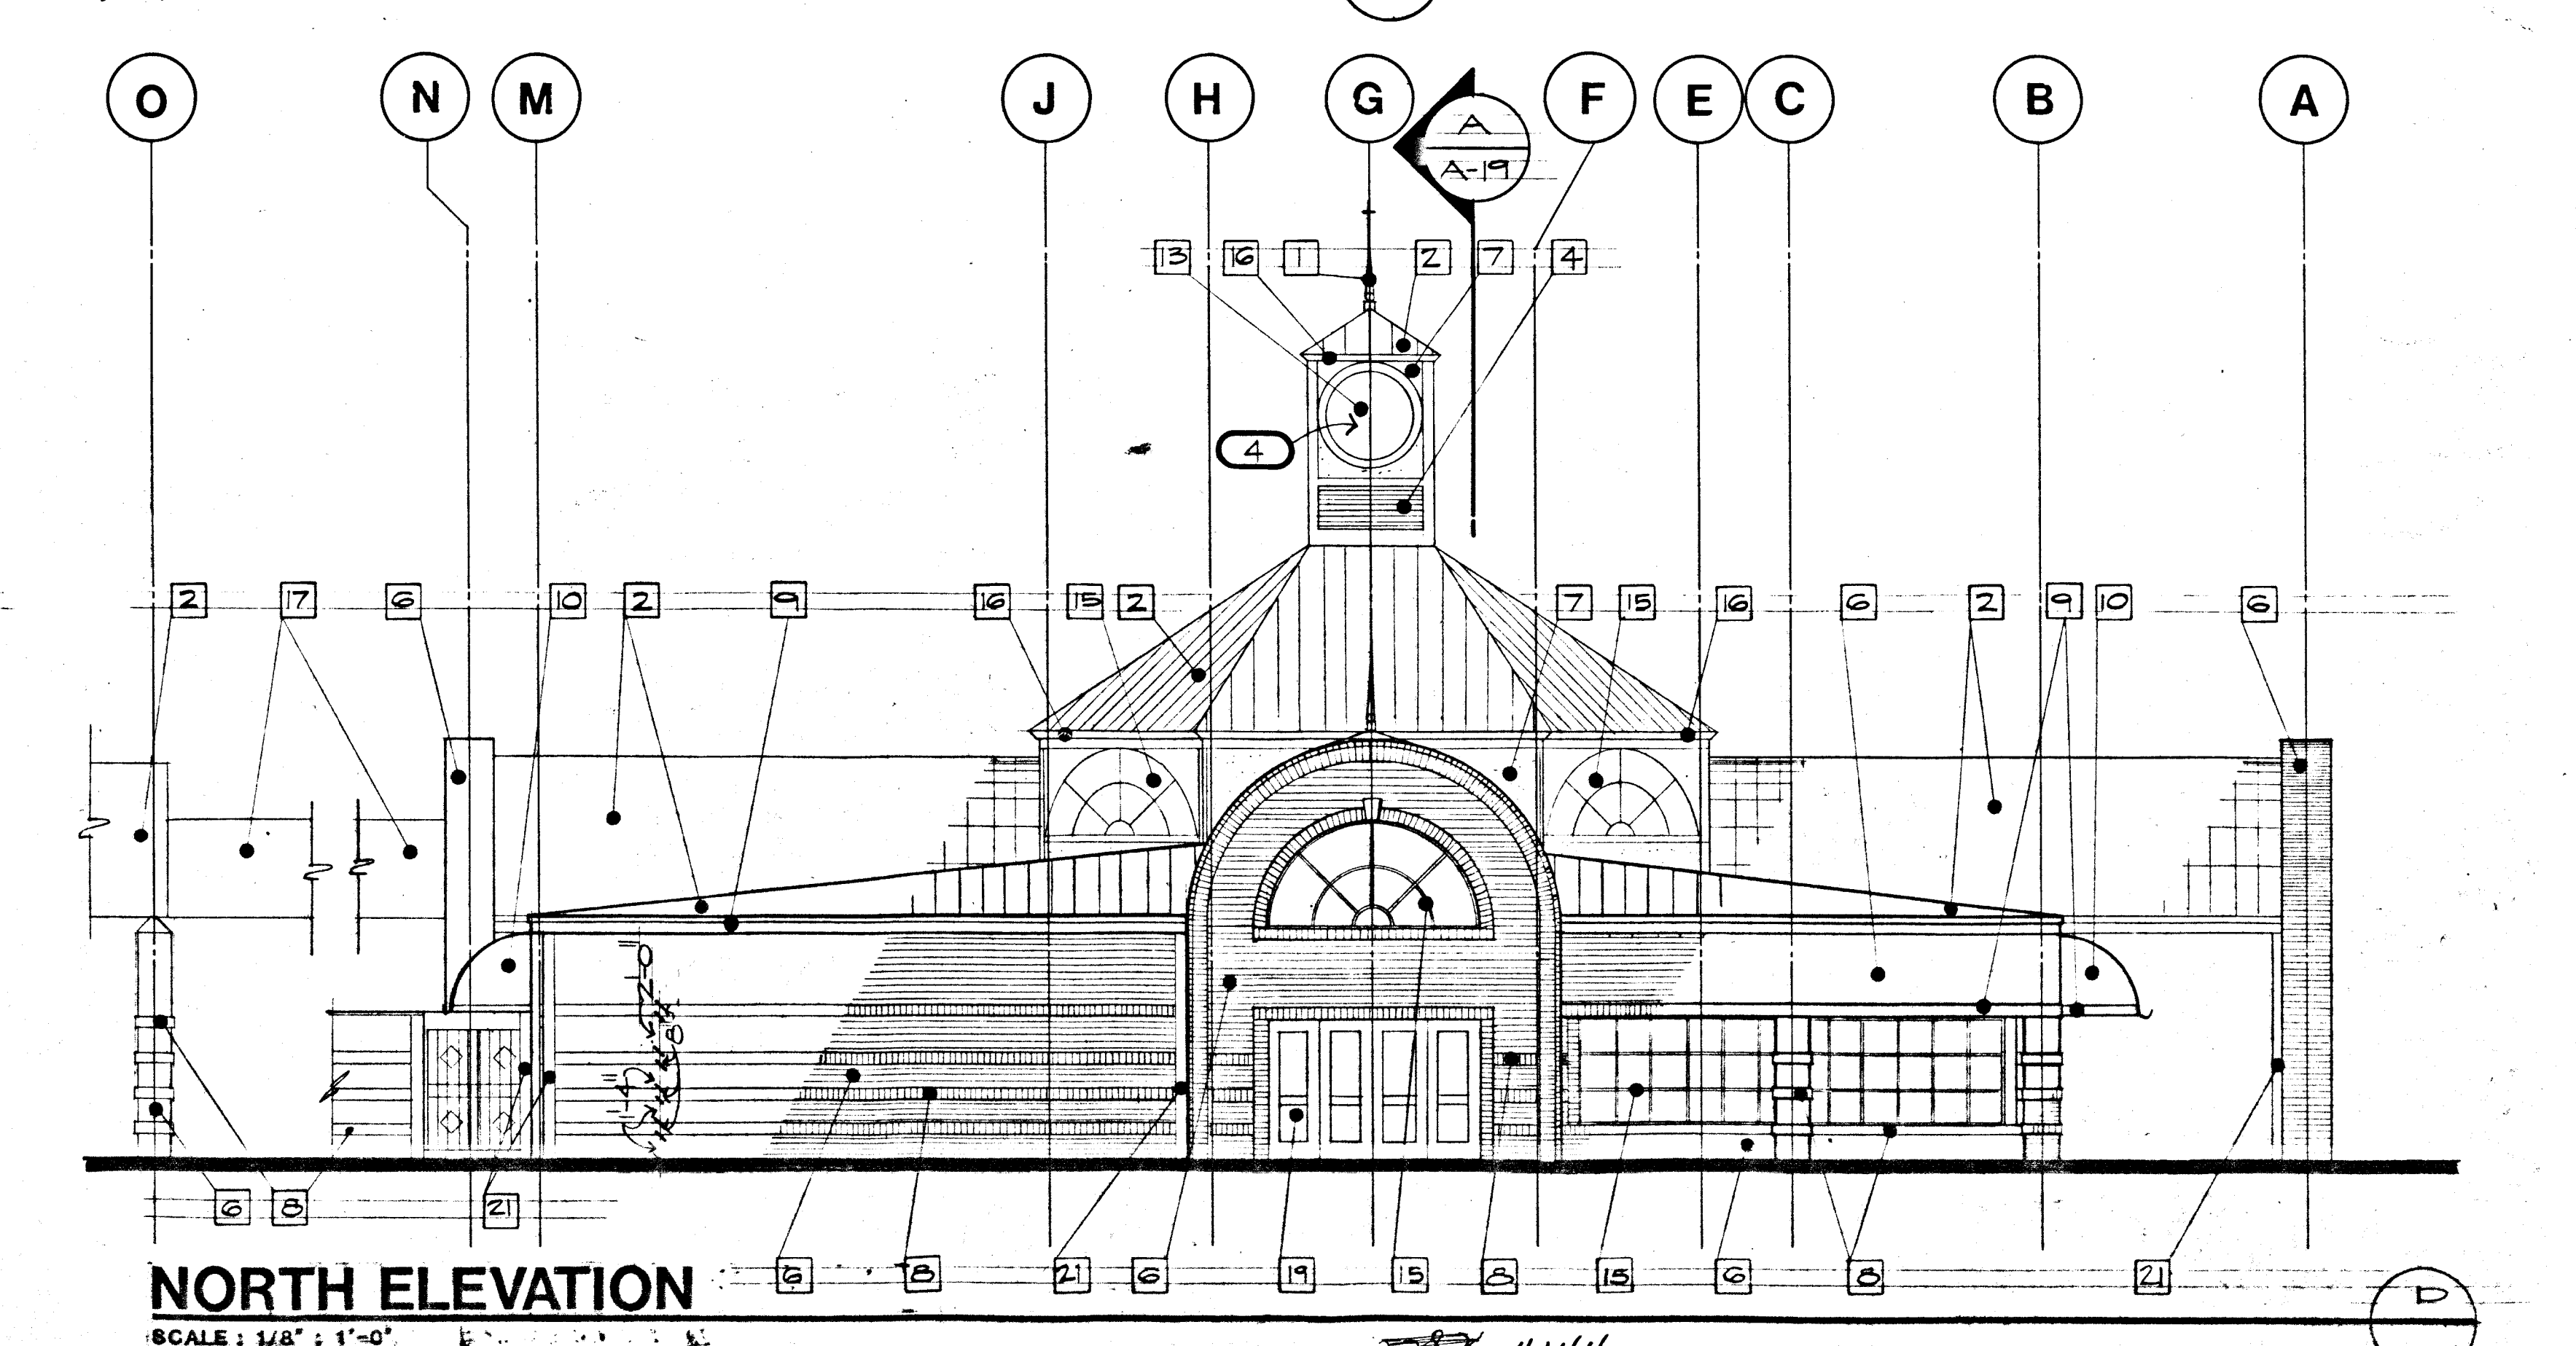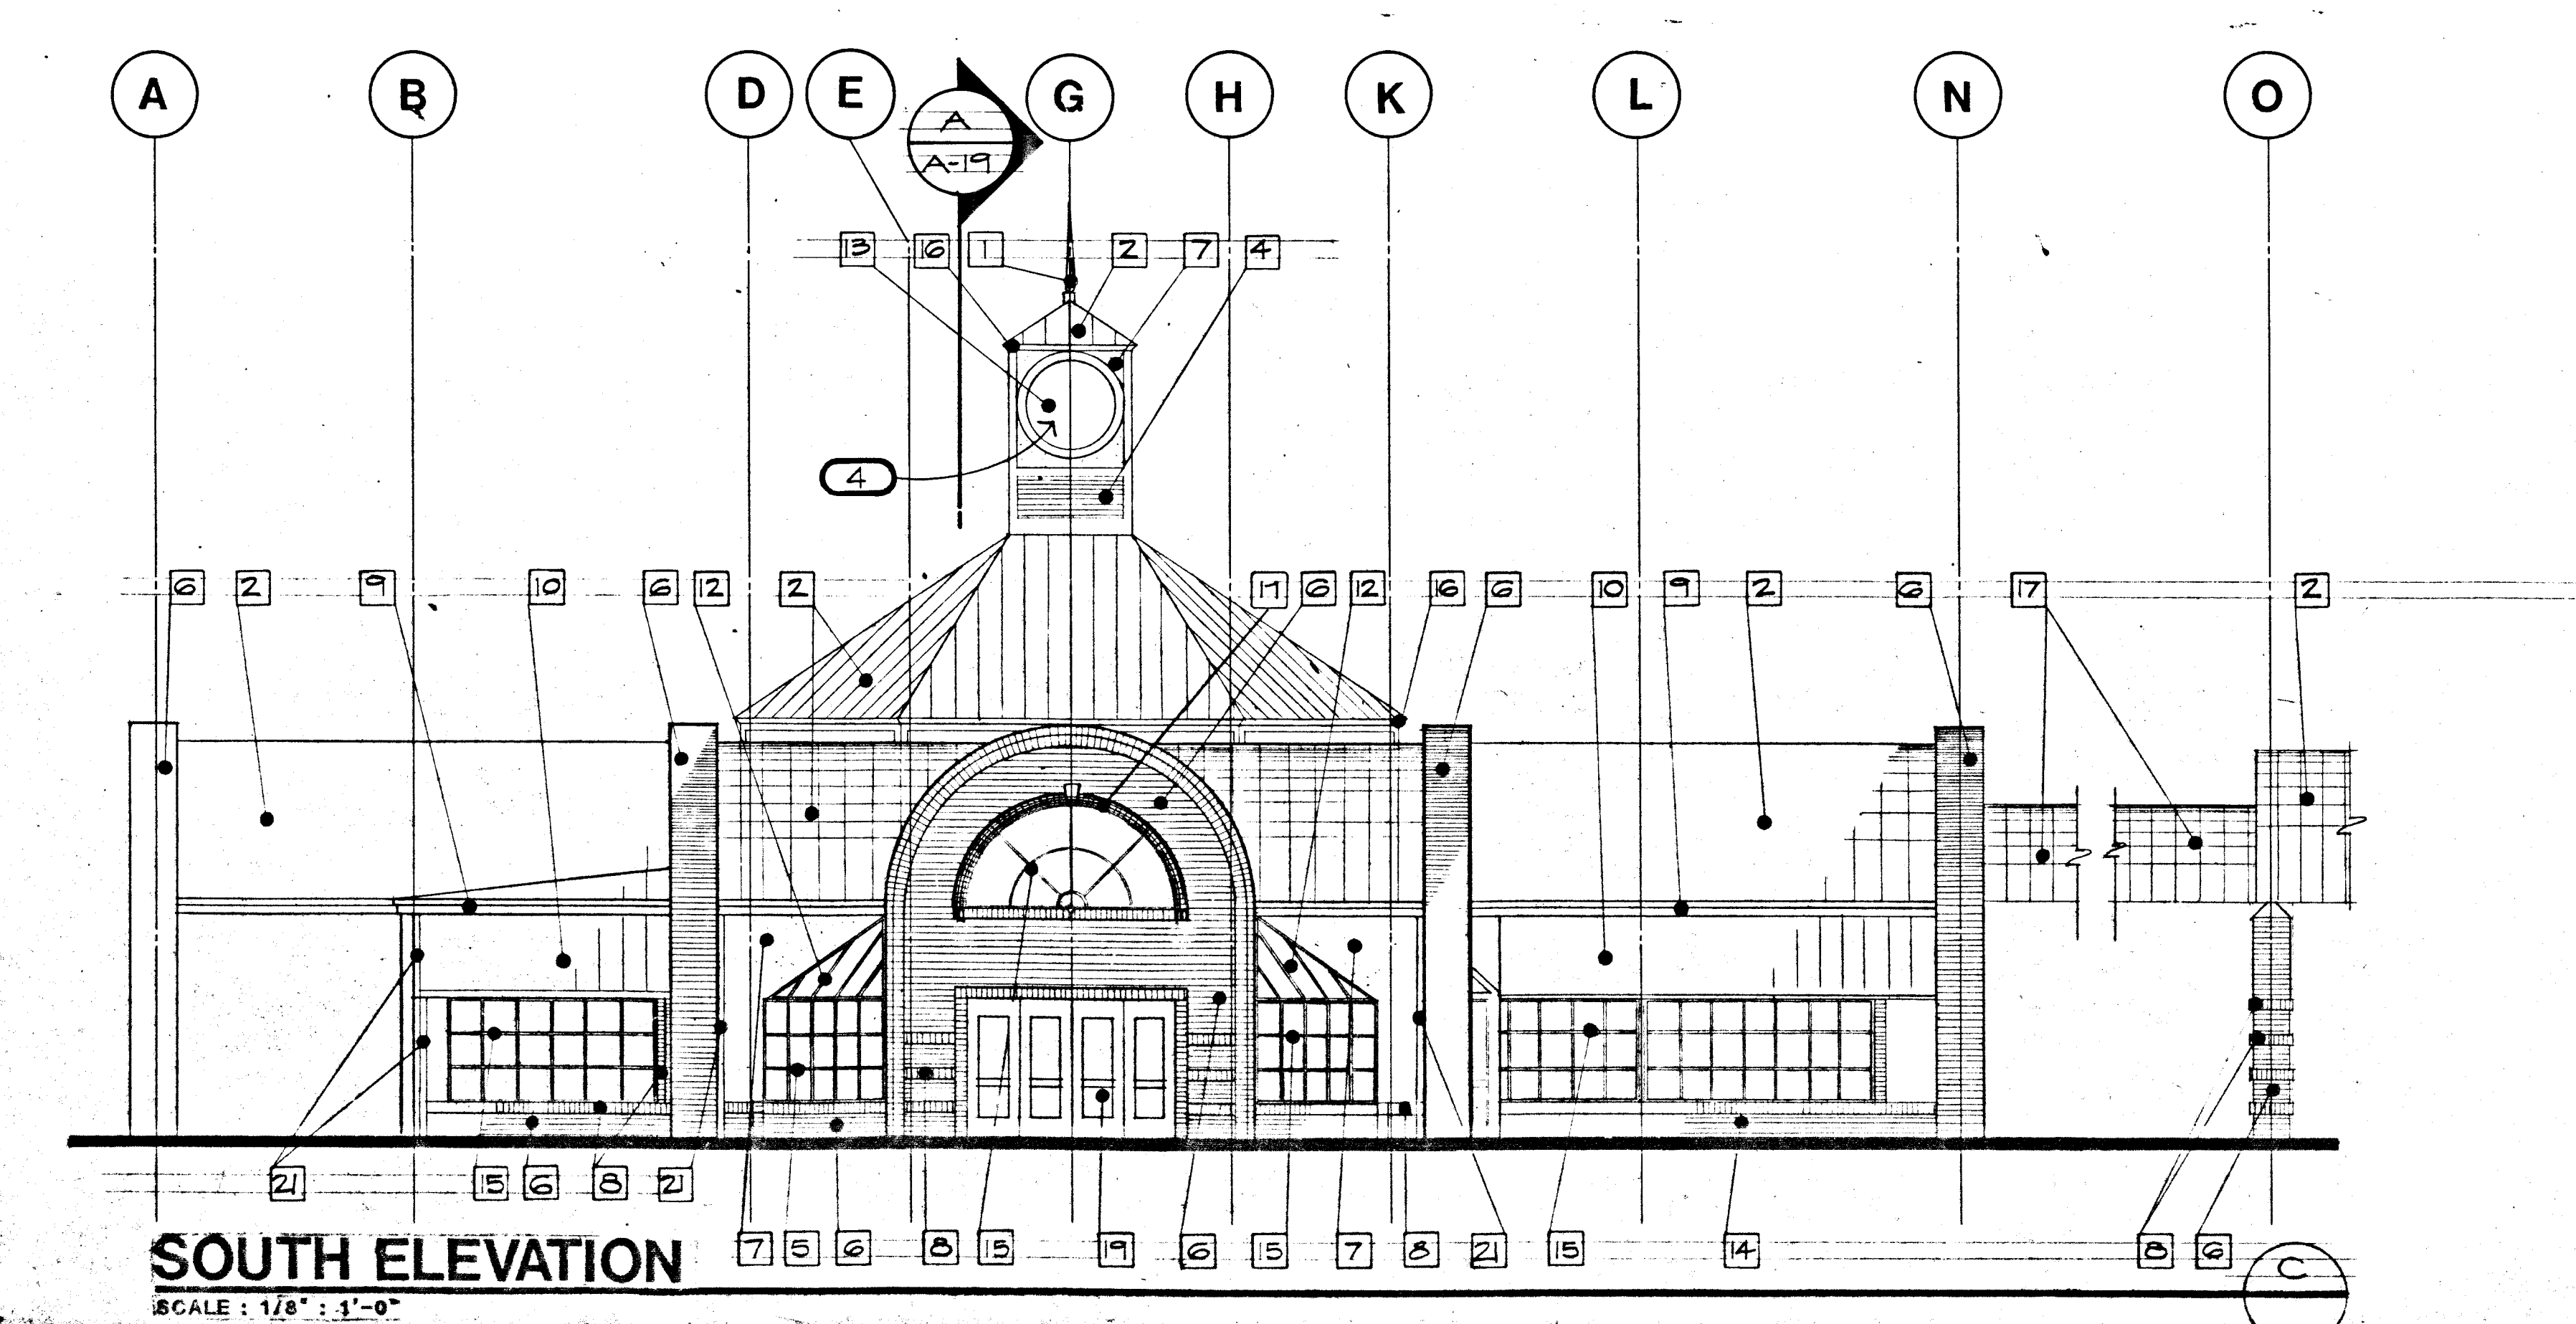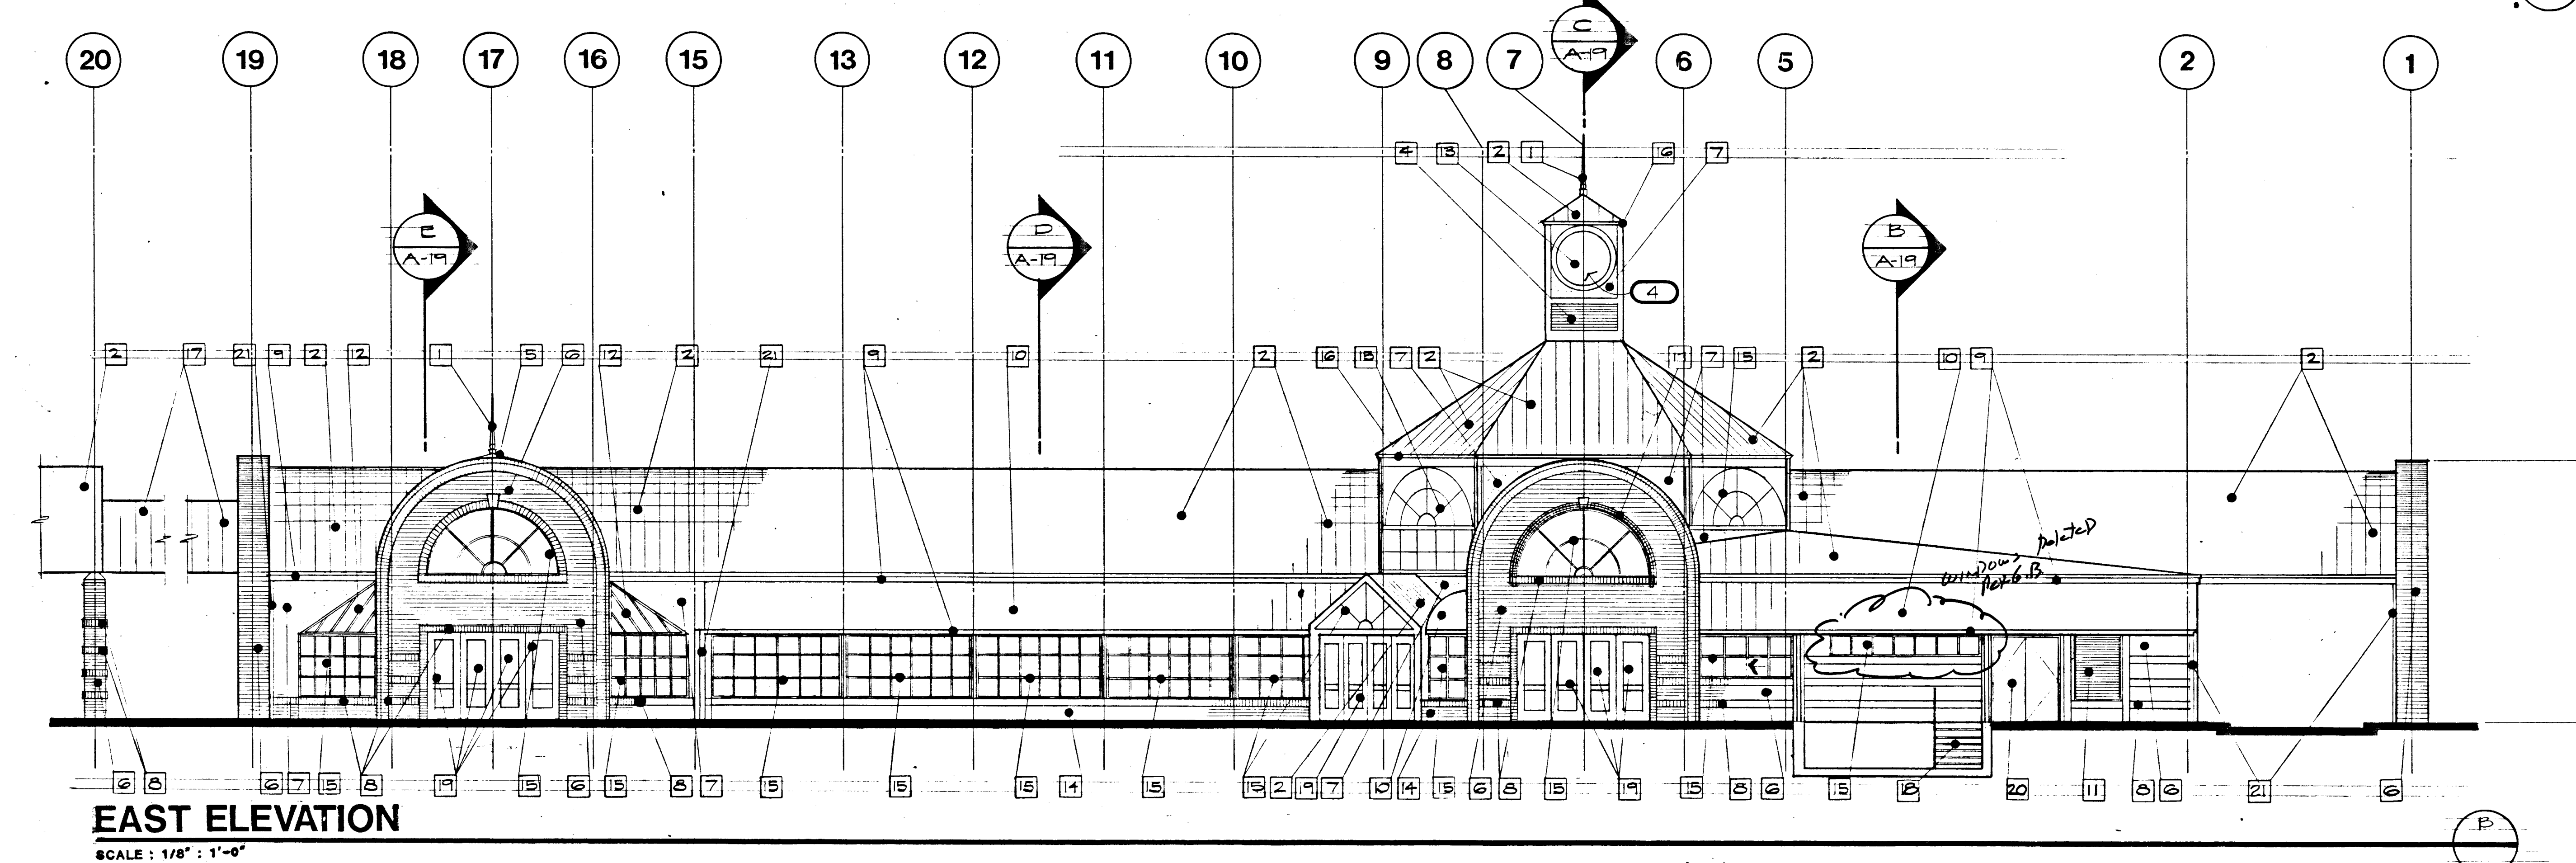

DOBROUSKY KITTRELL GARLOCK
Architects
1100 CAMDEN ST. LAS VEGAS, NEVADA 89101
(702) 461-1418

City of Las Vegas
Transportation
Downtown
Las Vegas, Nevada

SHEET
A-18
27.4.65
REVISED
800-25