


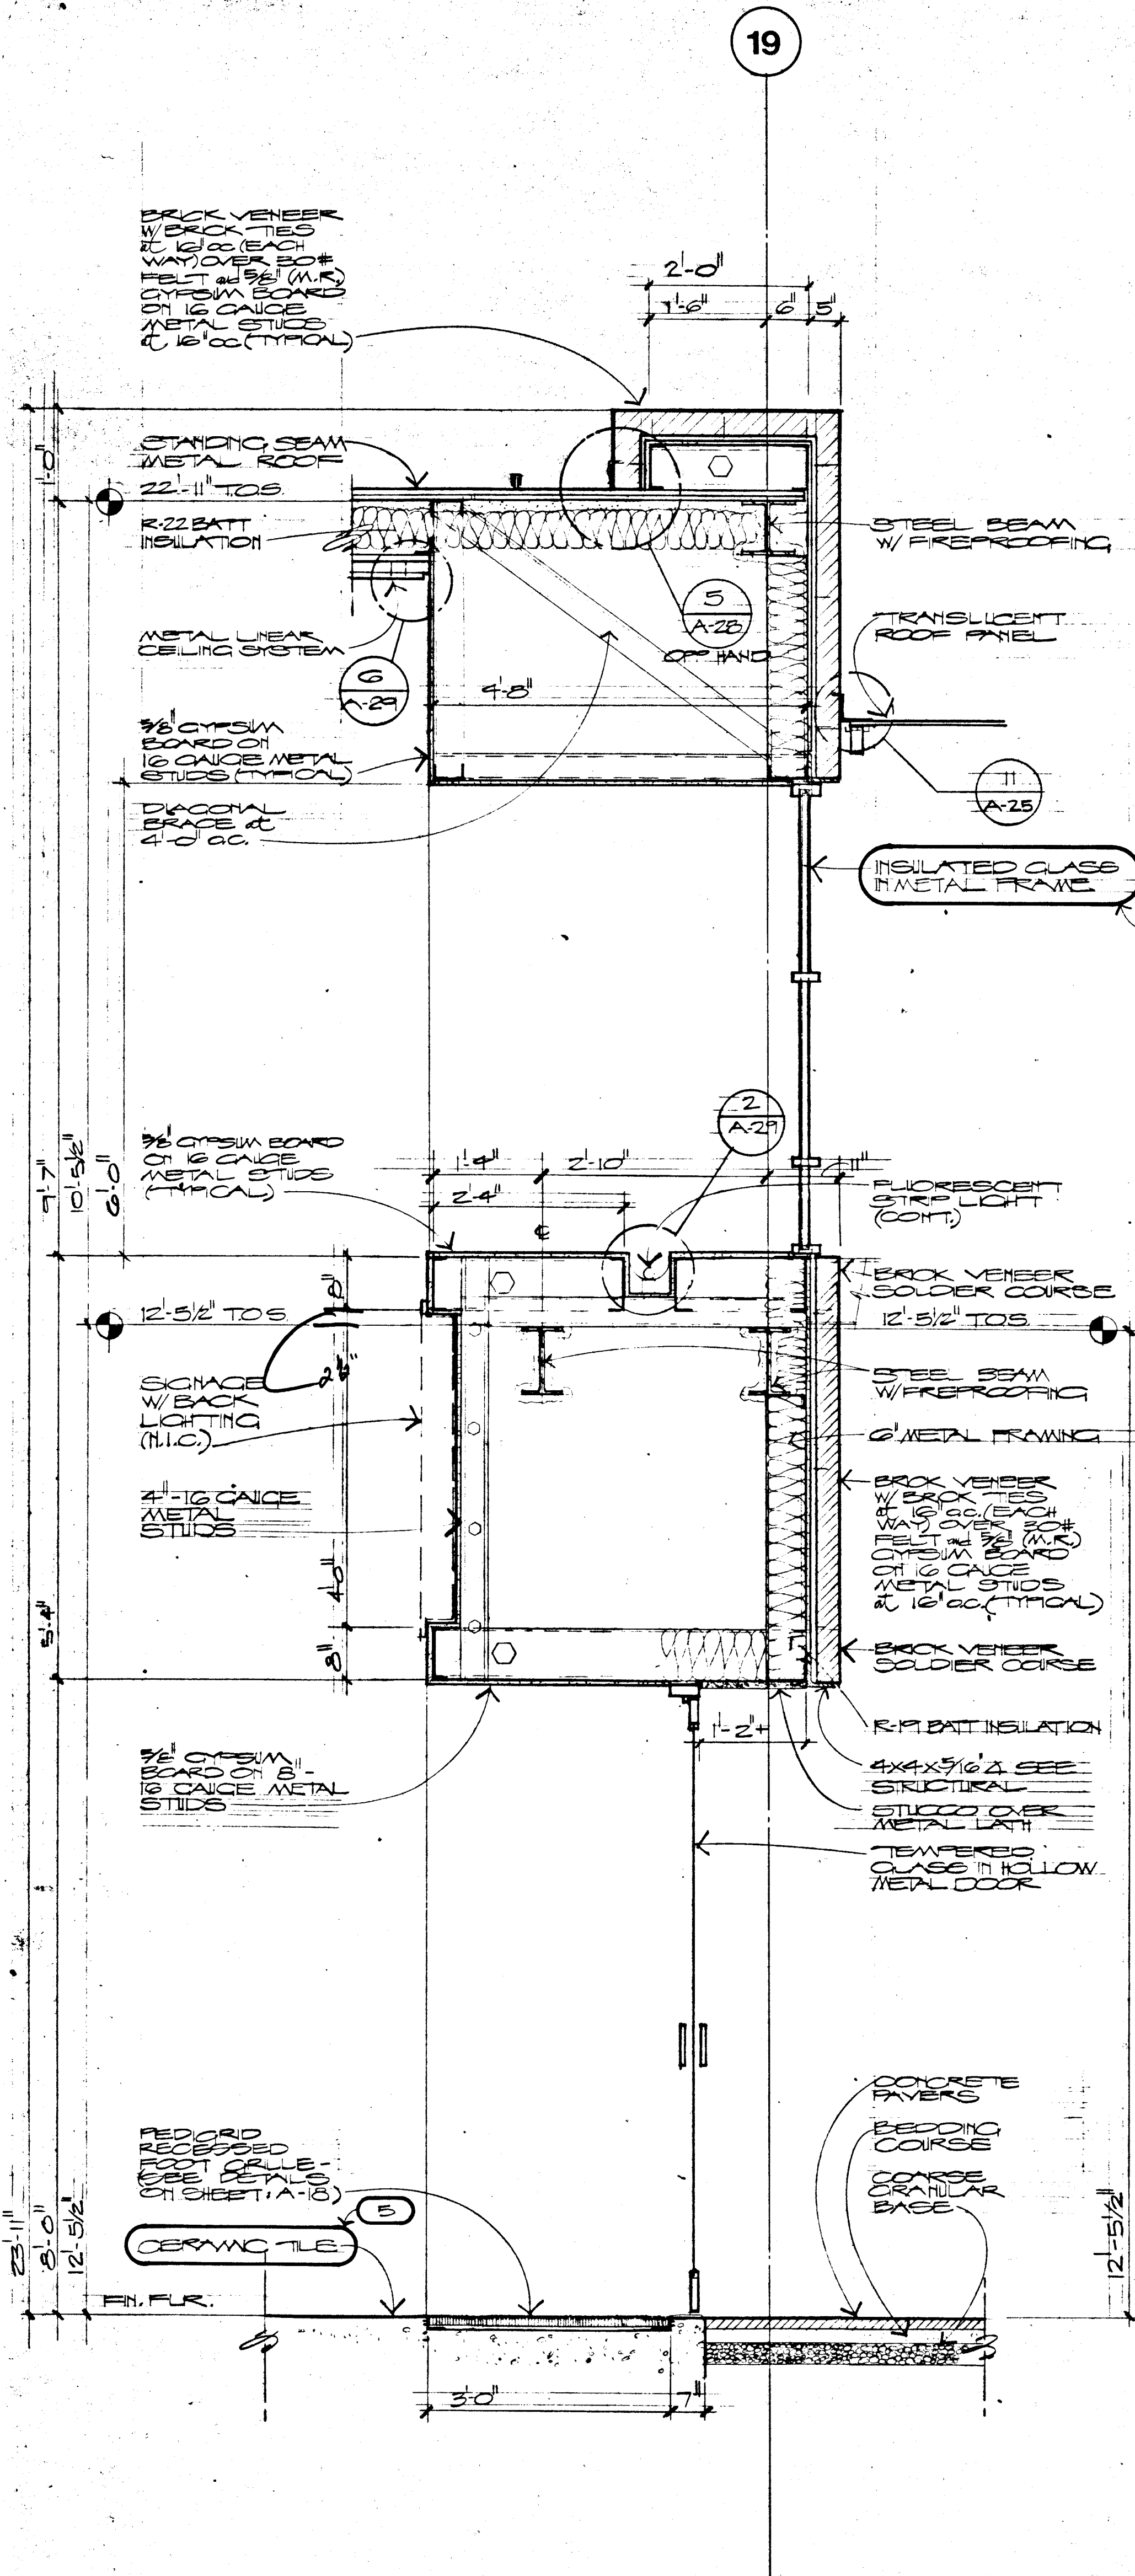


WALL SECTION

SCALE: 3/4" = 1'-0"

5
A-21

WALL SECTION

SCALE: 3/4" = 1'-0"

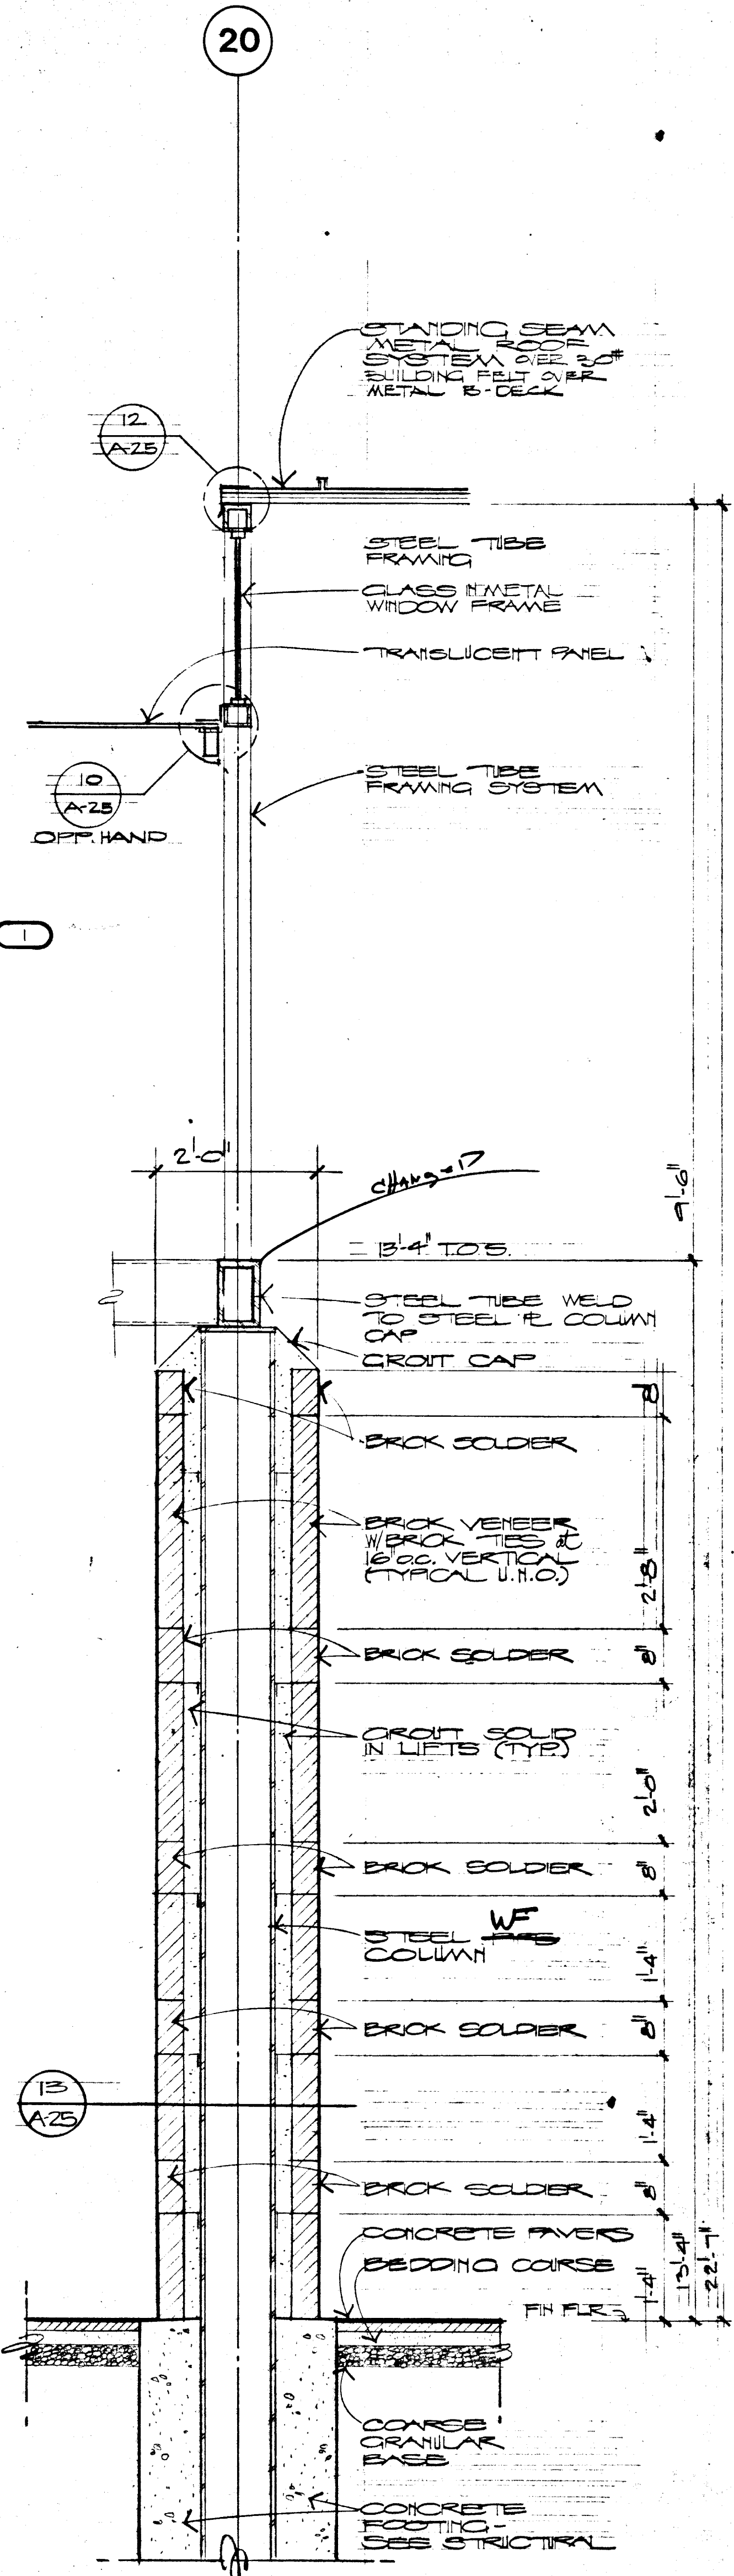


6
A-21

WALL SECTION

SCALE: 3/4" = 1'-0"

B

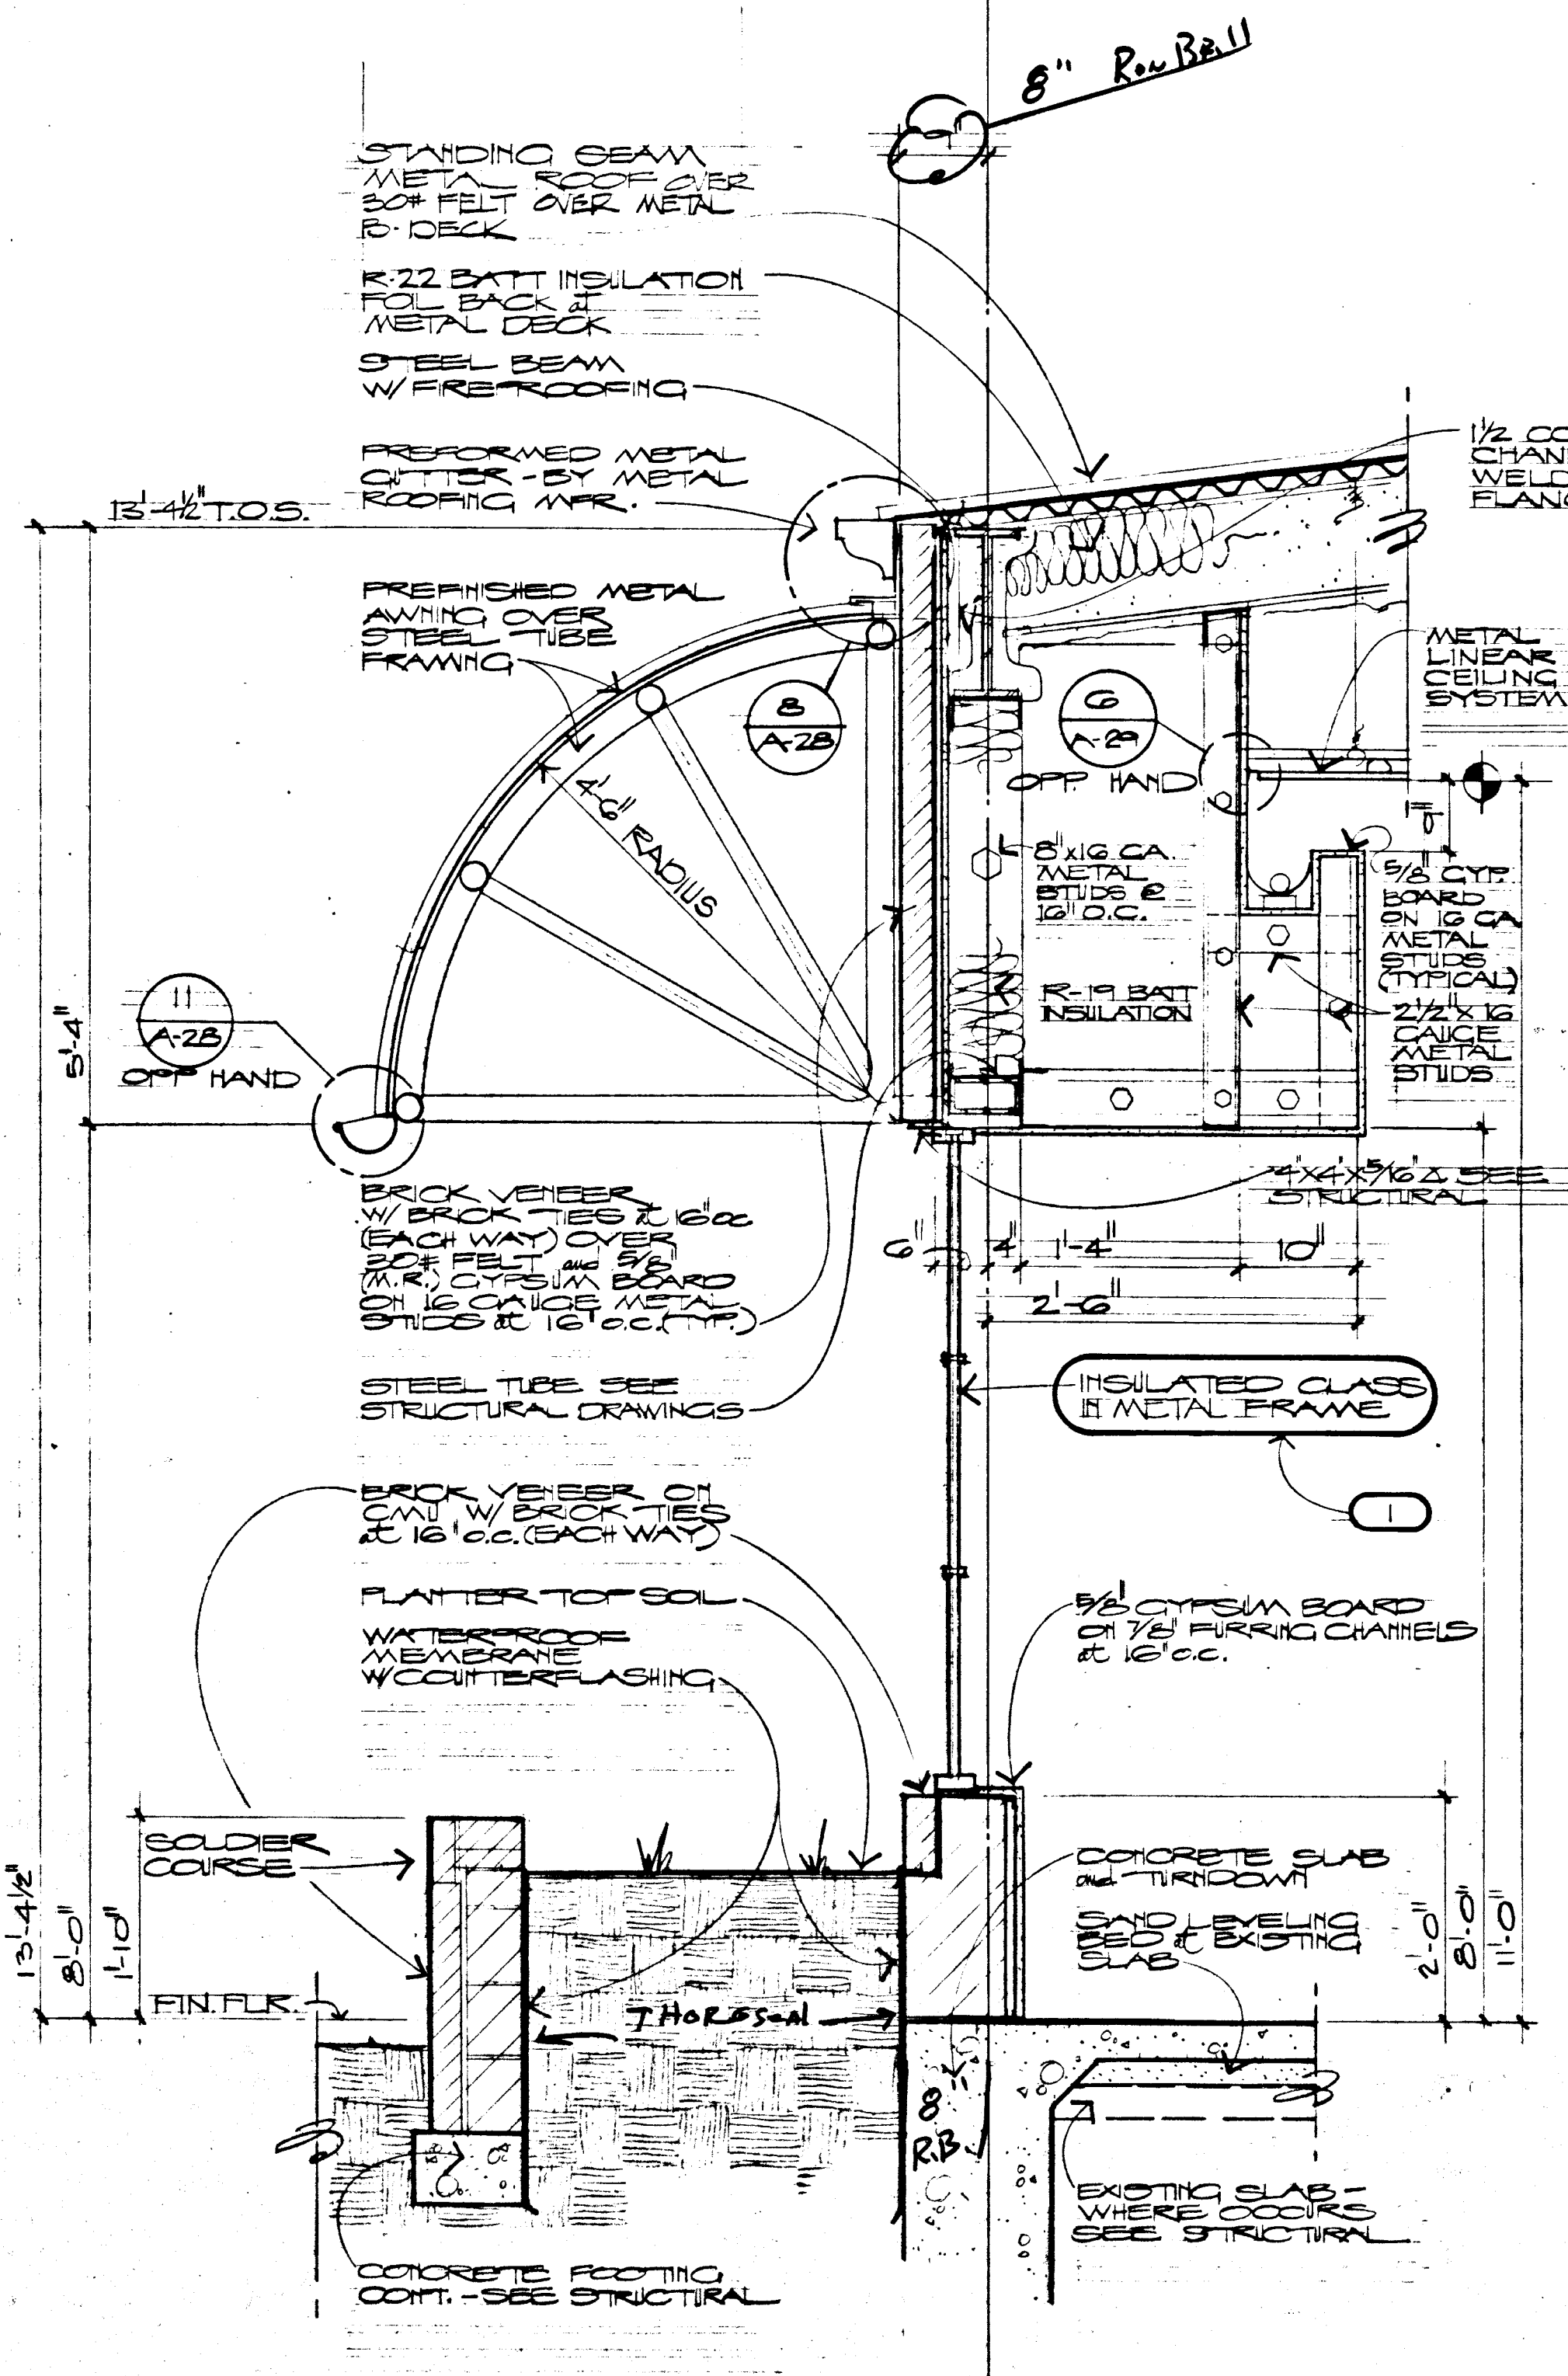


7
A-21

WALL SECTION

SCALE: 3/4" = 1'-0"

H

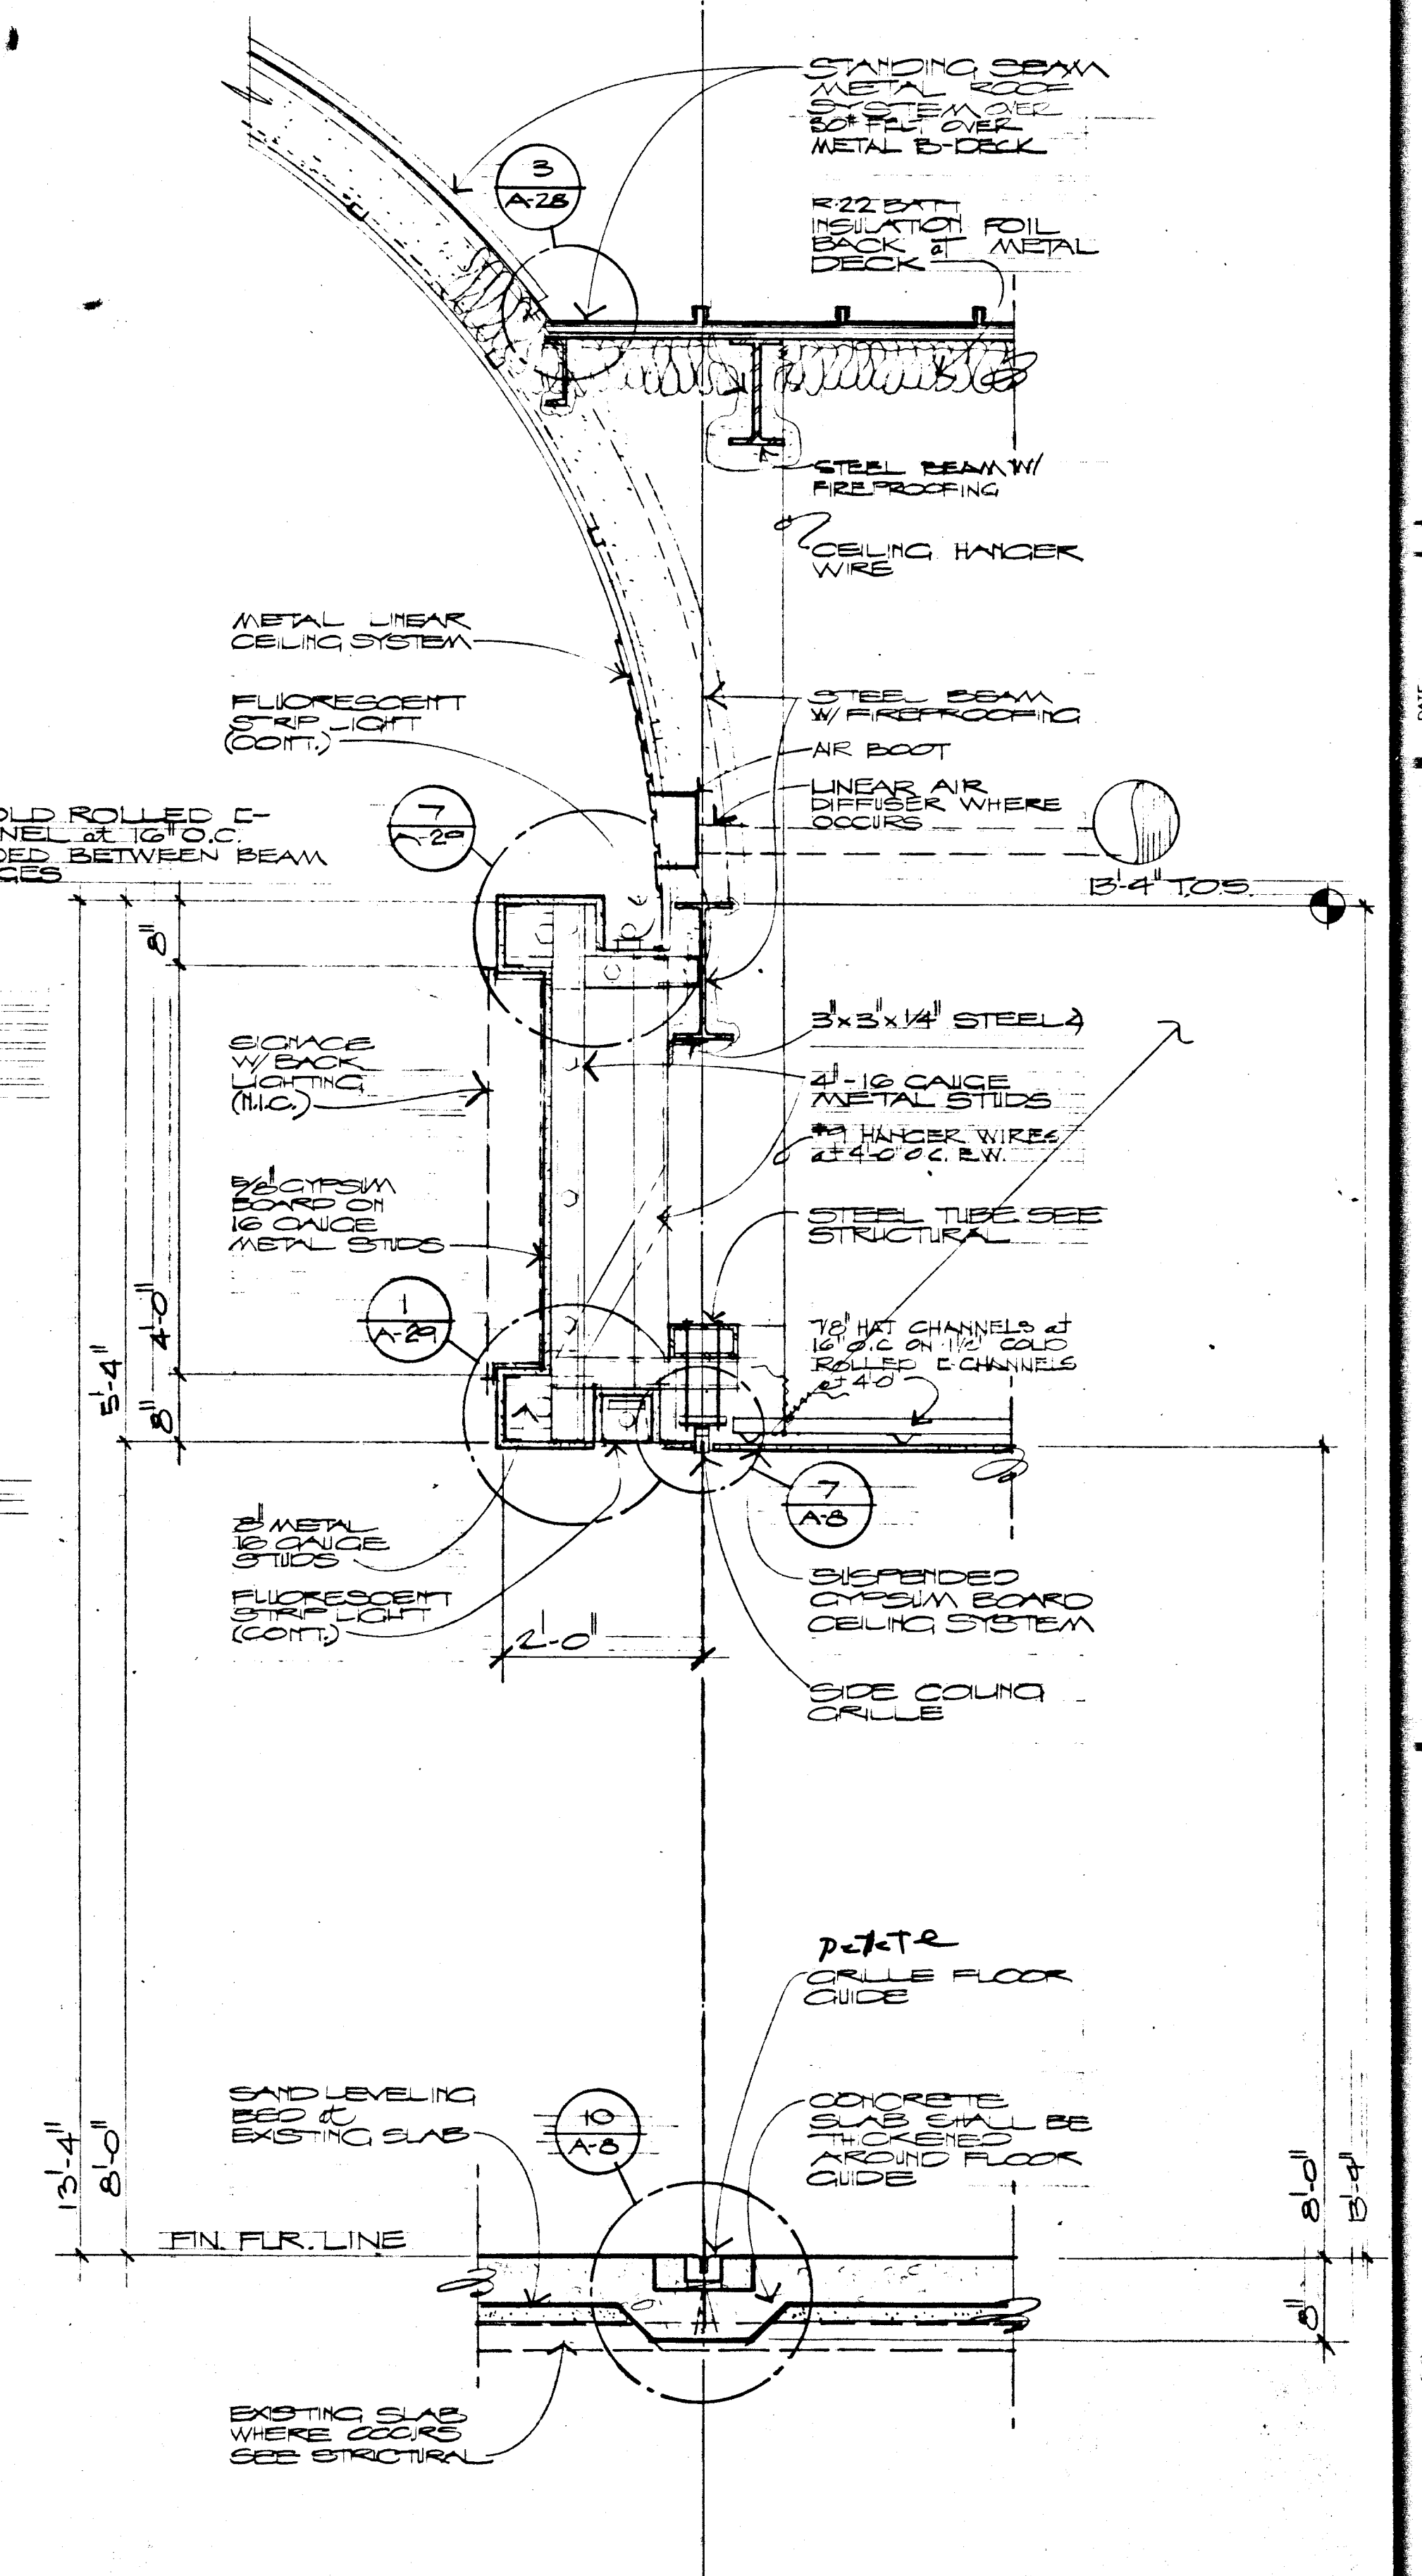

8
A-21

NOTES:

ALL METAL STUDS WILL BE 16 GAUGE UNLESS OTHERWISE NOTED
ALL STUD CONNECTIONS SHALL BE WELDED
SEE SHEET A-26 FOR WALL TYPES AND CONSTRUCTION NOTES

- ① DEDUCTIVE BID ITEM #1 (I)
IN LIEU OF METAL WINDOW FRAMES AS SHOWN, SUBSTITUTE ALUMINUM WINDOW FRAMES
- ⑤ DEDUCTIVE BID ITEM #5 (I)
IN LIEU OF CERAMIC (QUARRY) TILE FLOOR AND BASE AS SHOWN, SUBSTITUTE VINYL TILE FLOOR AND BASE.
FOR DETAILED DESCRIPTION SEE SPECIFICATIONS.

DOB RUSKY KITTEL GARLOCK
Architects
1000 S. LAS VEGAS BLVD., SUITE 200
LAS VEGAS, NEVADA 89101
(702) 733-0438

City of Las Vegas
Transportation Center
Las Vegas, Nevada

A-21
30 of 65
4/47