
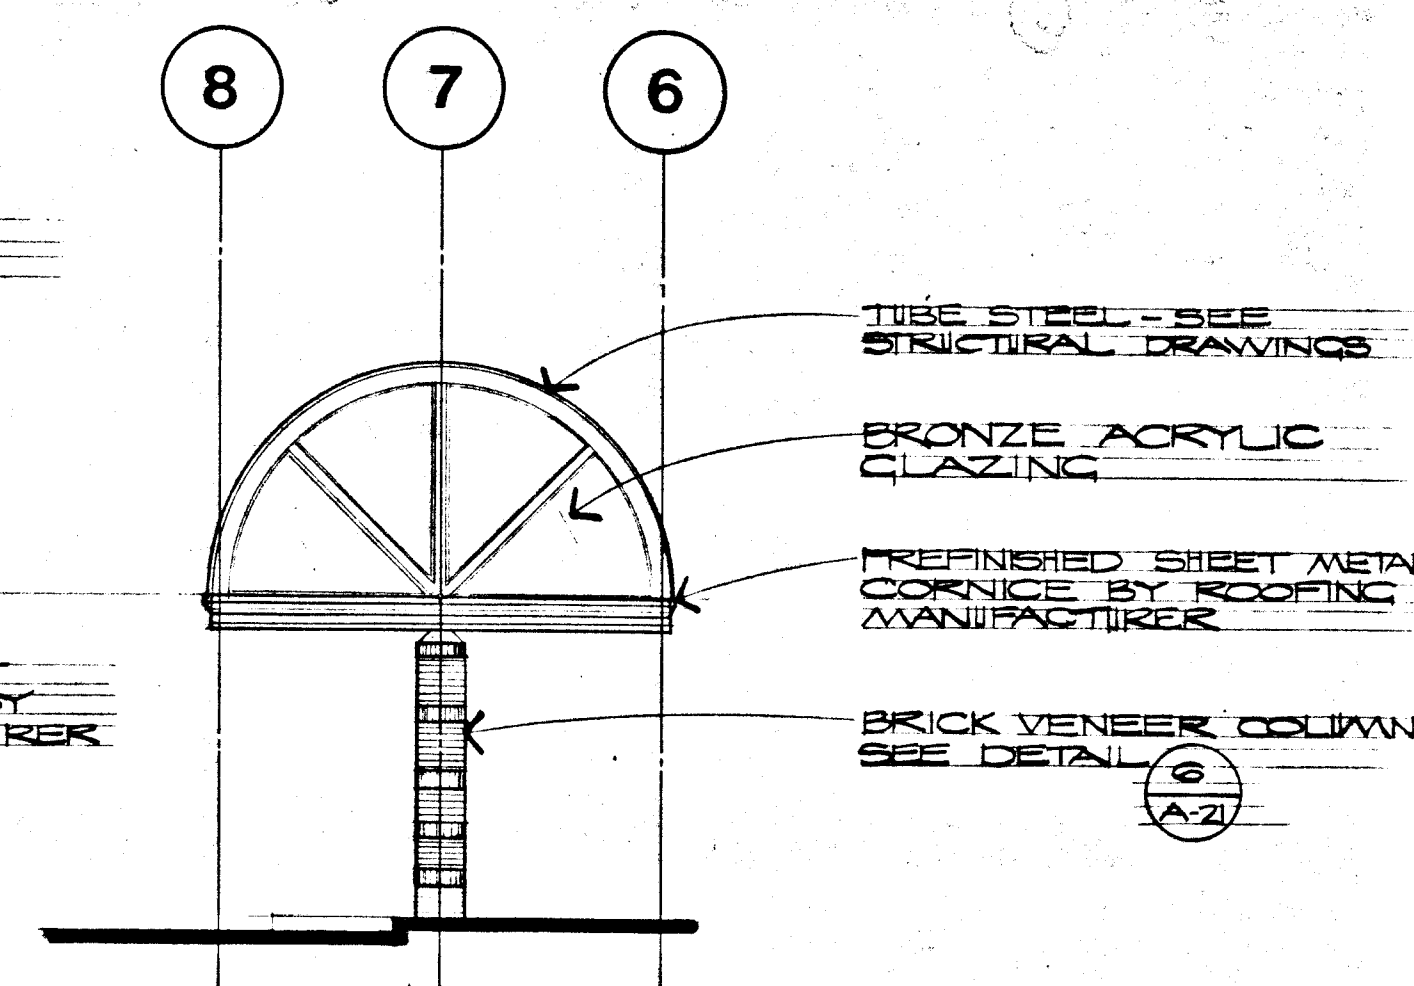


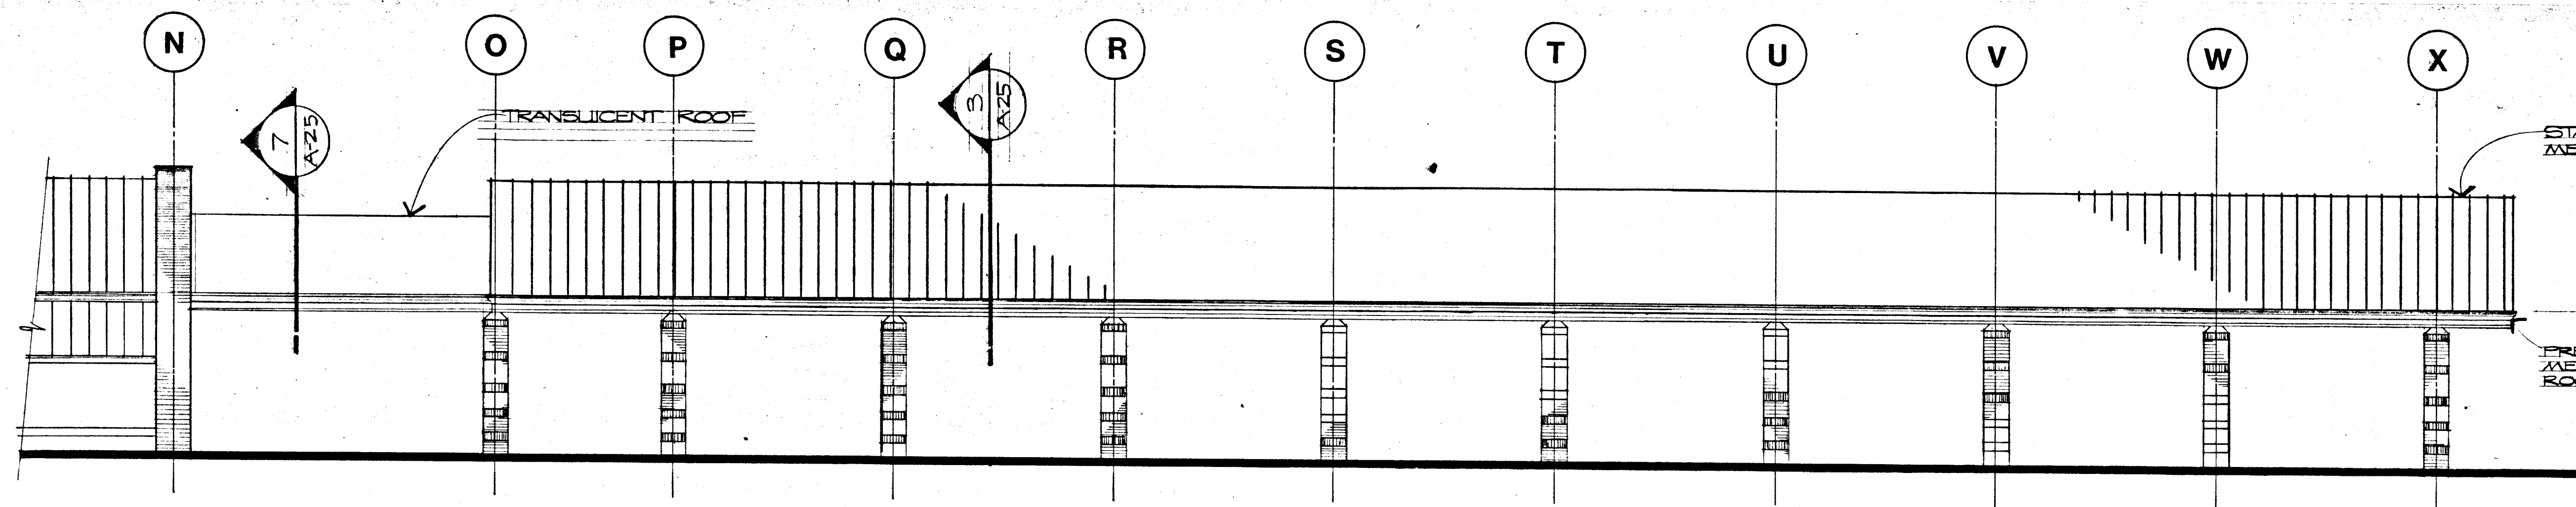


EAST CANOPY ELEVATION (SOUTH CANOPY SIMILAR)

SCALE: 1/8" = 1'-0"


END ELEVATION

SCALE: 1/8" = 1'-0"

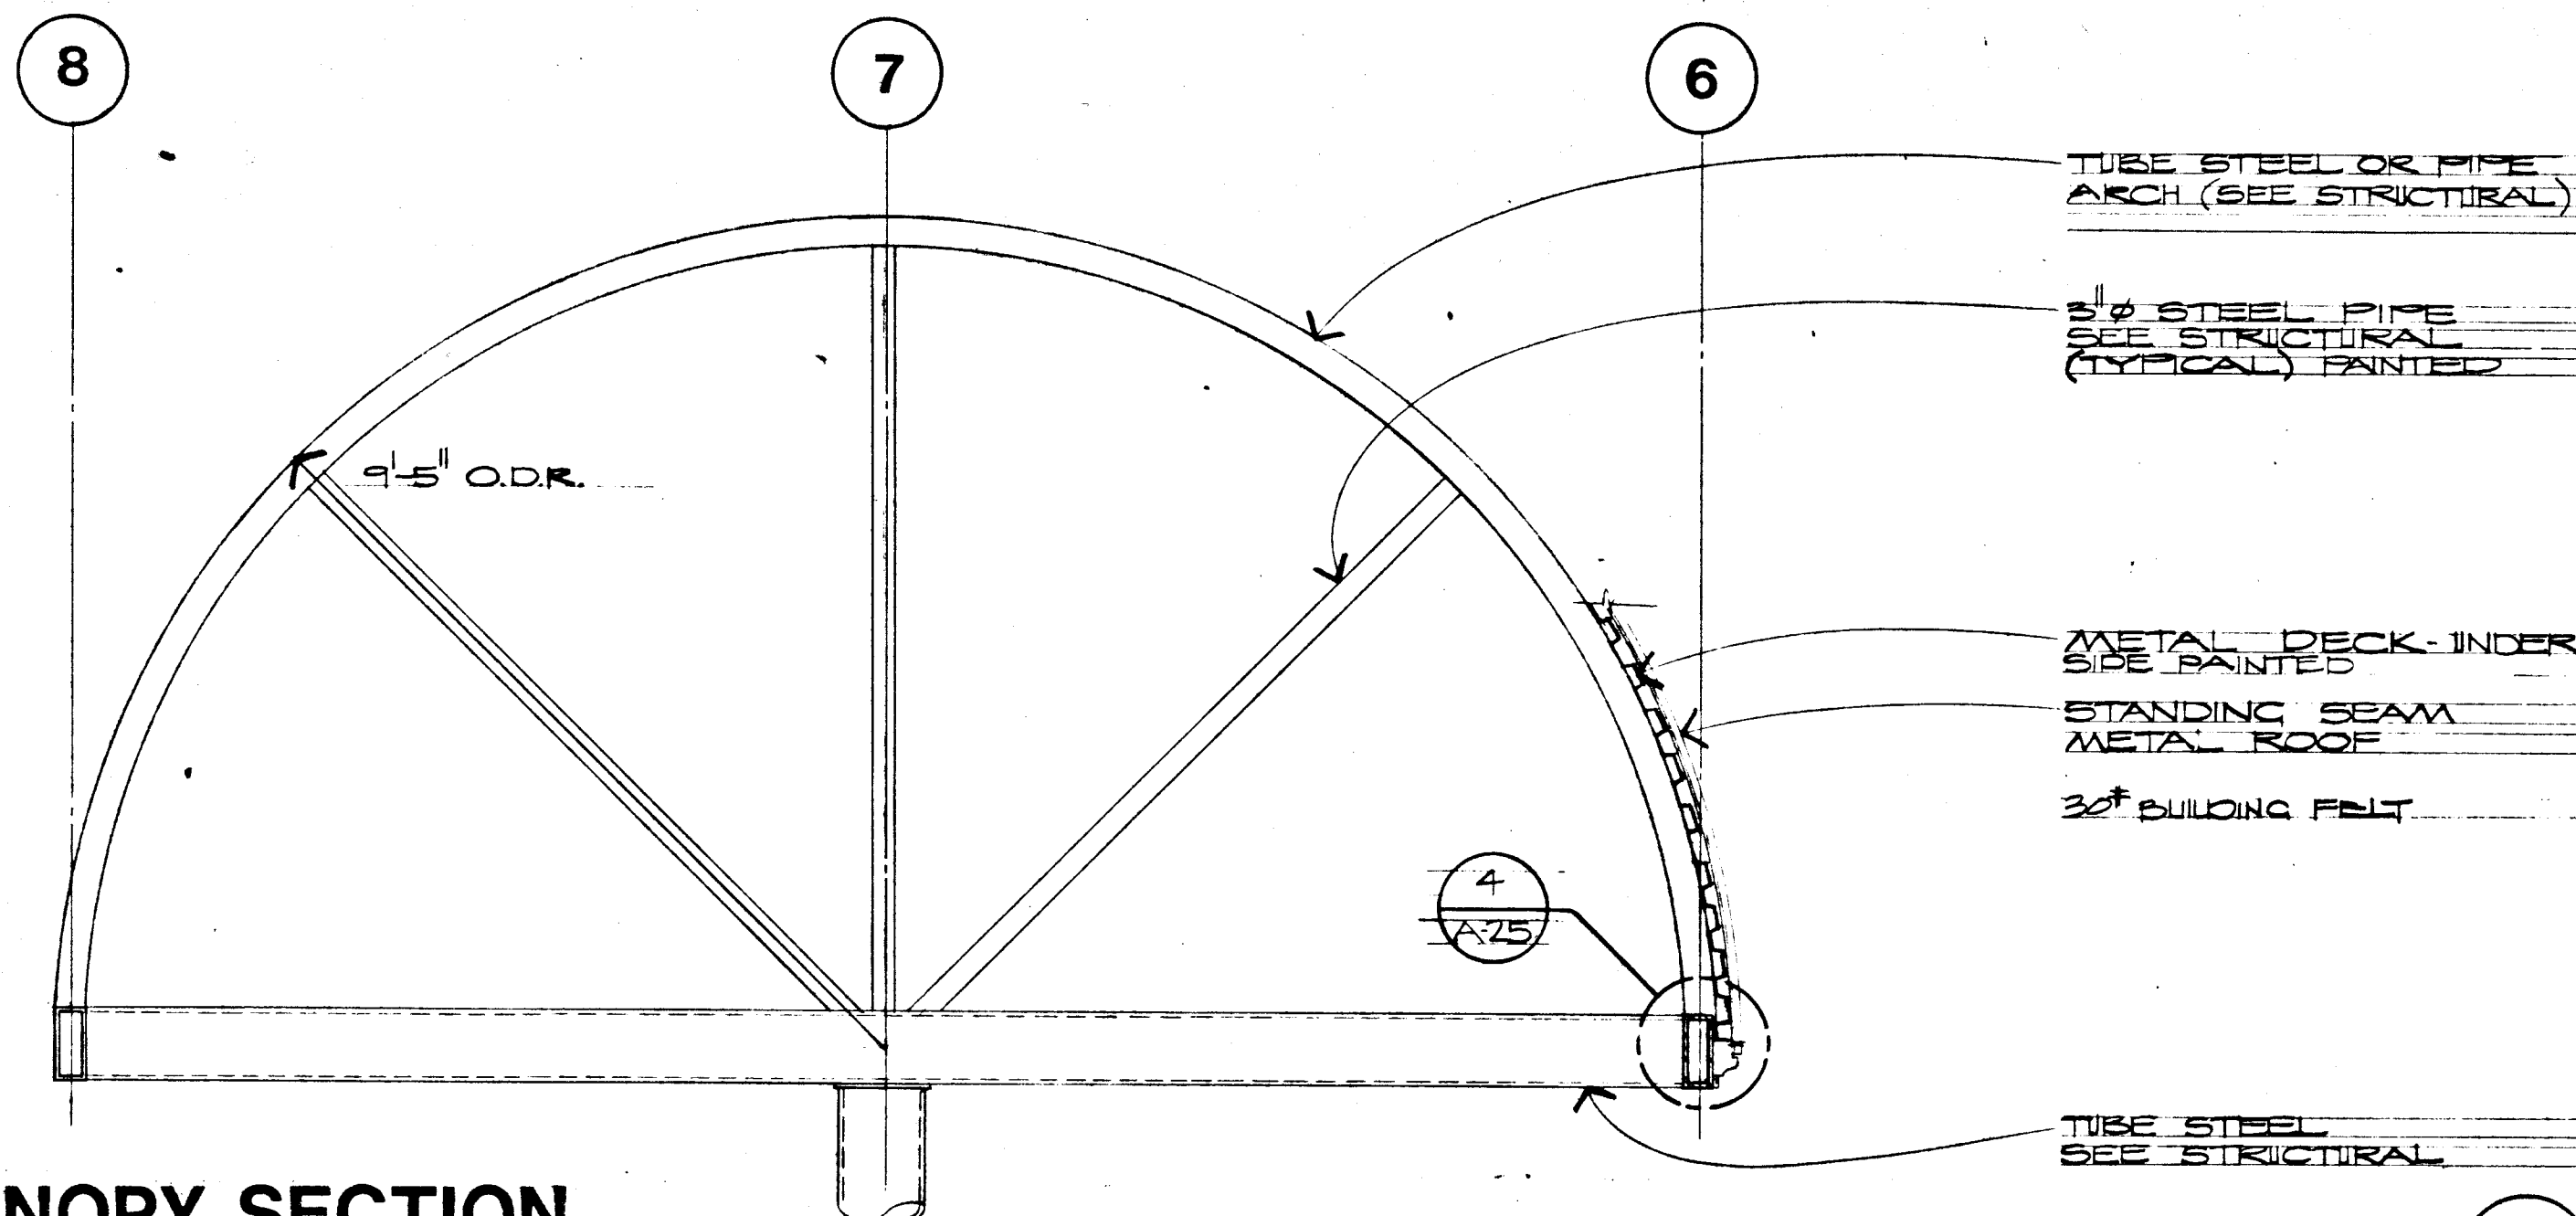


CANOPY SECTION

SCALE: 1/2" = 1'-0"

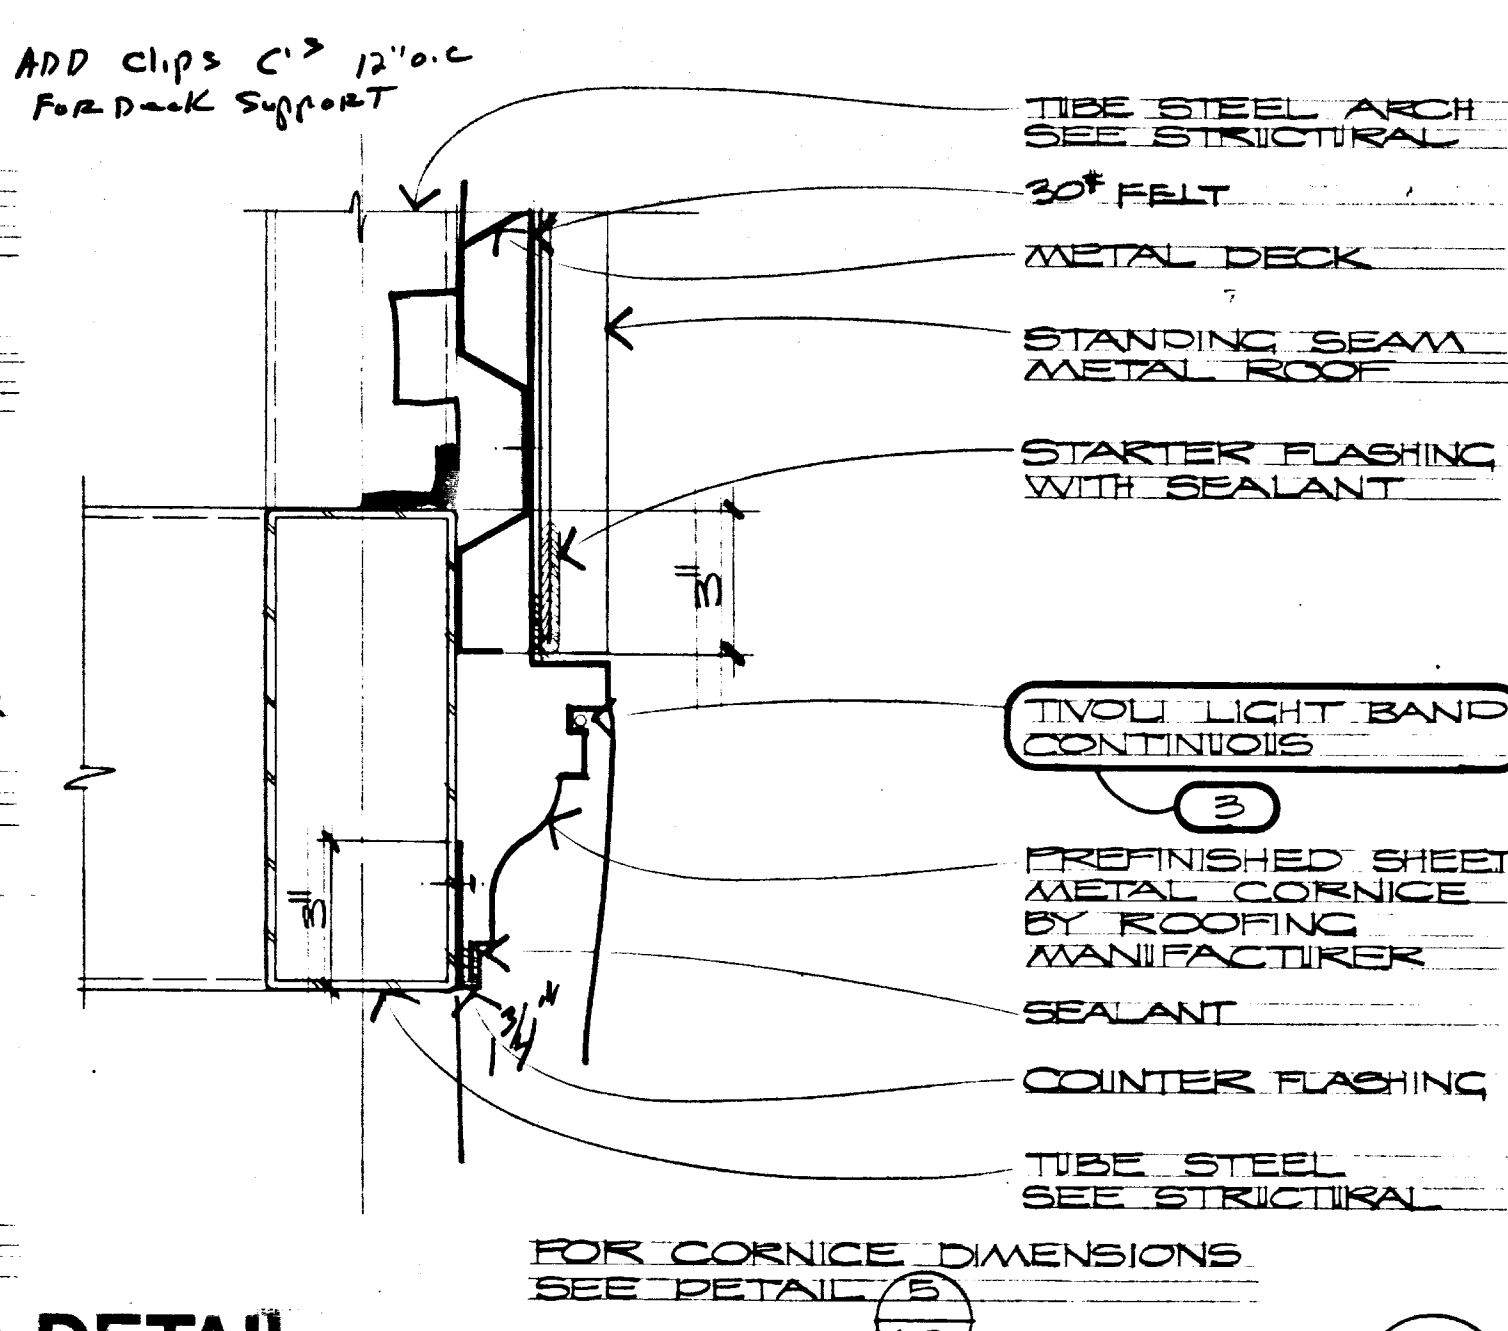


DETAIL

SCALE: 3" = 1'-0"

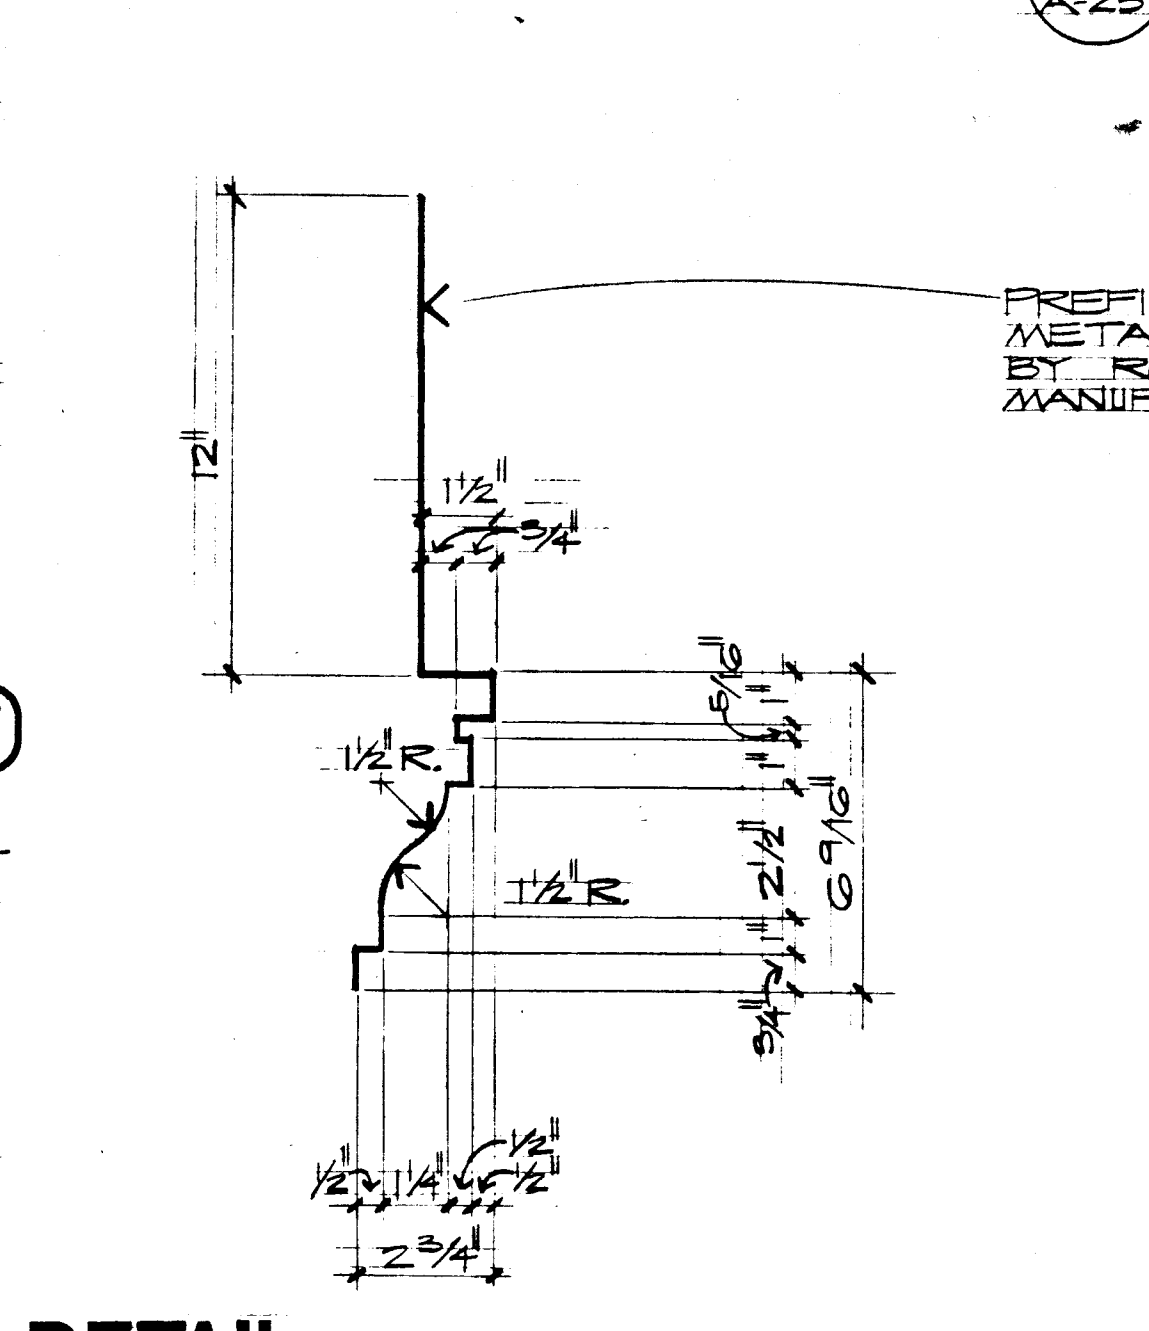


DETAIL

SCALE: 3" = 1'-0"

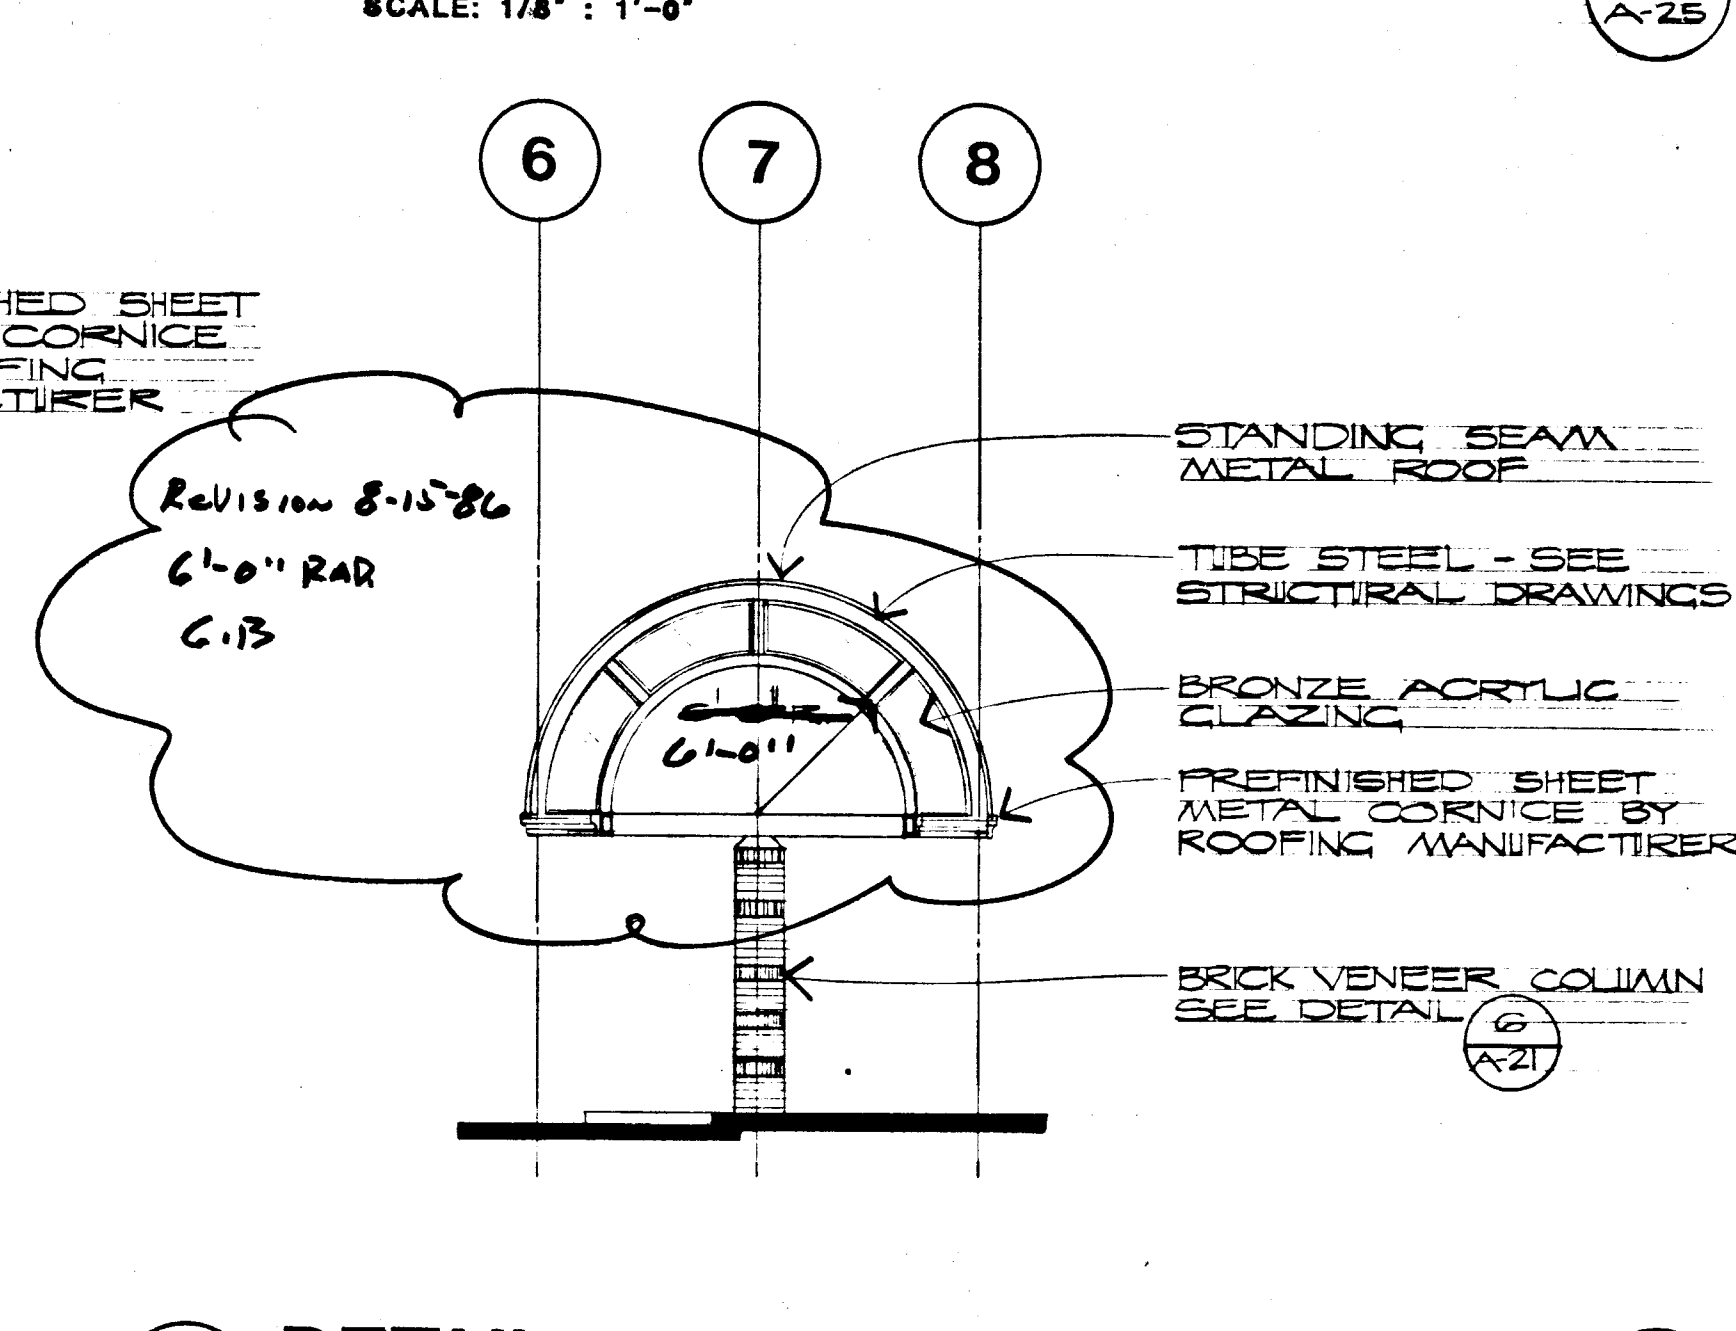


DETAIL

SCALE: 1/8" = 1'-0"

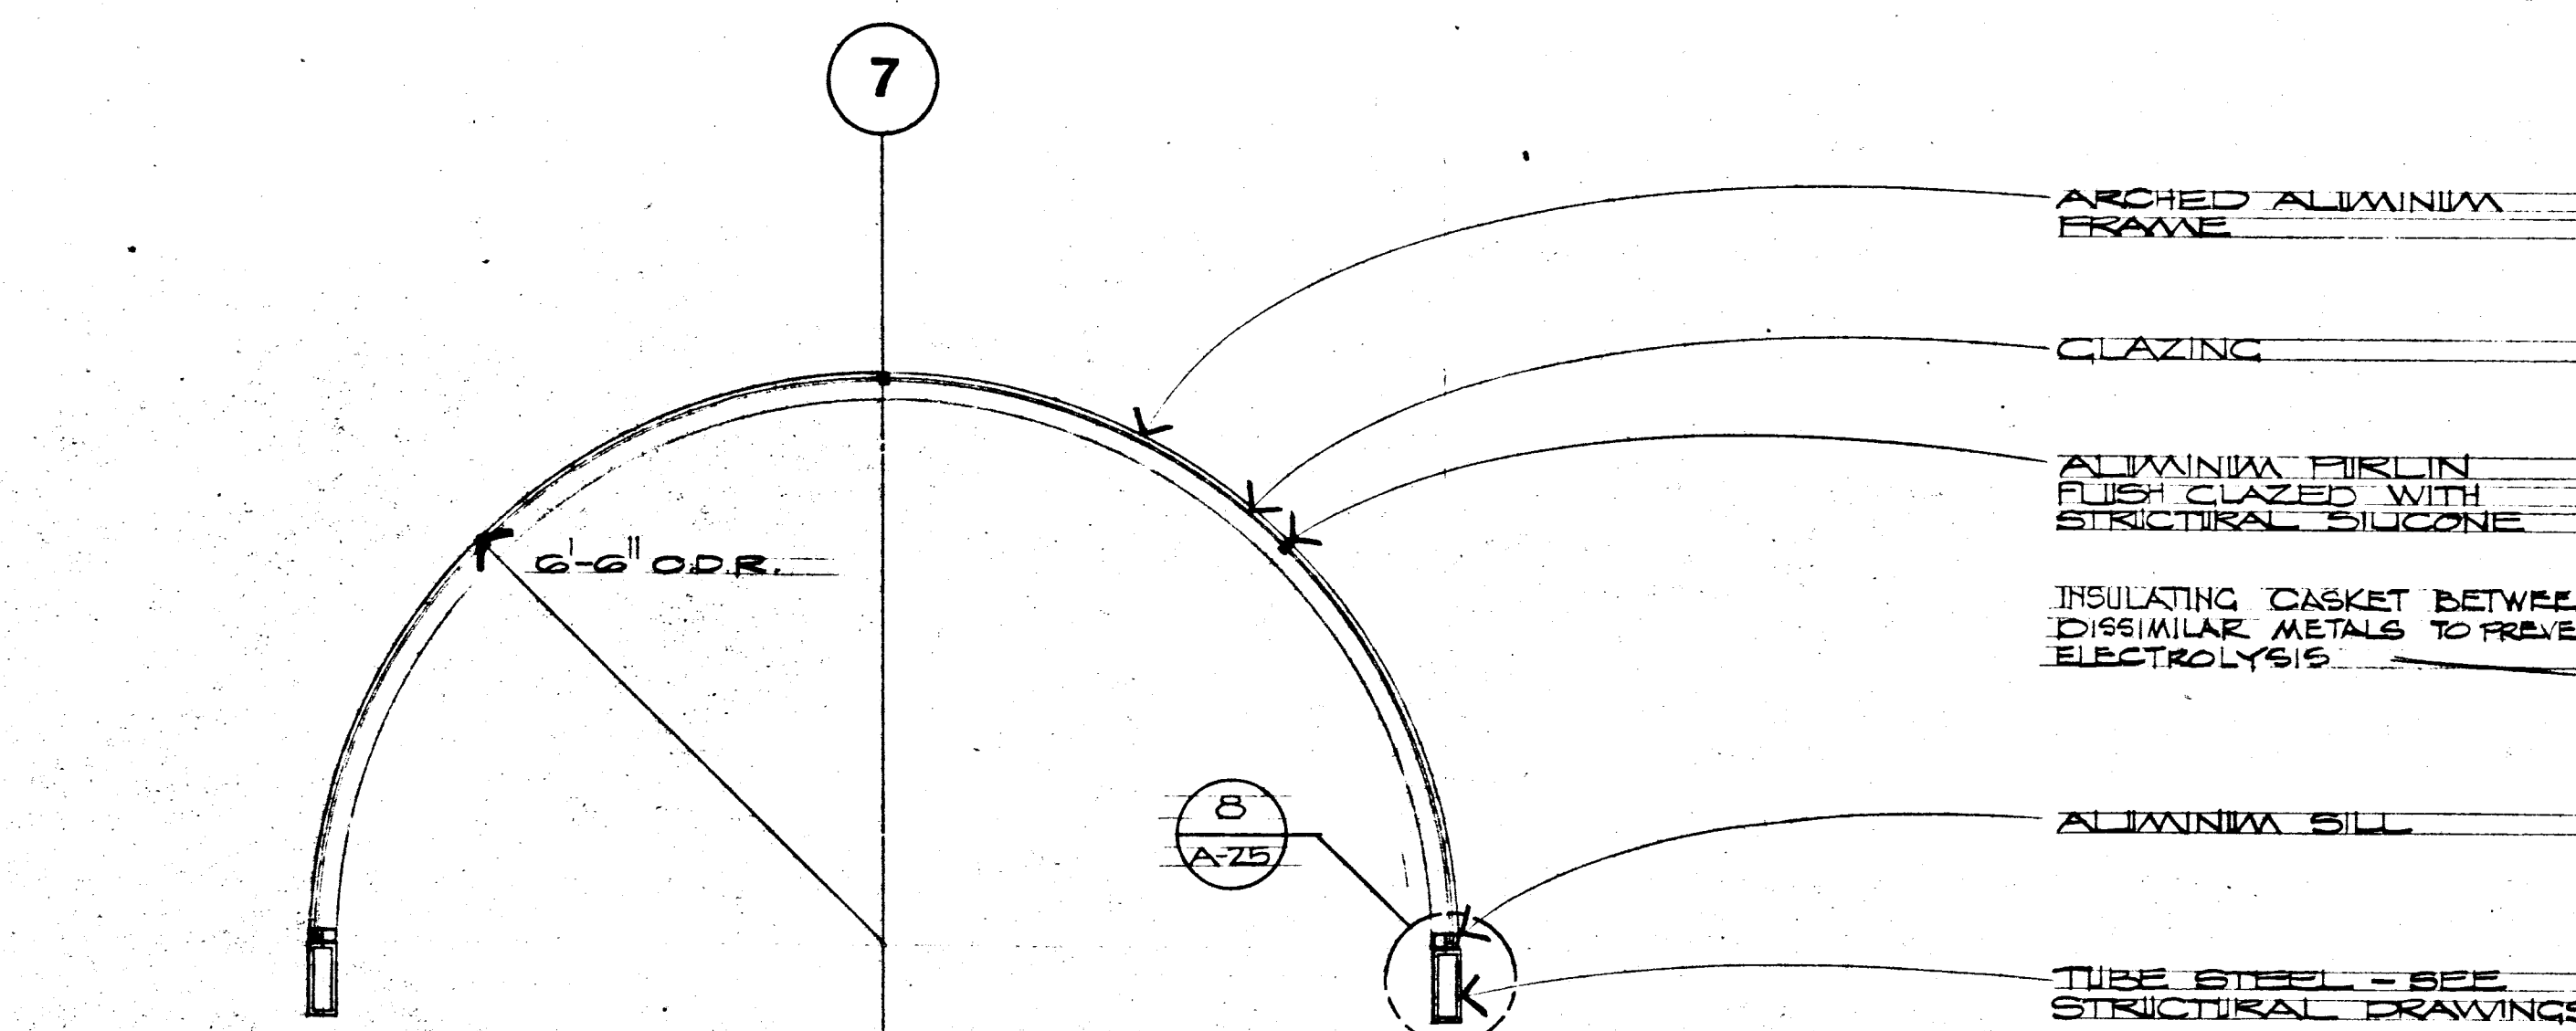


TRANSLUCENT CANOPY SECTION

SCALE: 1/2" = 1'-0"

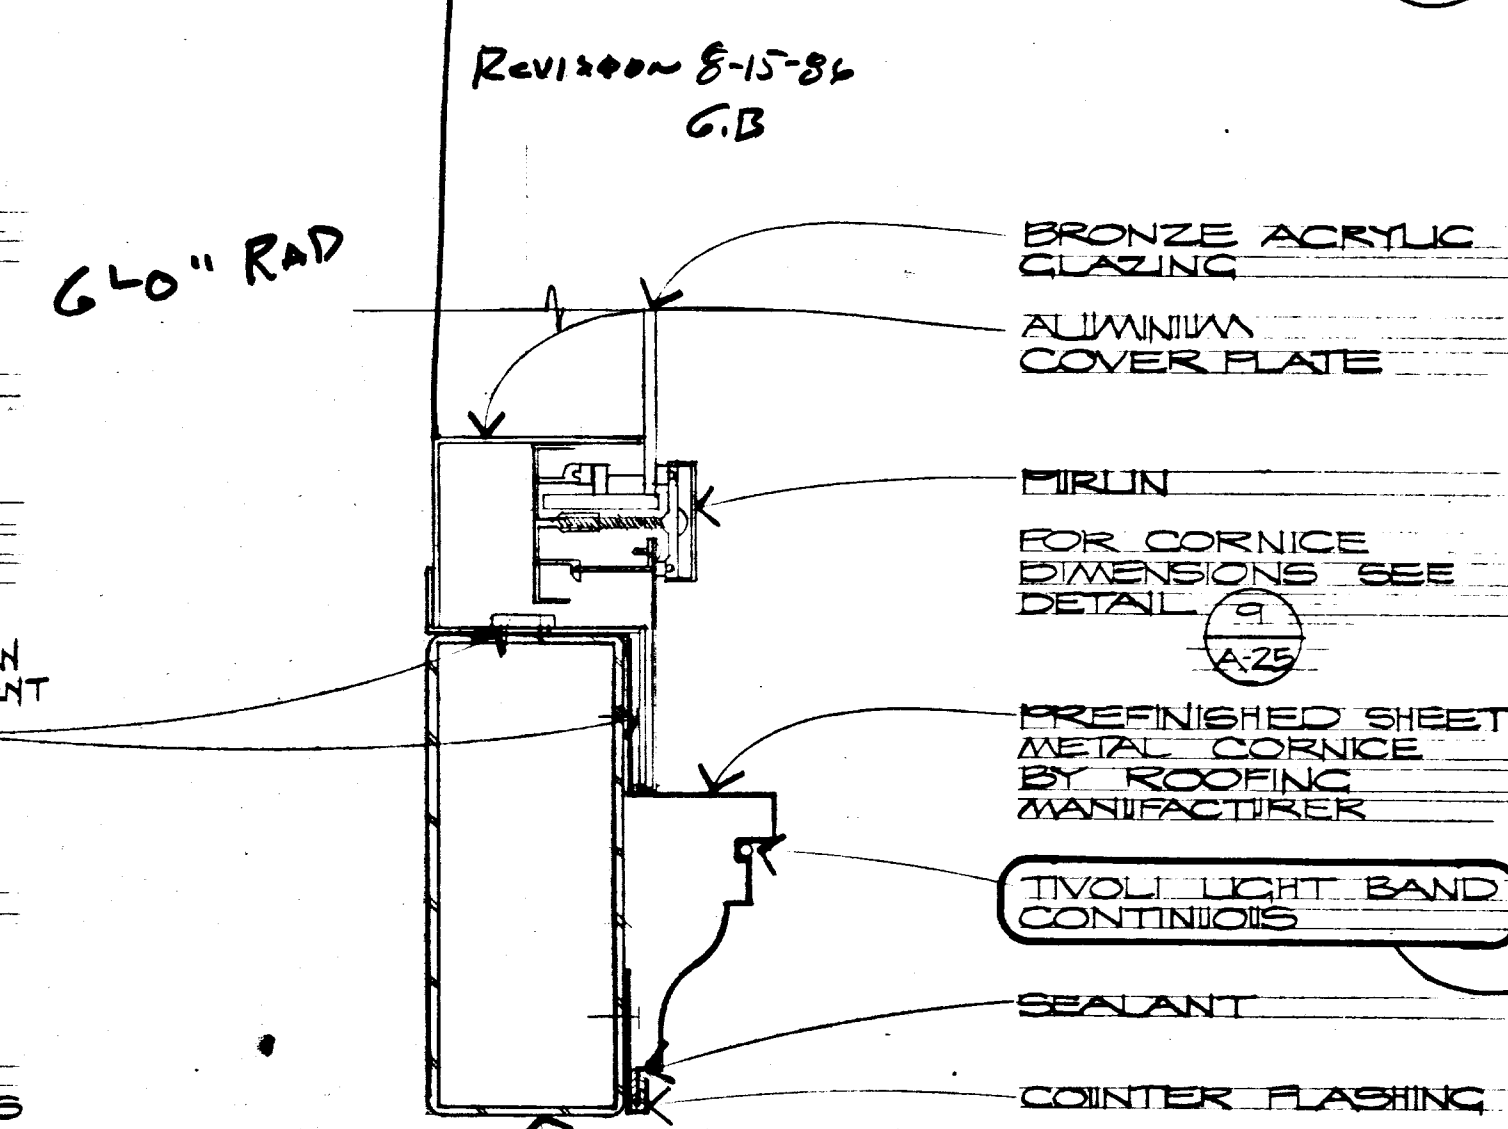


DETAIL

SCALE: 3" = 1'-0"

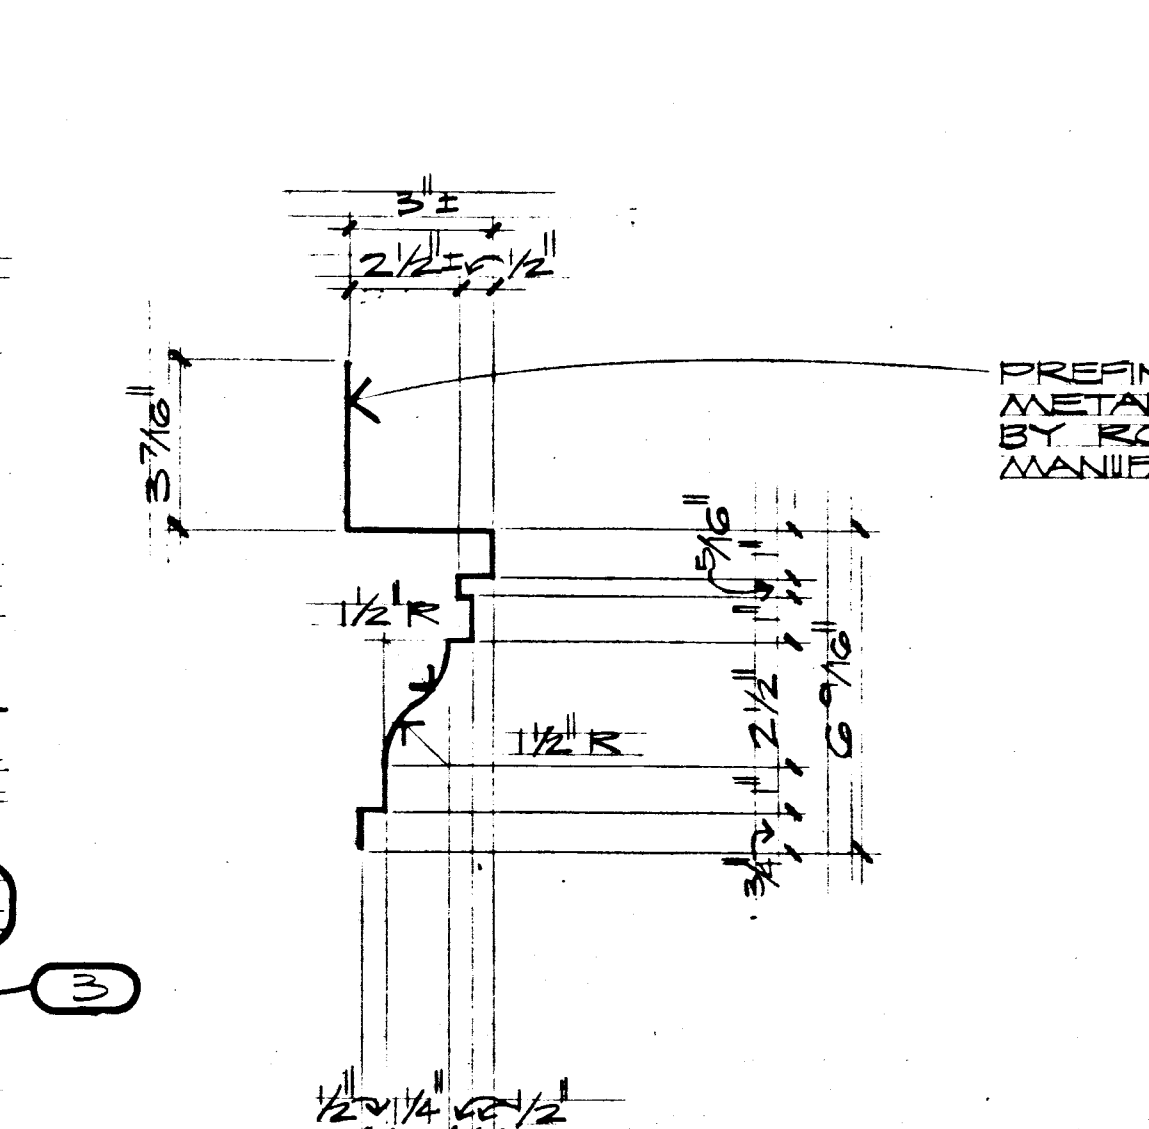


DETAIL

SCALE: 3" = 1'-0"

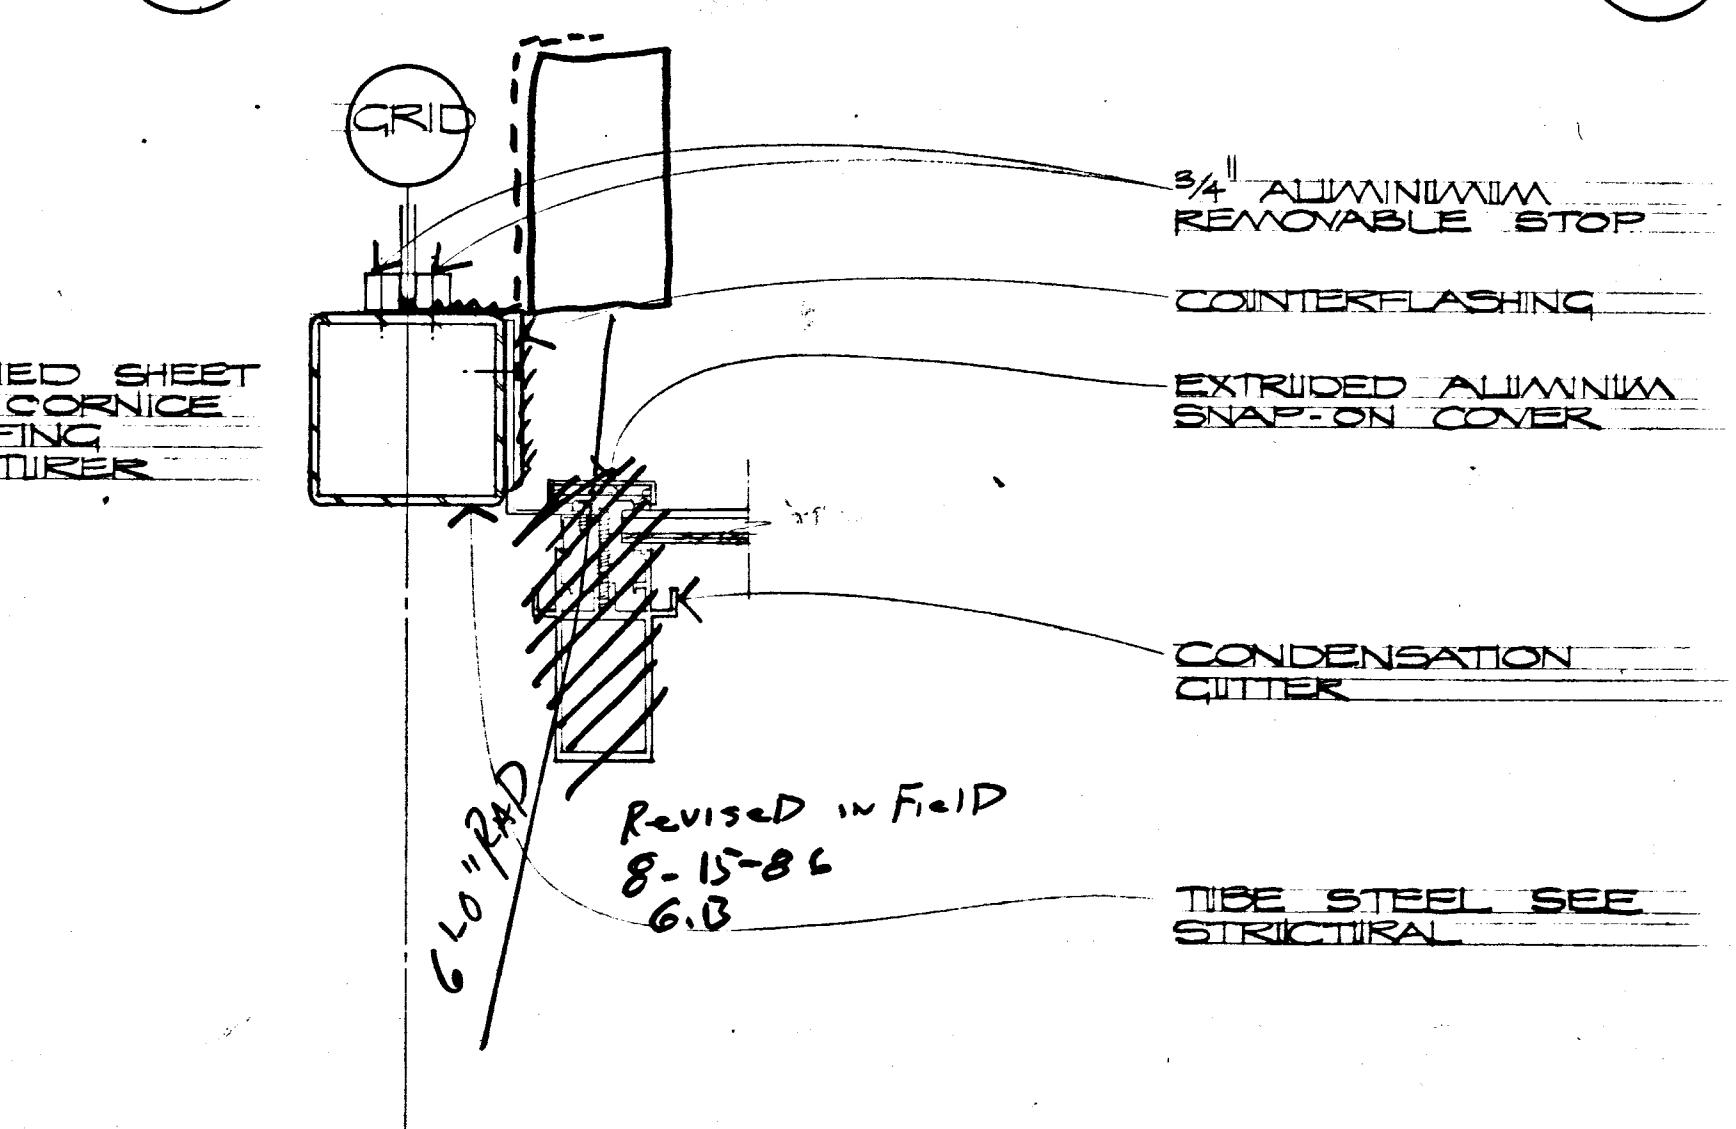


DETAIL

SCALE: 3" = 1'-0"

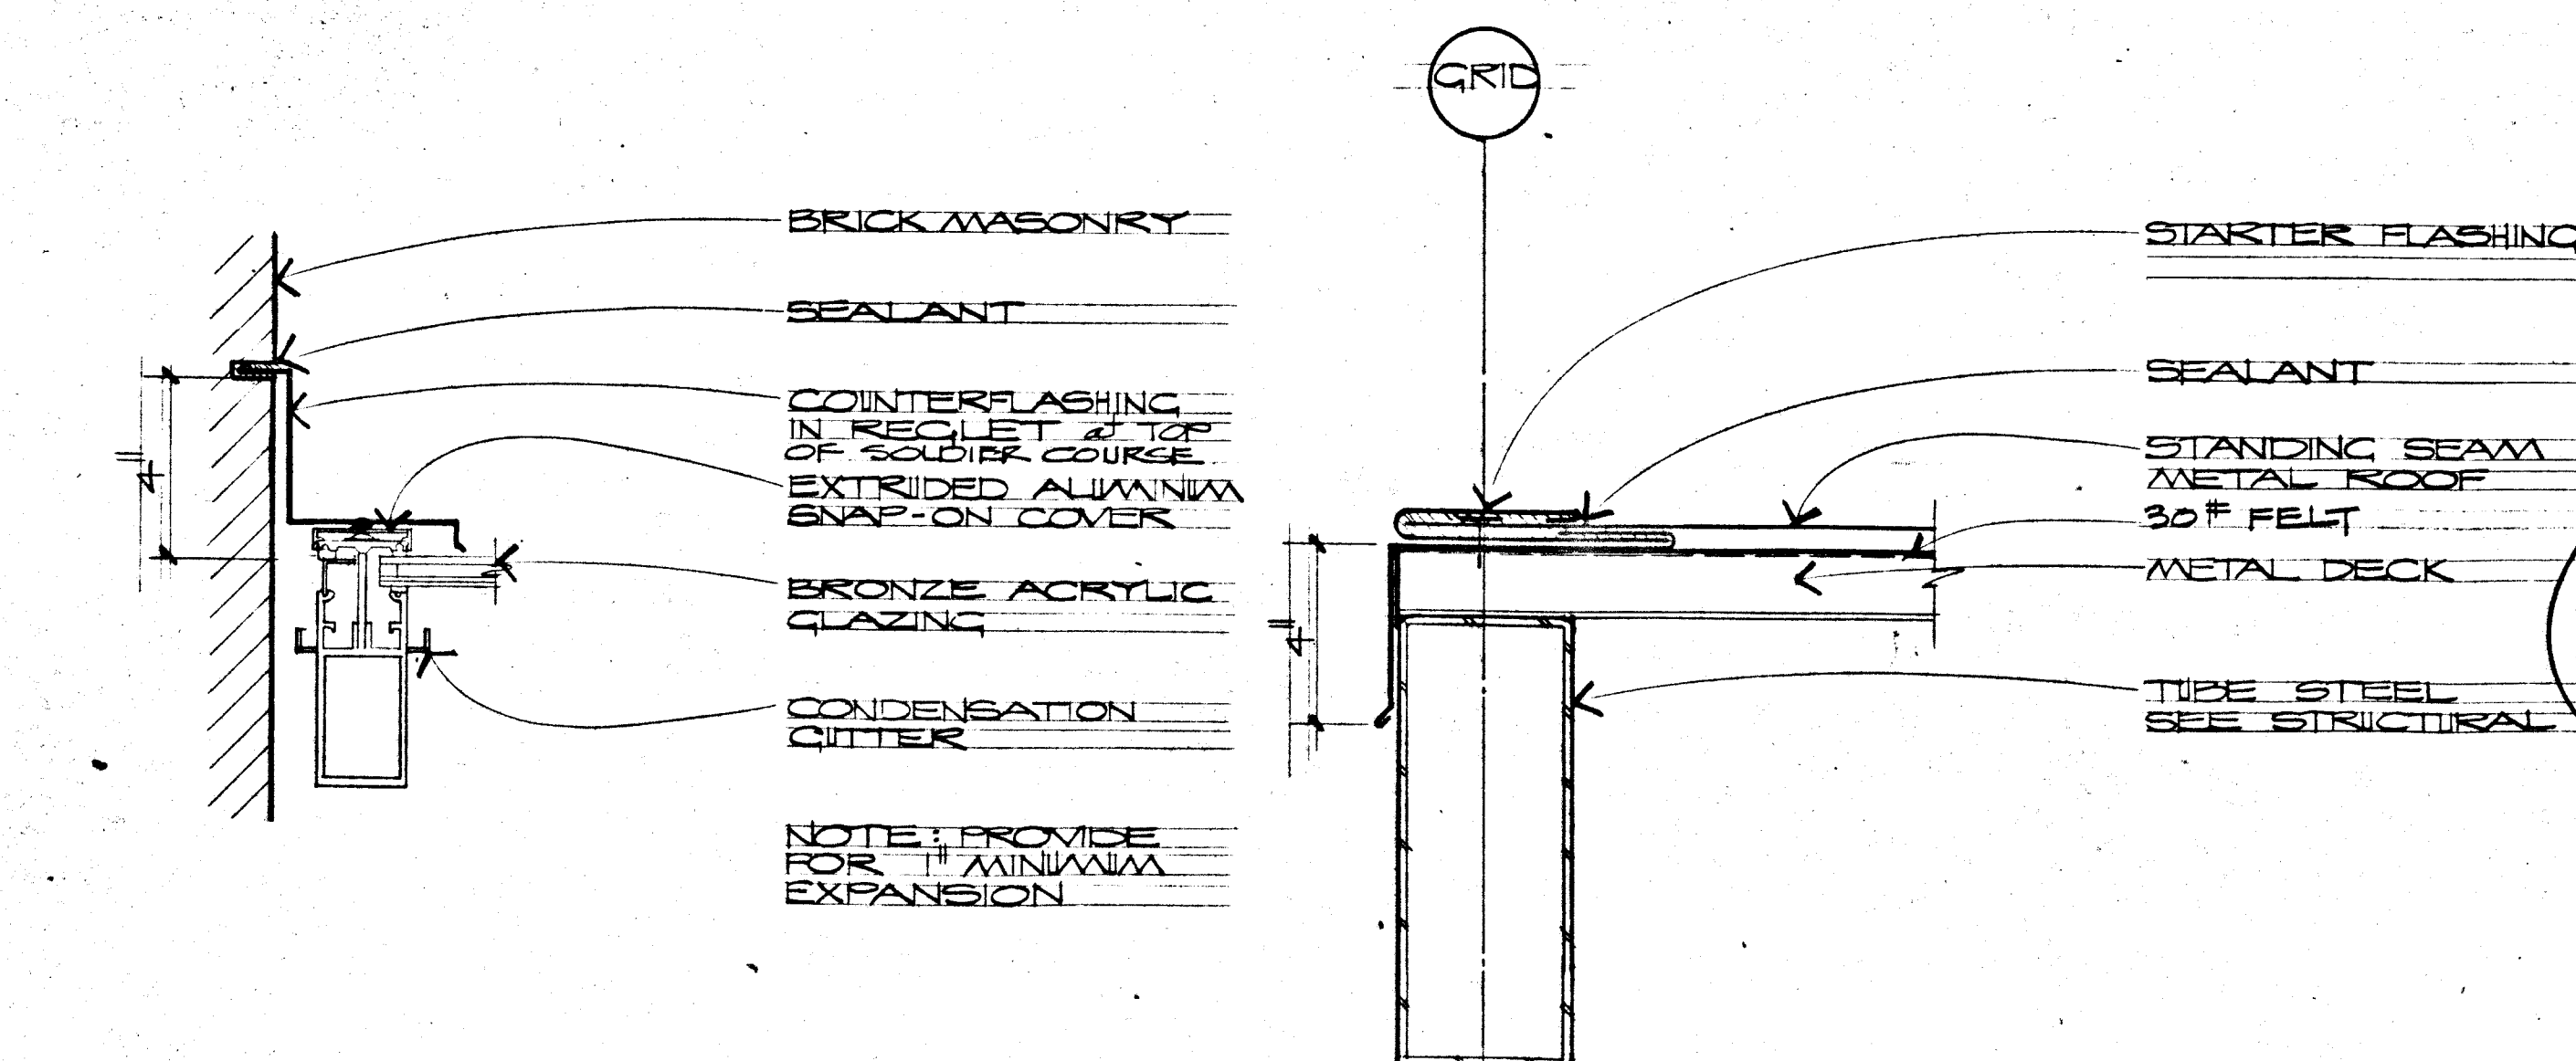


DETAIL

SCALE: 3" = 1'-0"

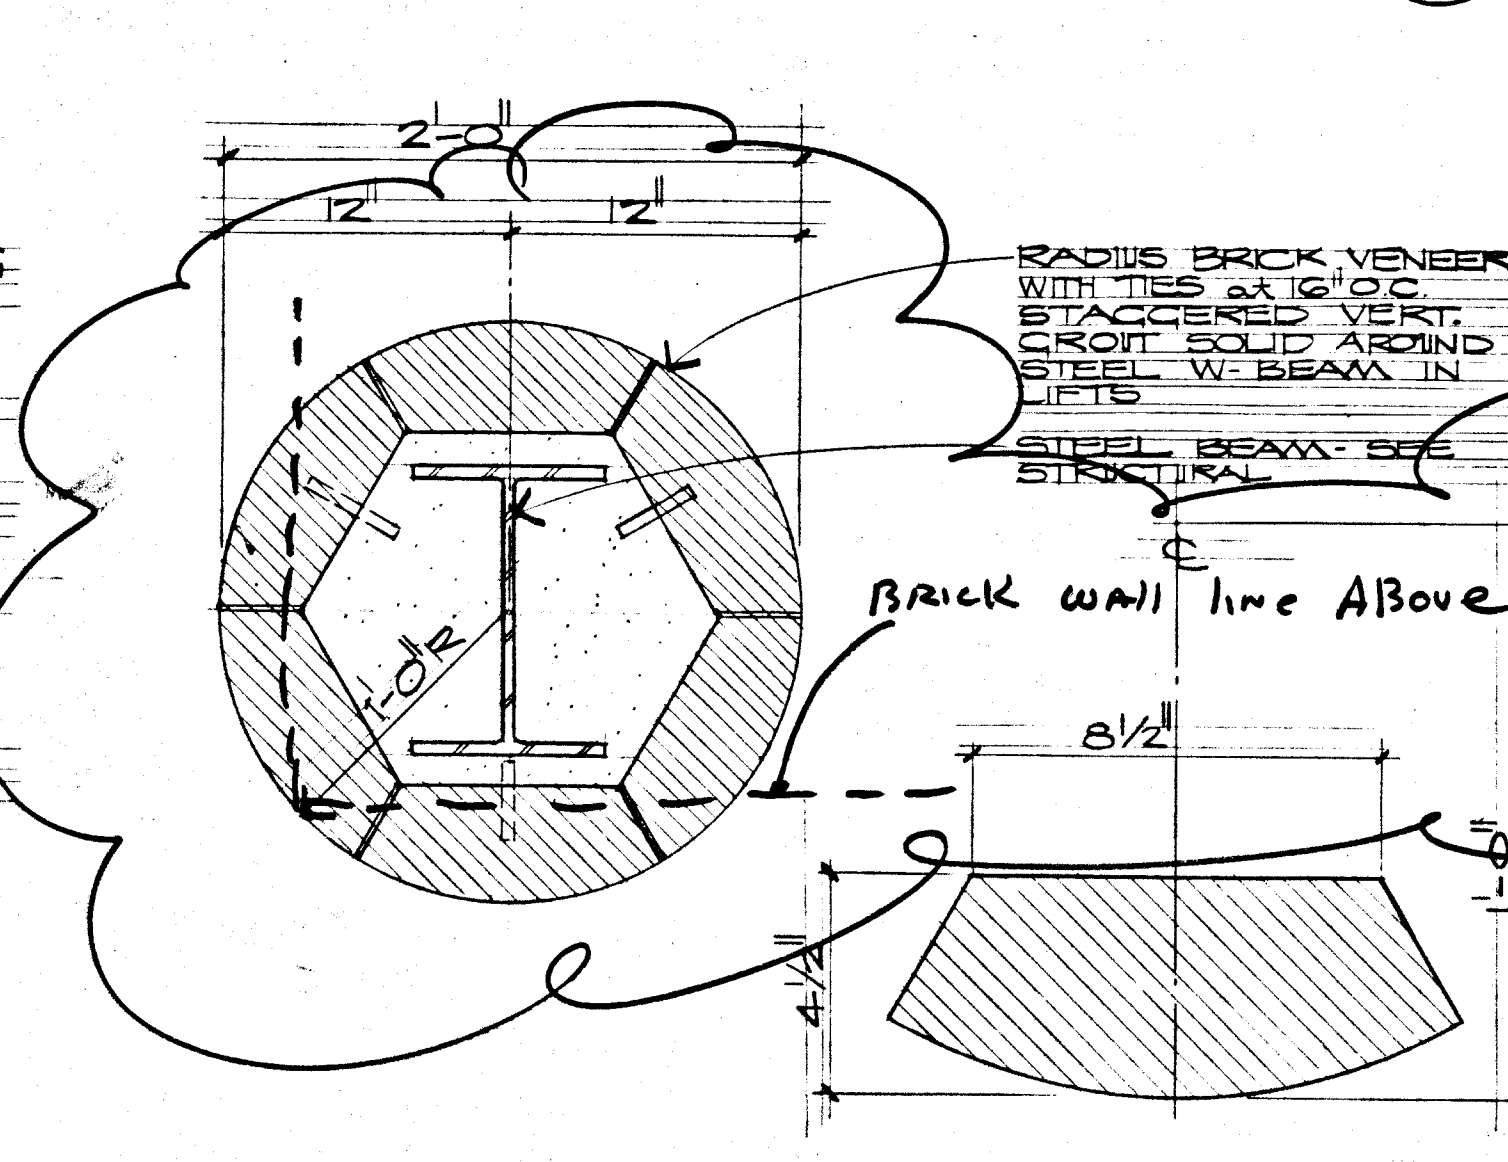


DETAIL

SCALE: 11/2" = 1'-0"

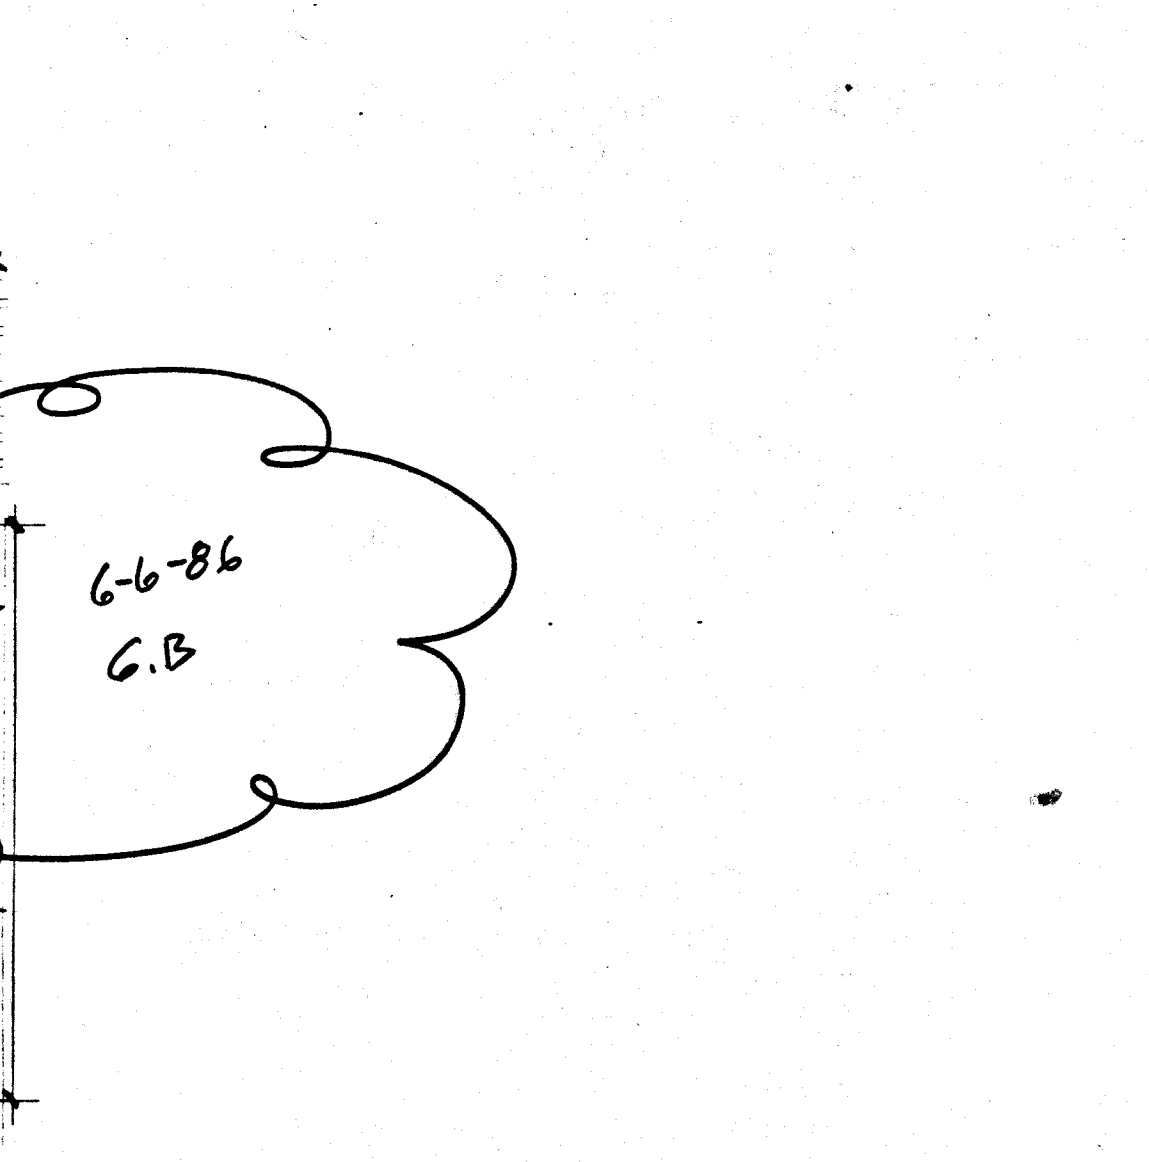

DETAIL

SCALE: 11/2" = 1'-0"

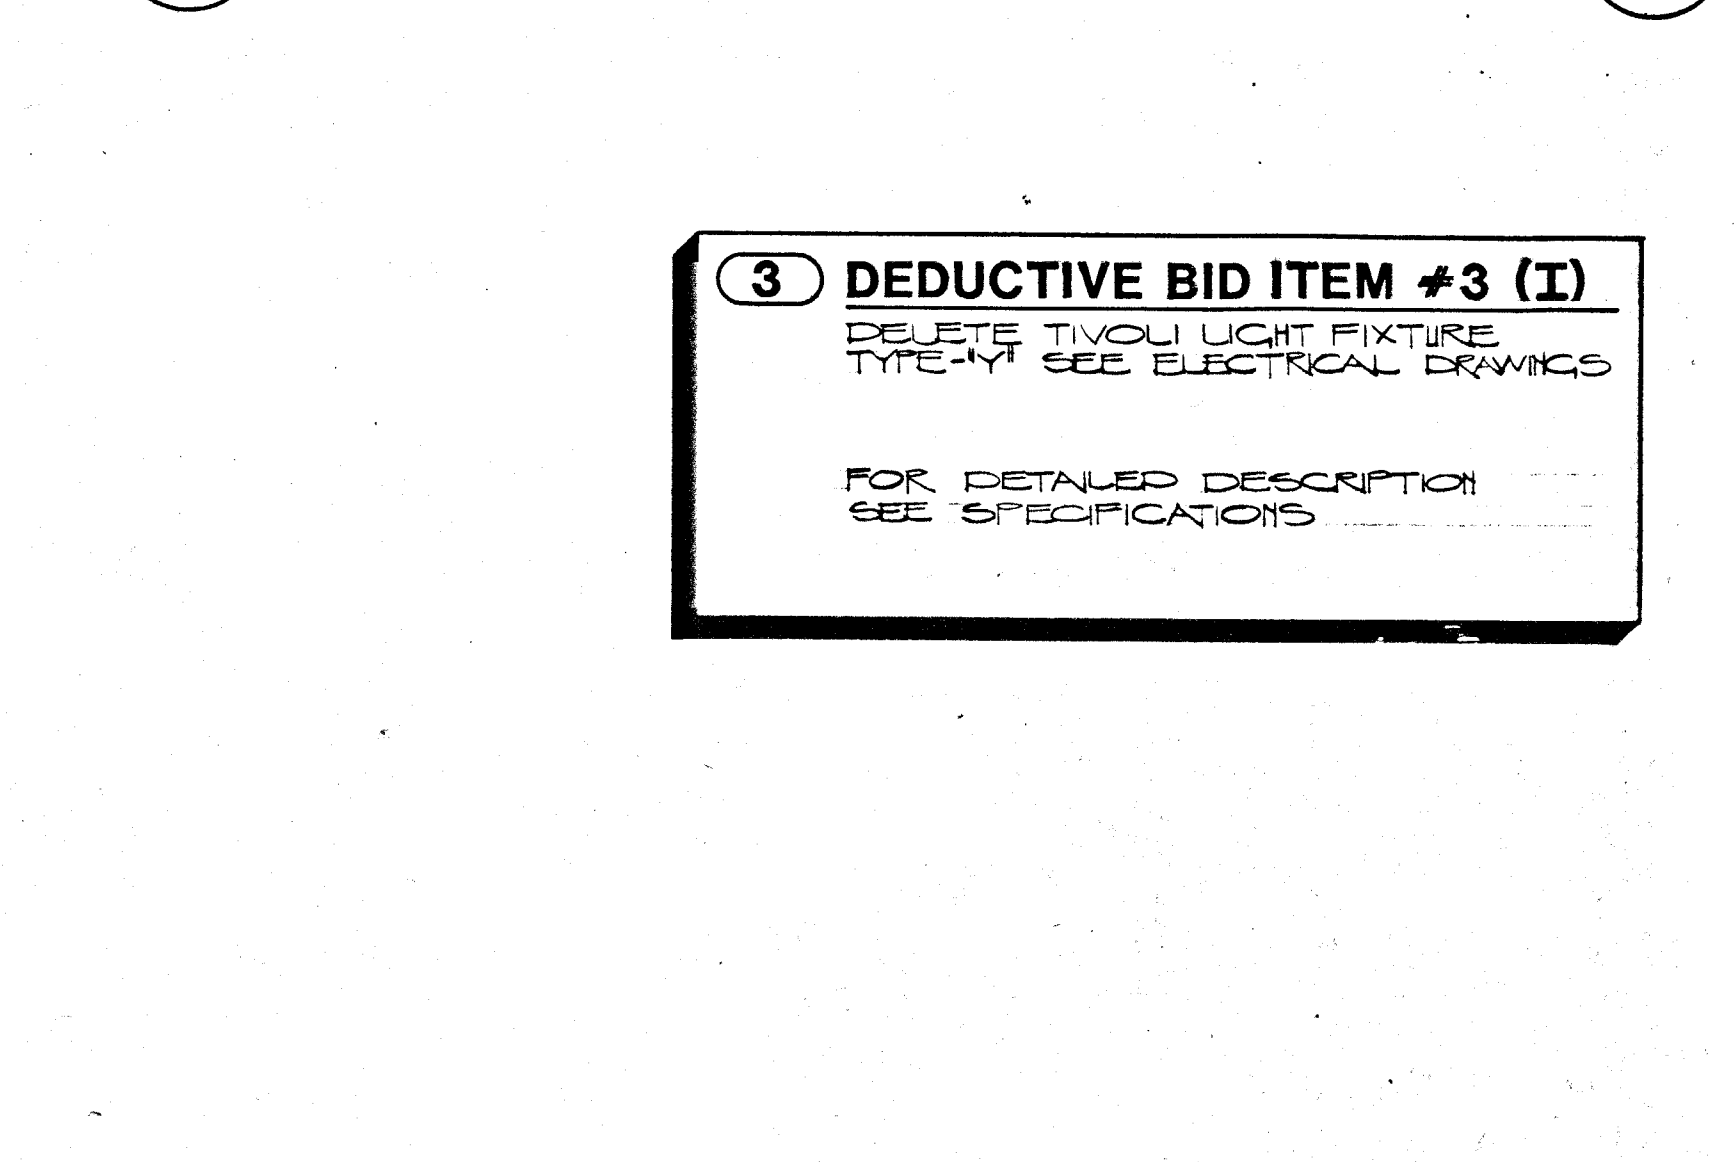

DETAIL

SCALE: 3" = 1'-0"

(3) DEDUCTIVE BID ITEM #3 (I)
 SEE ELECTRICAL DRAWINGS
 FOR DETAILED DESCRIPTION
 SEE SPECIFICATIONS