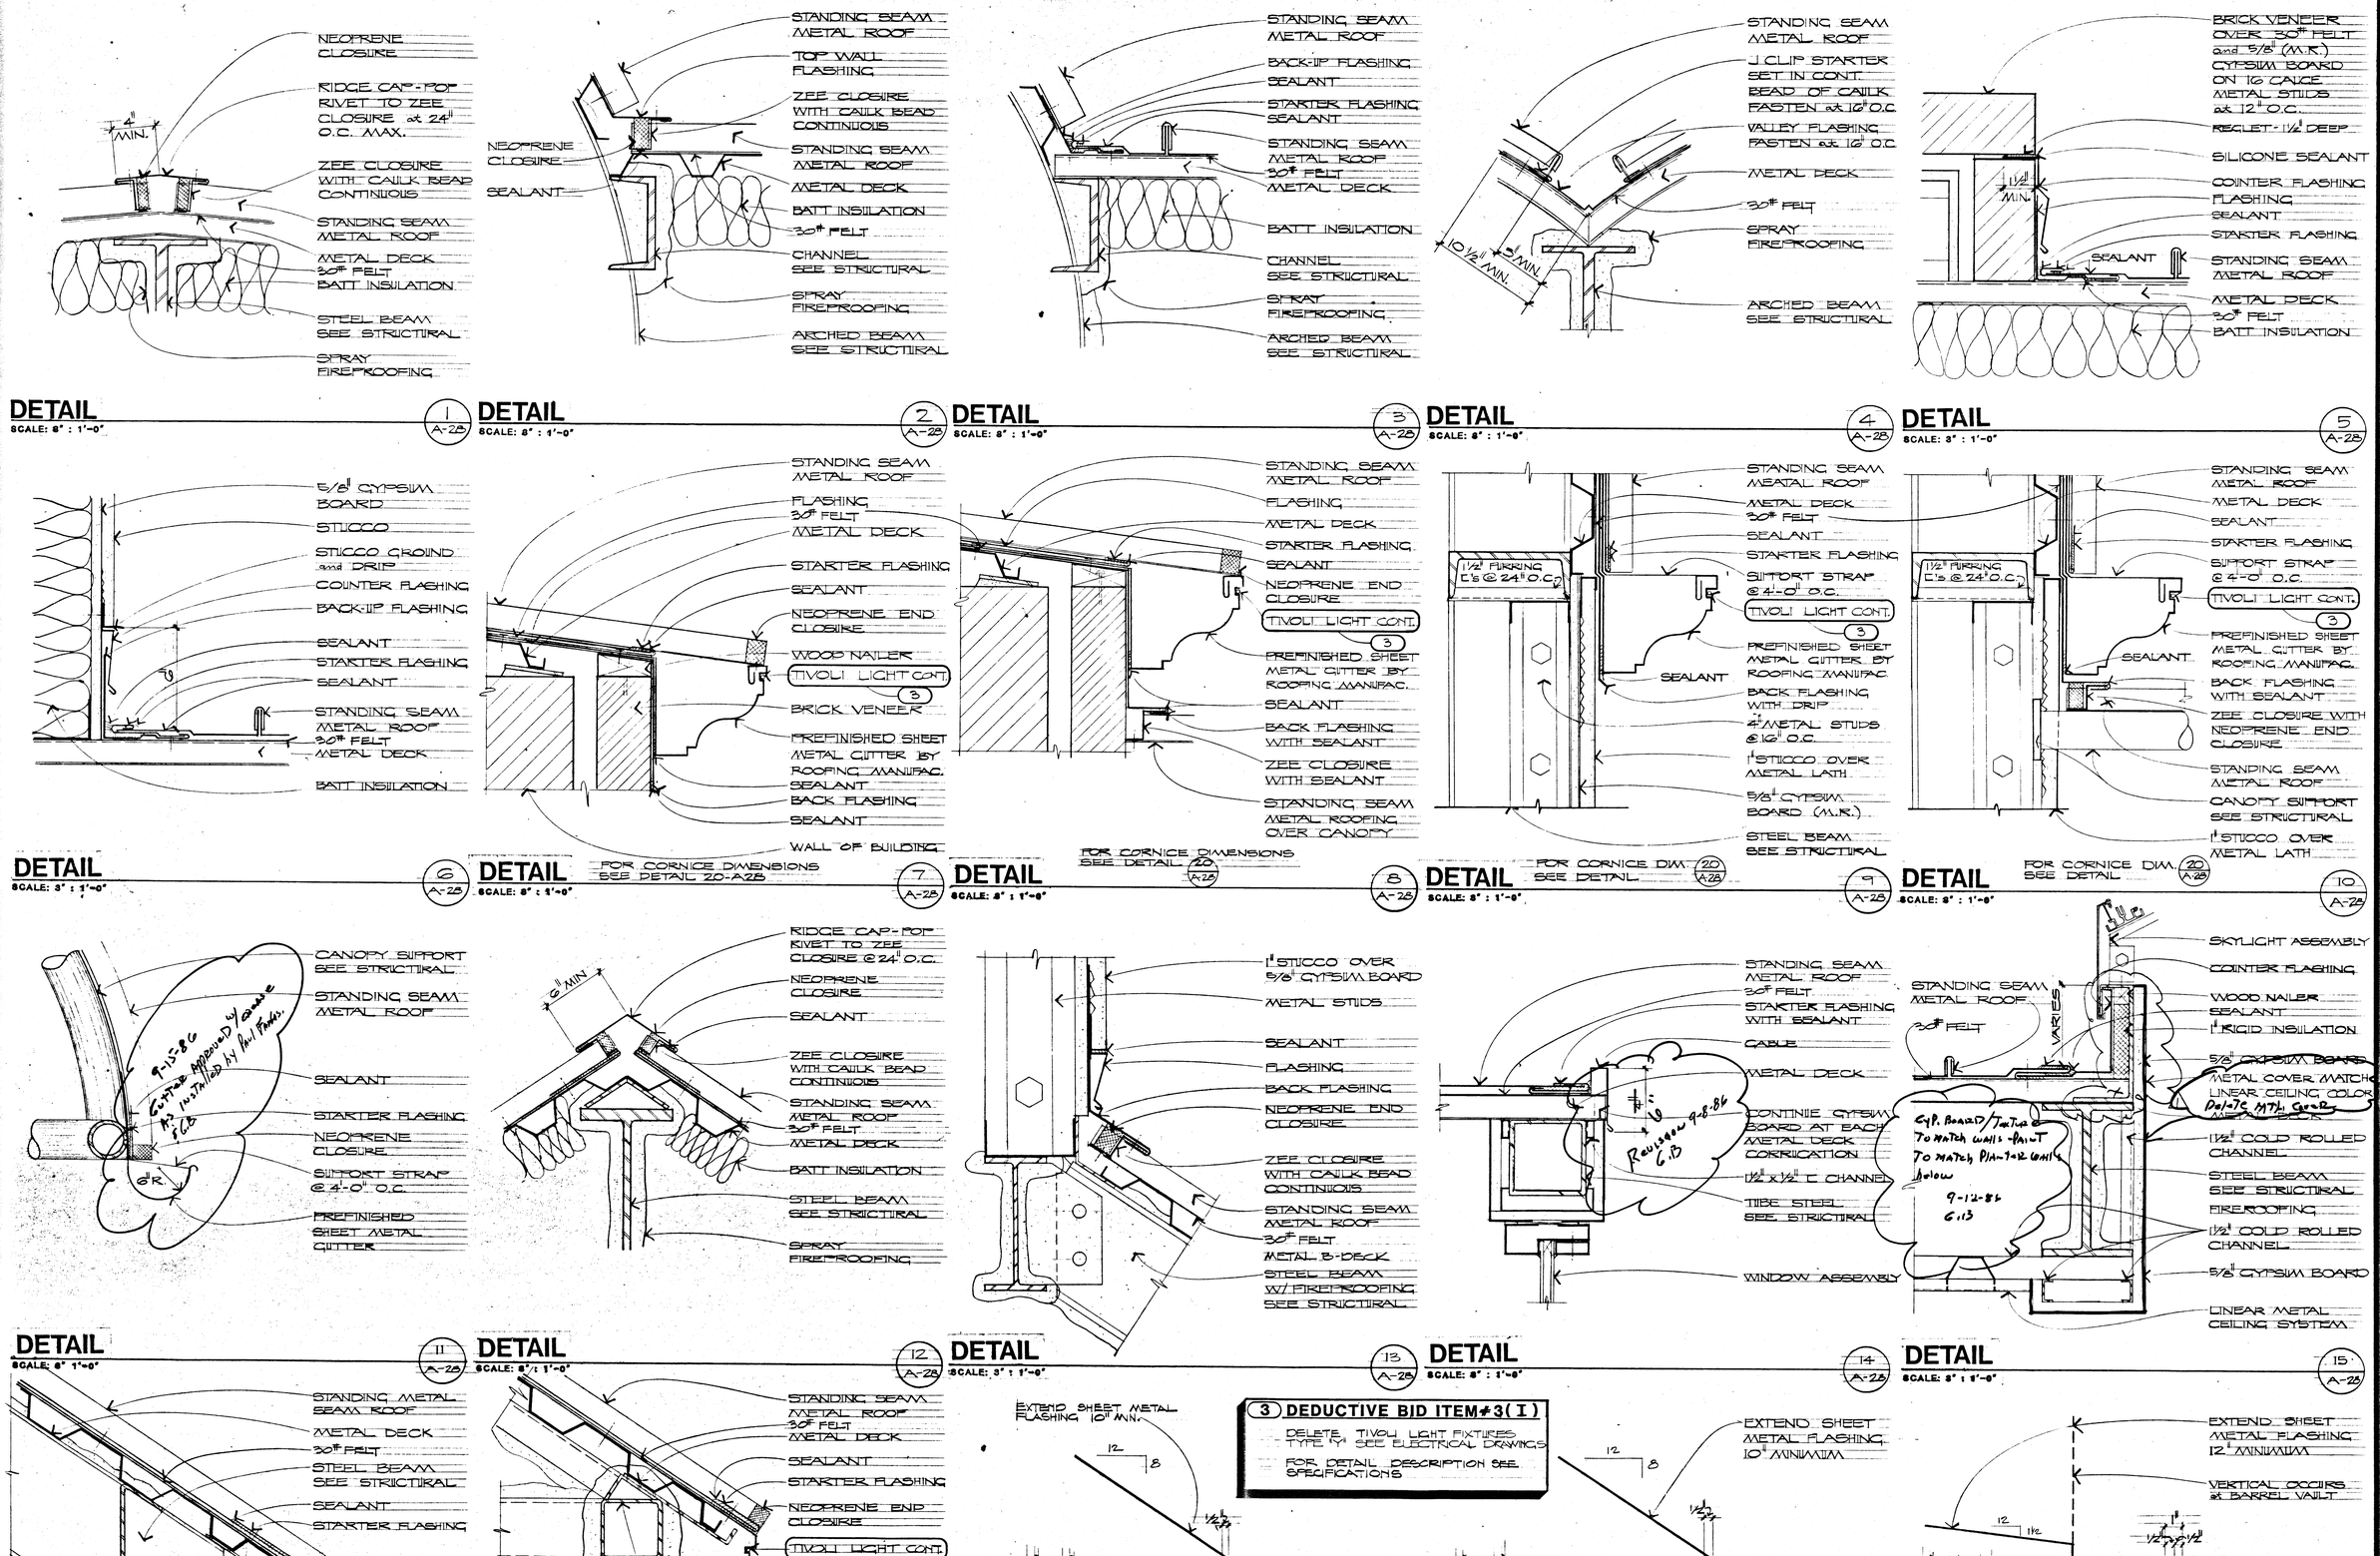

3 DEDUCTIVE BID ITEM #3(I)

DELETE TIVOLI LIGHT FIXTURES TYPE (V) SEE ELECTRICAL DRAWINGS

FOR DETAIL DESCRIPTION SEE SPECIFICATIONS

4150

1/1 11-15-85 ISSUED FOR ADDENDUM #1

DATE: 10-1-85
DRAWN: K.S.
CHECKED: R.K.
FILE NO. 0341.02

DOBRUSKY KITTRELL GARLOCK aia Architects
3555 CAMBRIDGE ST. LAS VEGAS, NEVADA 89109 (702) 736-0458

City of Las Vegas
Downtown Transportation Center
Las Vegas, Nevada

SHEET A-28
OF 37 of 65

Dobrusky Press - 1818 TELEDAM DRAFTING FILM