



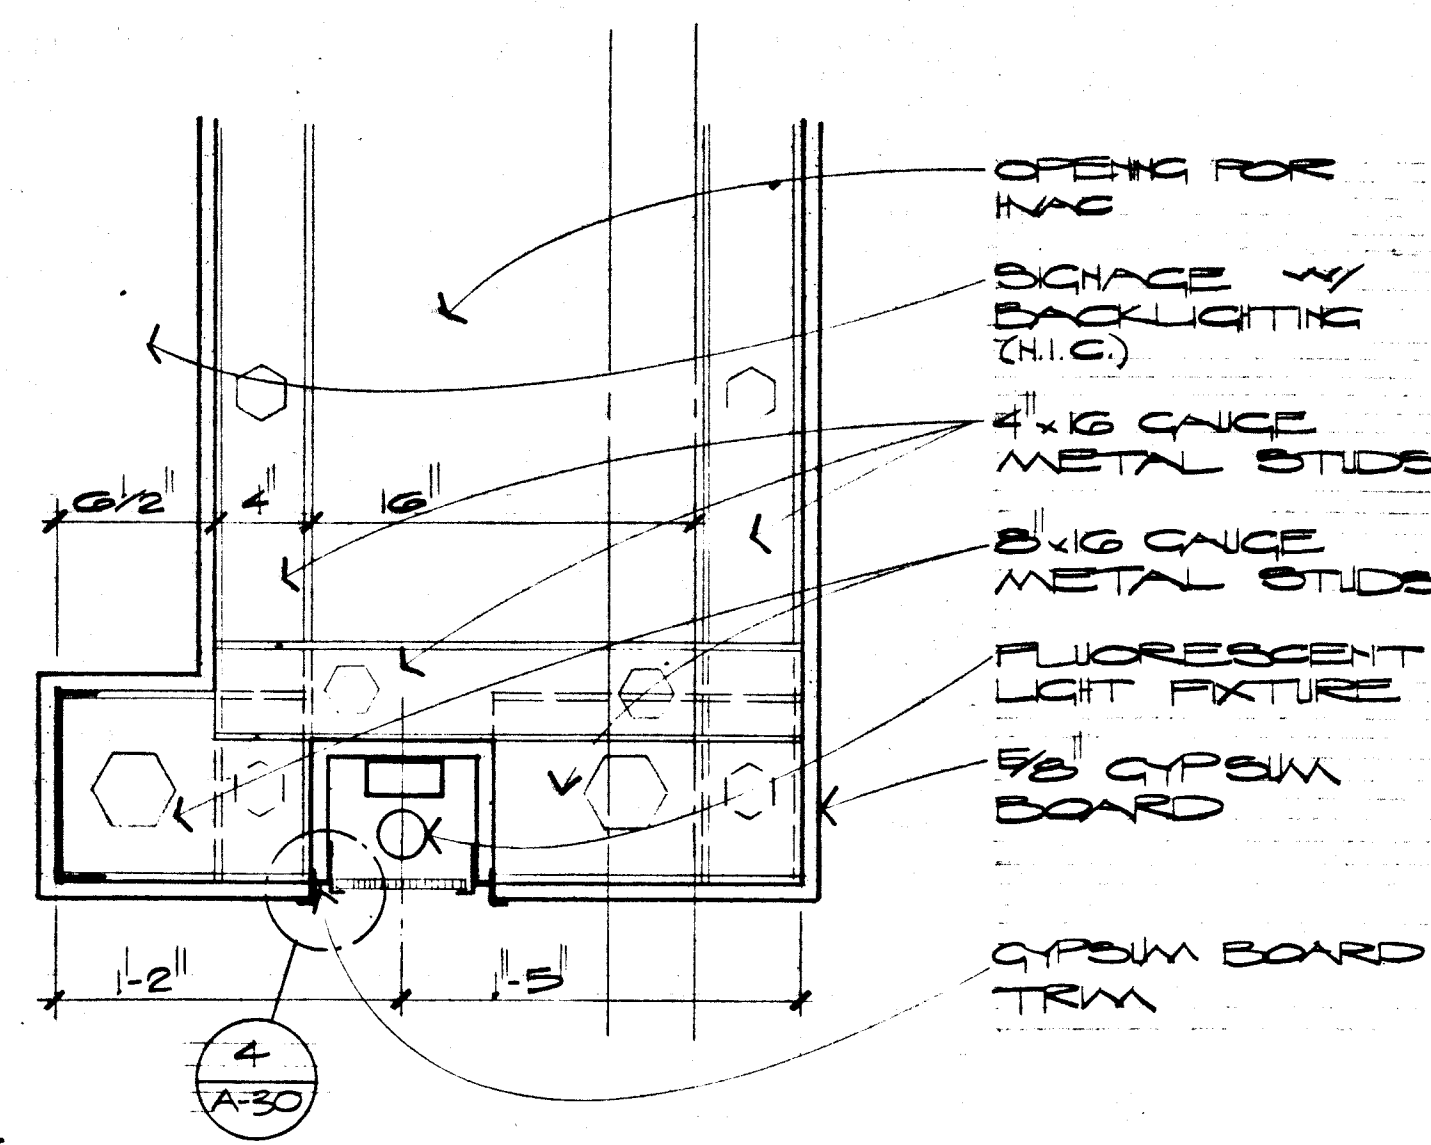

DETAIL

SCALE: 1 1/2" = 1'-0"


1
A-30

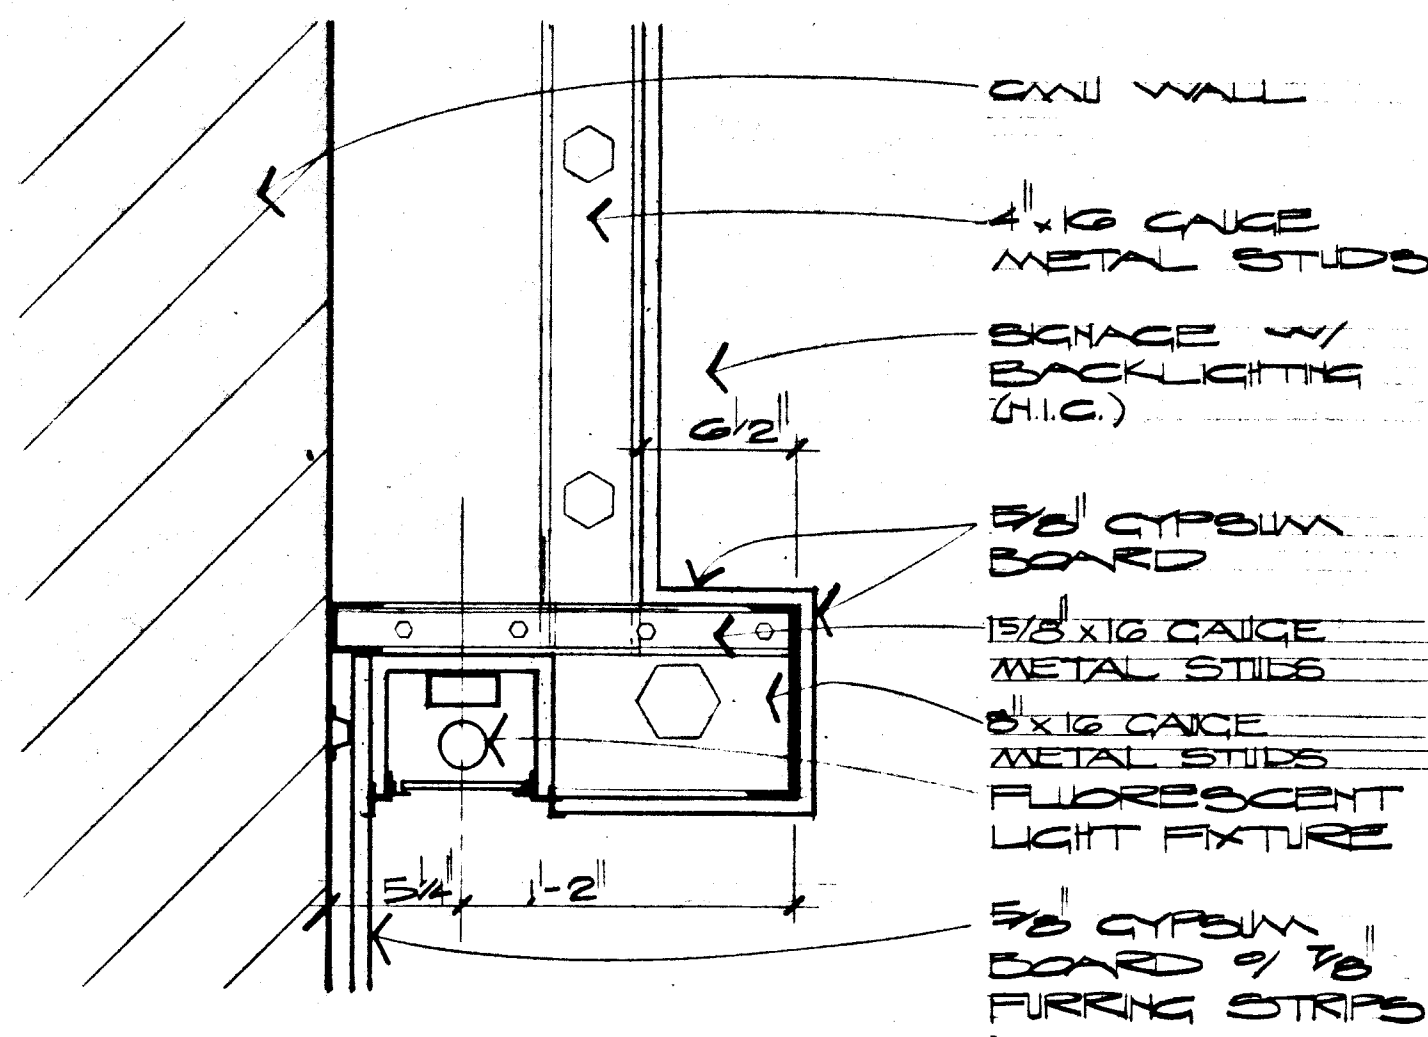

DETAIL

SCALE: 1 1/2" = 1'-0"


2
A-30

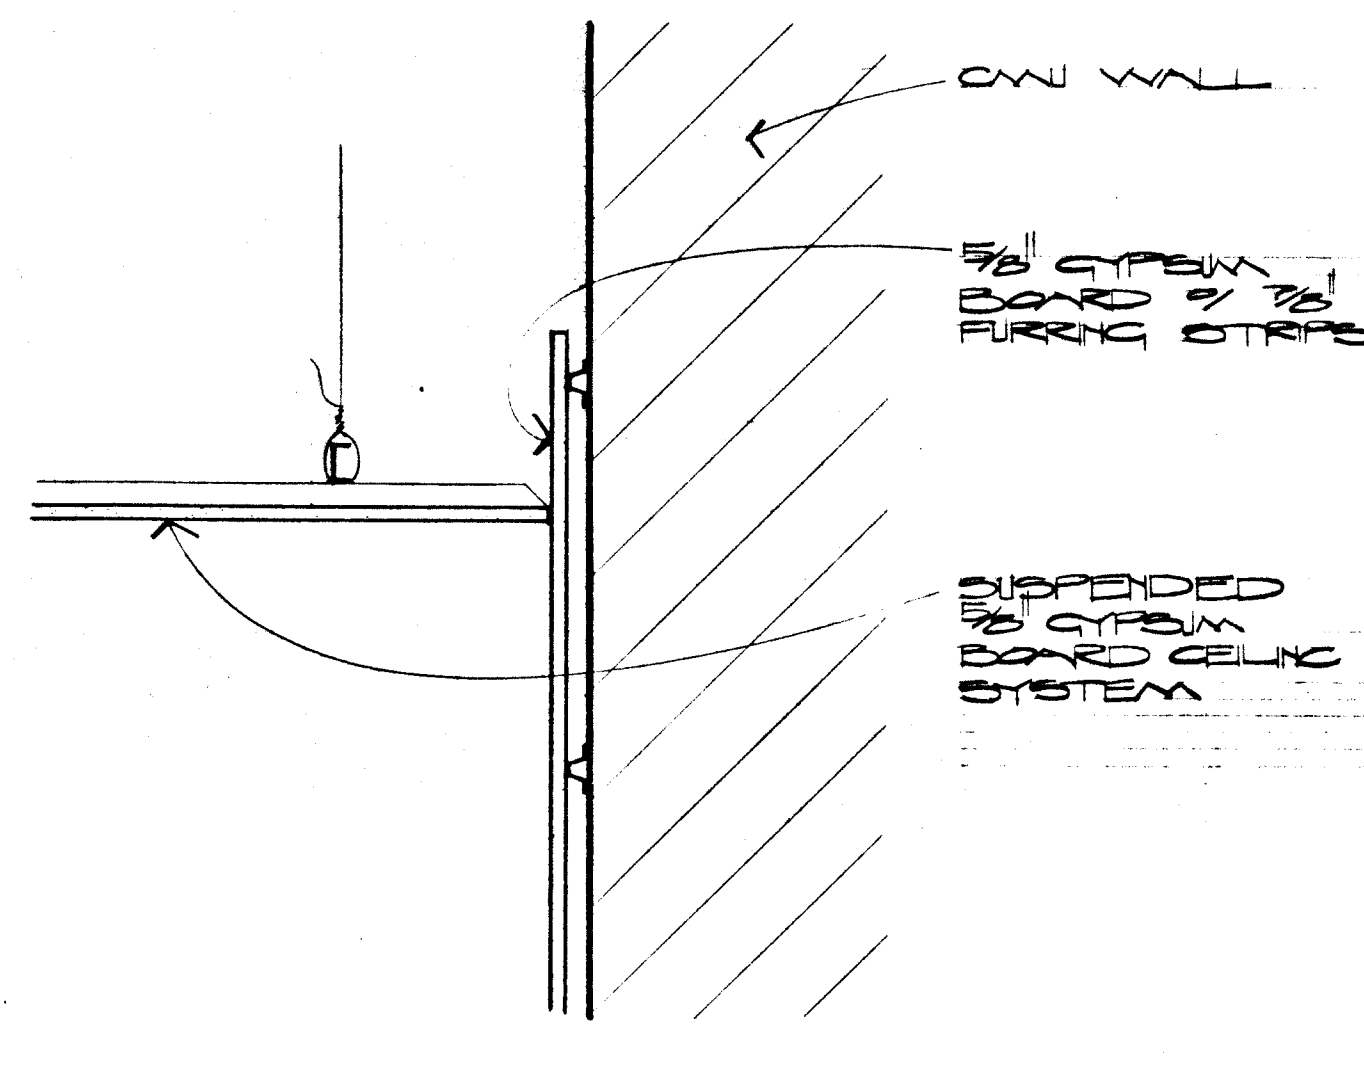

DETAIL

SCALE: 1 1/2" = 1'-0"


3
A-30

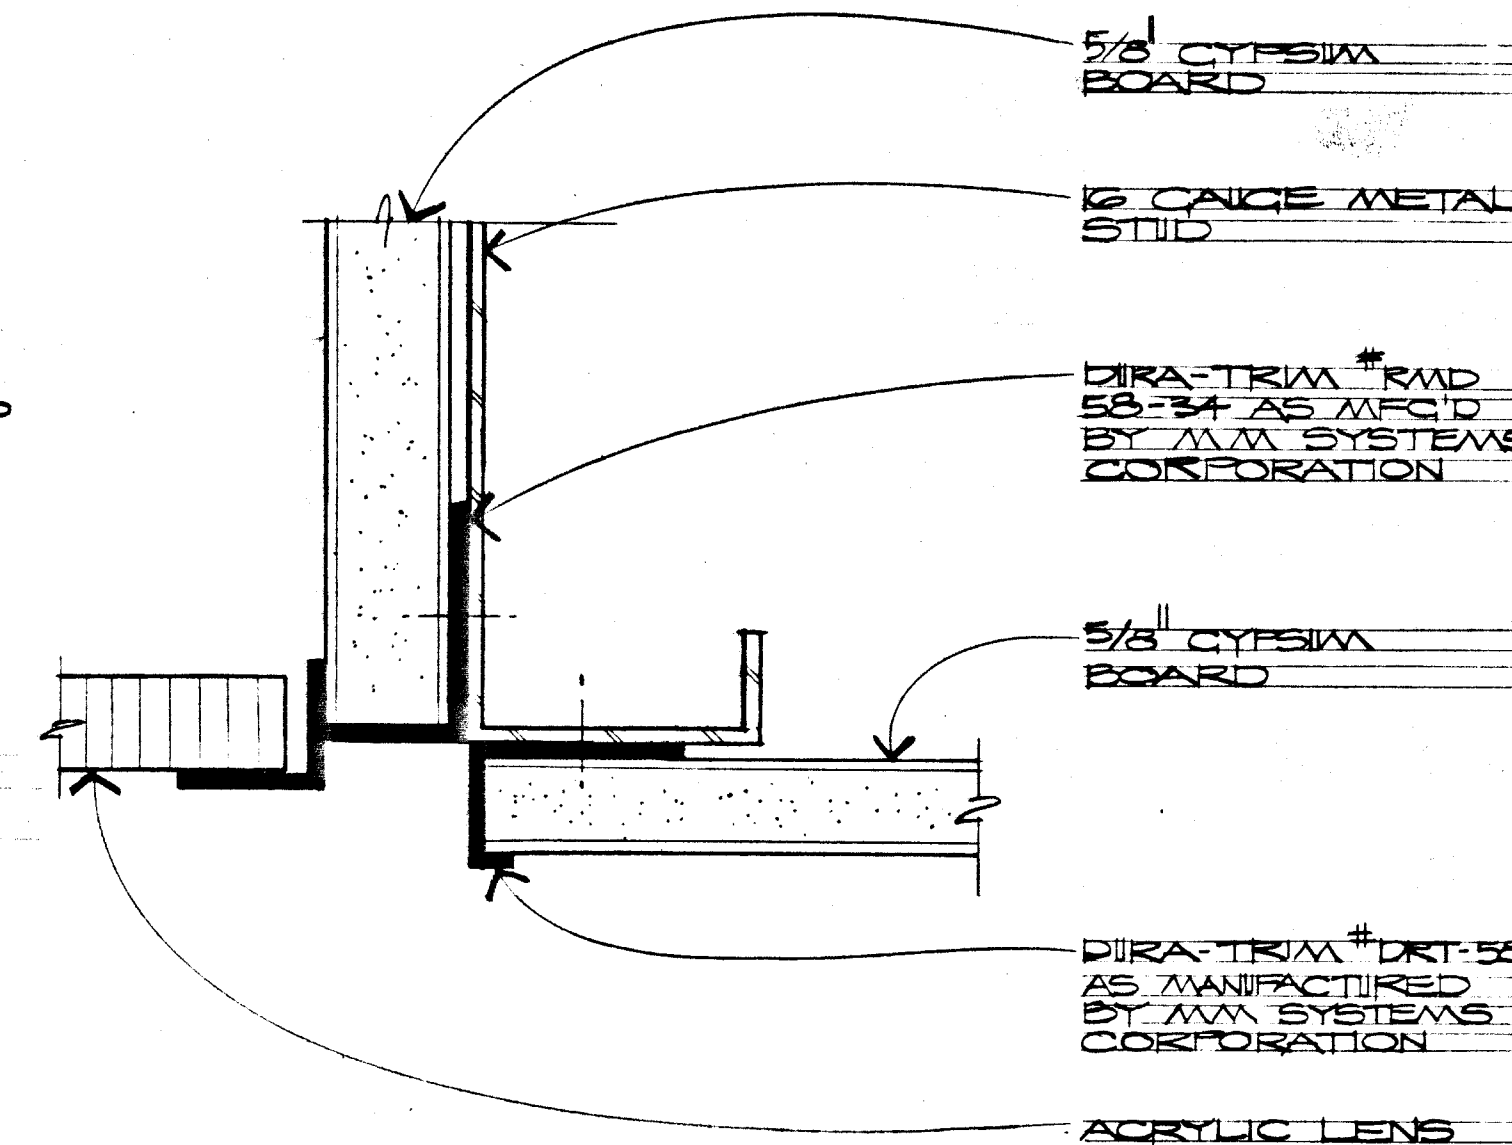

DETAIL

N.T.S.


4
A-30

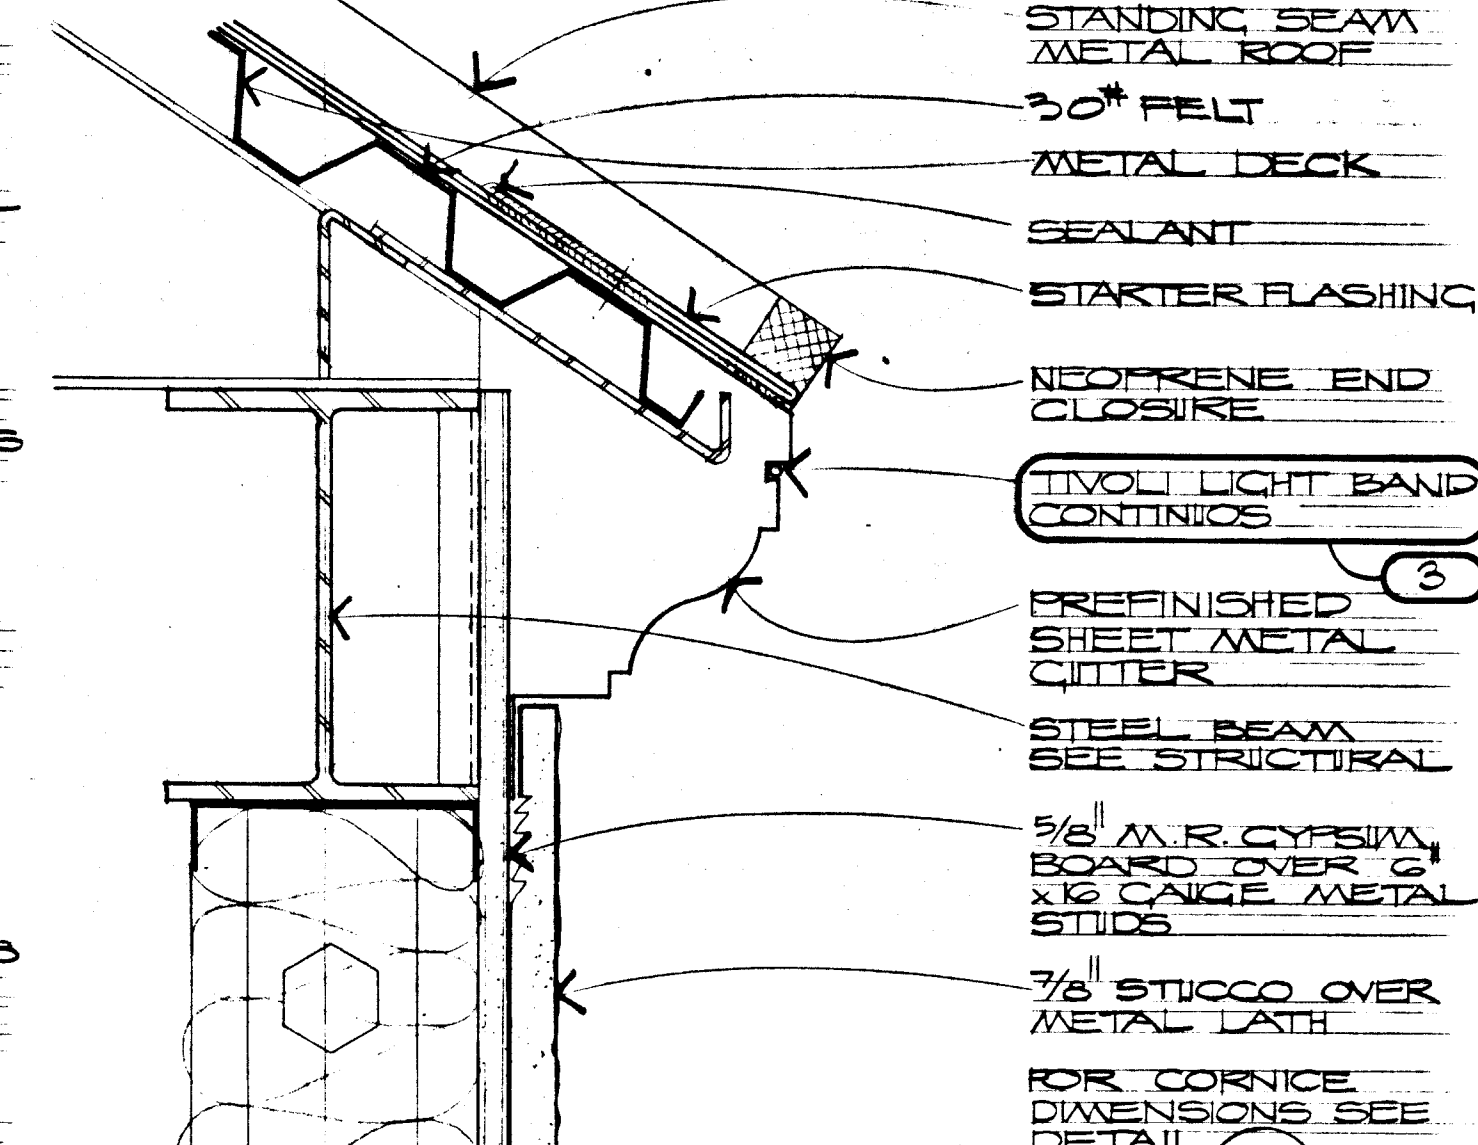

DETAIL

SCALE: 3" = 1'-0"


5
A-30

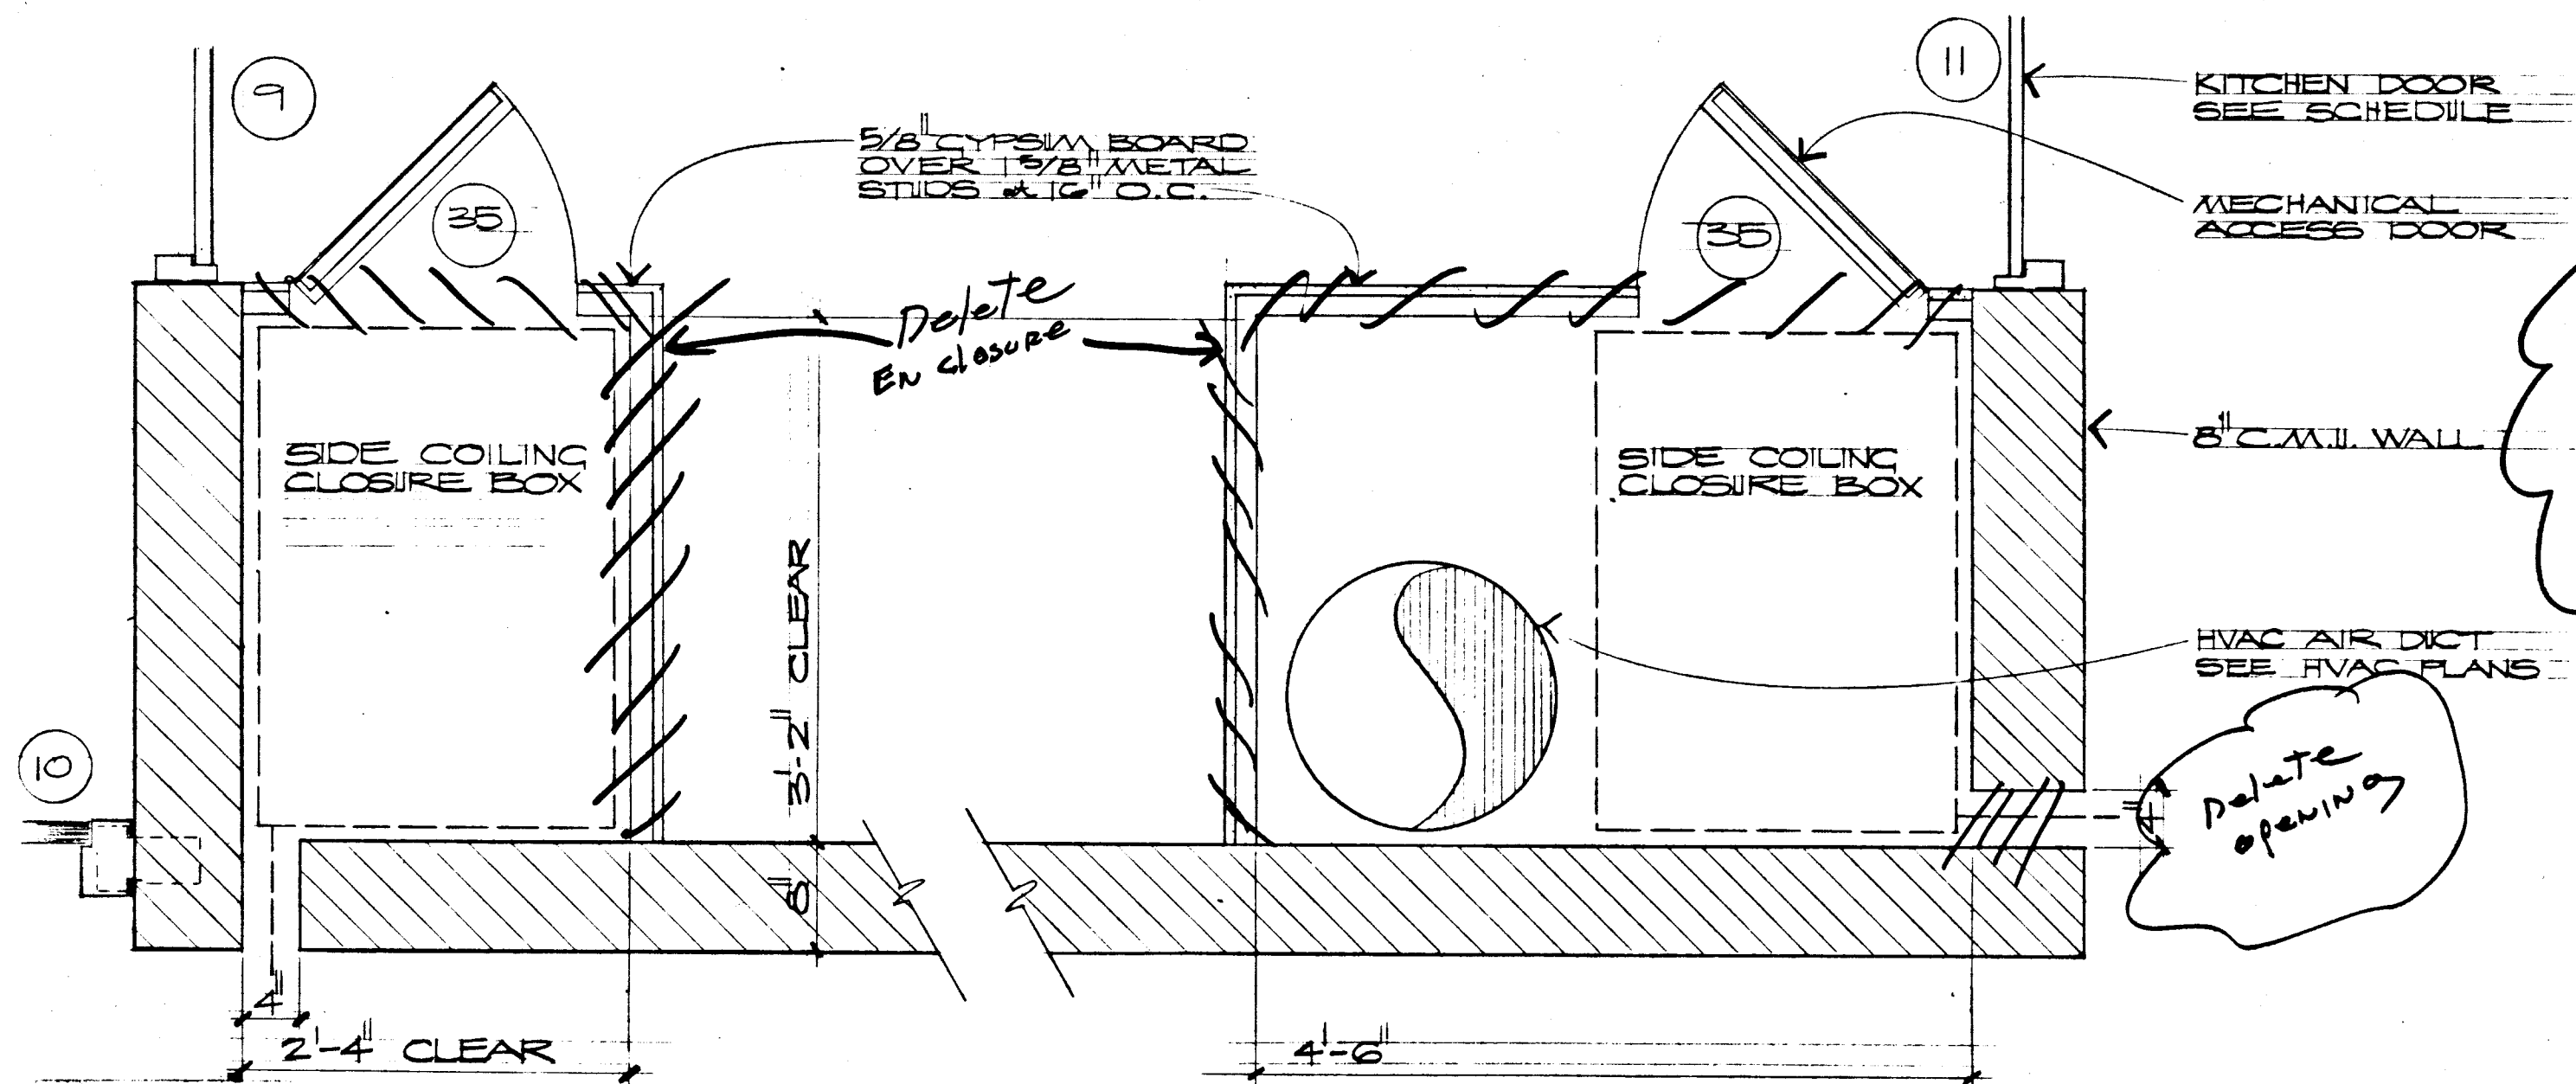

DETAIL

SCALE: 1" = 1'-0"


6
A-30

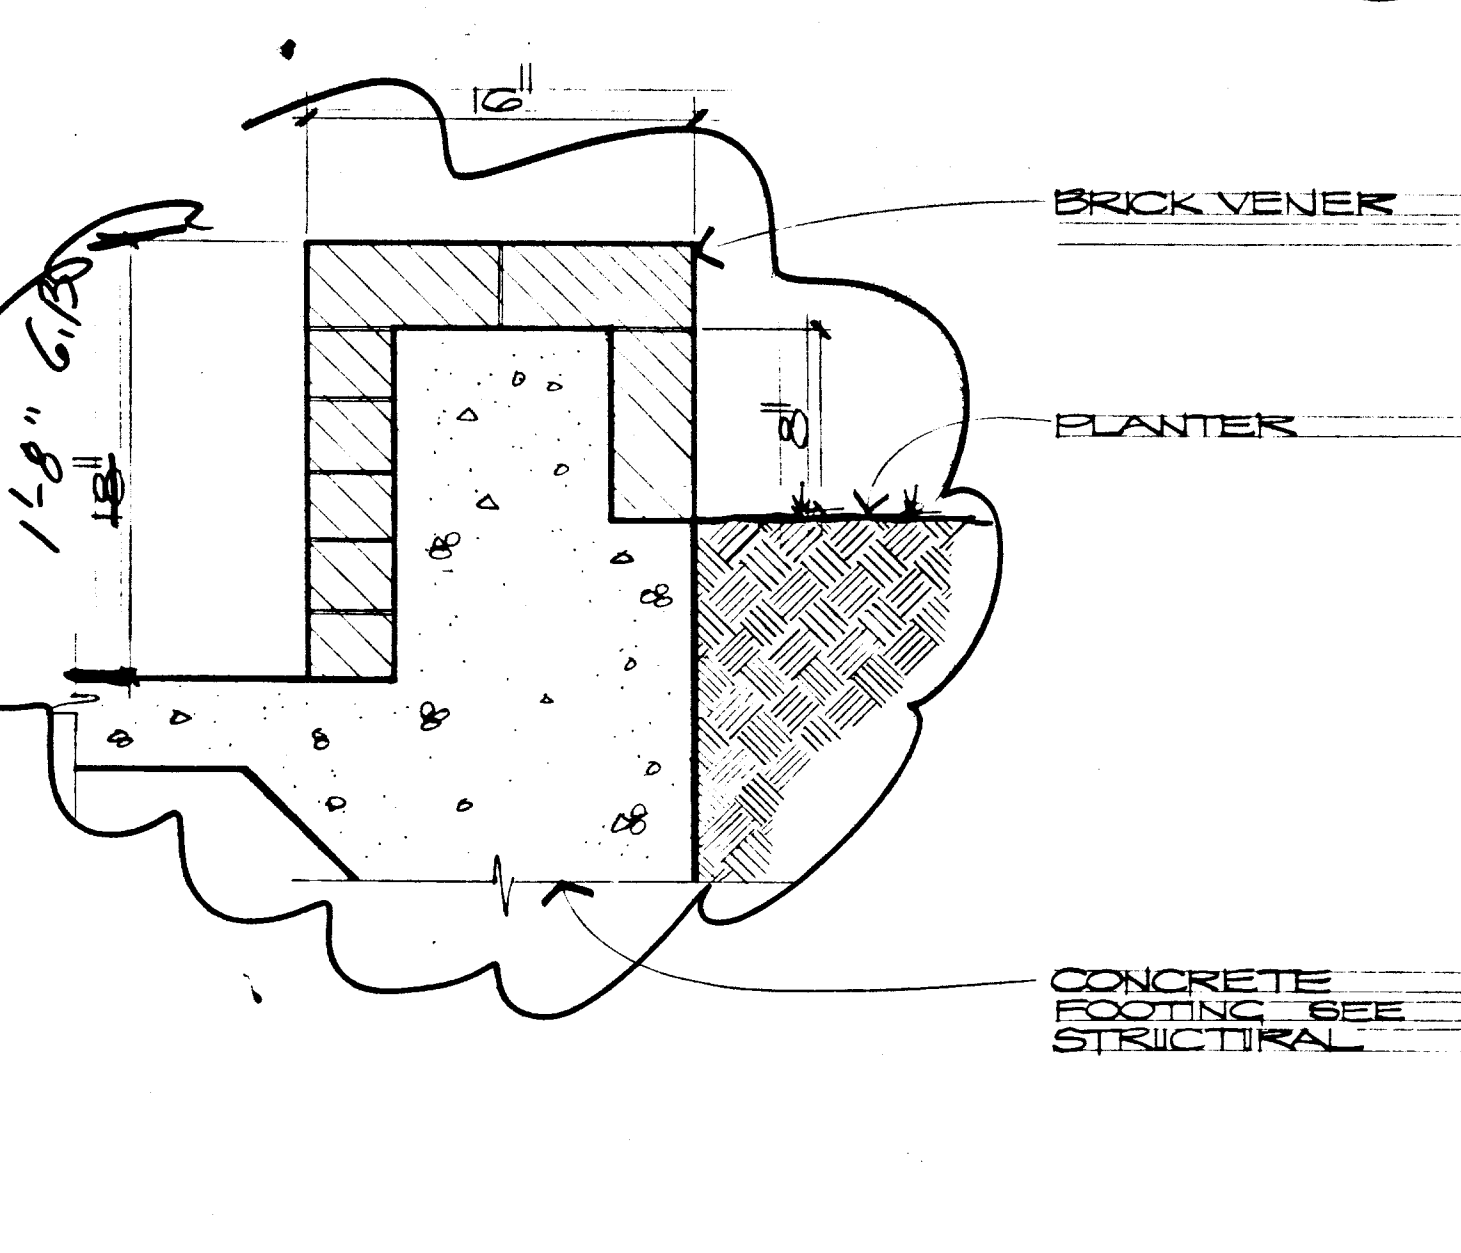

DETAIL

SCALE: 1 1/2" = 1'-0"


7
A-30

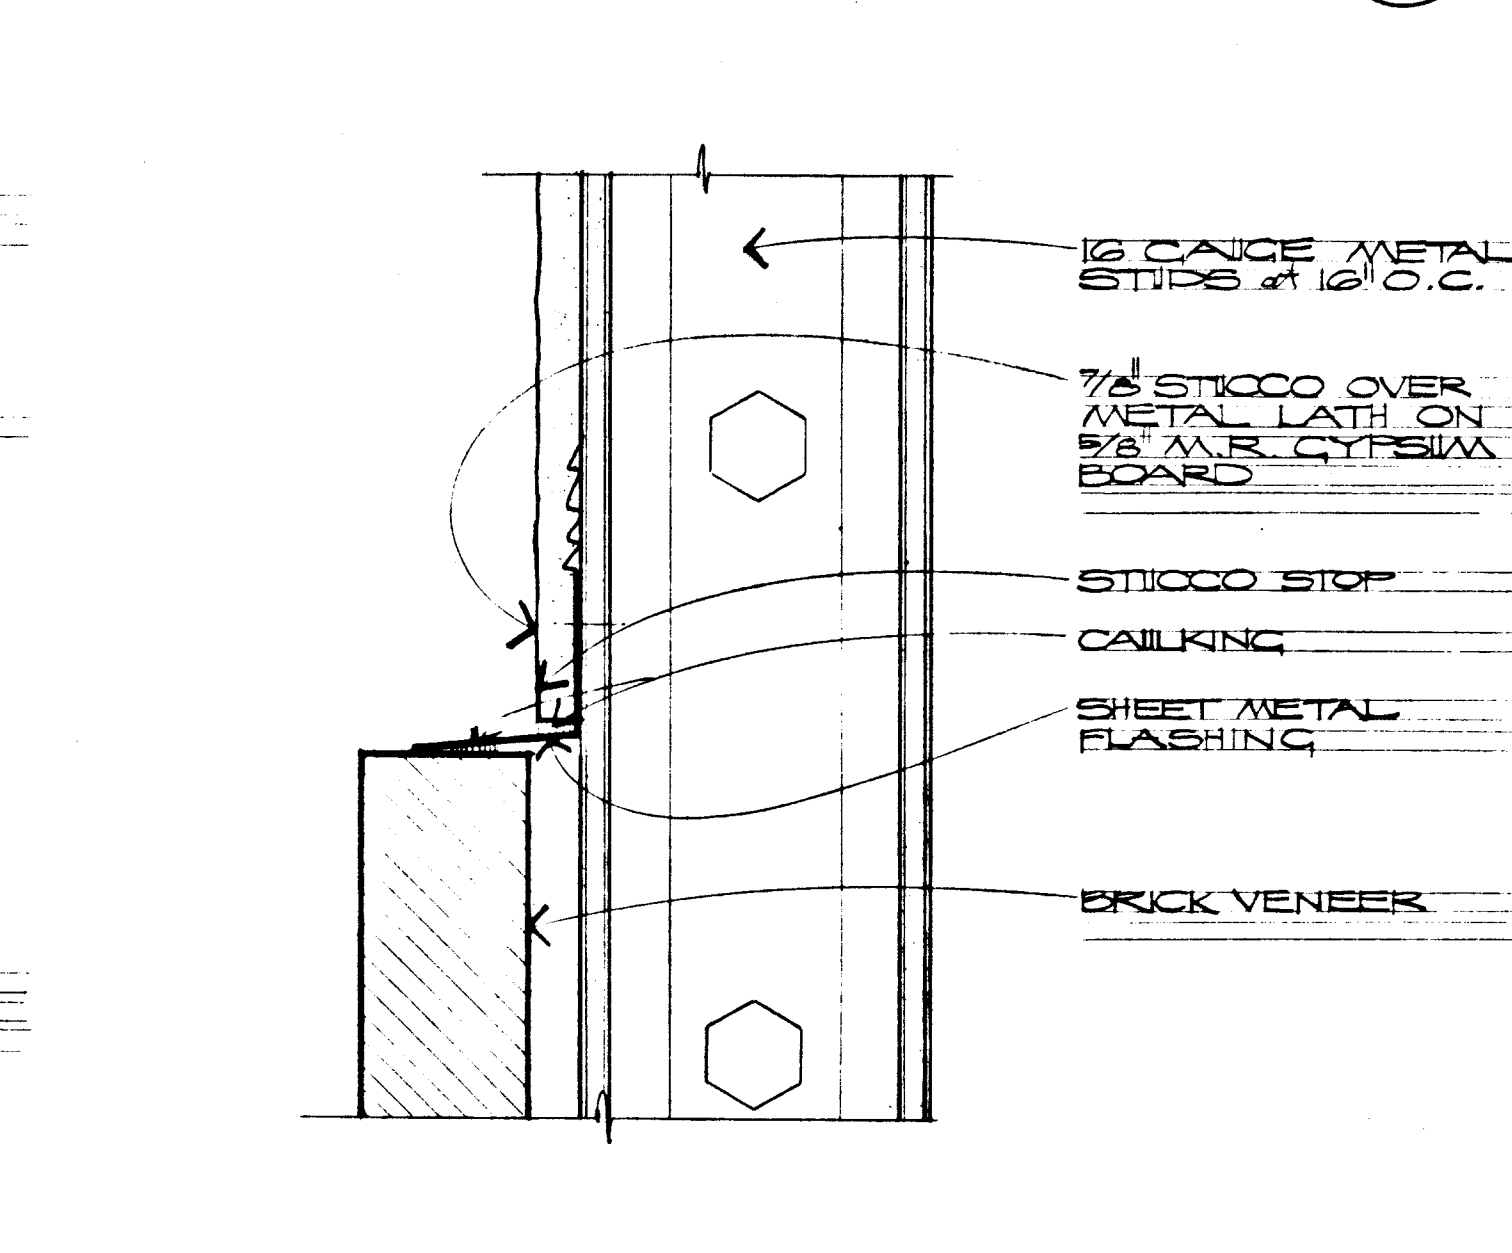

DETAIL

SCALE: 3" = 1'-0"


8
A-30

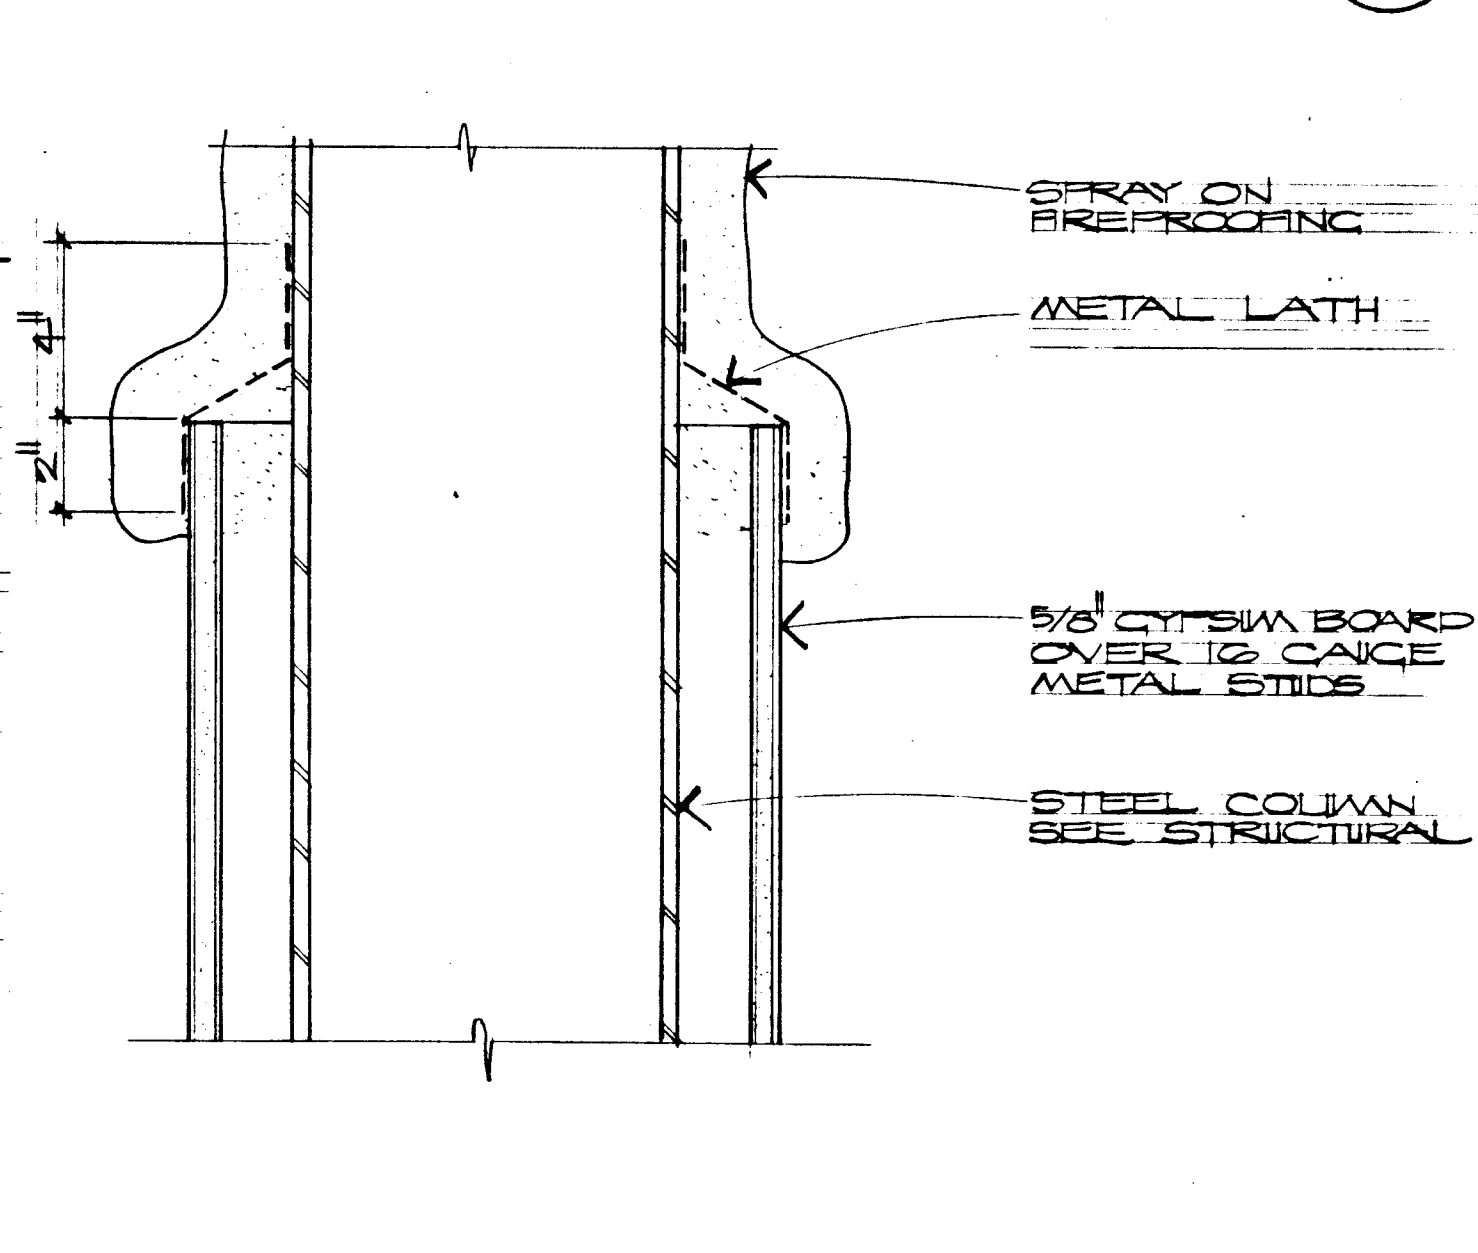

DETAIL

SCALE: 3" = 1'-0"


9
A-30

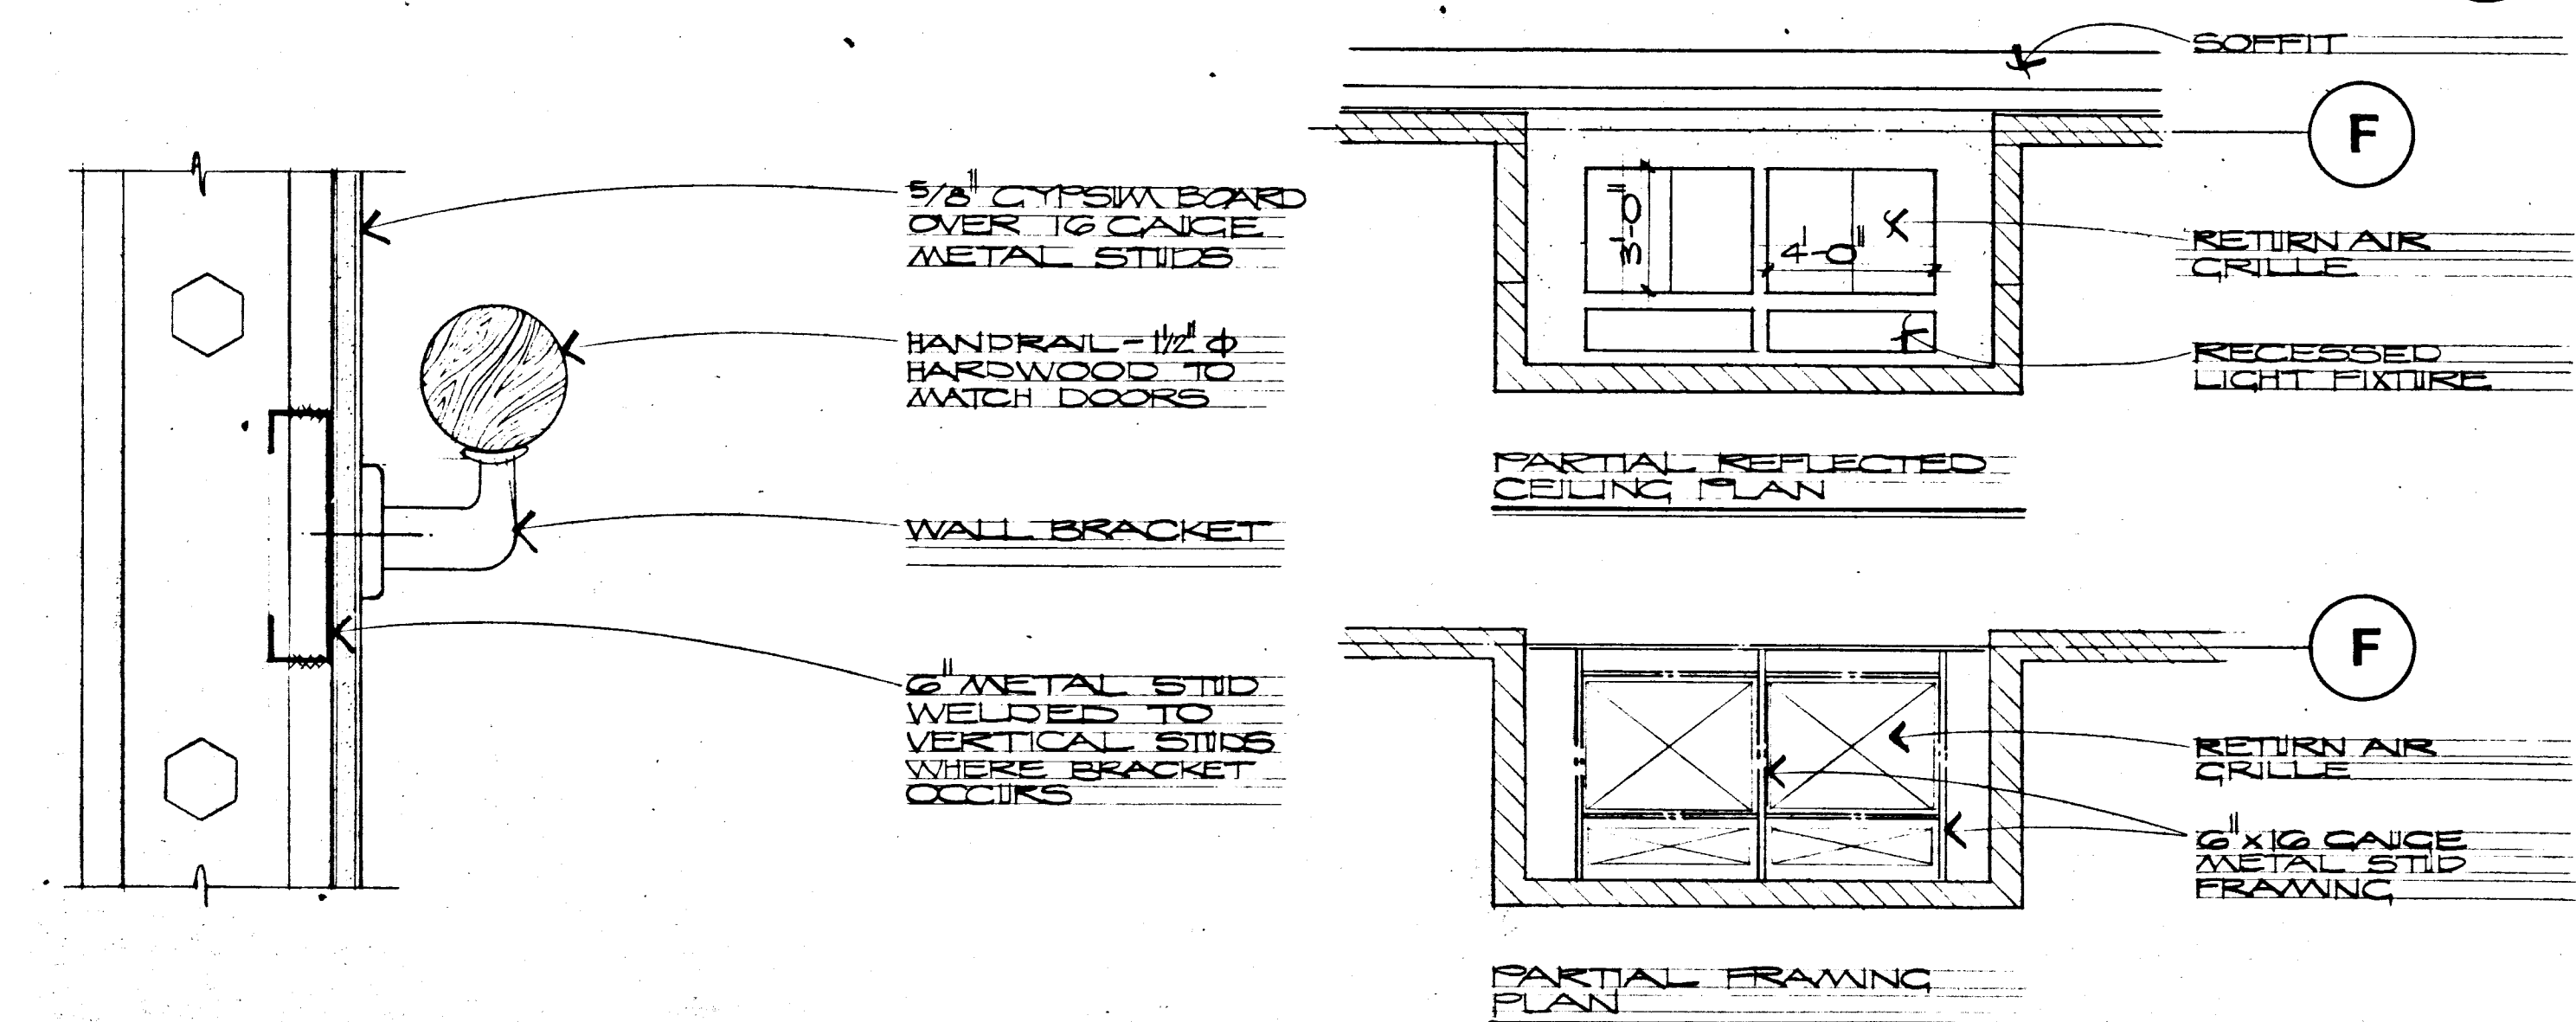

DETAIL

SCALE: 3" = 1'-0"


10
A-30

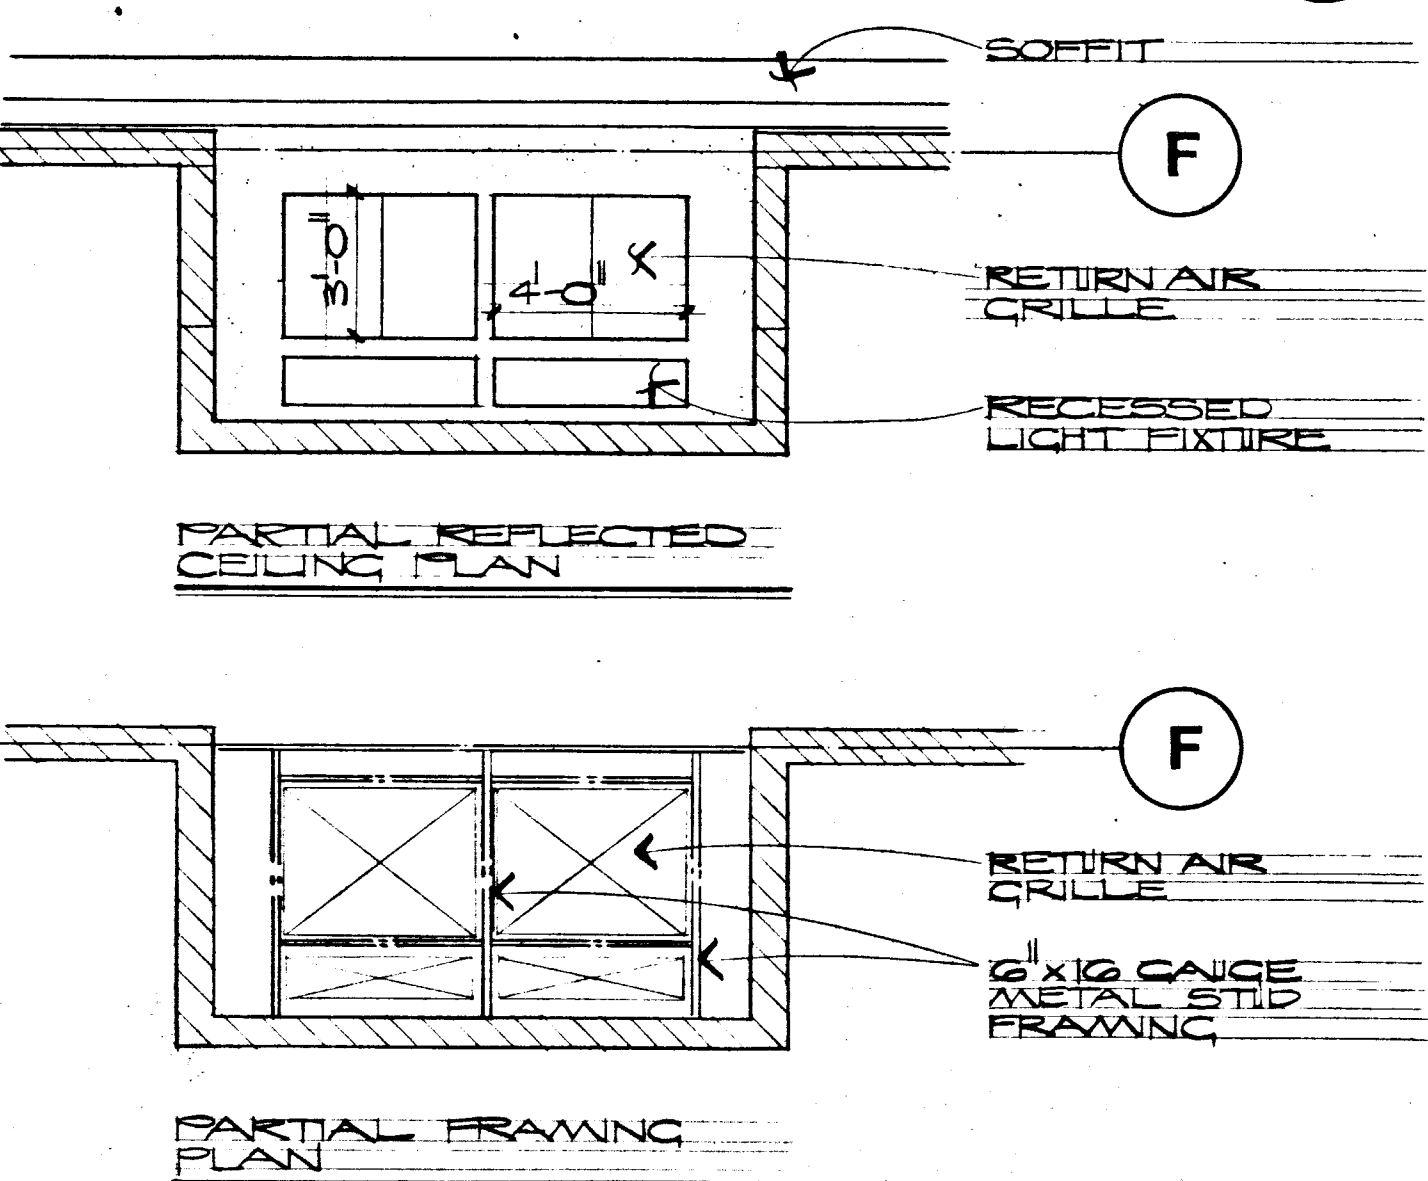

DETAIL

SCALE: 3" = 1'-0"


11
A-30

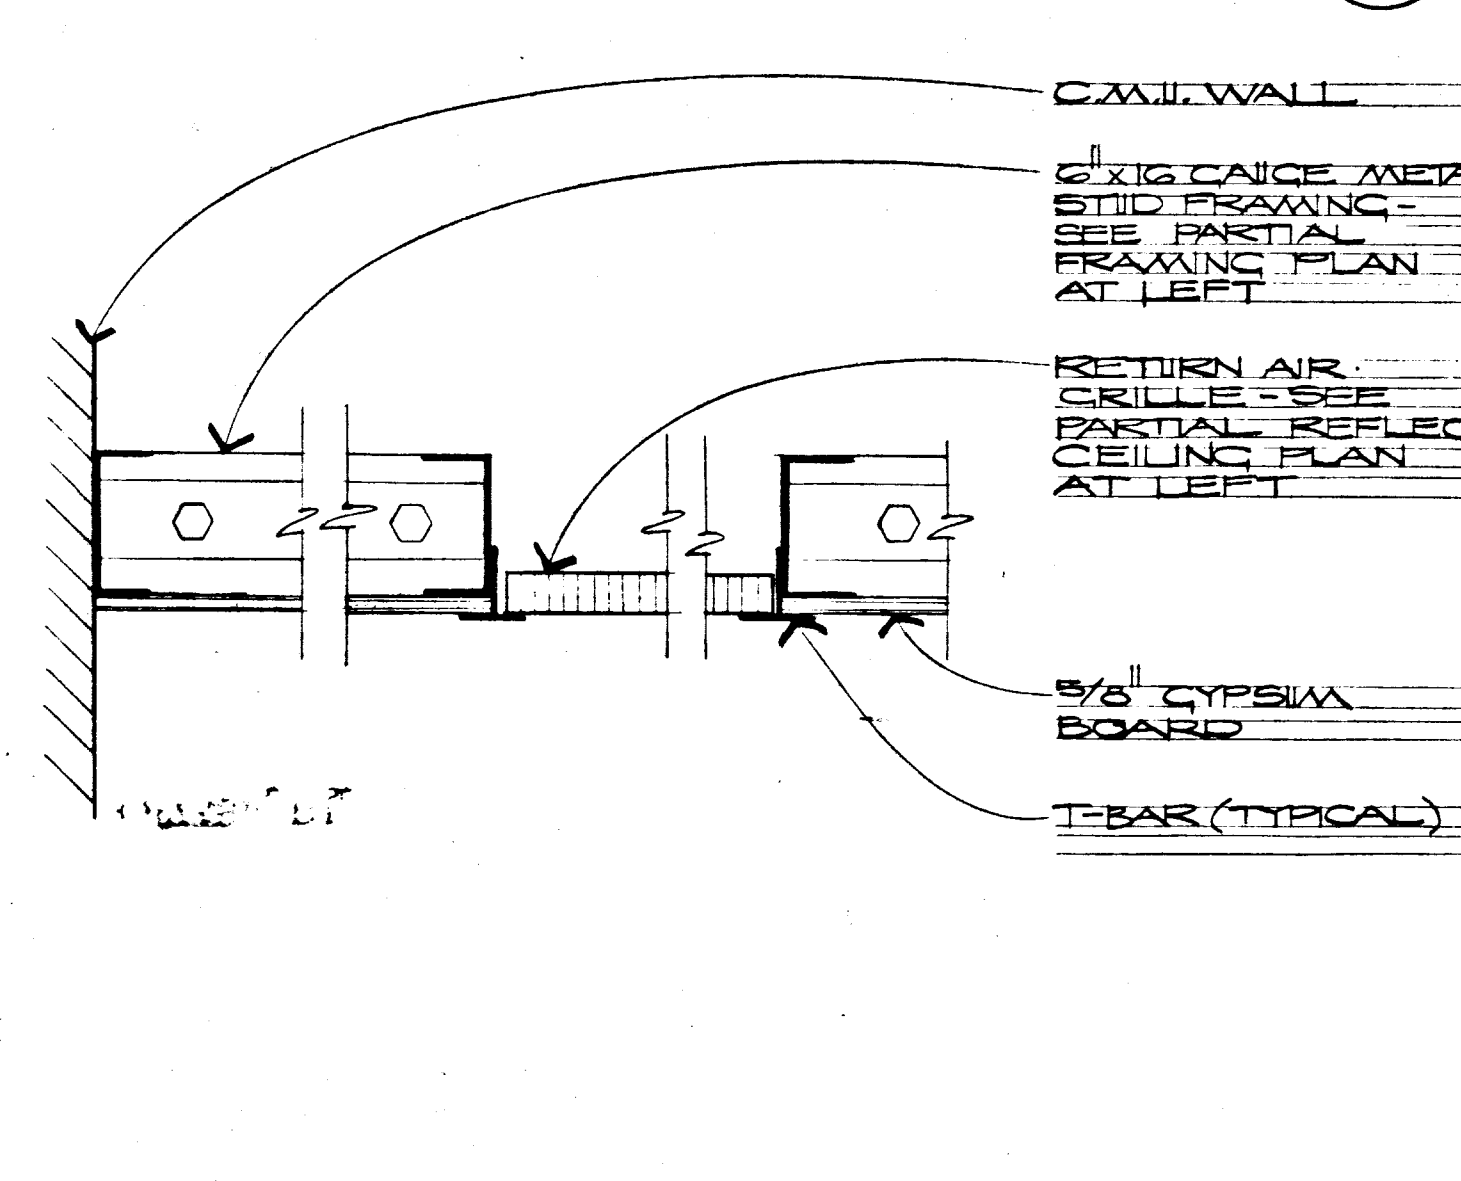

DETAIL

SCALE: 1 1/2" = 1'-0"


12
A-30

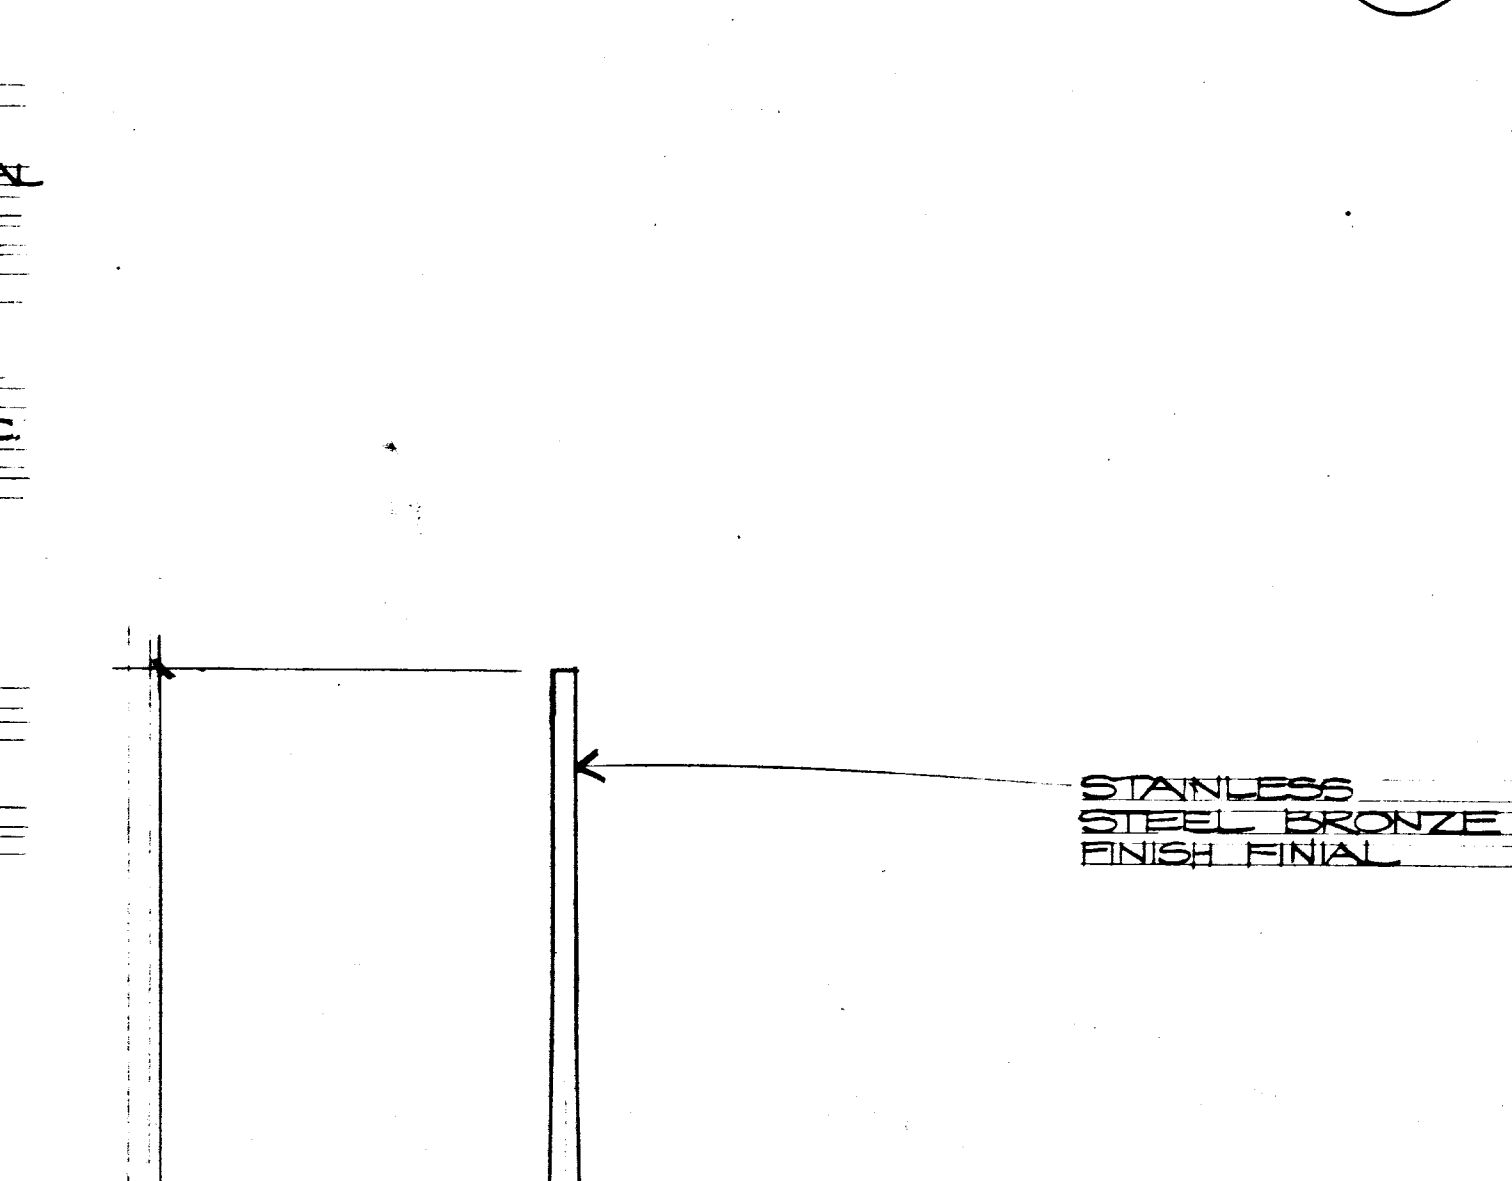

DETAIL

SCALE: 3" = 1'-0"


13
A-30

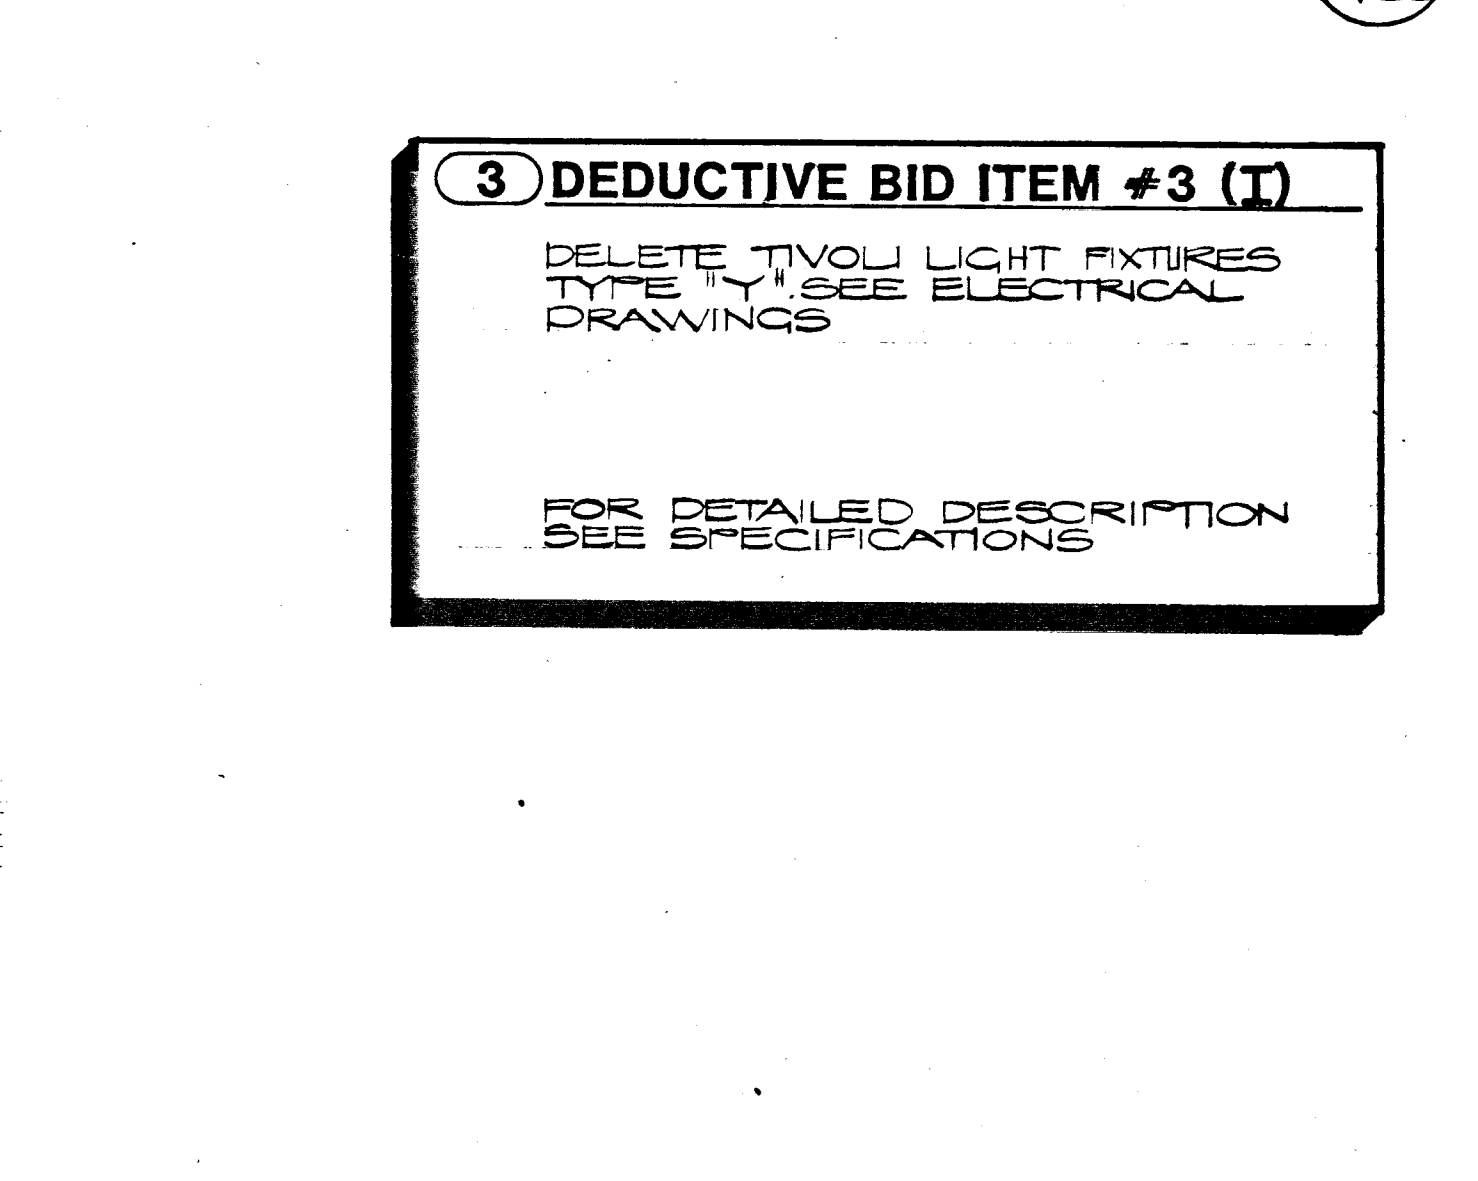

DETAIL


SCALE: 3" = 1'-0"

14
A-30

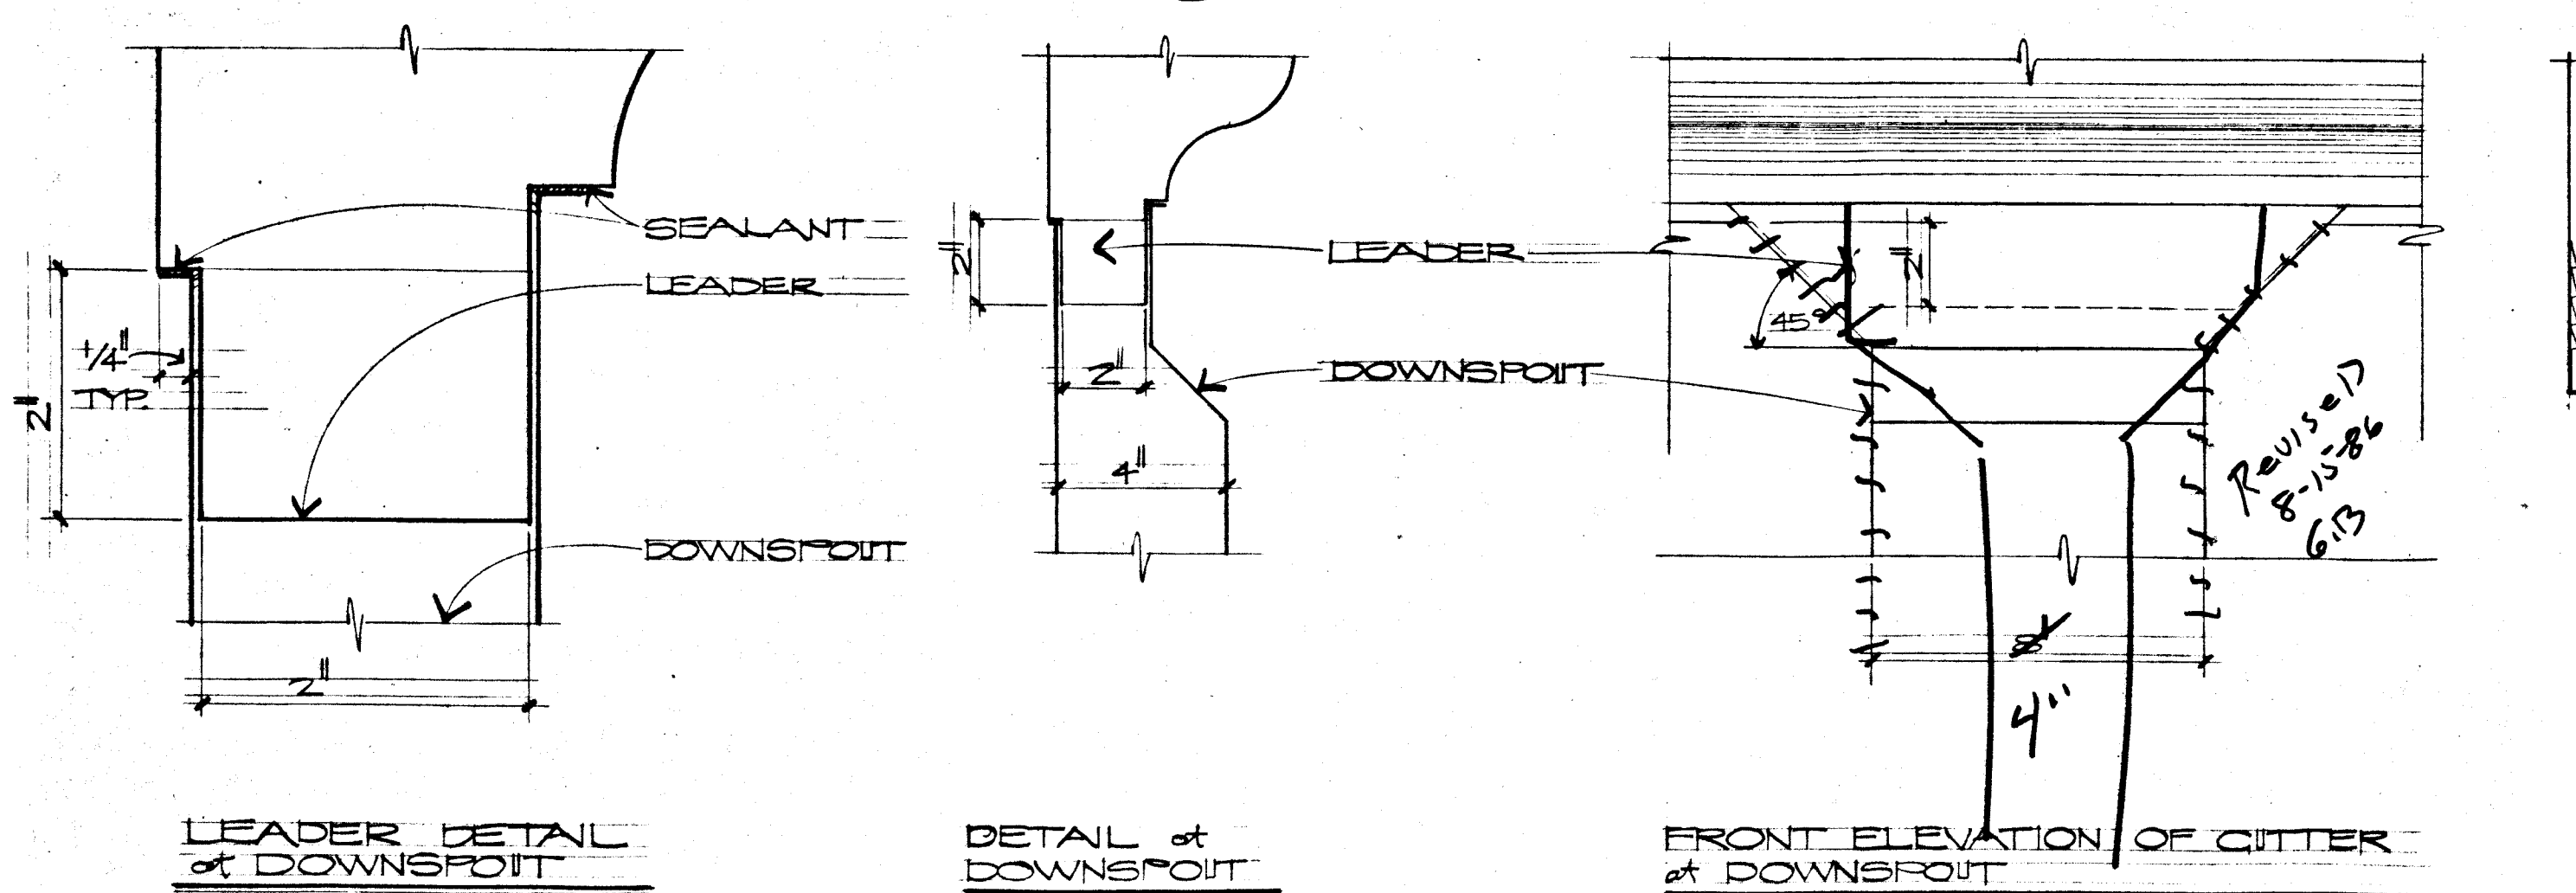

DOWNSPOUT DETAIL


N.T.S.

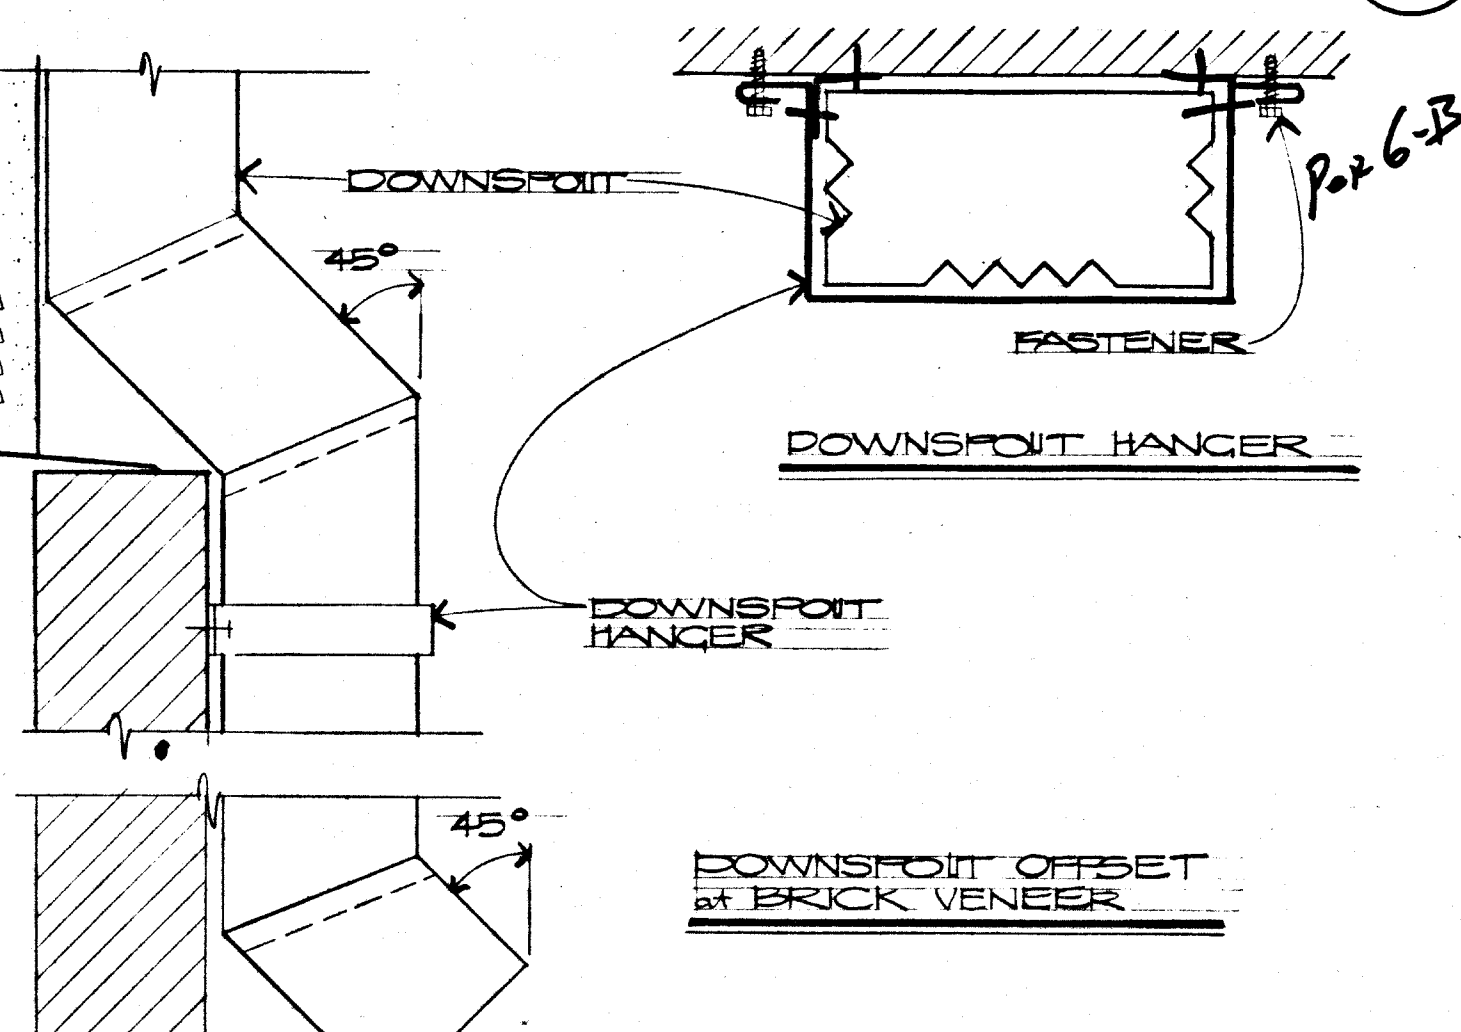

DETAIL

SCALE: 1 1/2" = 1'-0"


16
A-30

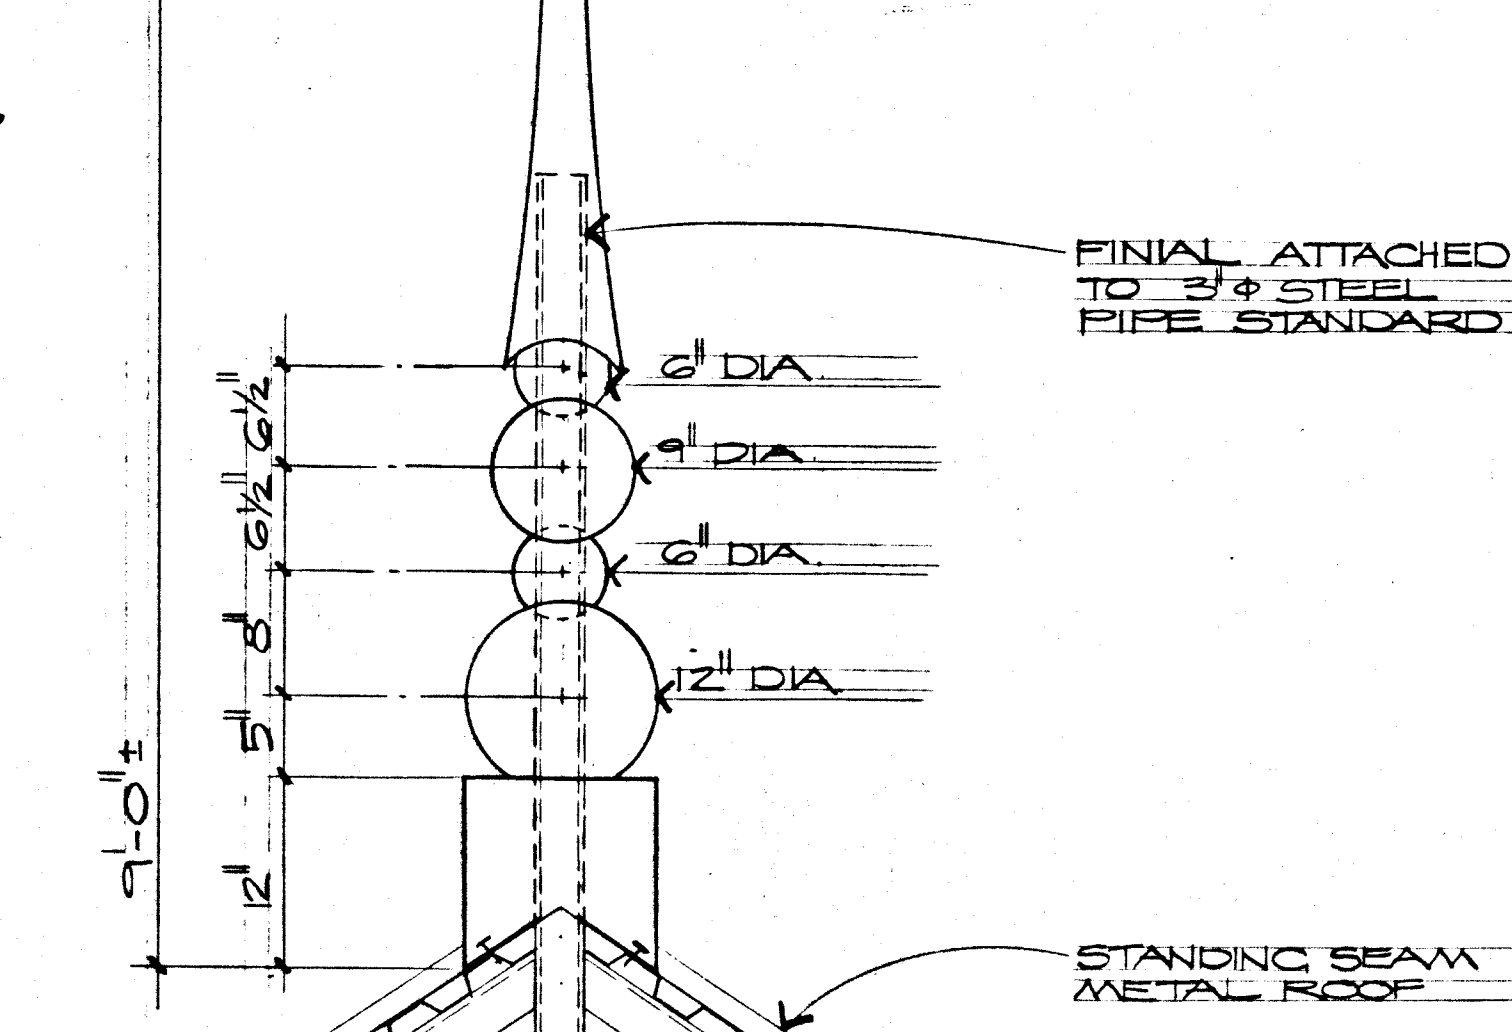

DETAIL

SCALE: 3" = 1'-0"

17
A-30

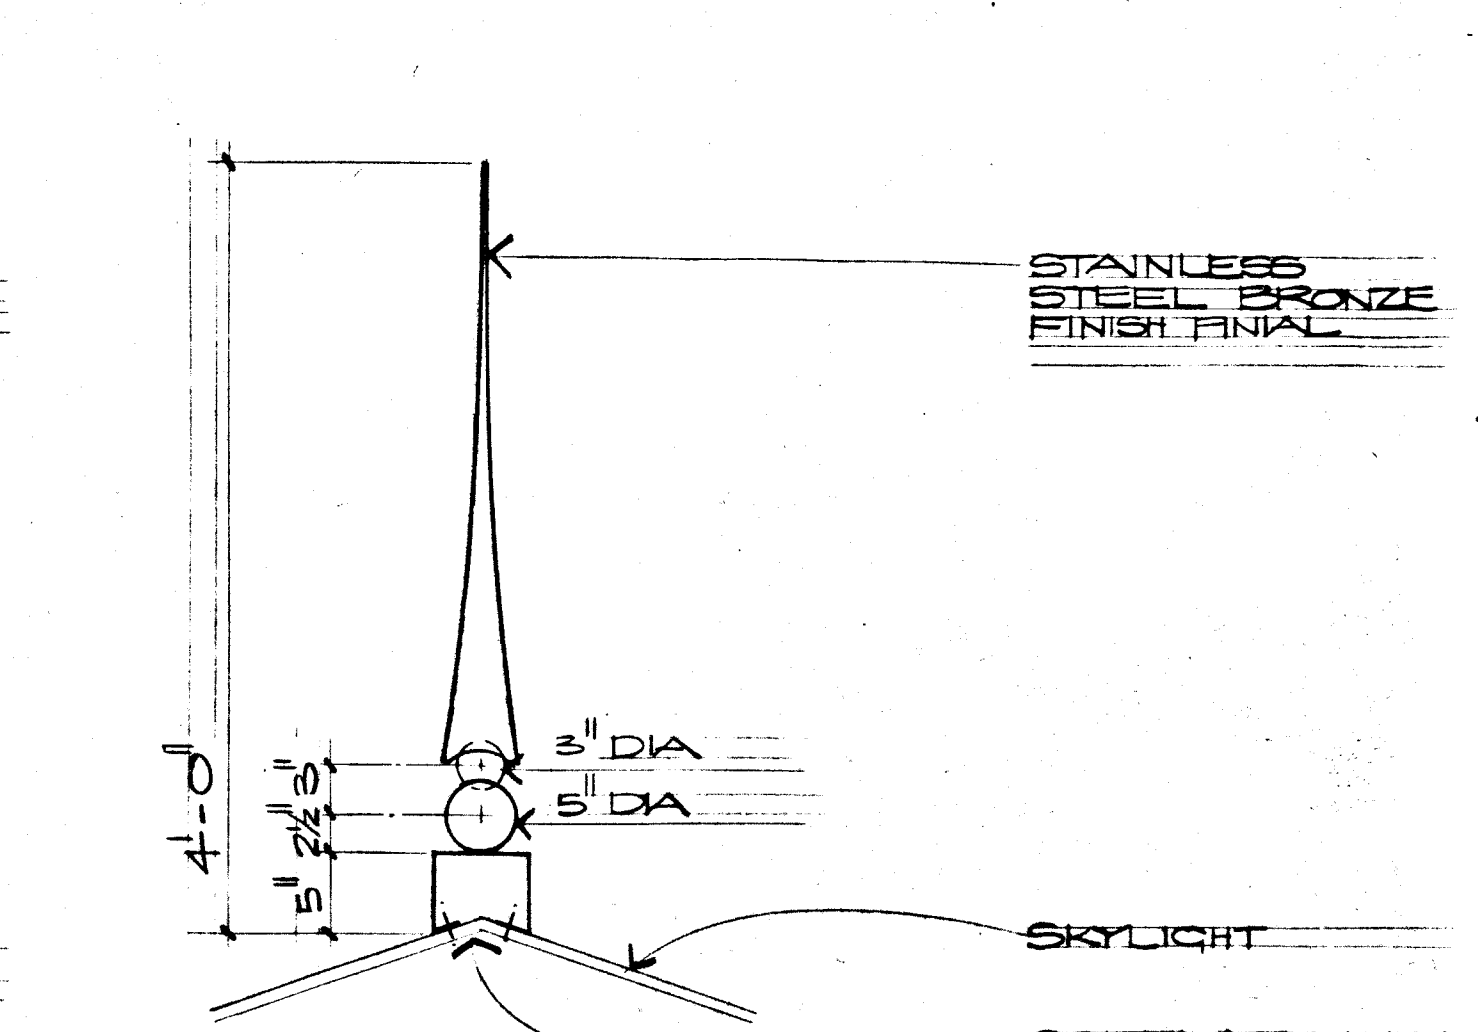

DETAIL

SCALE: 3" = 1'-0"

18
A-30

3 DEDUCTIVE BID ITEM #3 (1)
DELETE TIVOLI LIGHT FIXTURES
TYPE 11 SEE ELECTRICAL
DRAWINGS
FOR DETAILED DESCRIPTION
SEE SPECIFICATIONS

DOBROSKY KITTRELL GARLOCK
Architects
3033 CAMBRIDGE ST. LAS VEGAS, NEVADA 89106
(702) 735-0435

City of Las Vegas
Transportation Center
Downtown
Las Vegas, Nevada

A-30
39 of 65
3/26/2017