
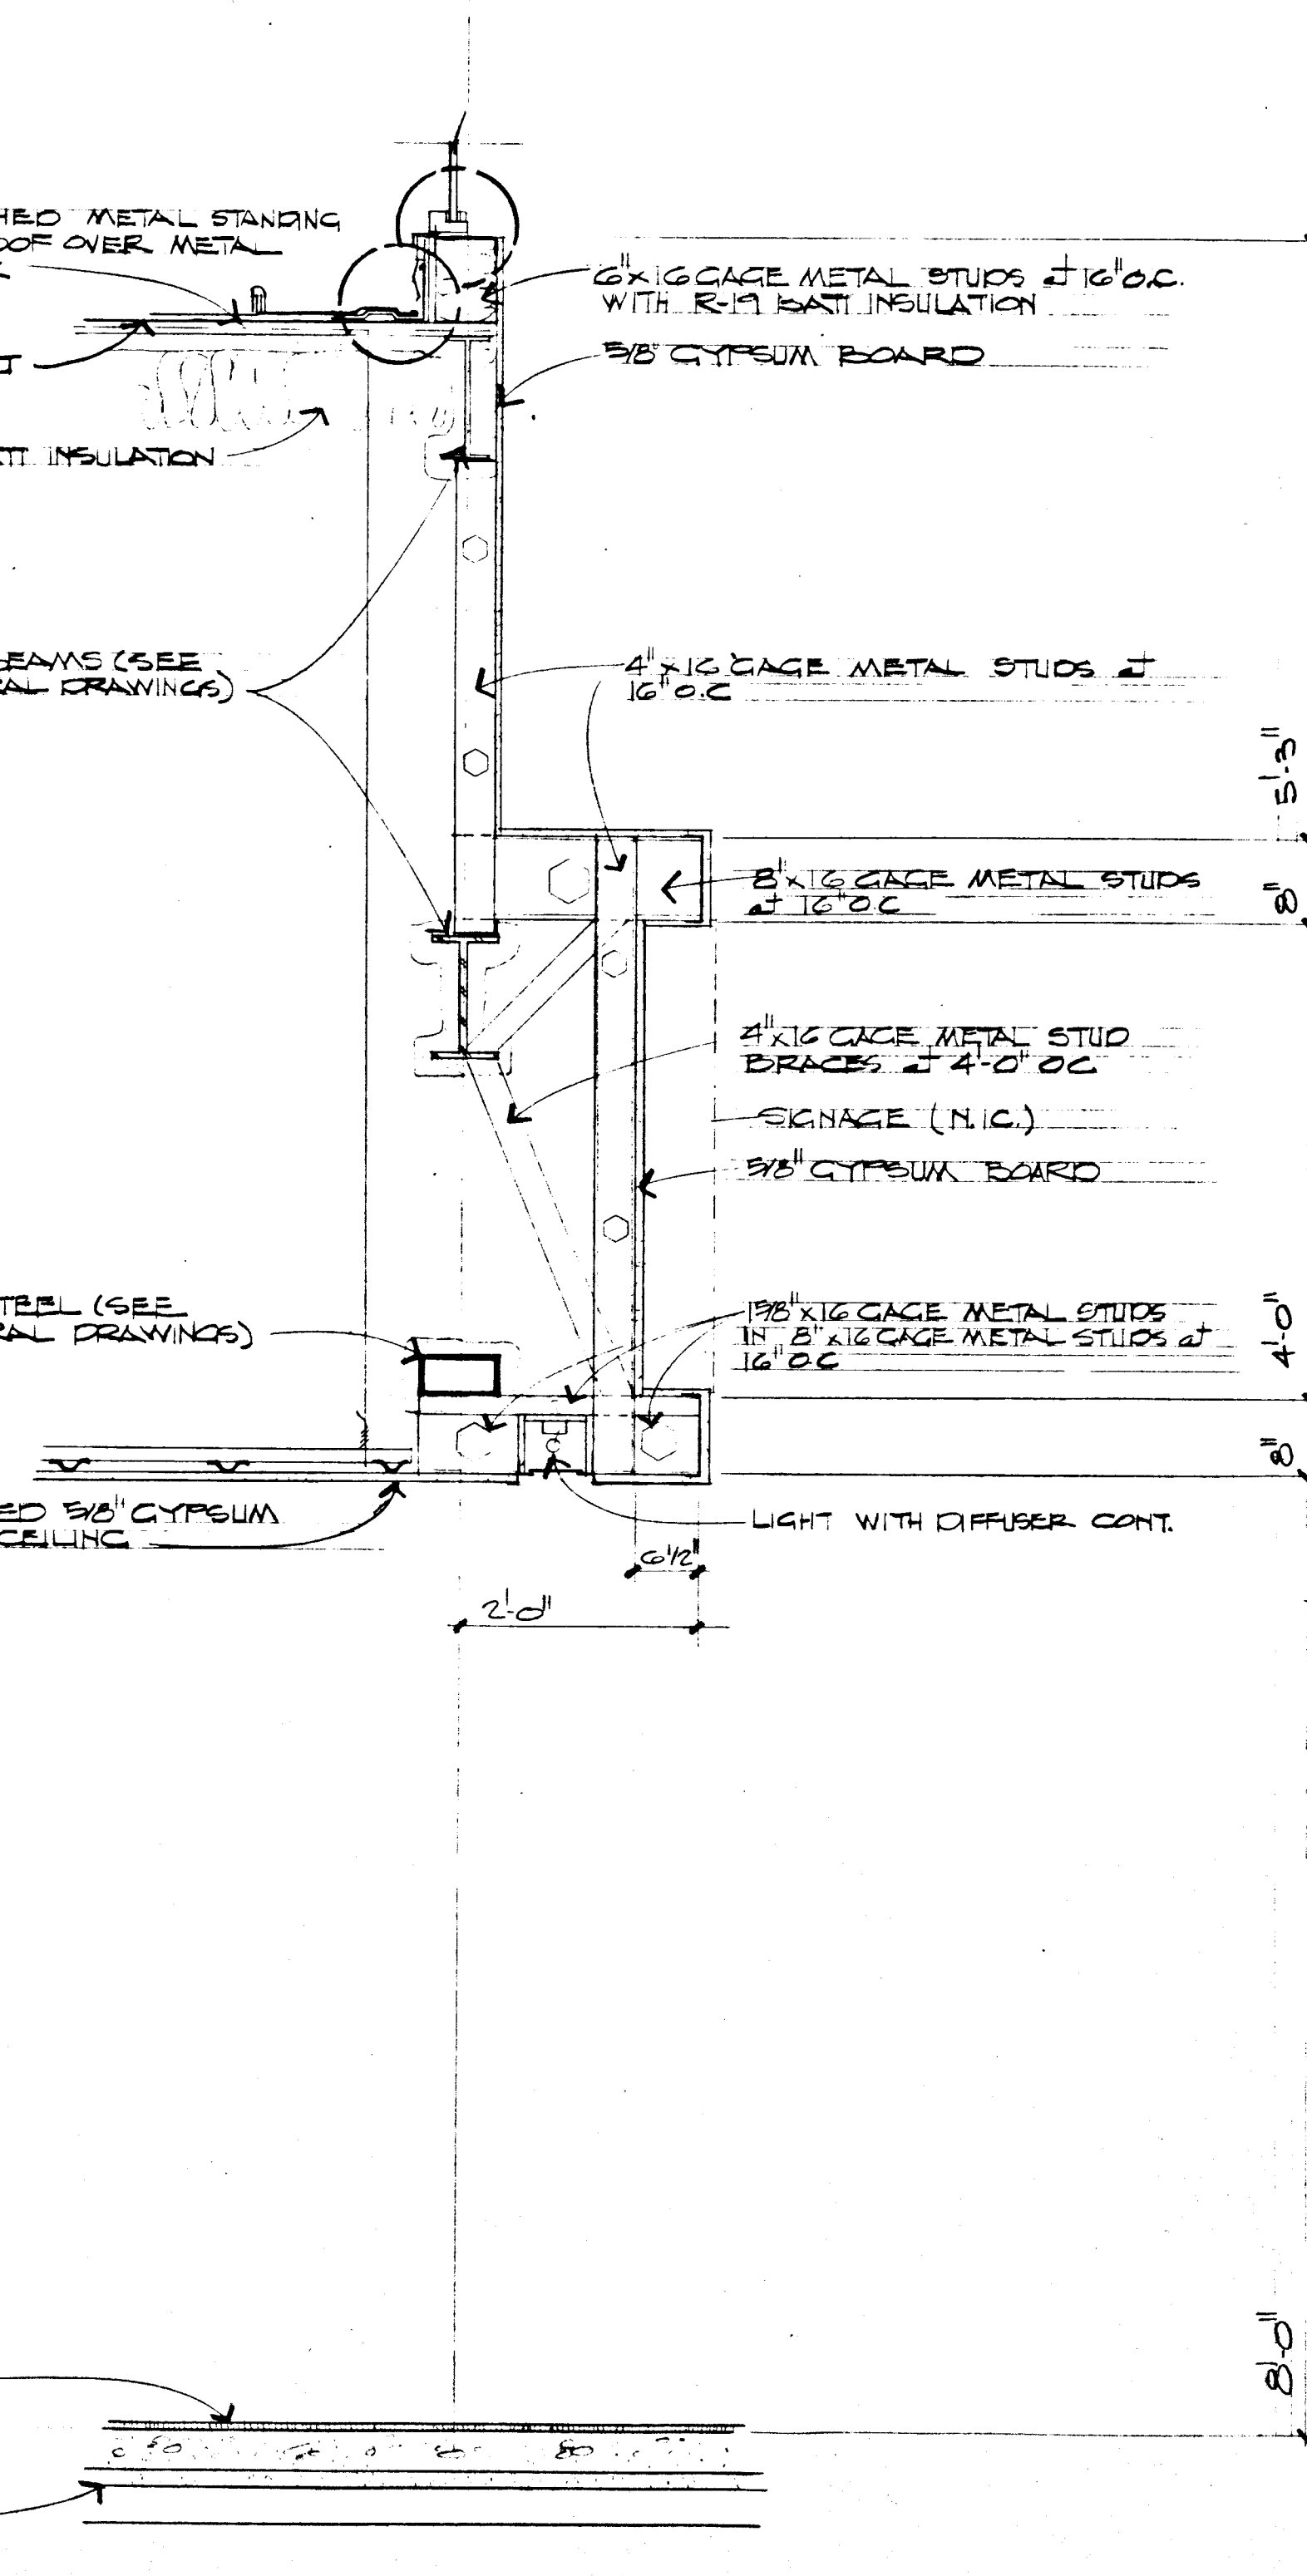
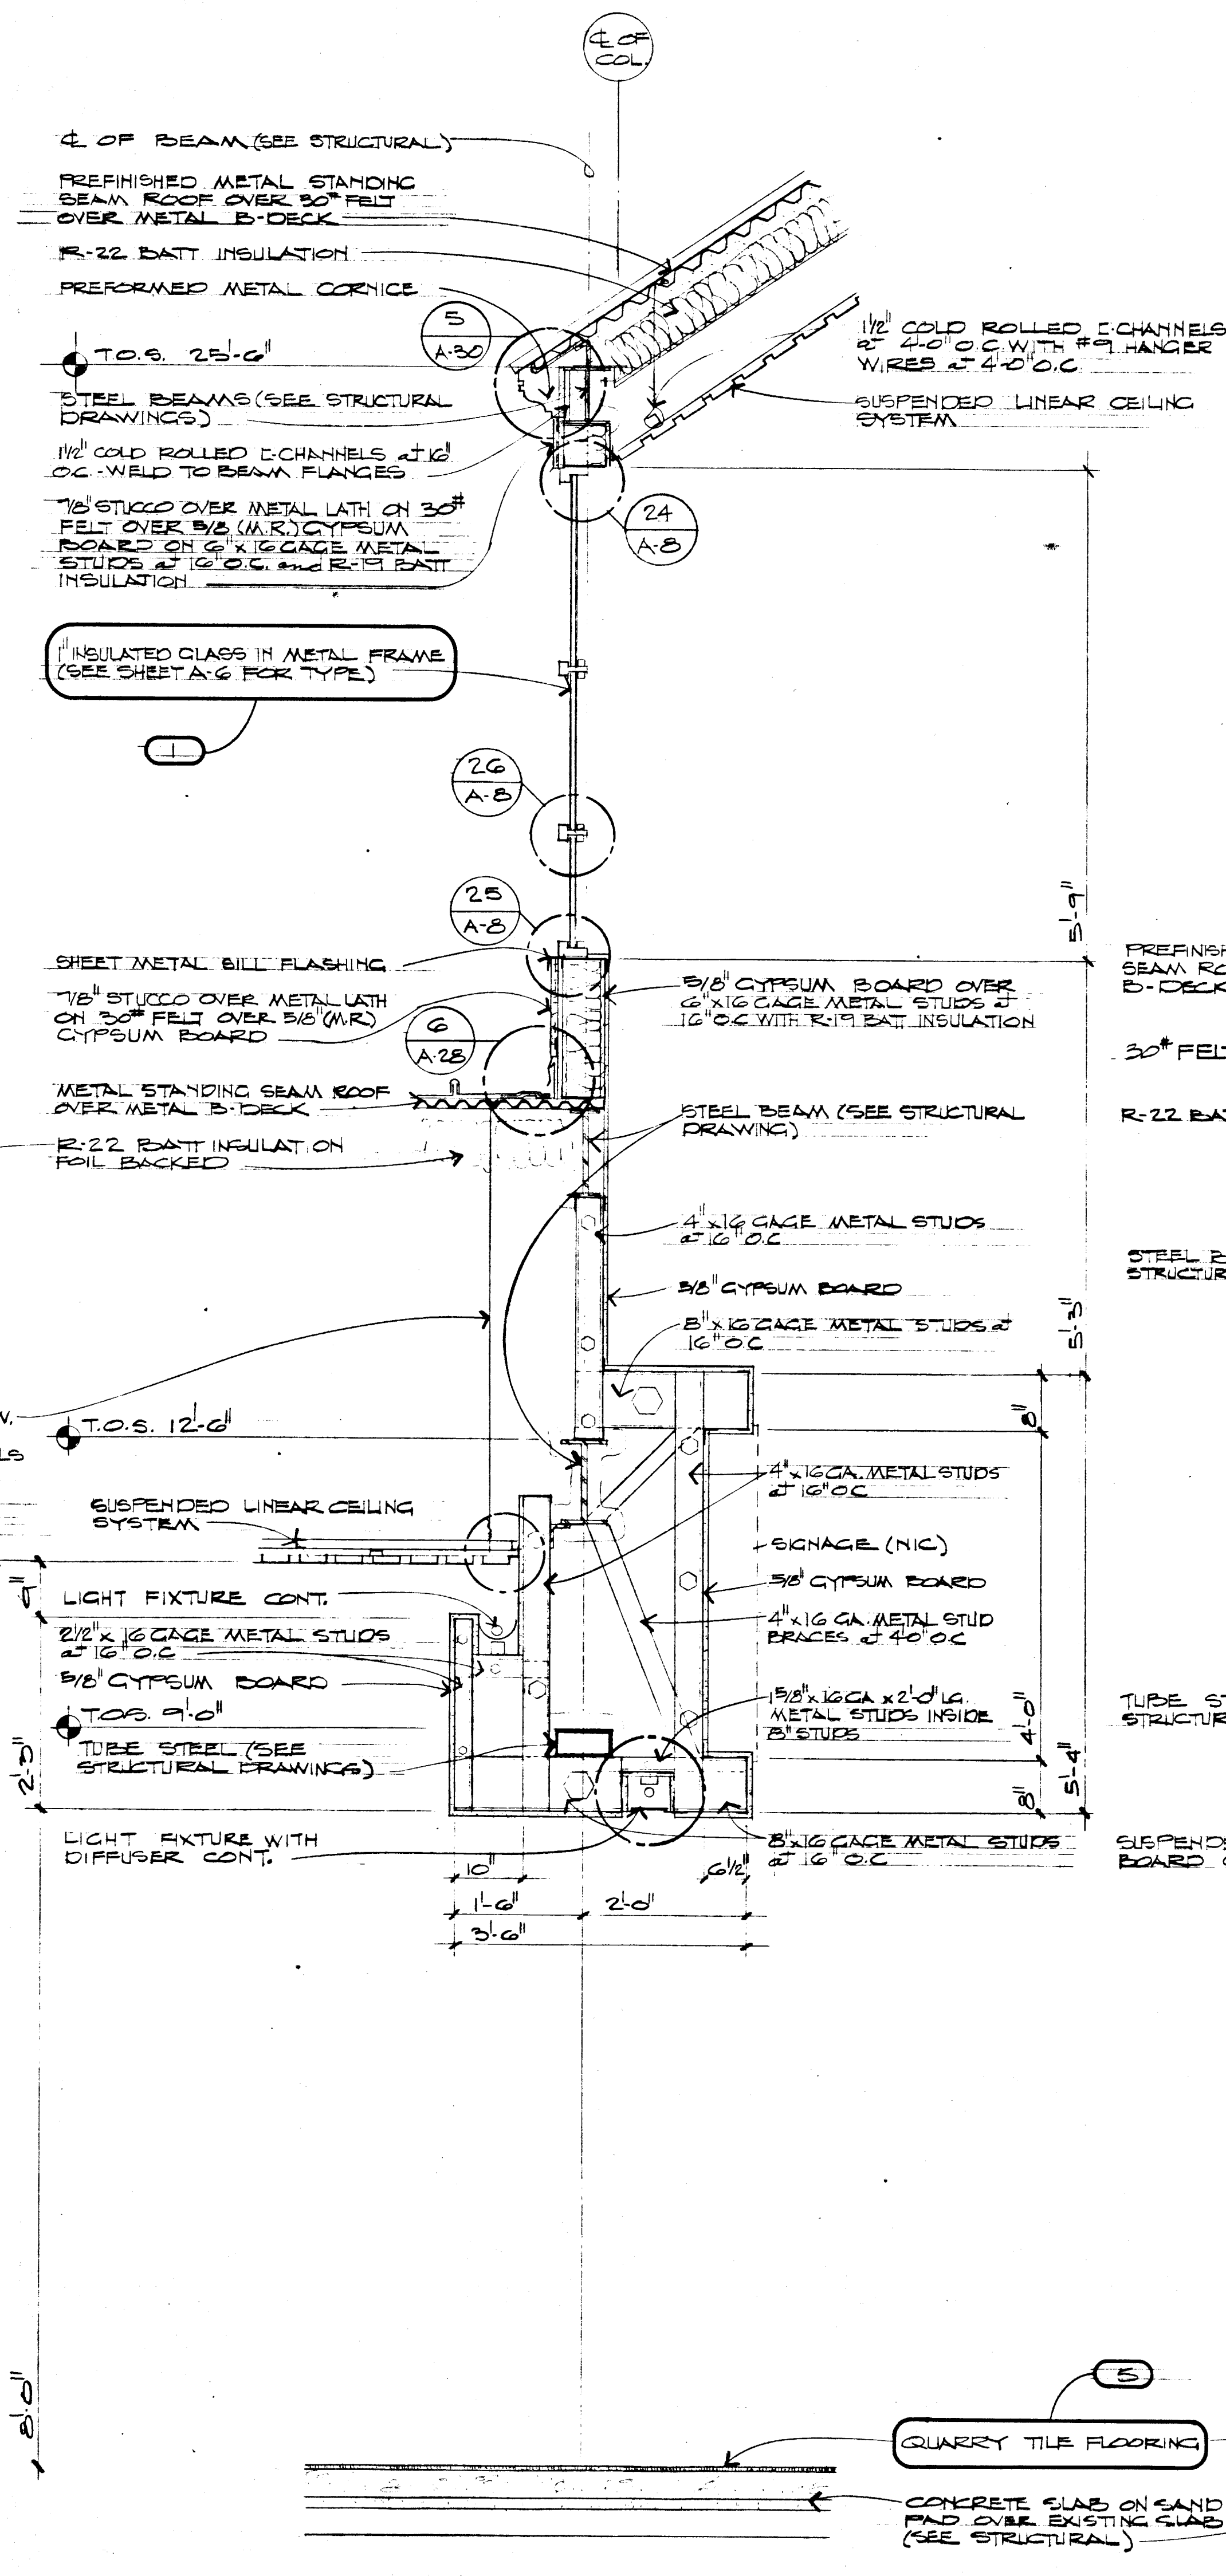
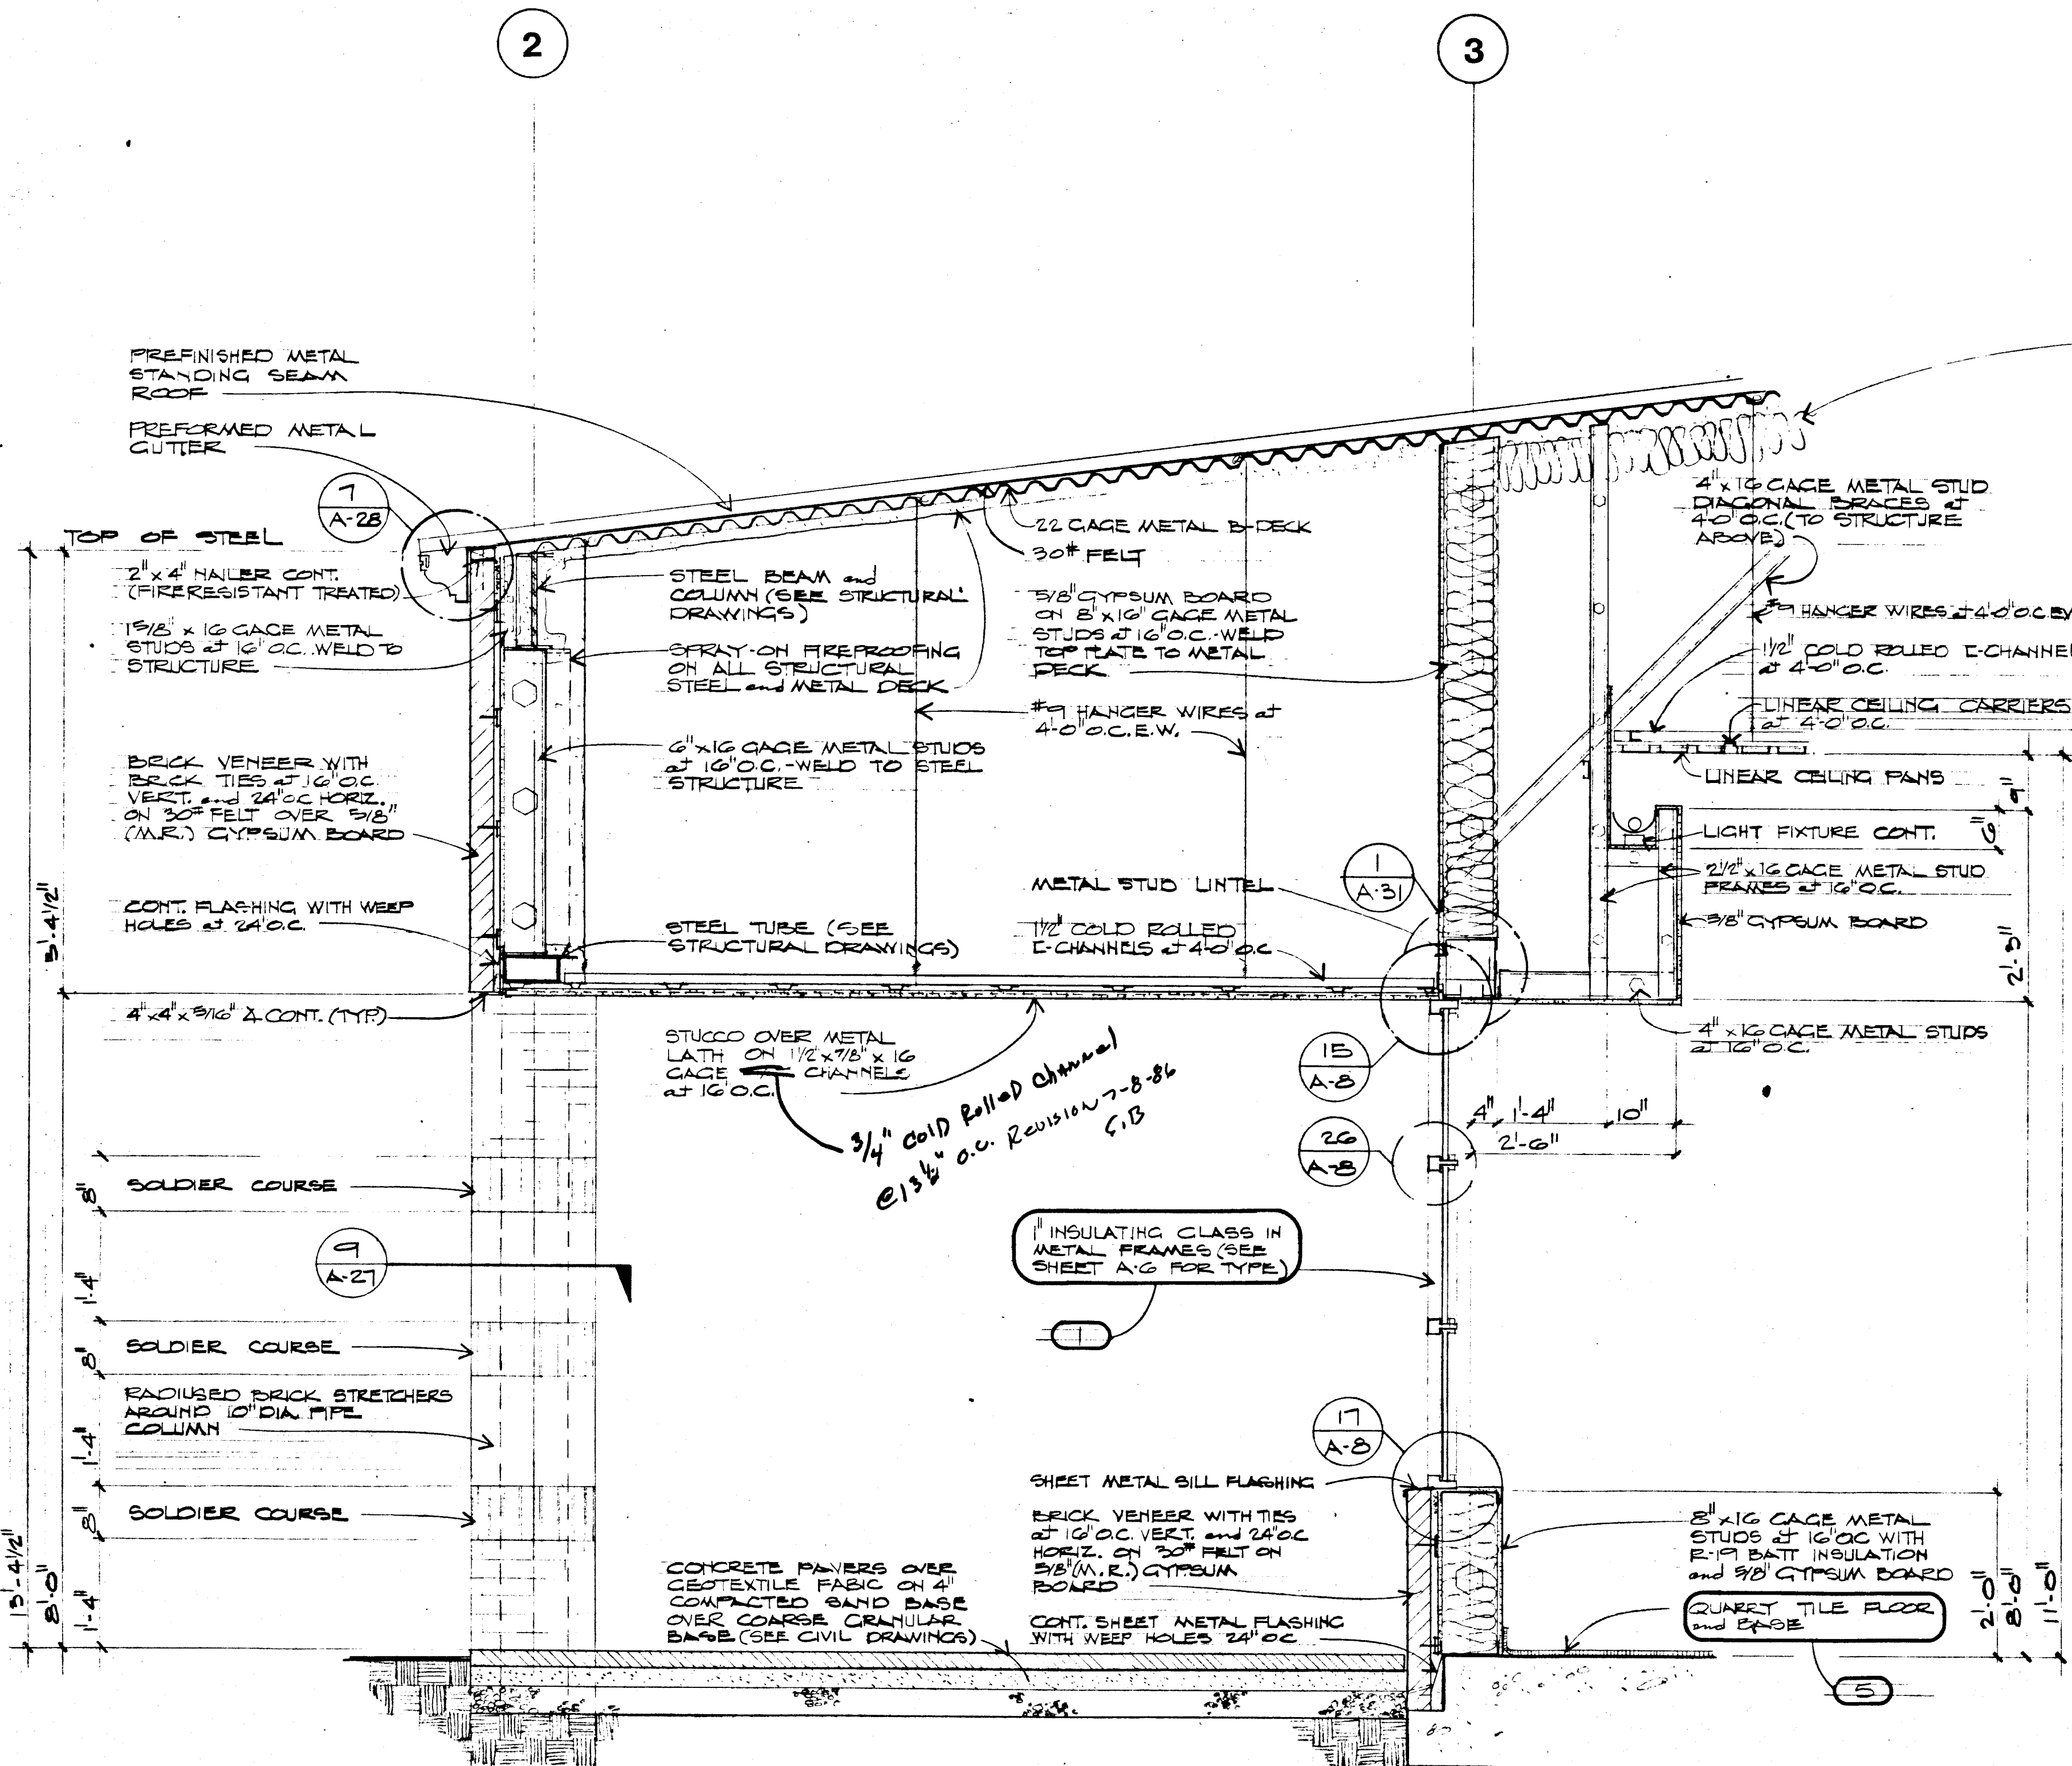


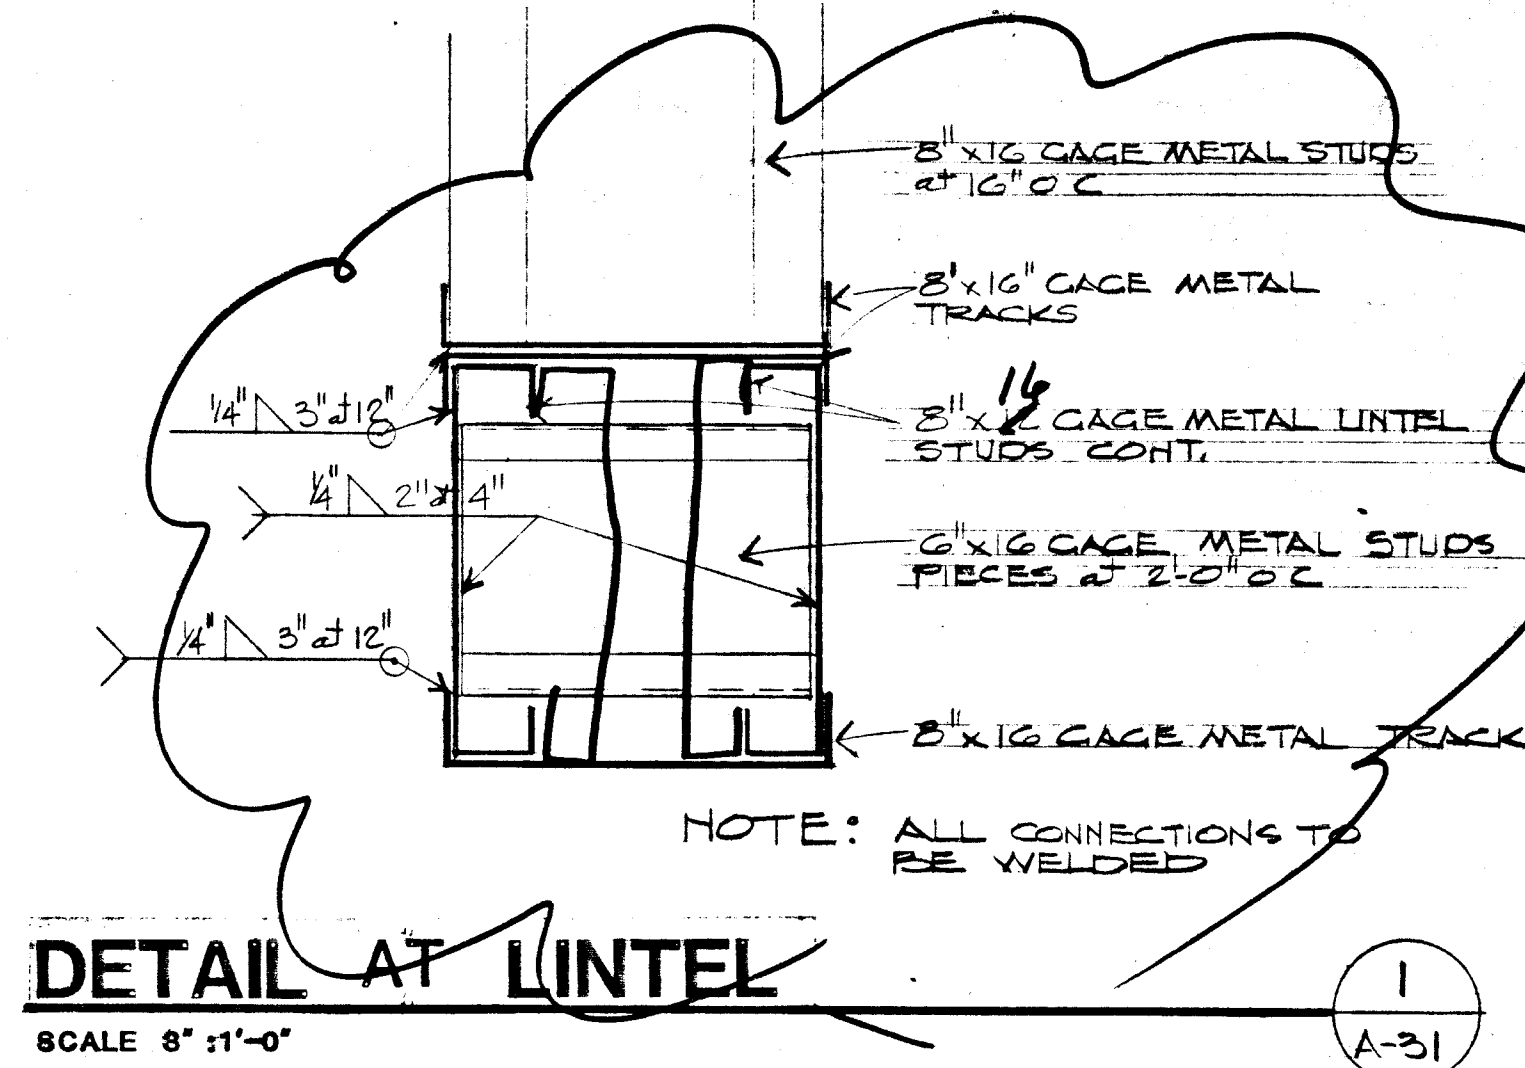

- 1 DEDUCTIVE BID ITEM #1 (I)**
IN LIEU OF METAL WINDOW FRAMES AS SHOWN, SUBSTITUTE ALUMINUM WINDOW FRAMES.
- 5 DEDUCTIVE BID ITEM #5 (I)**
IN LIEU OF CERAMIC (QUARRY) TILE FLOOR AND BASE AS SHOWN, SUBSTITUTE VINYL TILE FLOOR AND BASE.
- FOR DETAIL DESCRIPTION SEE SPECIFICATIONS

WALL SECTION

WALL SECTION

WALL SECTION