



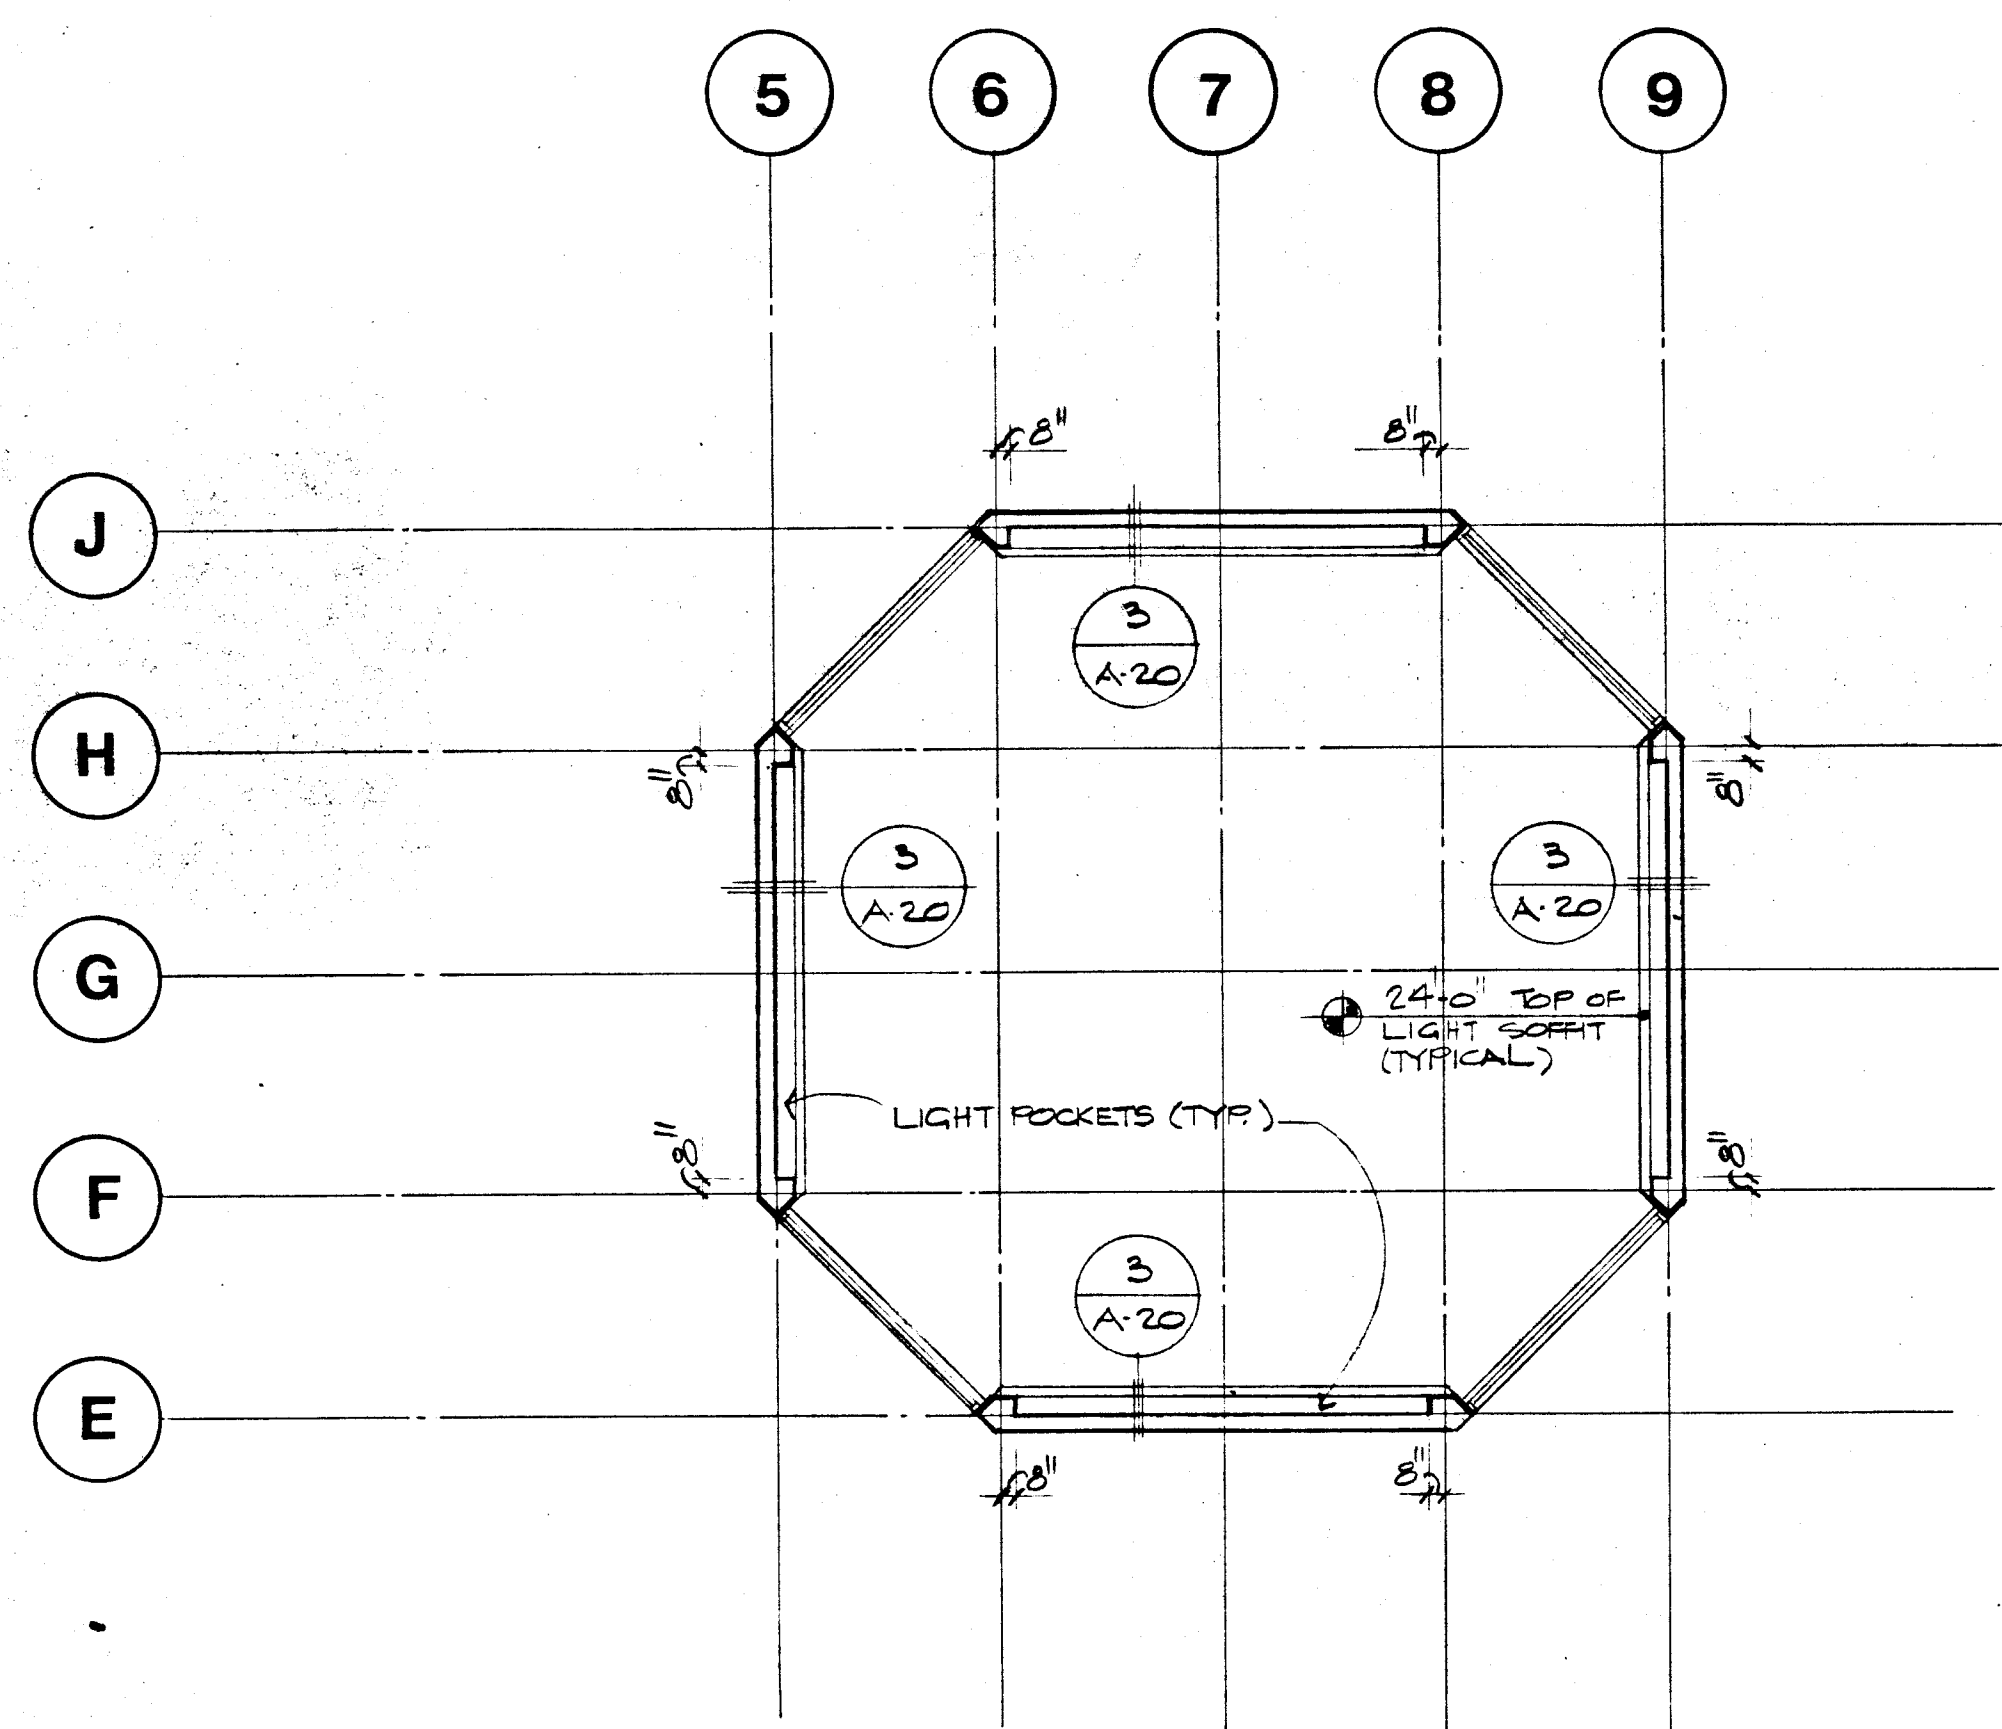


HIGH SOFFIT PLAN

SCALE 1/8" = 1'-0"

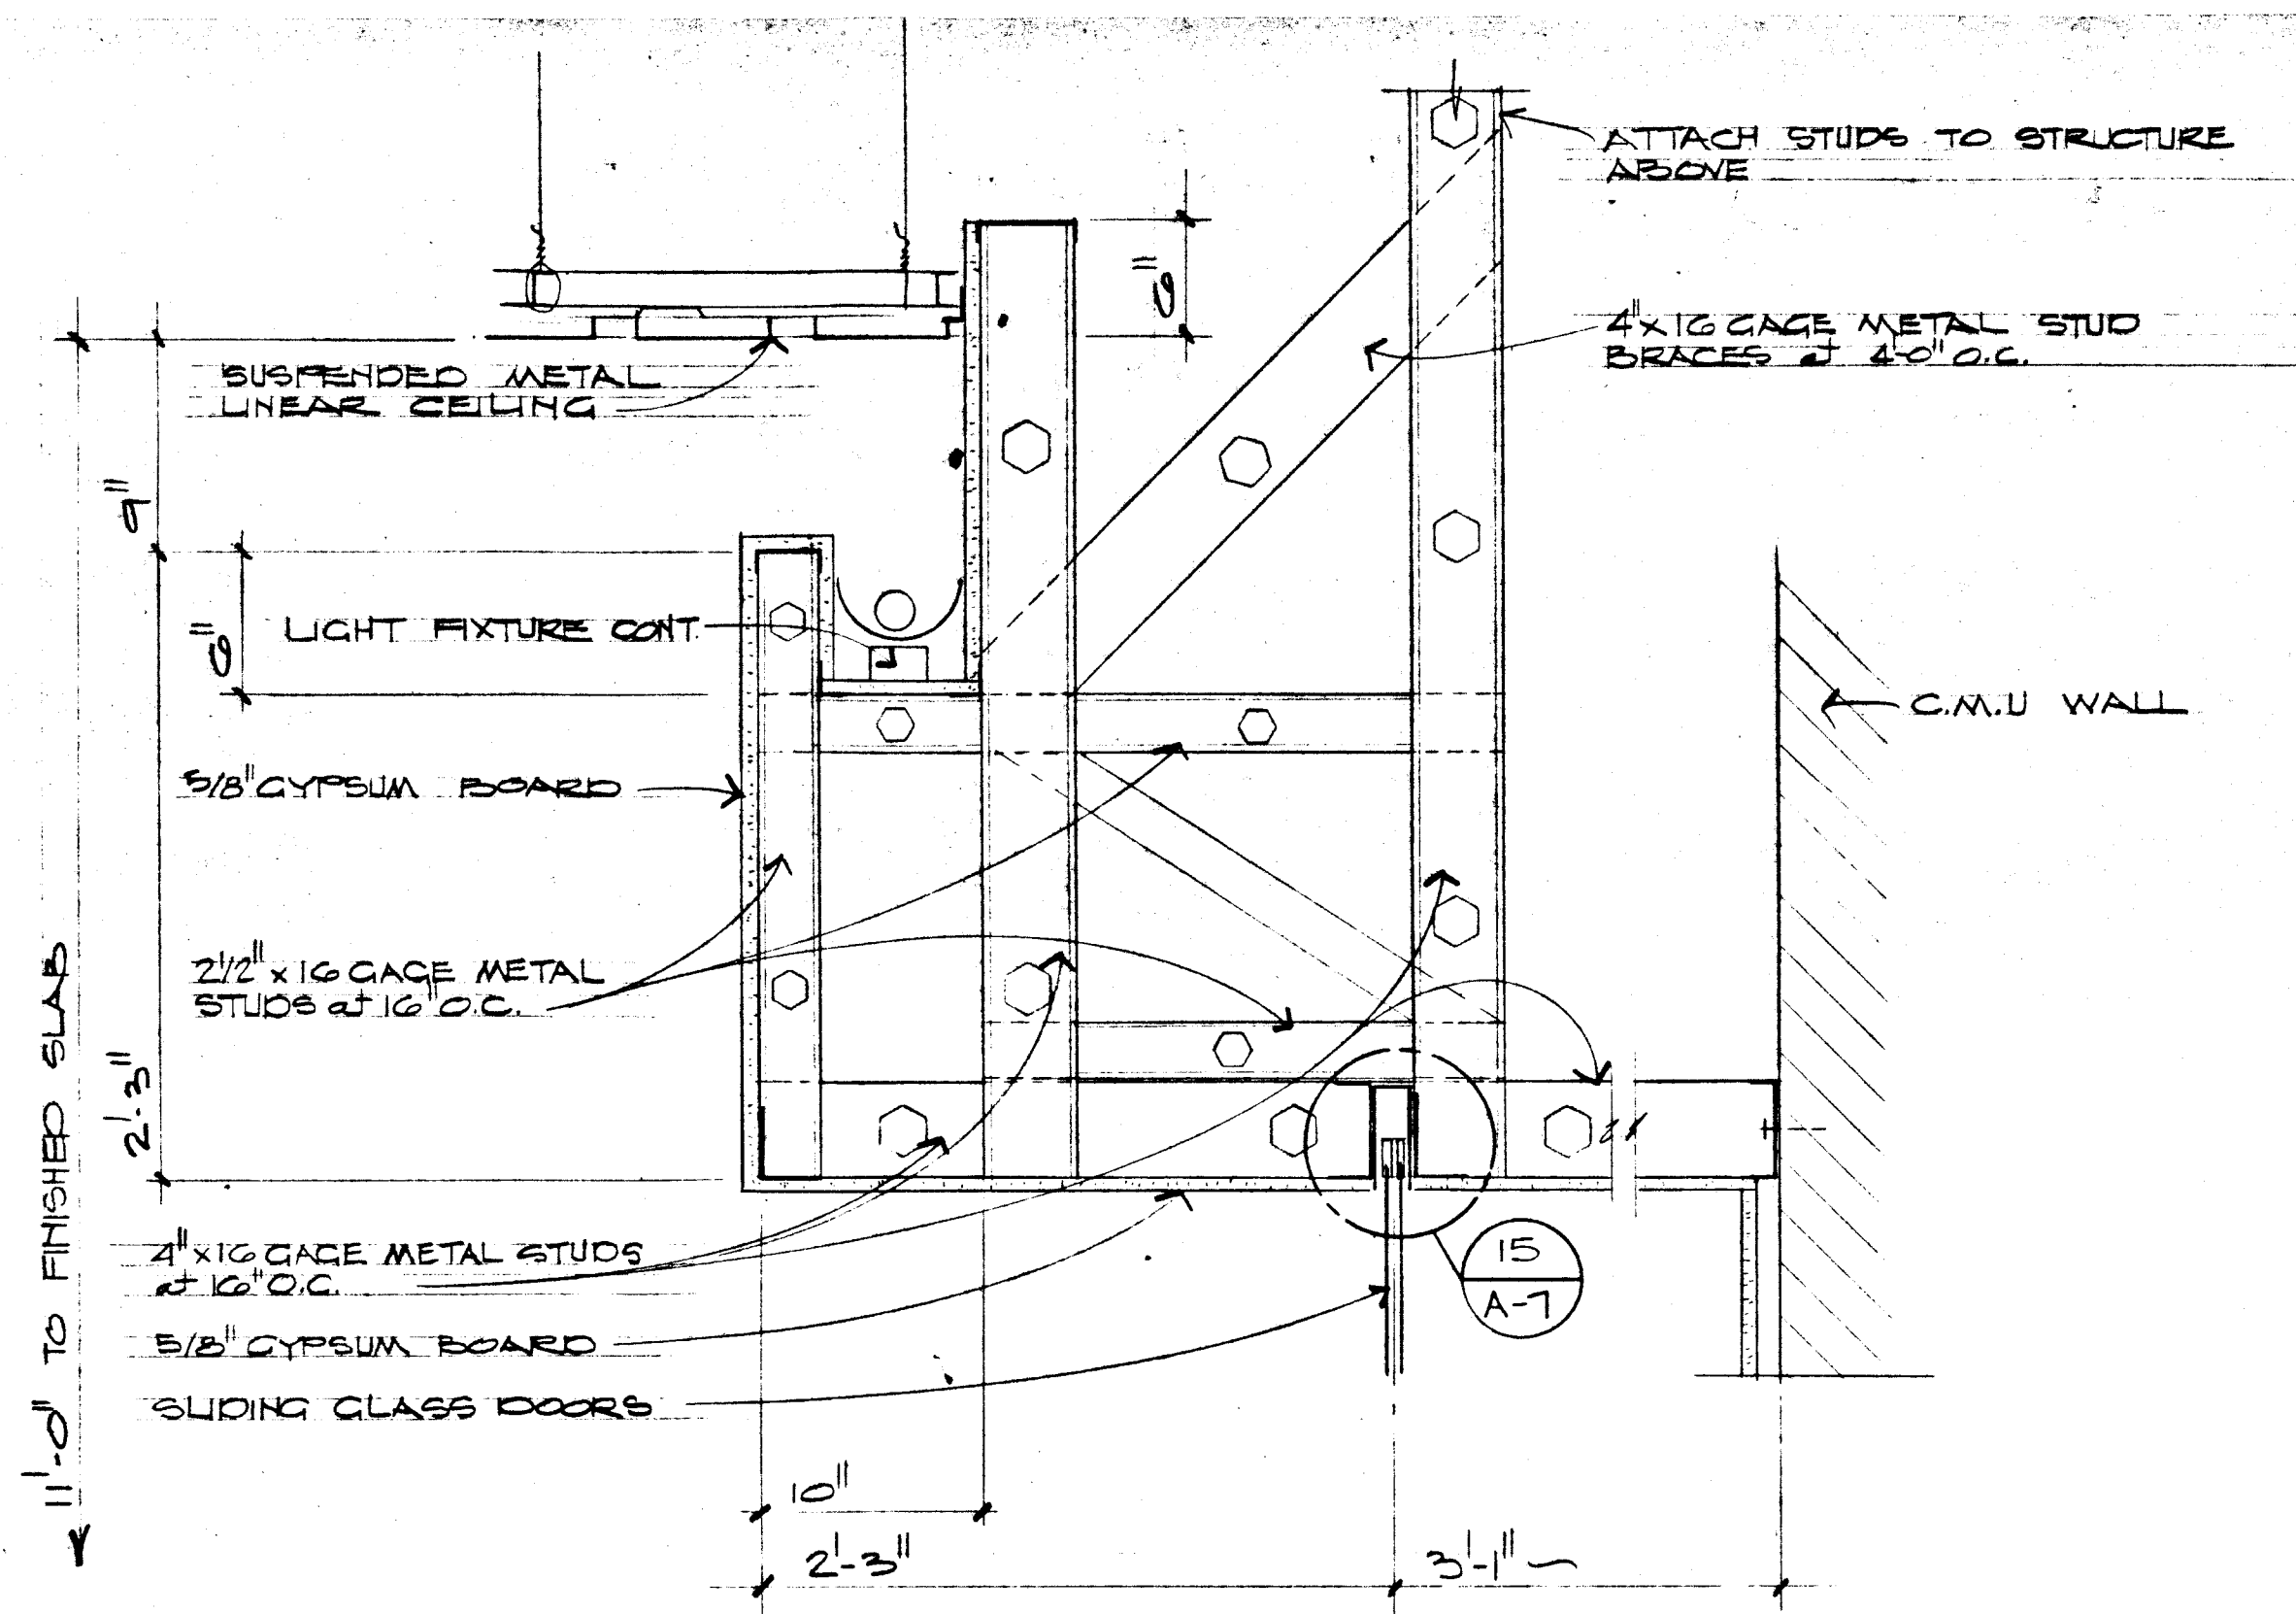


DETAIL

SCALE 1 1/2" = 1'-0"

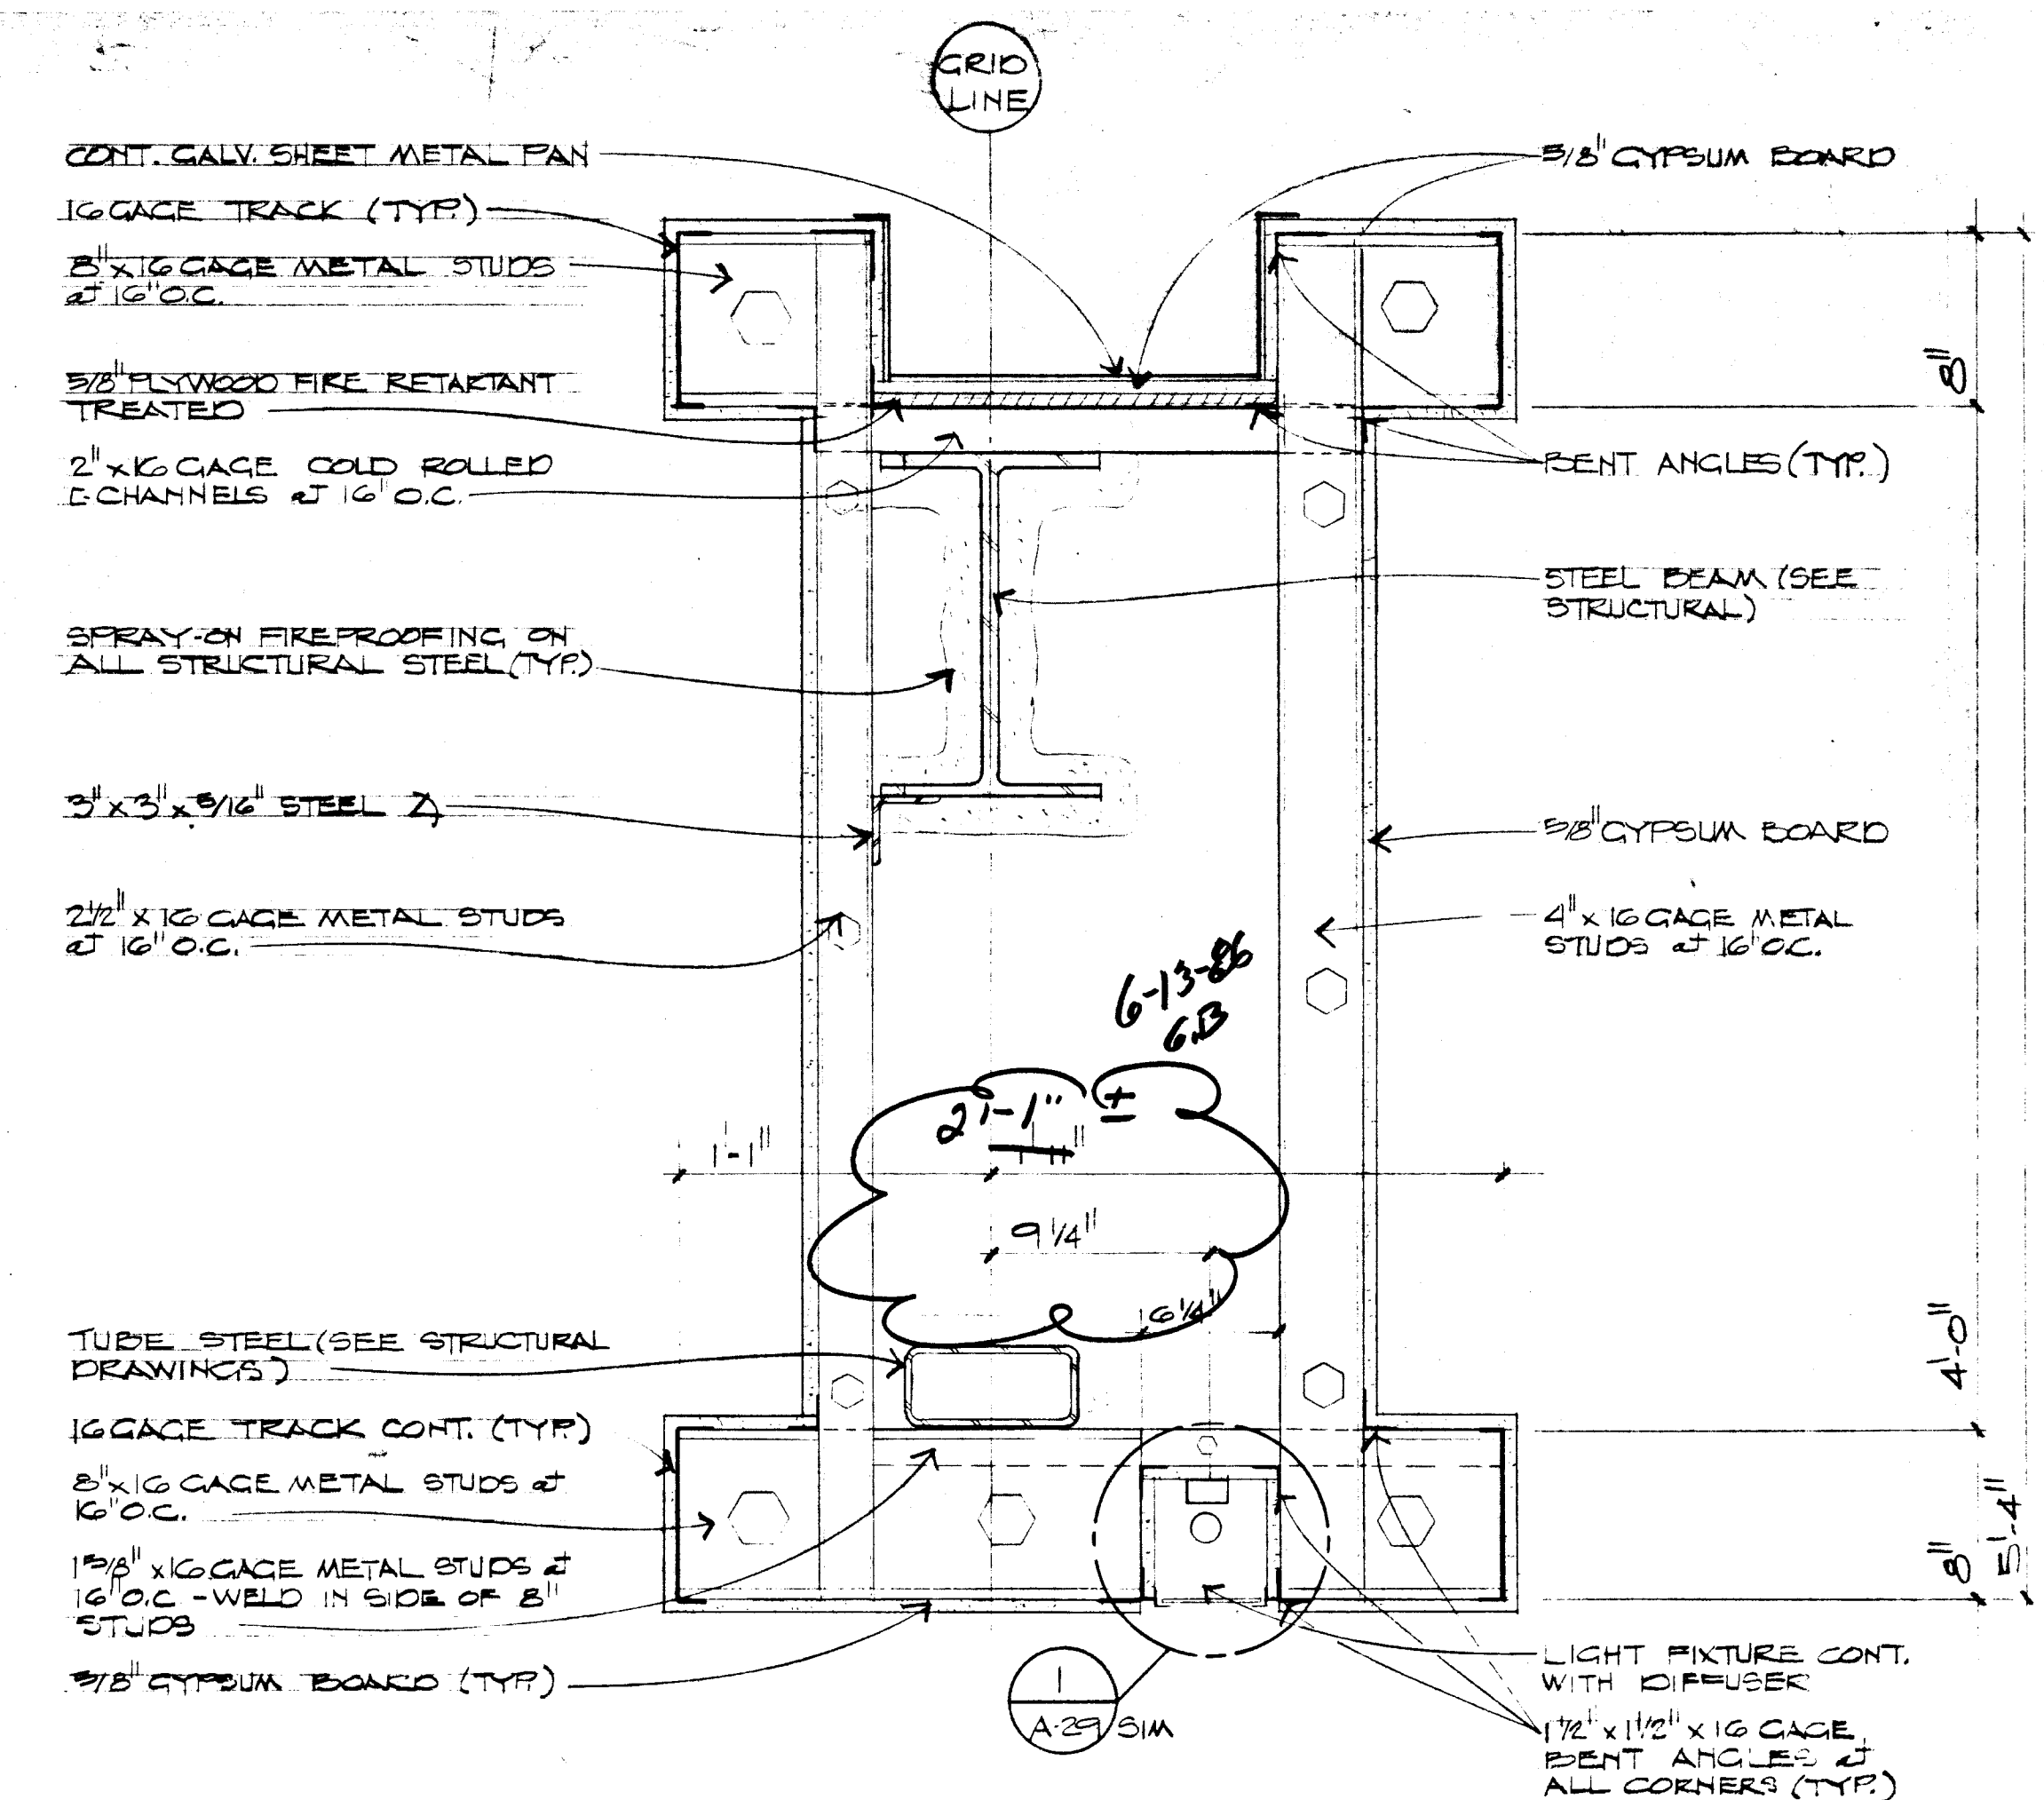

DETAIL

SCALE 1 1/2" = 1'-0"

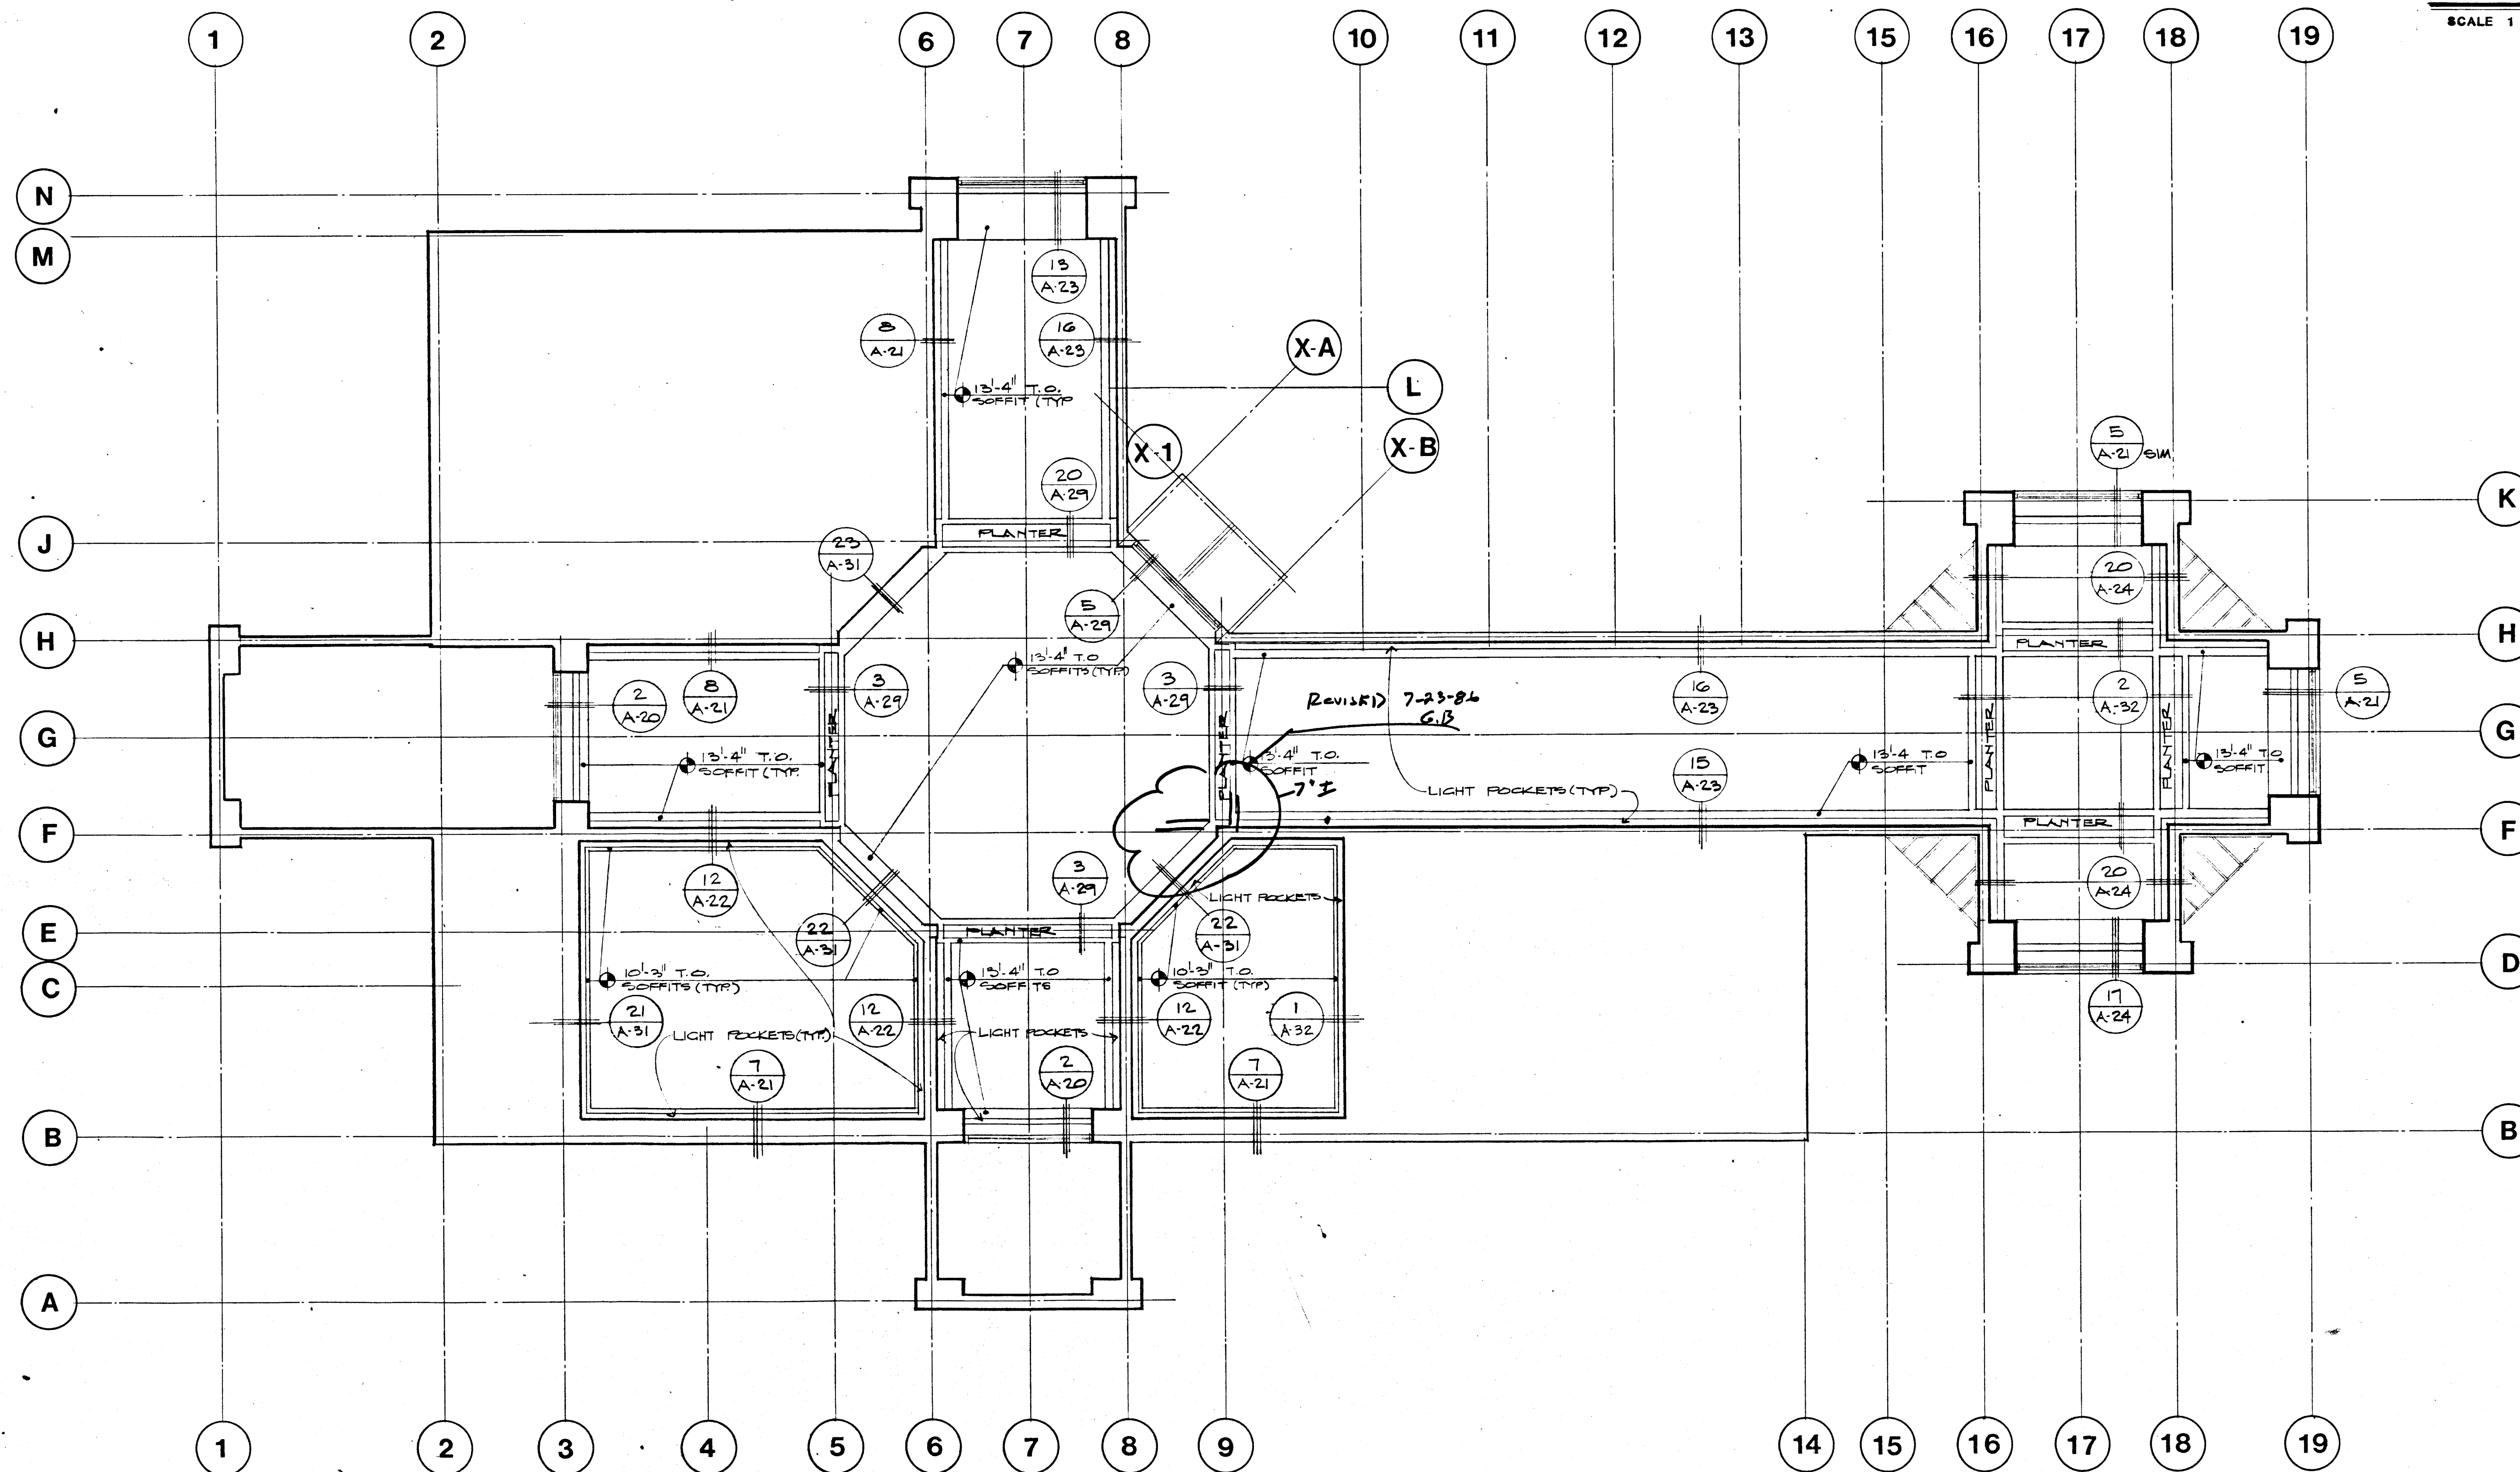

UPPER SOFFIT PLAN

SCALE 1/8" = 1'-0"