



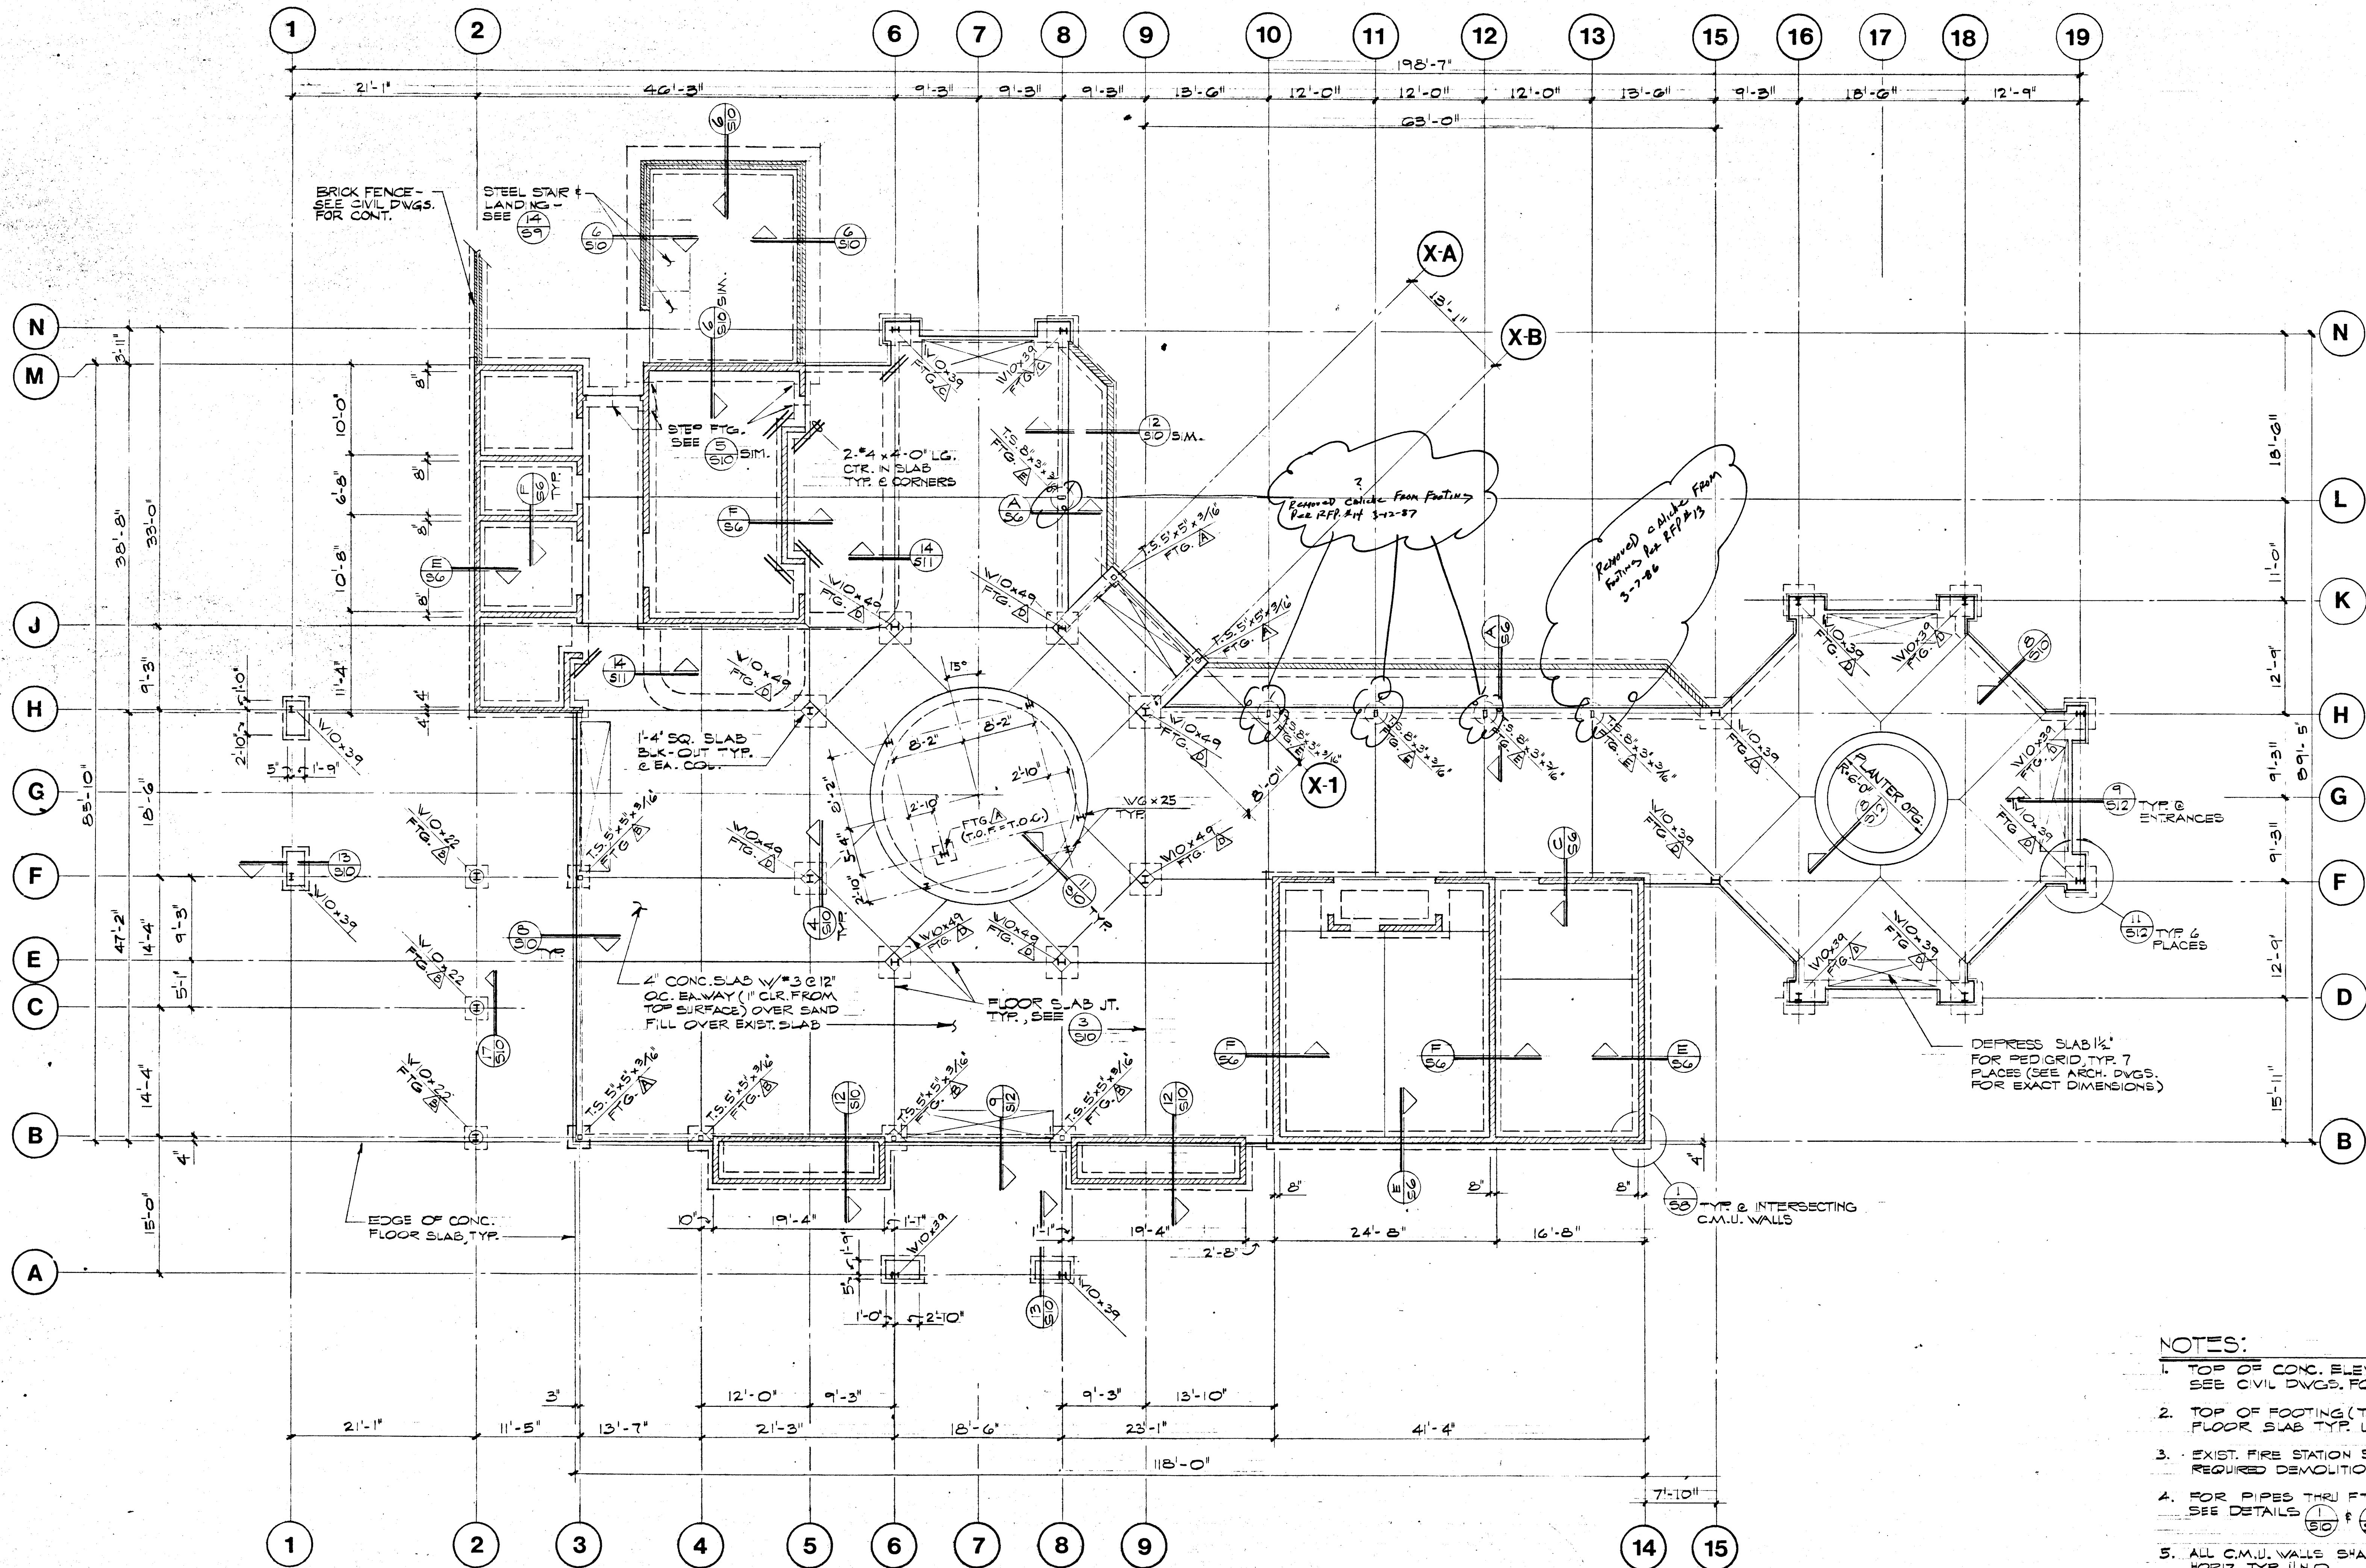

FOUNDATION PLAN

1/8" = 1'-0"

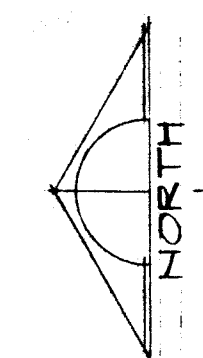

NOTES:

1. TOP OF CONC. ELEV. FOR CONC. FLOOR SLAB = 0'-0" (ASSUMED). SEE CIVIL DWGS. FOR ACTUAL ELEVATION.
2. TOP OF FOOTING (T.O.F.) ELEVATIONS ARE 1'-4" BELOW FLOOR SLAB TYP. U.N.O.
3. EXIST. FIRE STATION SLAB NOT SHOWN ON THIS PLAN. FOR REQUIRED DEMOLITION OF EXIST. SLAB, SEE SHEET S2.1
4. FOR PIPES THRU FTGS. OR TRENCHES ADJACENT TO FTGS. SEE DETAILS (1) & (2) (SEE MECH. & PLUMBING DWGS. FOR LOCATIONS WHERE OCCUR)
5. ALL C.M.U. WALLS SHALL HAVE #5 @ 32" OC. VERT. & 2'-#4 @ 48" OC. HORIZ. TYP. U.N.O. OPQS. IN C.M.U. WALLS SHALL HAVE REINF. PER DET. (2) TYP. U.N.O.

FOOTING SCHEDULE

NO.	SIZE	REIN.	REMARKS
1	2'-0" SQ. x 12" THK.	3-#4 E.N. BOTT.	
2	2'-6" SQ. x 12" THK.		
3	3'-0" SQ. x 12" THK.		
4	3'-6" SQ. x 12" THK.	3-#4 E.N. BOTT.	
5	3'-0" x 4'-0" DEEP	SEE SECTION (A) (50)	