
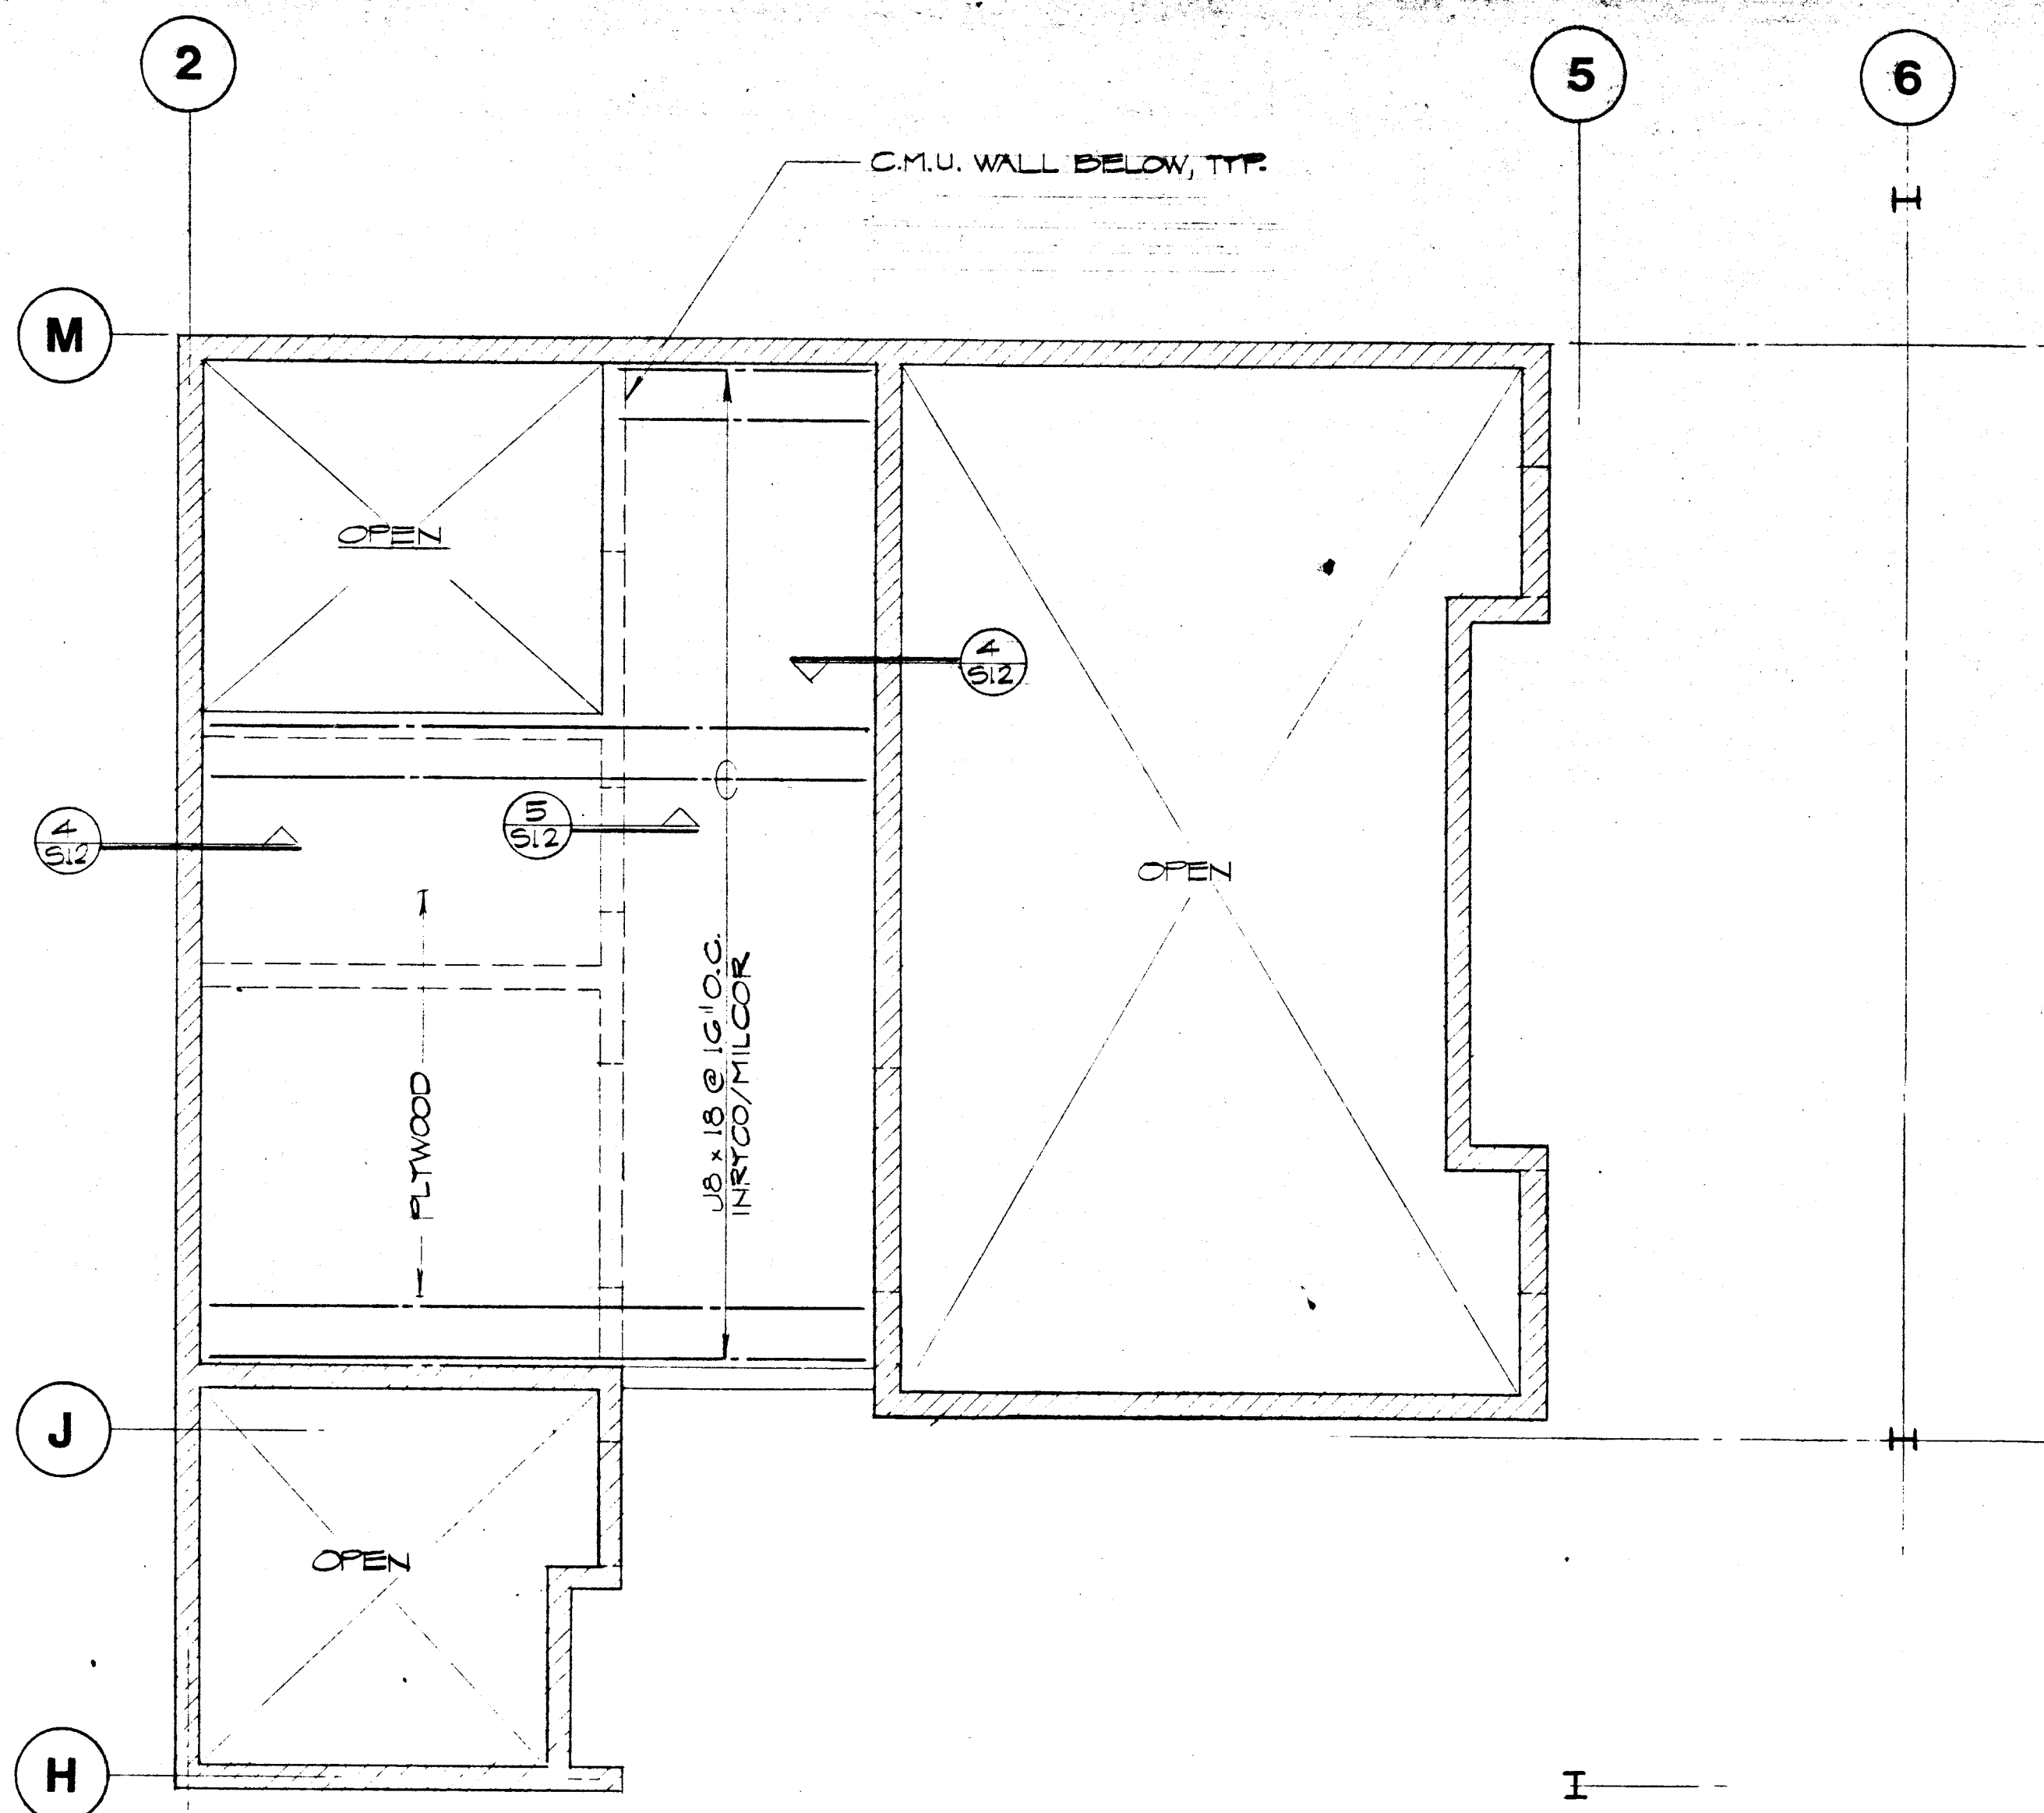


DETAIL

1/2" = 1'-0"

BLOG.

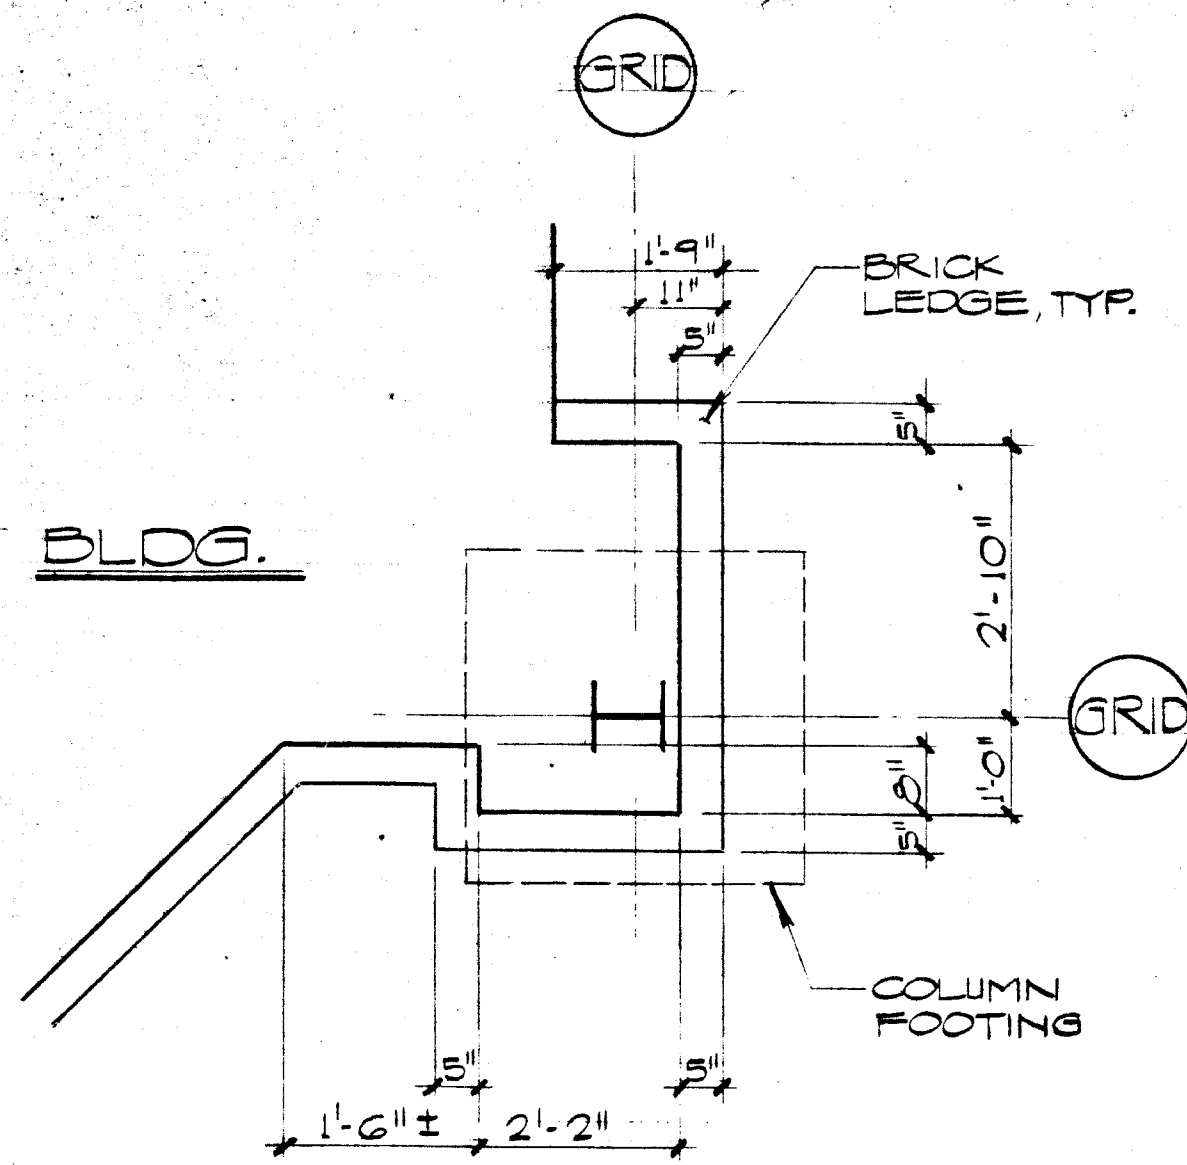


NOTE:
1. FLYWOOD - 3/4" COX T & G. STRUCT. II
PERPENDICULAR TO JOIST WITH
DUGLE HEAD SCREWS @ 12" O.C.
FOR ATTACHMENT TO JOIST.

2. SEE DETAIL (2) FOR TYP. OPENING.

CEILING FRAMING PLAN

1/4" = 1'-0"

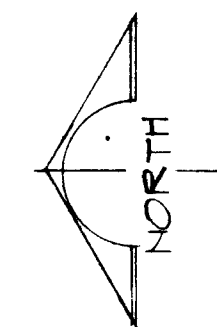



CEILING FRAMING

1/4" = 1'-0"

NOTE:

1. FLYWOOD - 3/4" COX T & G. STRUCT. II PERPENDICULAR TO JOIST WITH DUGLE HEAD SCREWS @ 12" O.C. FOR ATTACHMENT TO JOIST.
2. SEE DETAIL (2) FOR TYP. OPENING.


LIVE LOAD = 50 PSF

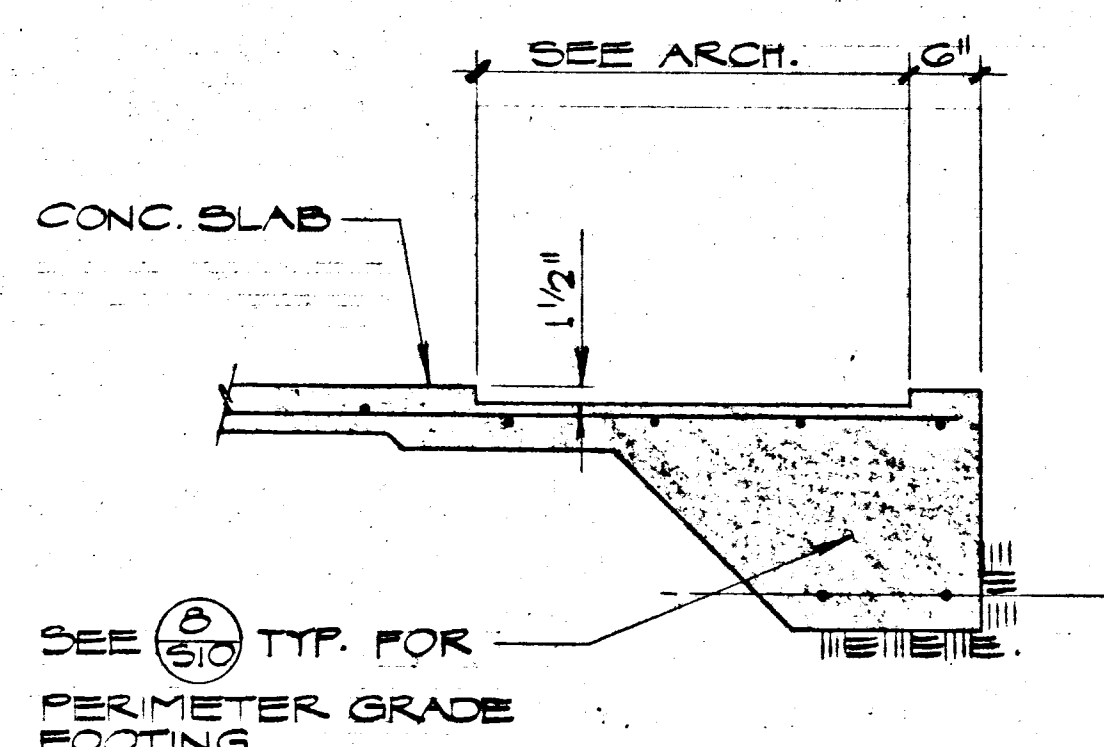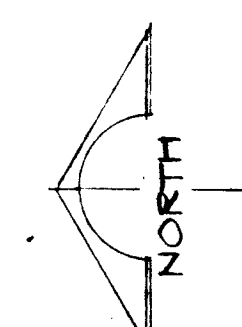

DETAIL

3/4" = 1'-0"


(1)

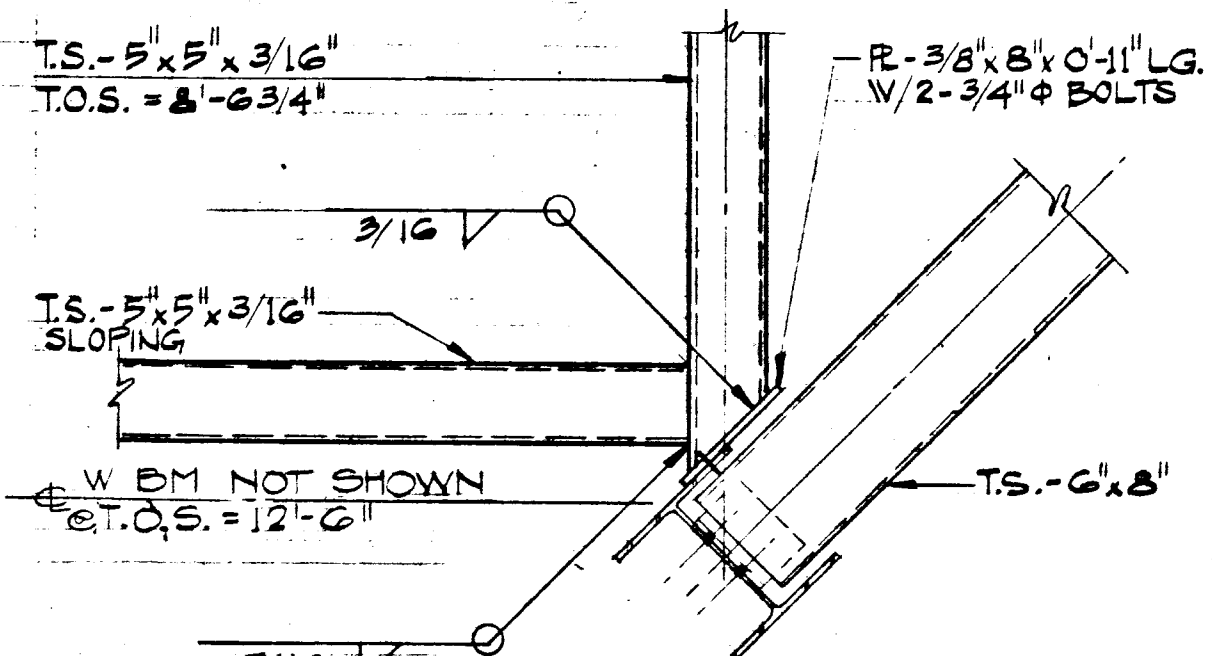

DETAIL

1" = 1'-0"


(7)

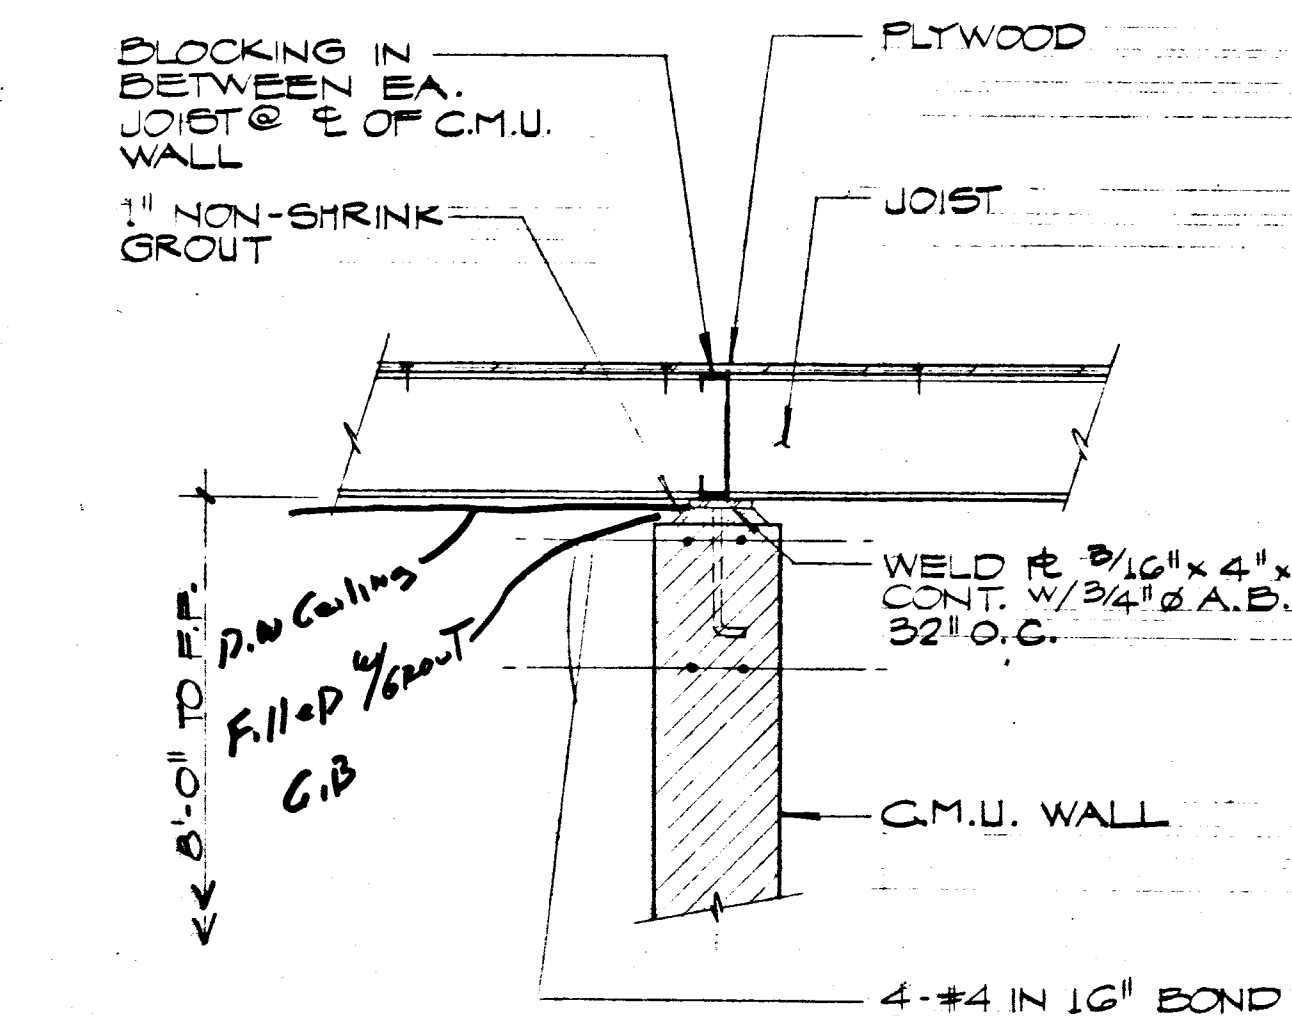

DETAIL

1" = 1'-0"


(5)

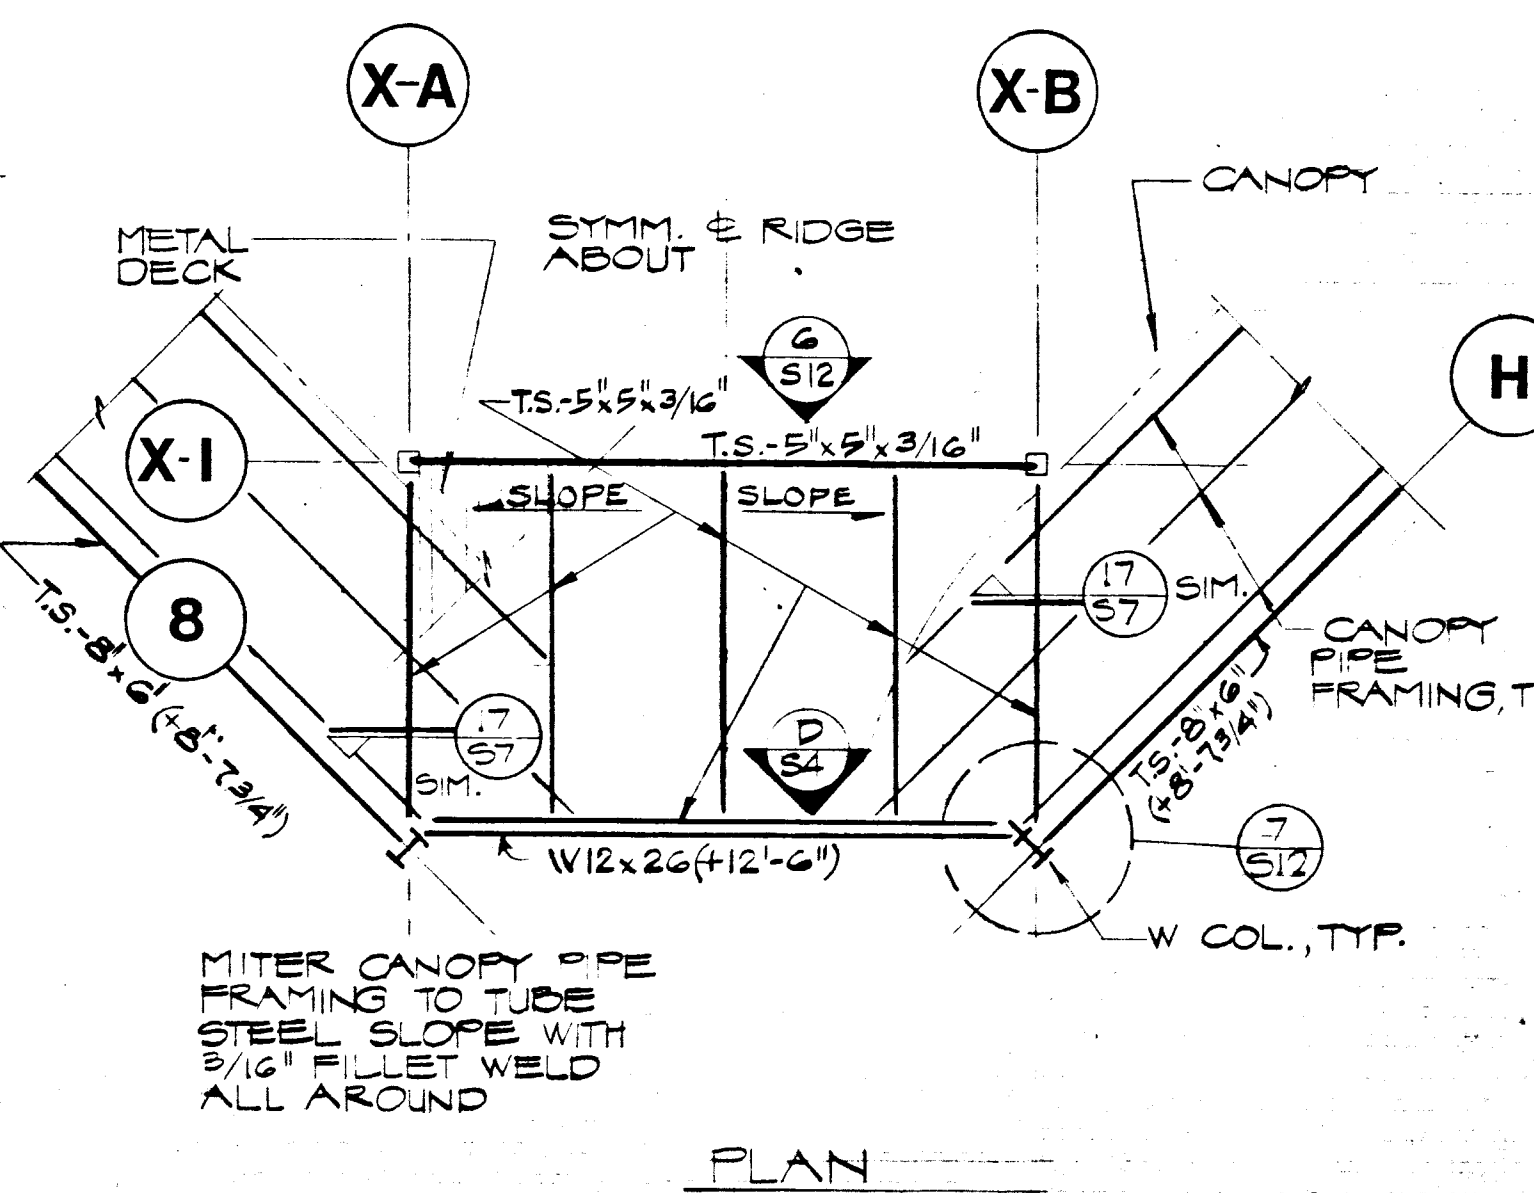

DETAIL

1/4" = 1'-0"


(3)

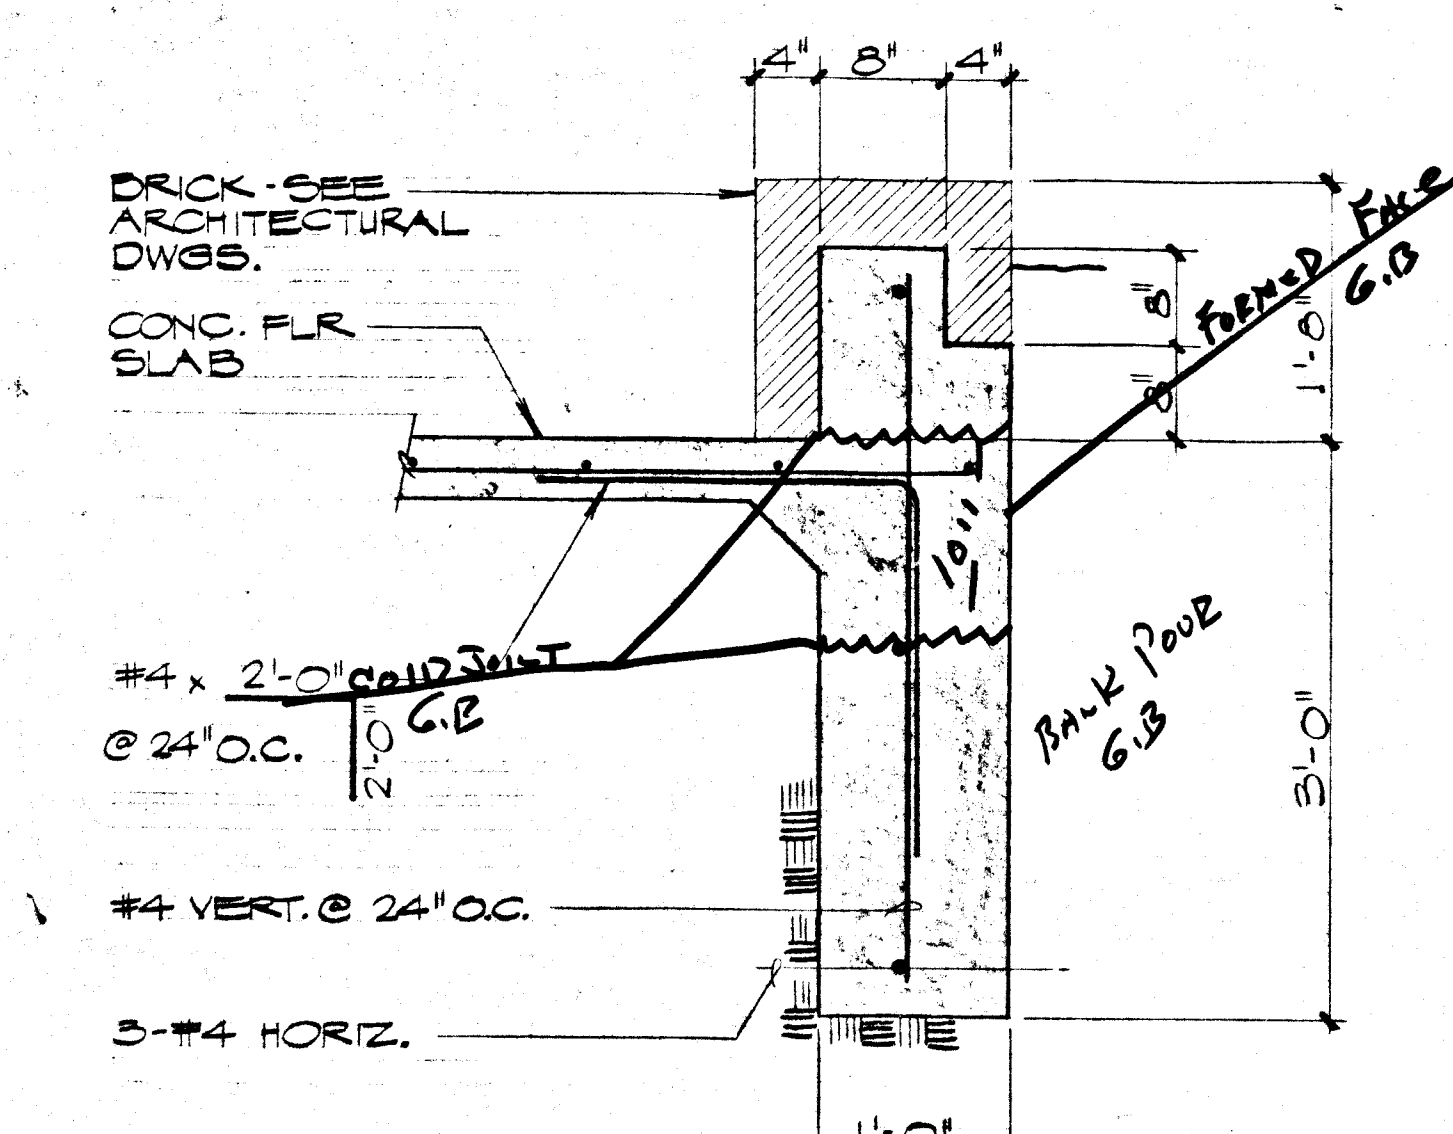

DETAIL

1" = 1'-0"


(8)

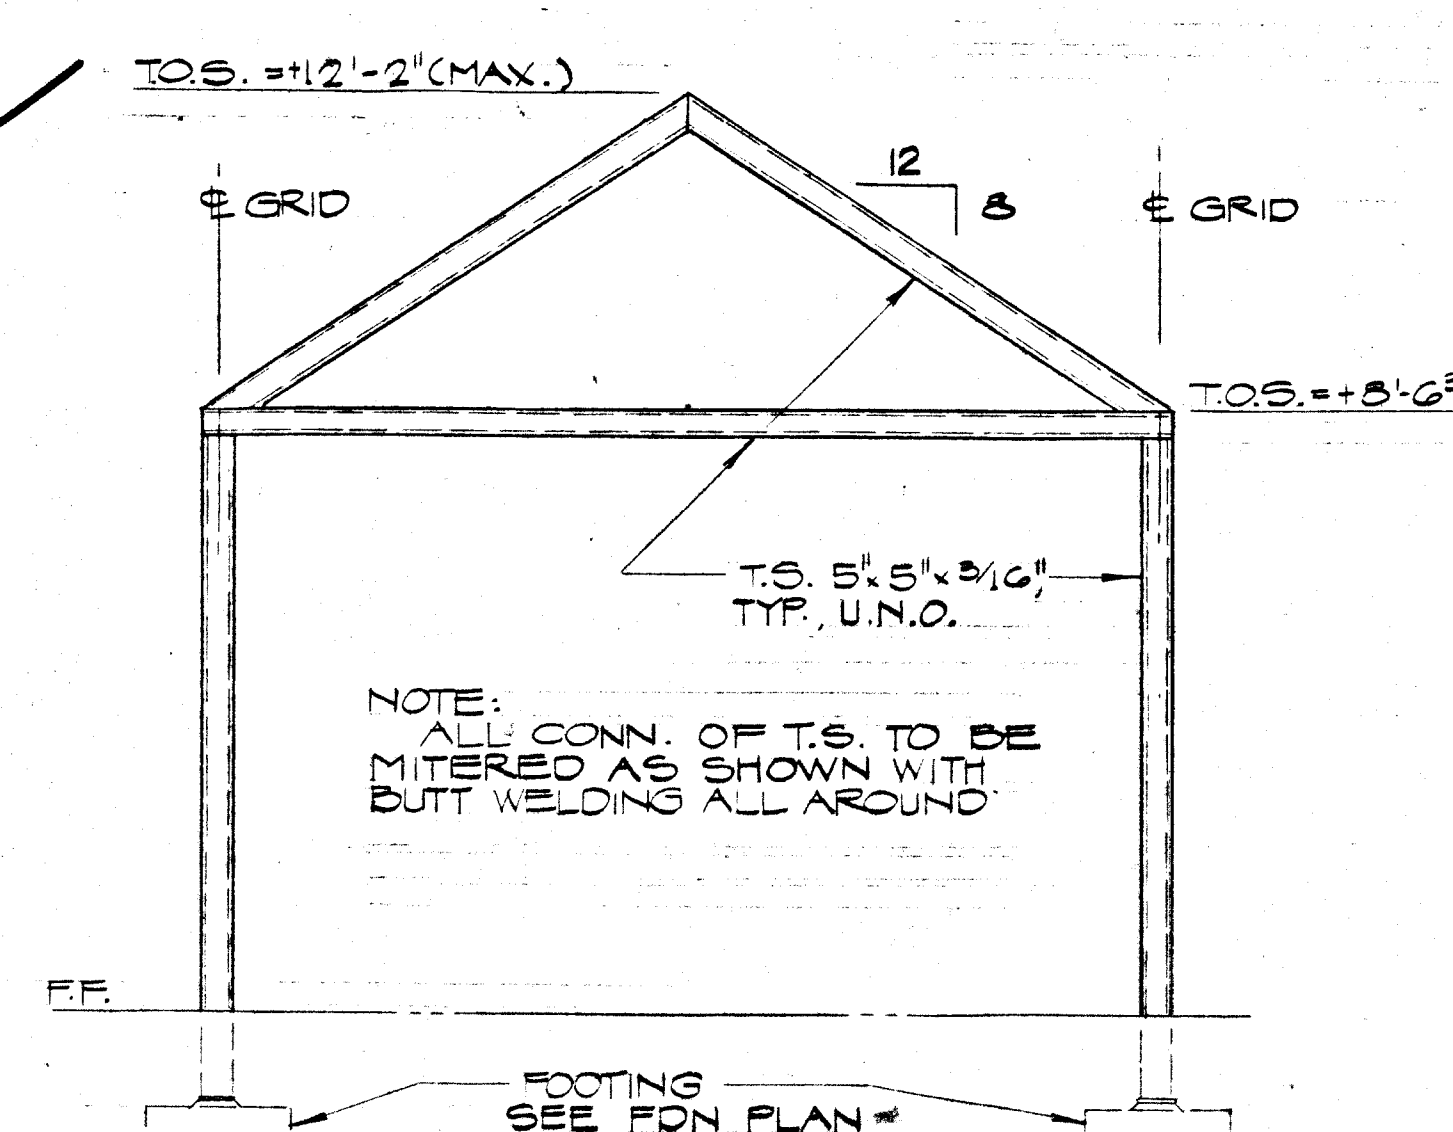

DETAIL

3/8" = 1'-0"

(6)

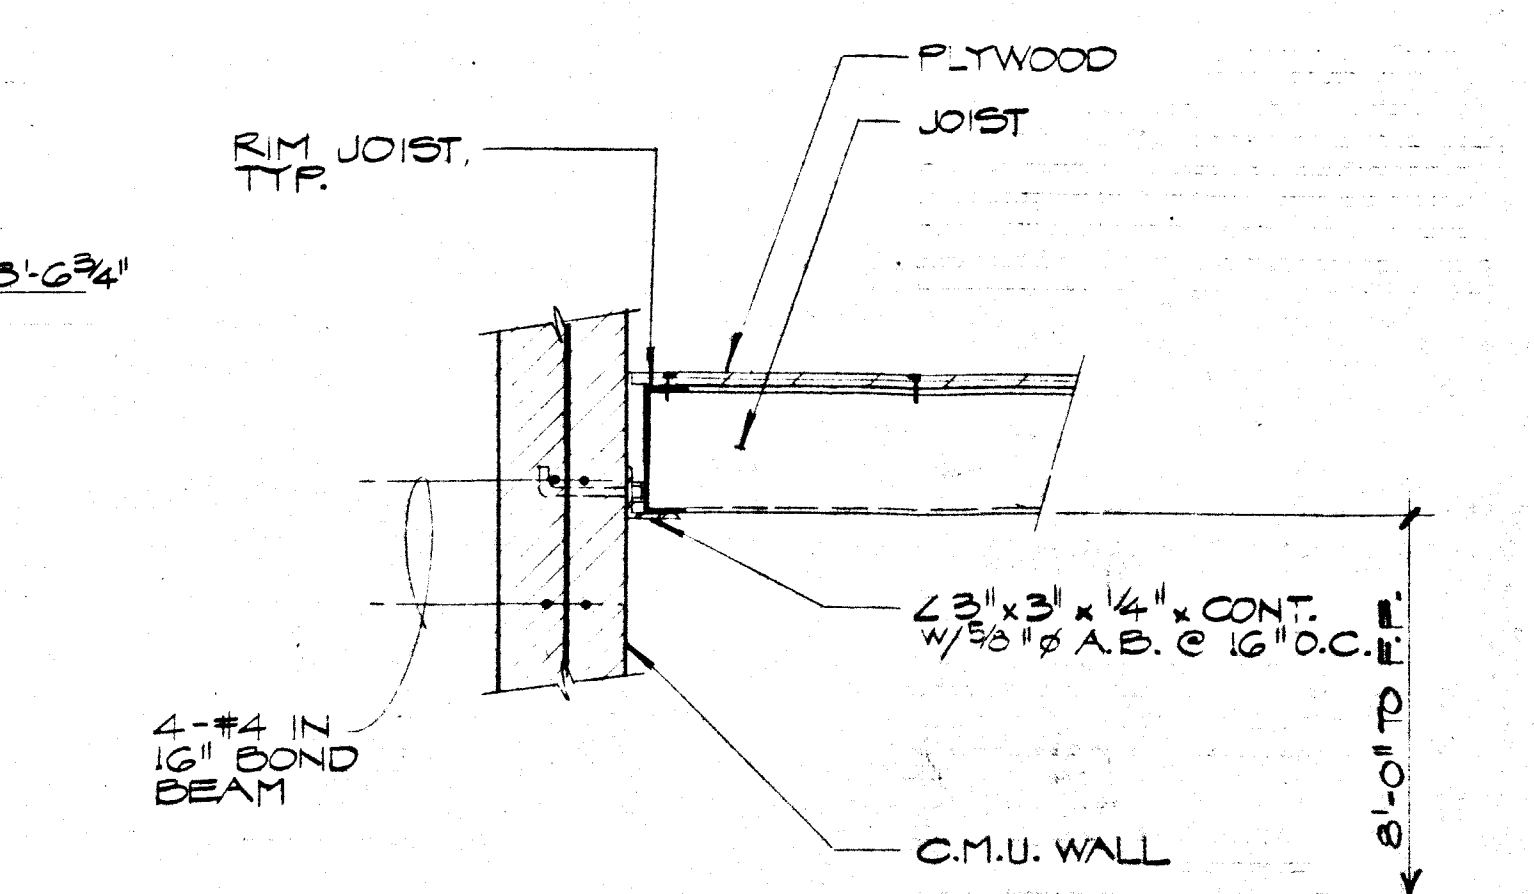

DETAIL

1" = 1'-0"

(4)

GUNNY, BRIZENDINE & POGEMEYER
ENGINEERS
1004 EAST SARARA AVENUE • LAS VEGAS • NEVADA 89102
1005 W. WILLOW AVENUE • LAS VEGAS • NEVADA 89102
(702) 877-1000
(702) 877-1001

DOBROSKY KITTRELL GARLOCK
Architects
1005 W. WILLOW AVENUE • LAS VEGAS • NEVADA 89102
(702) 877-1000
(702) 877-1001

City of Las Vegas
Transportation
Center
Las Vegas, Nevada

S-12
3-4-91
3-8-91