

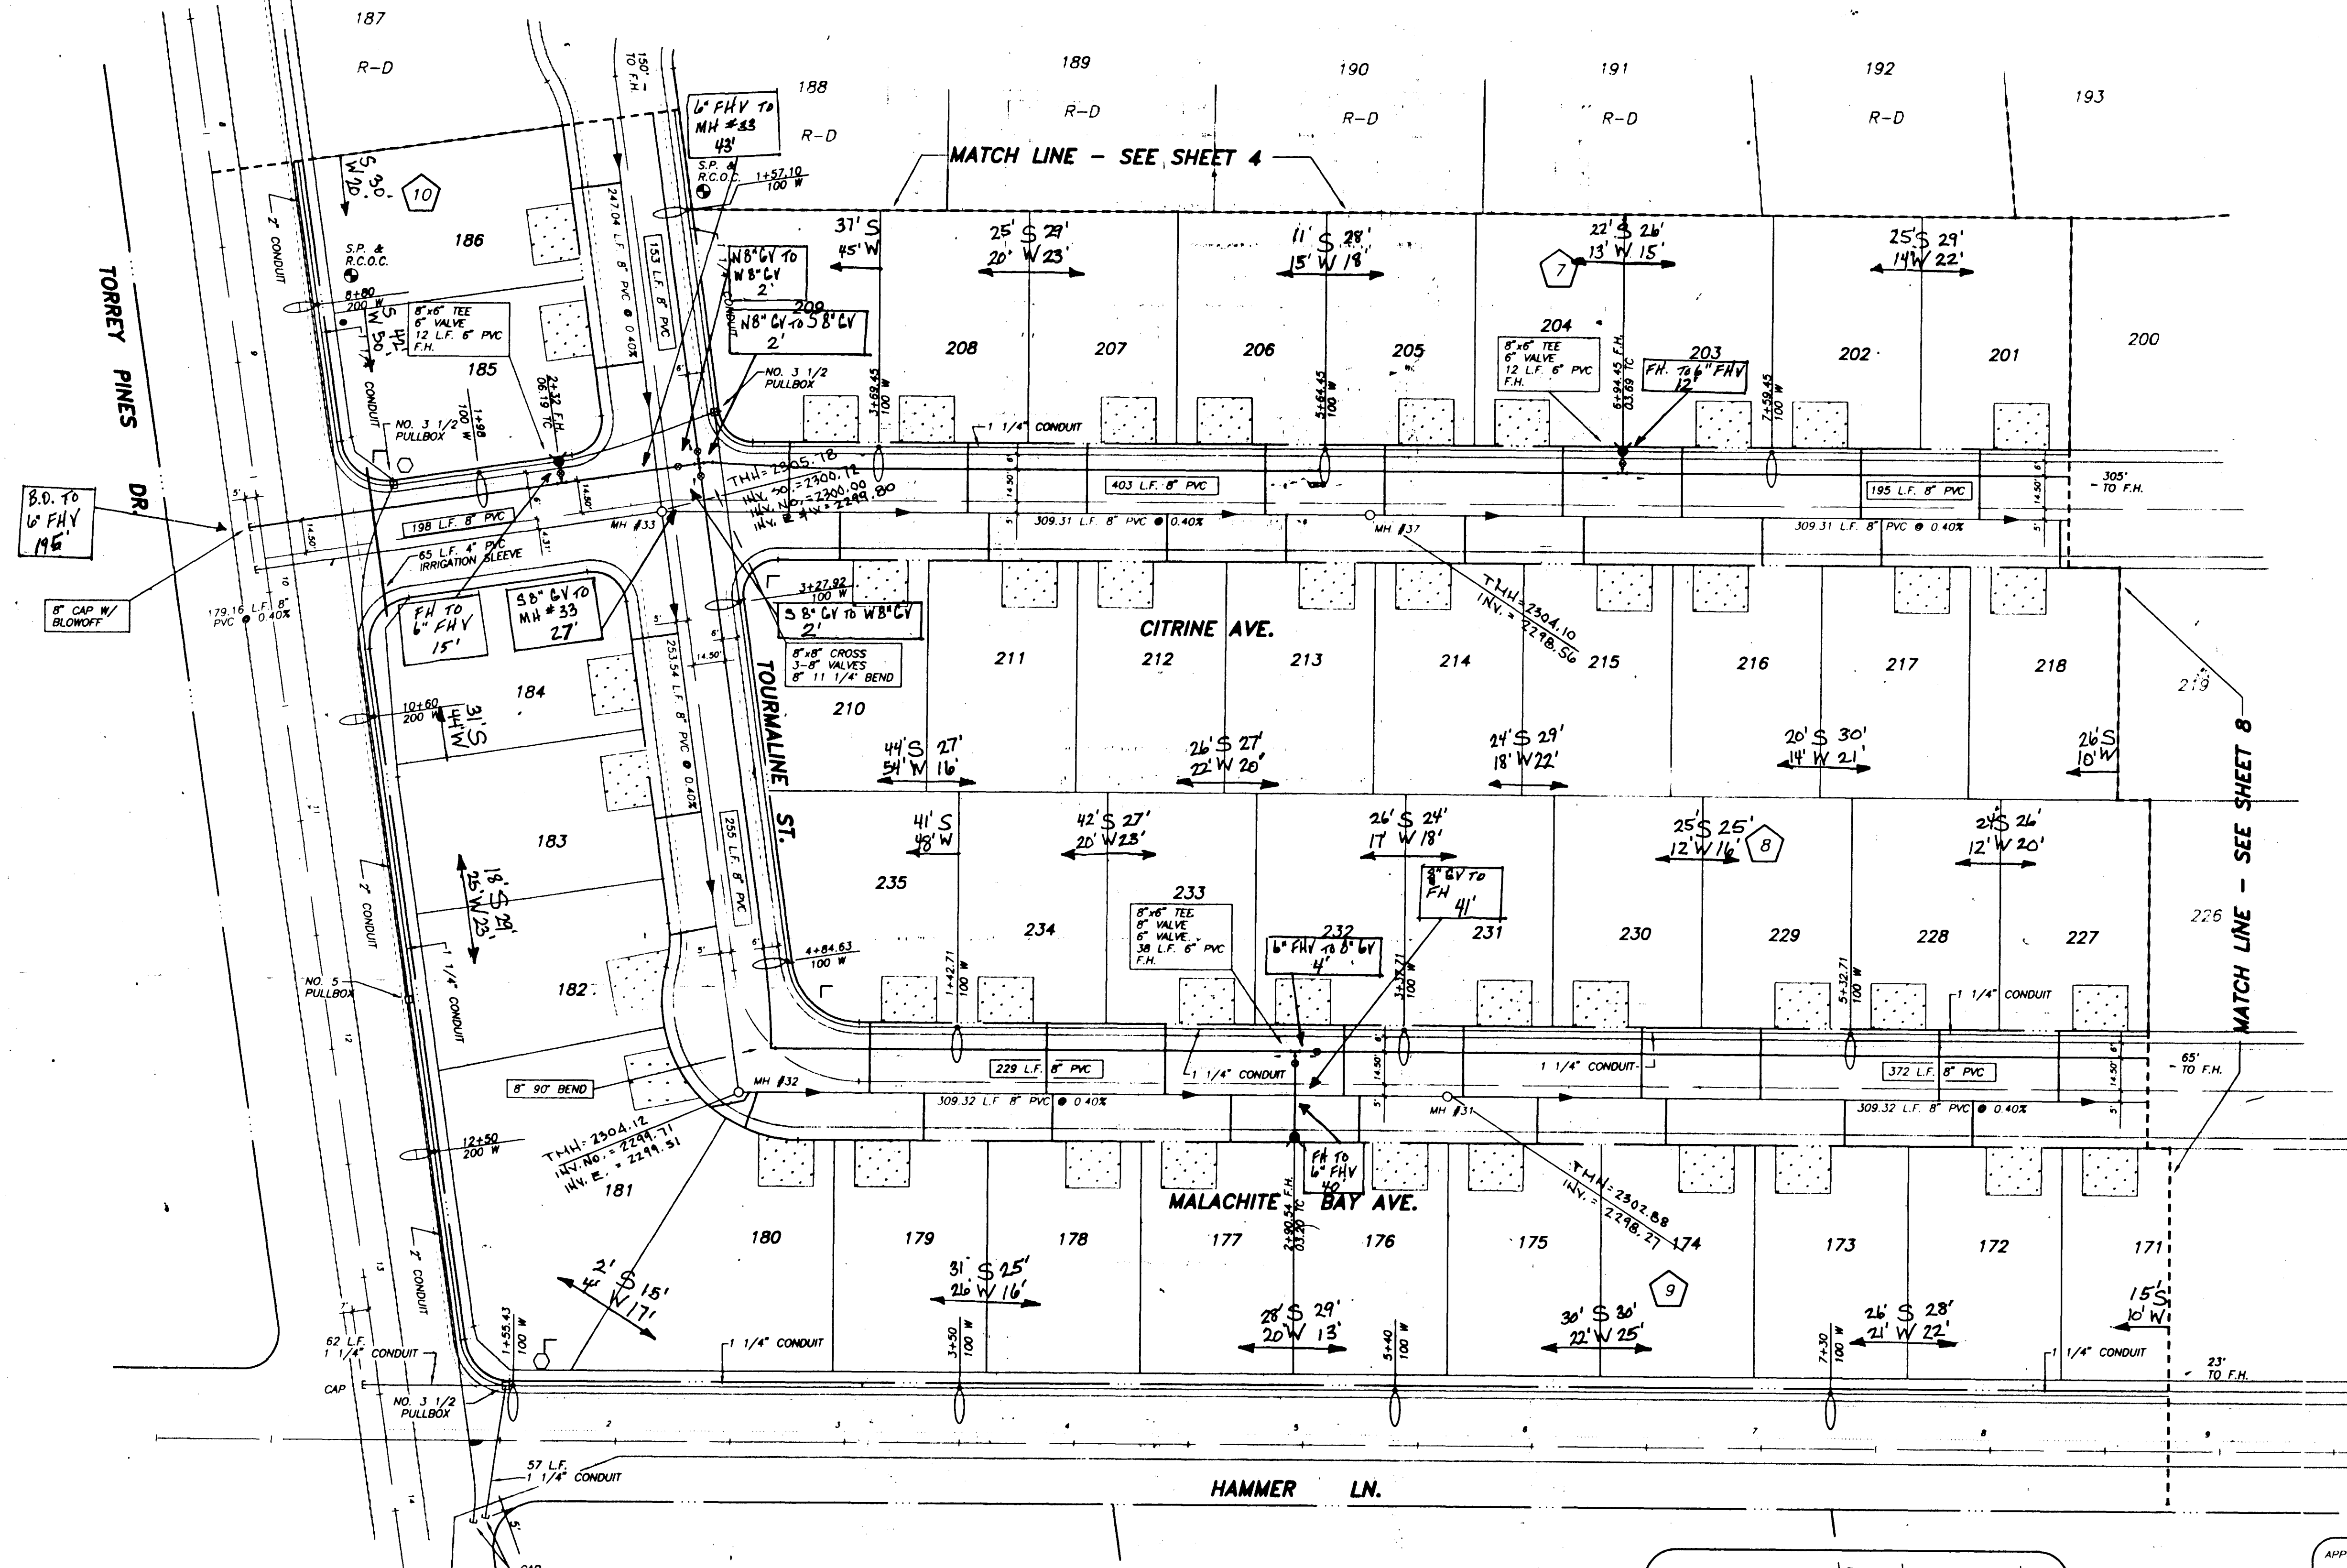
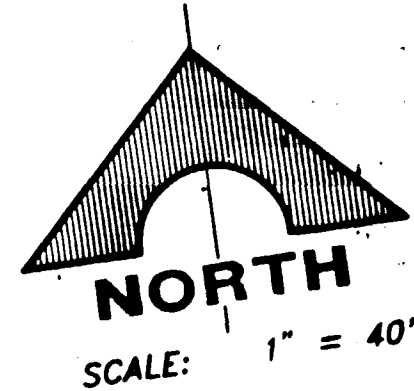


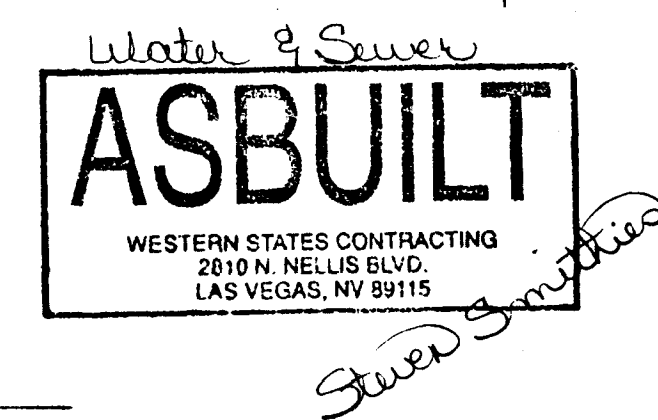


NOTE:
CONTRACTOR TO VERIFY THE HORIZONTAL
AND VERTICAL LOCATION OF EXISTING
UTILITIES PRIOR TO CONSTRUCTION.
ANY DISCREPANCY IN THE PLANS
SHALL BE IMMEDIATELY REPORTED TO
THE ENGINEER.

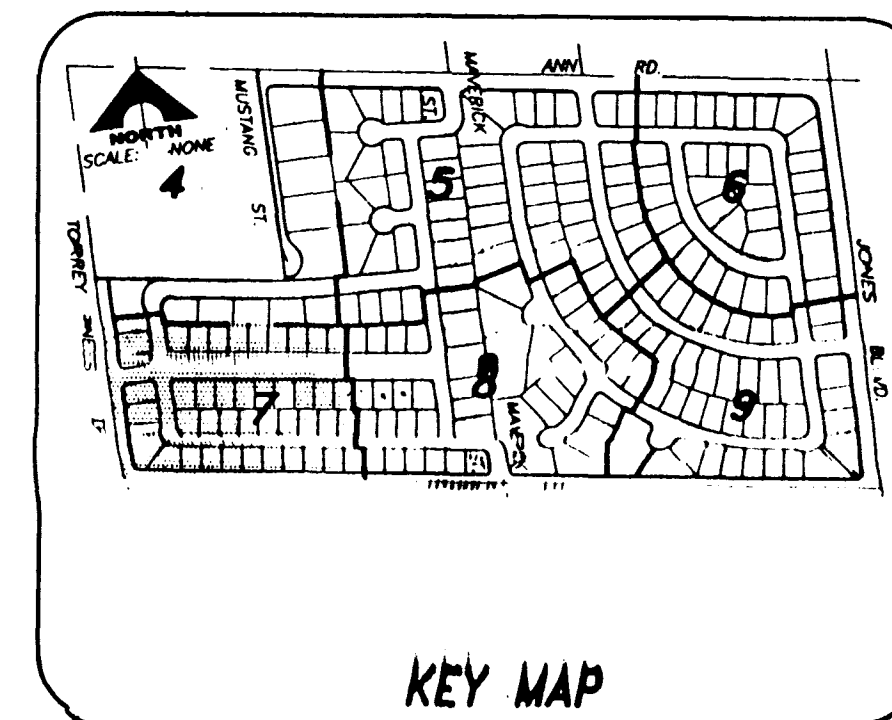

APPROVED FOR CONSTRUCTION	DATE
<i>J. Lopez</i>	5/1/94
APPROVED FOR CONSTRUCTION	DATE
<i>[Signature]</i>	5/1/94

ENGINEER	DATE	DESCRIPTION
SONNY W. NEIGH	5-5-94	NO. 10118
RECOMMENDED BY	DATE	DESCRIPTION
SONNY W. NEIGH	5-5-94	NO. 10118
G.C. WALSH & SONS, INC. Engineers/Architects 2810 N. Nellis Blvd., Las Vegas, NV 89115		
DEL WEBB OF NEVADA, INC. COPPER CREST UTILITY PLAN 'IV'		
SHEET 7 OF 40		

17543 NO. 770006 PLOTTED: 05/04/94 4:00 PM DRAWING: C:\COPPER\UTILITY\DC-7 BR CAP

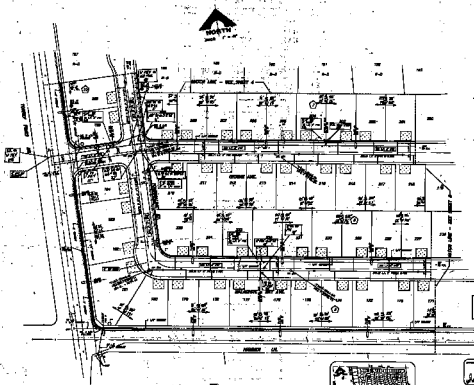

SIGNATURE OF CONTRACTOR

