


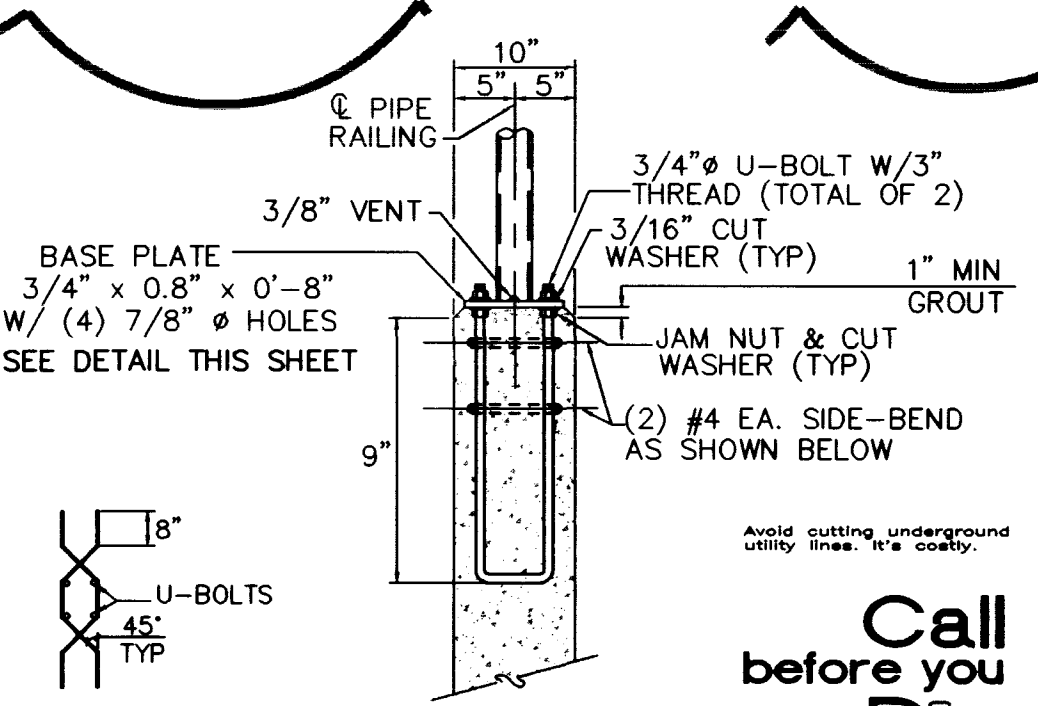
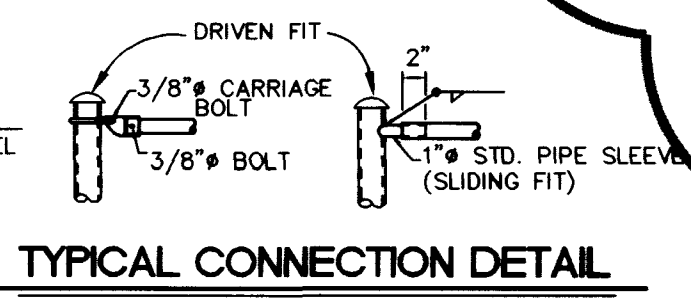
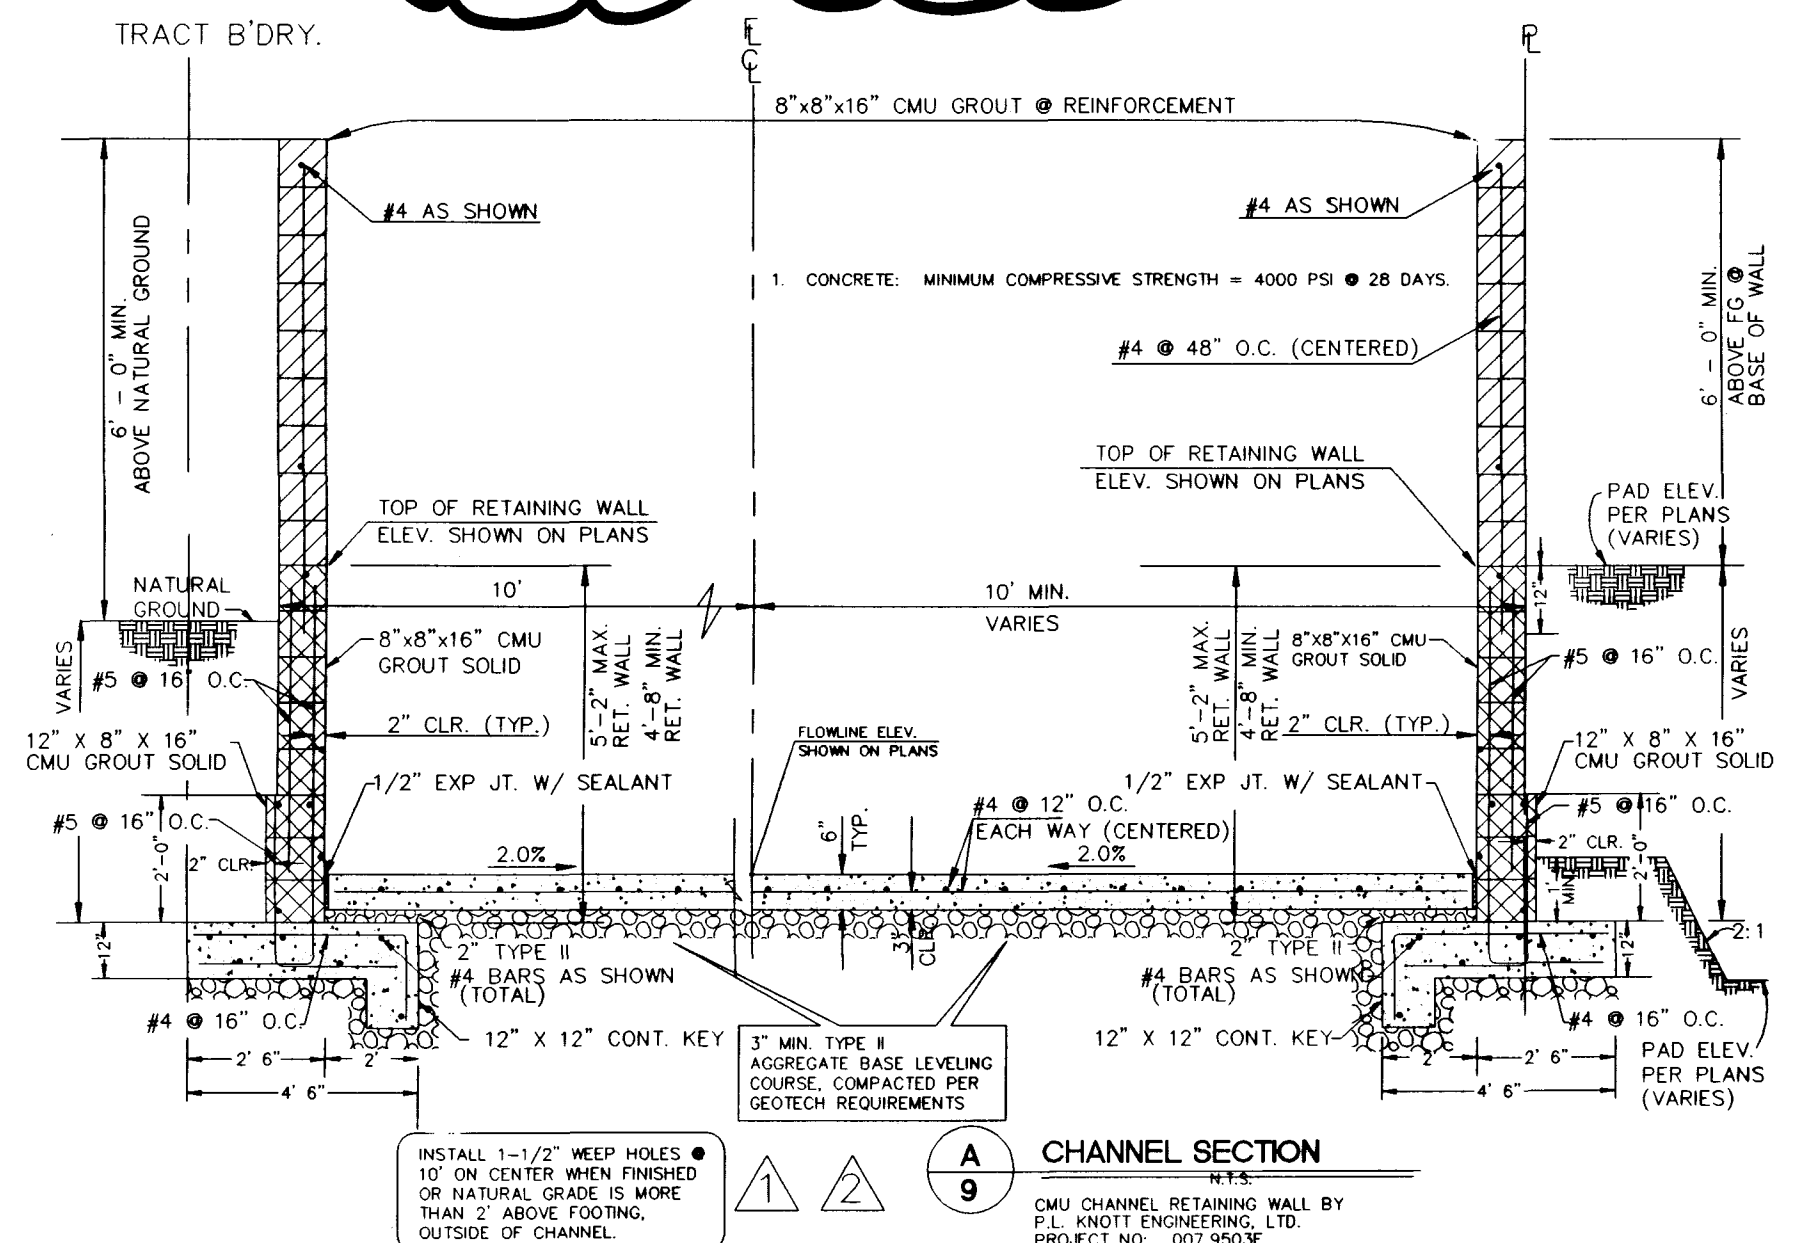
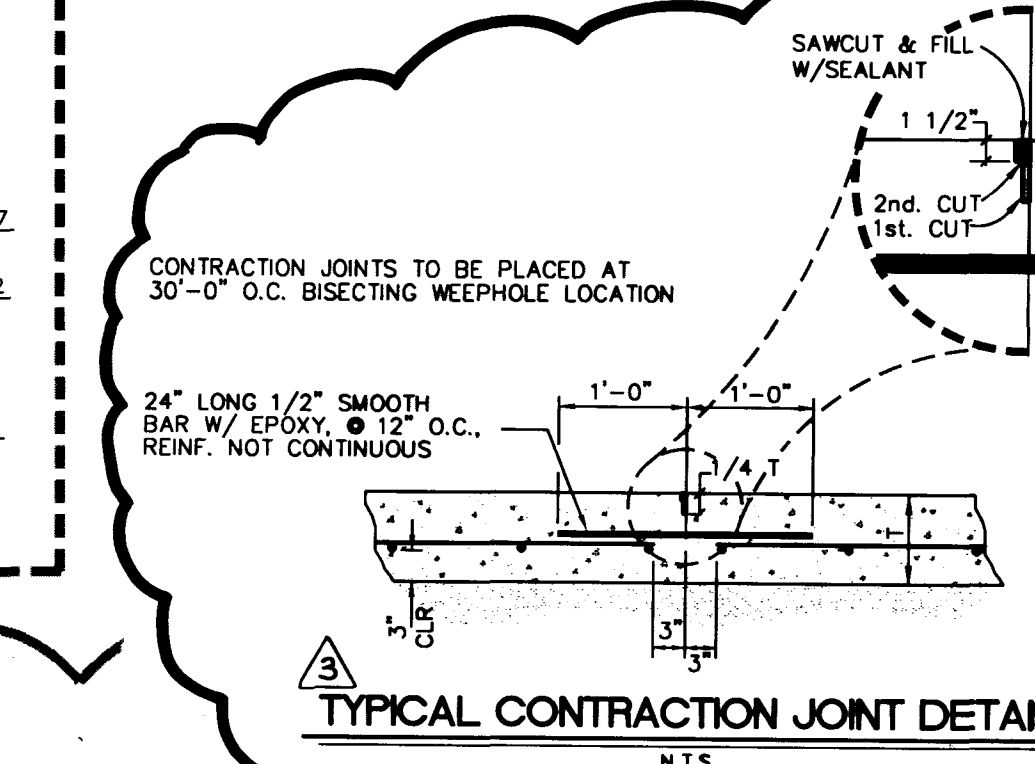
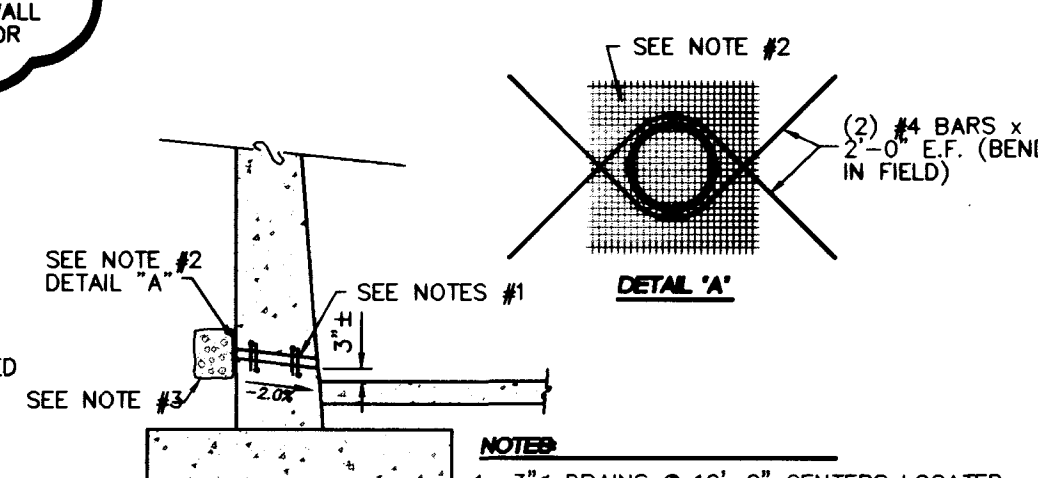
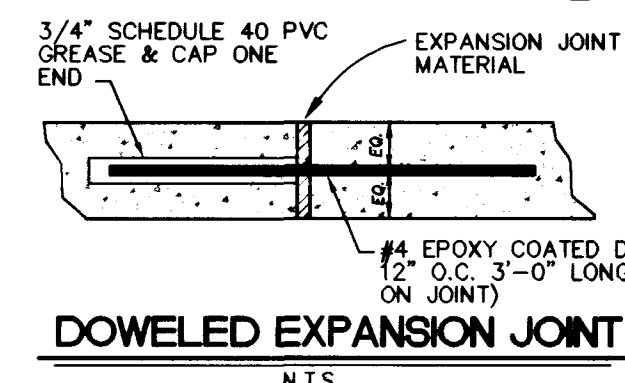
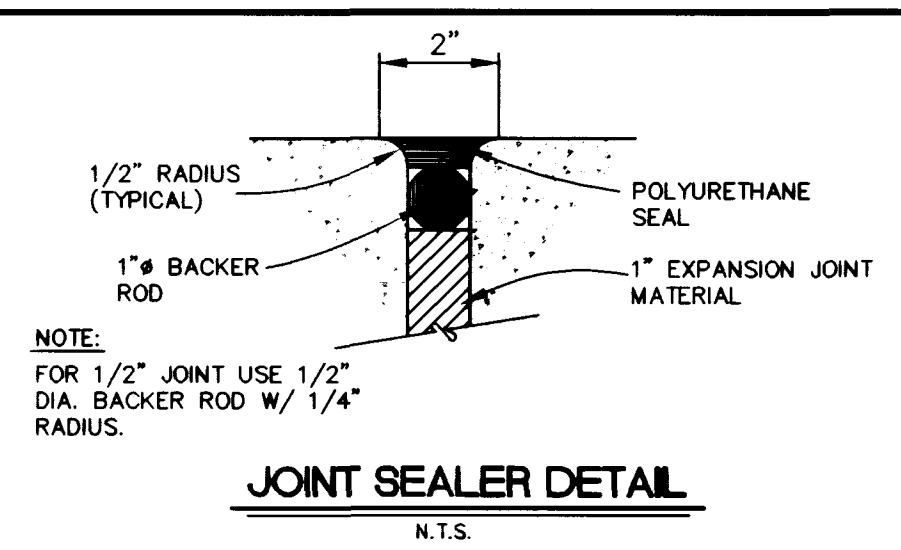
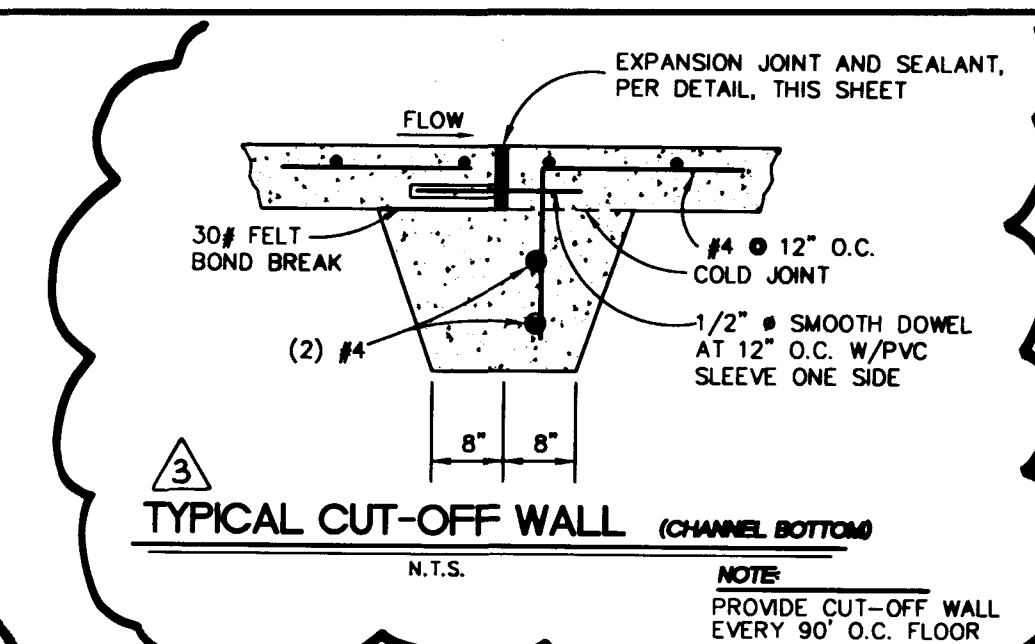
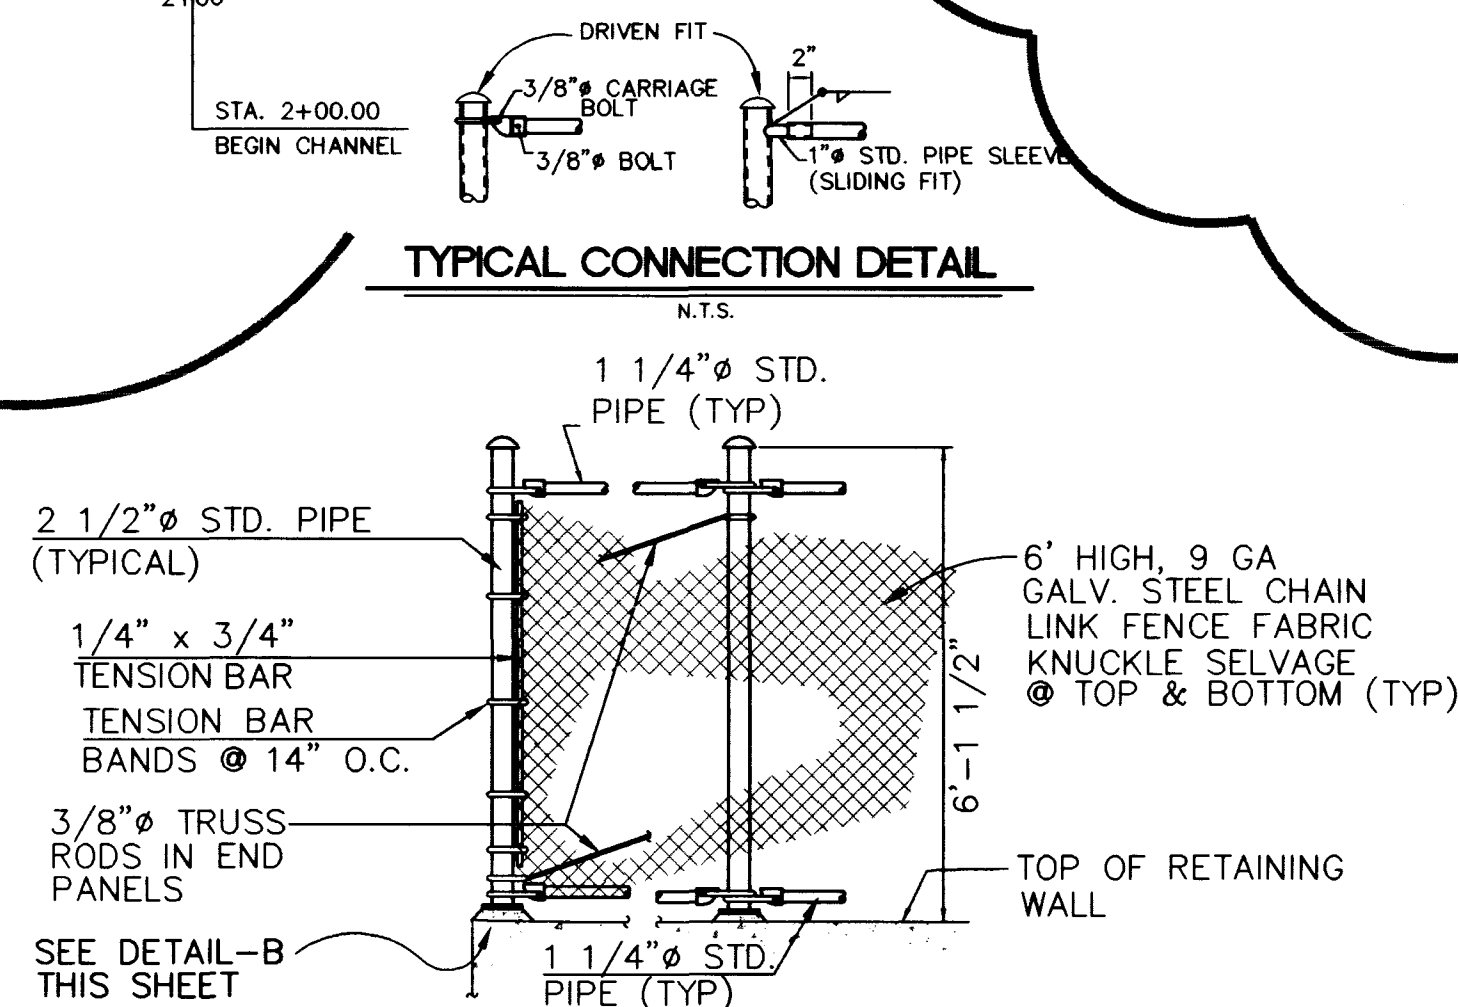
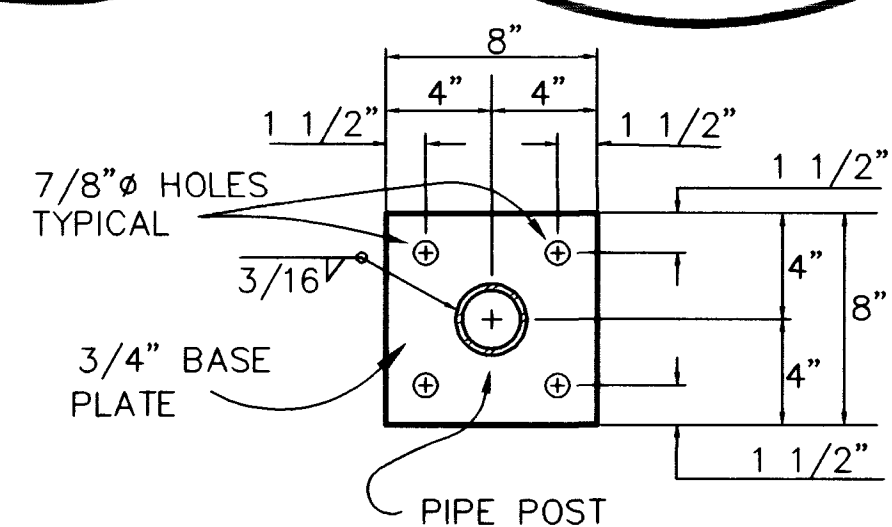
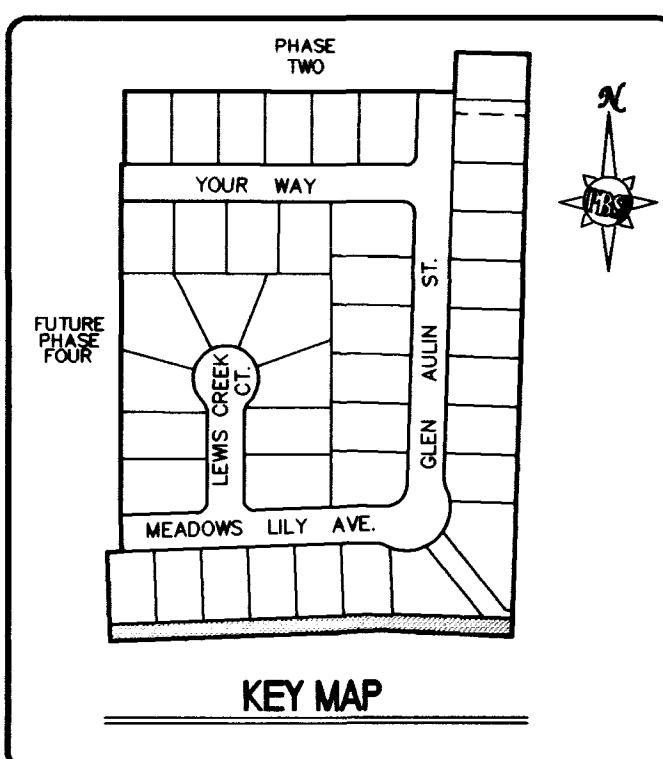
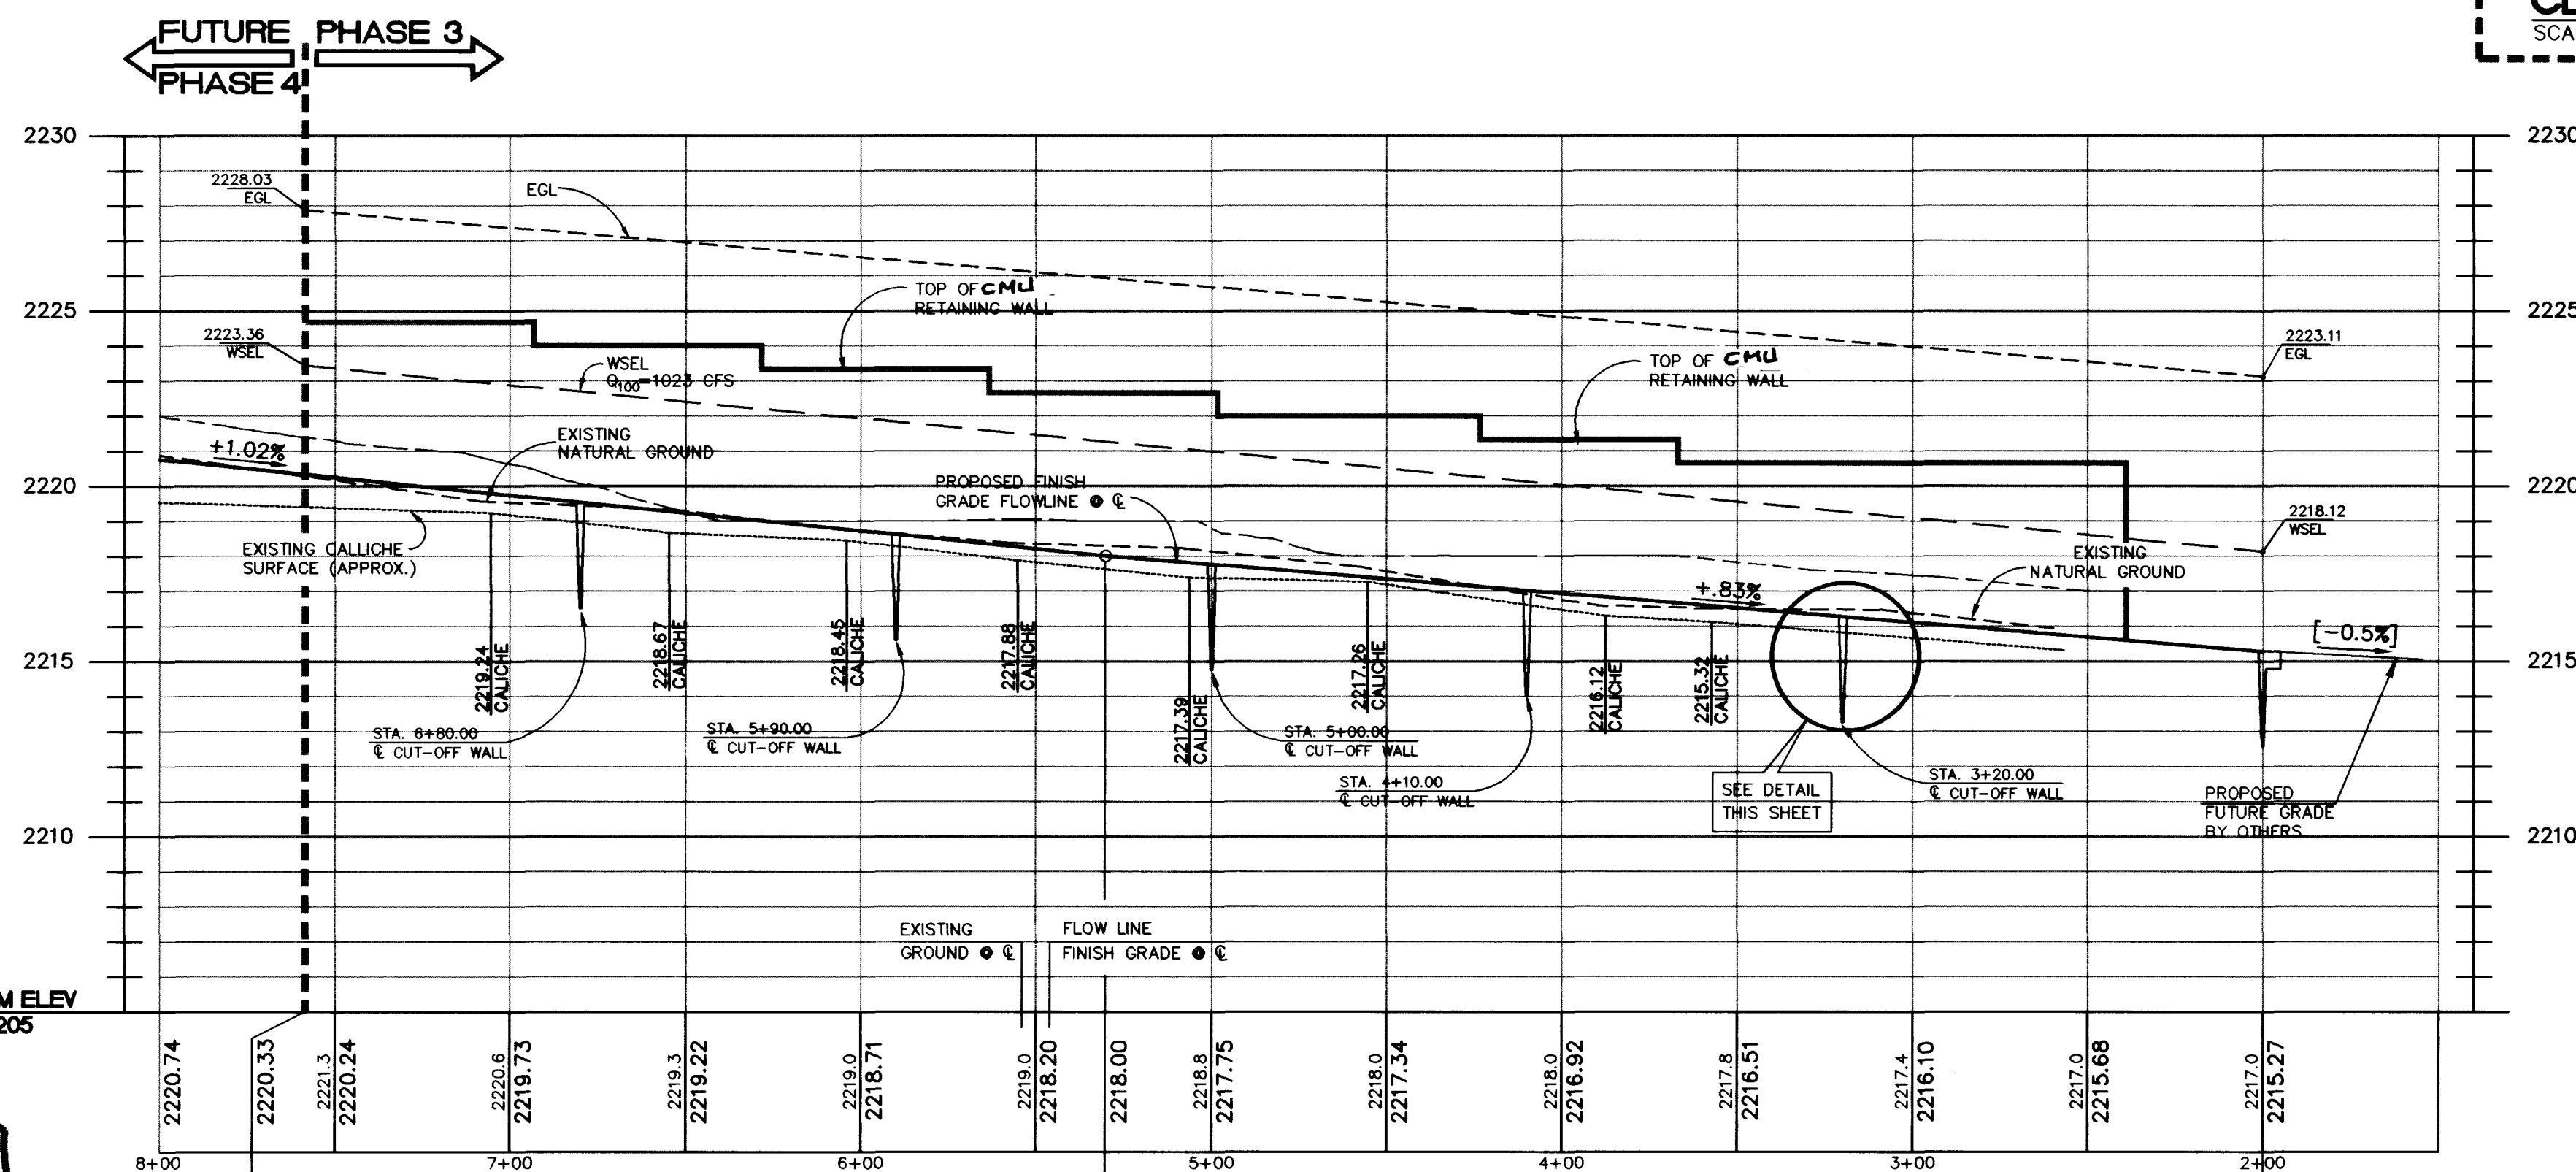
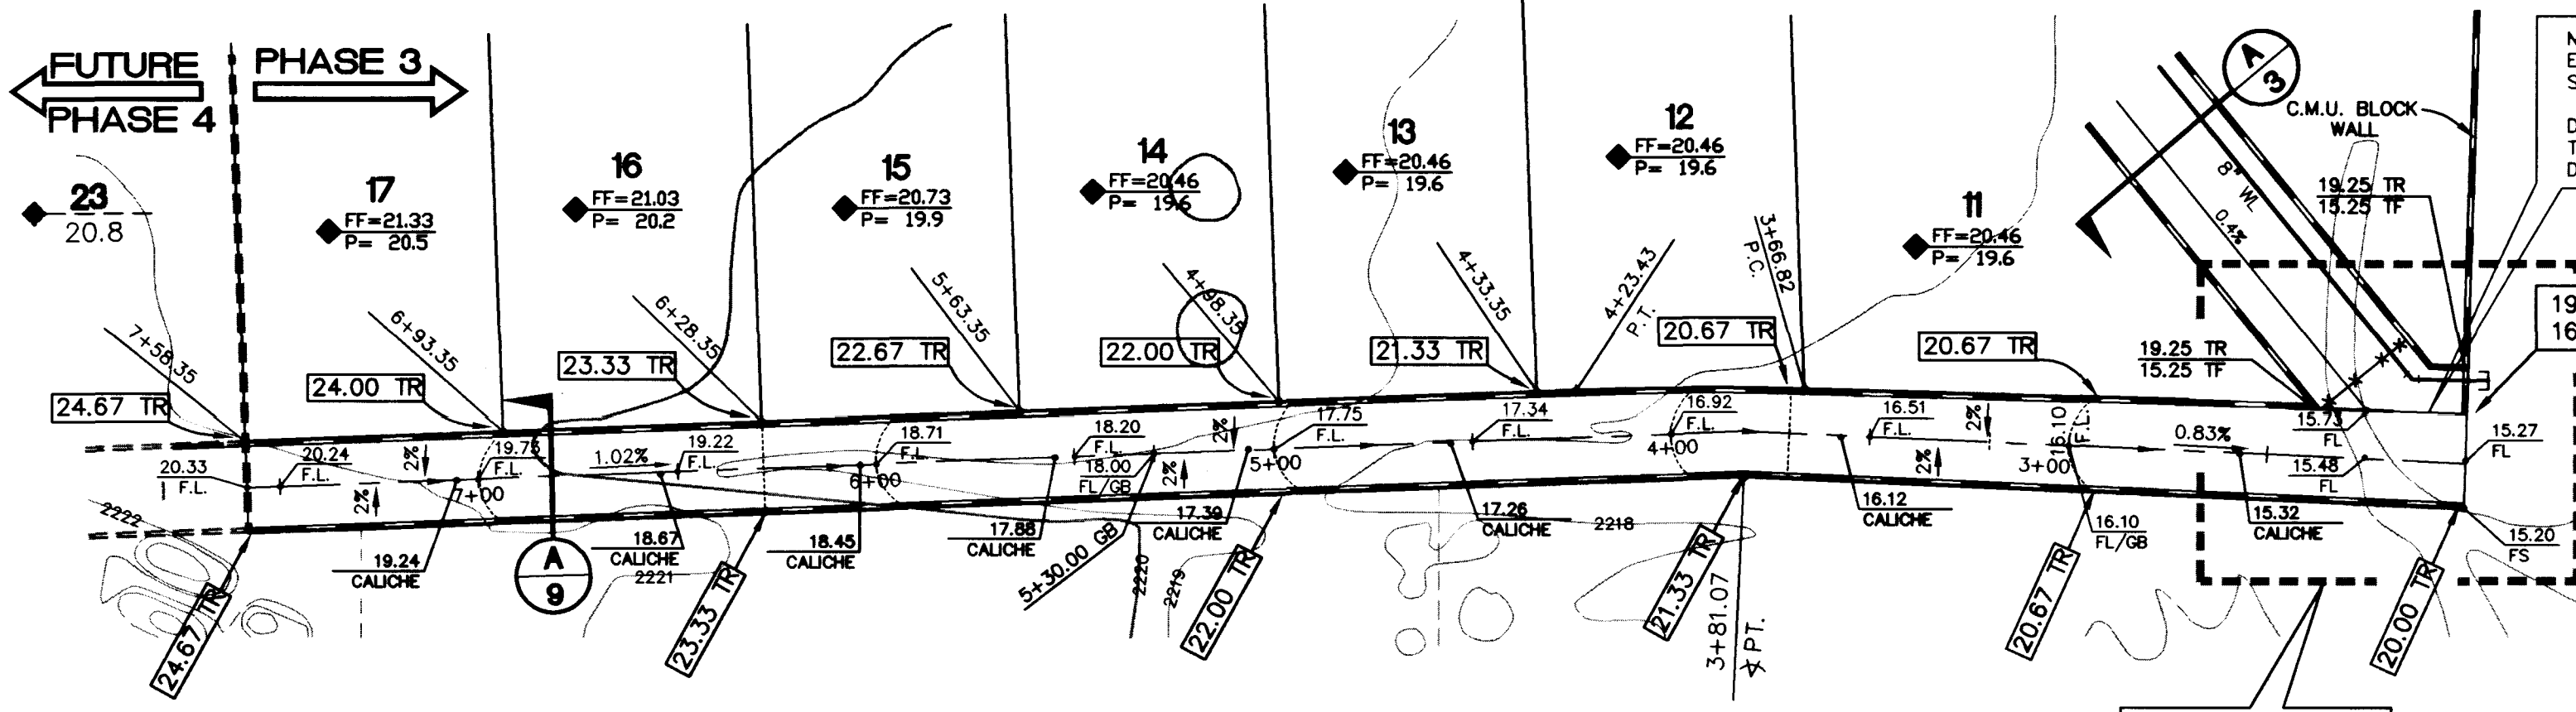


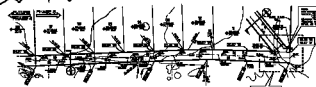


Joo Number 7089-653	Drawn by WLLY/ESM	Scale 1" = 40'	PHASE THREE PUBLIC DRAINAGE CHANNEL PLAN			901 N. Green Valley Parkway Suite 100 Nevada, 89004 SCHUH & Telephone: 702/353-7275 JERNIGAN Fax: 702/763-7500	POST, BUCKLEY, SCHUH & JERNIGAN	REVISIED DETAILS	width 8 MM	11/25/99	Date
Sheet Number 9 OF 9	Checked by MP	Date	File No. 653IMP								
Date				REVISIONS							
Date				REVISIONS							
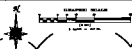

FIELD DRAINAGE CHANNEL - PLAN VIEW

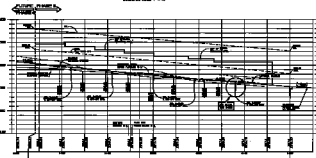

FIELD DRAINAGE CHANNEL - PROFILE

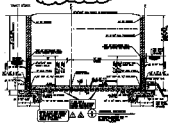

TYPICAL BASE PLATE DETAIL



CHAIN LINK FENCE AND RAILING DETAIL



NO. 1	NO. 2	
-------	-------	-------	-------	-------	-------	-------	-------	-------	--------	--------	---------

STANDARD SCALE 1 INCH = 10 FEET