
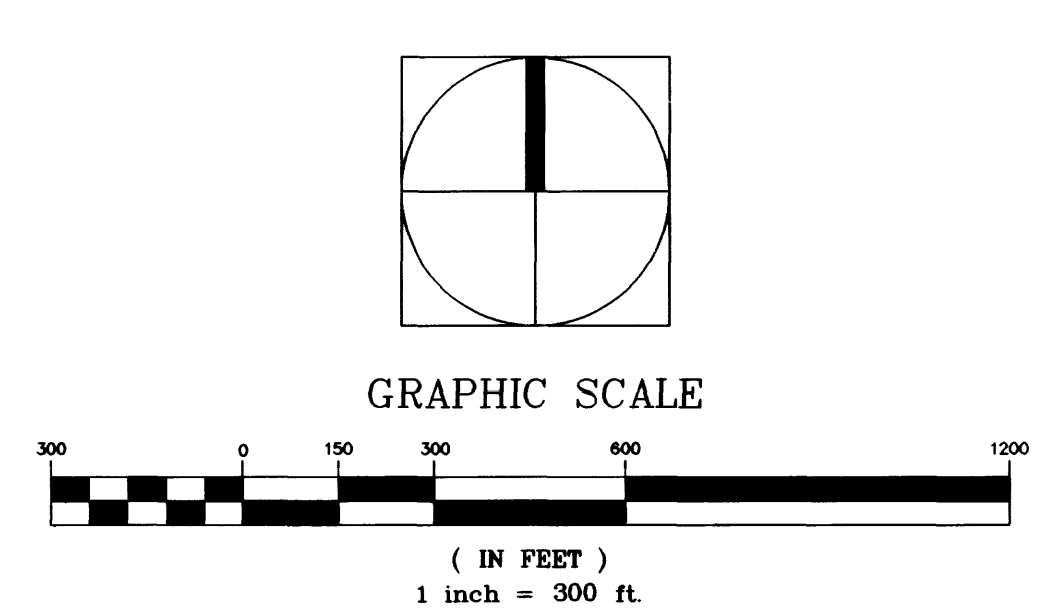


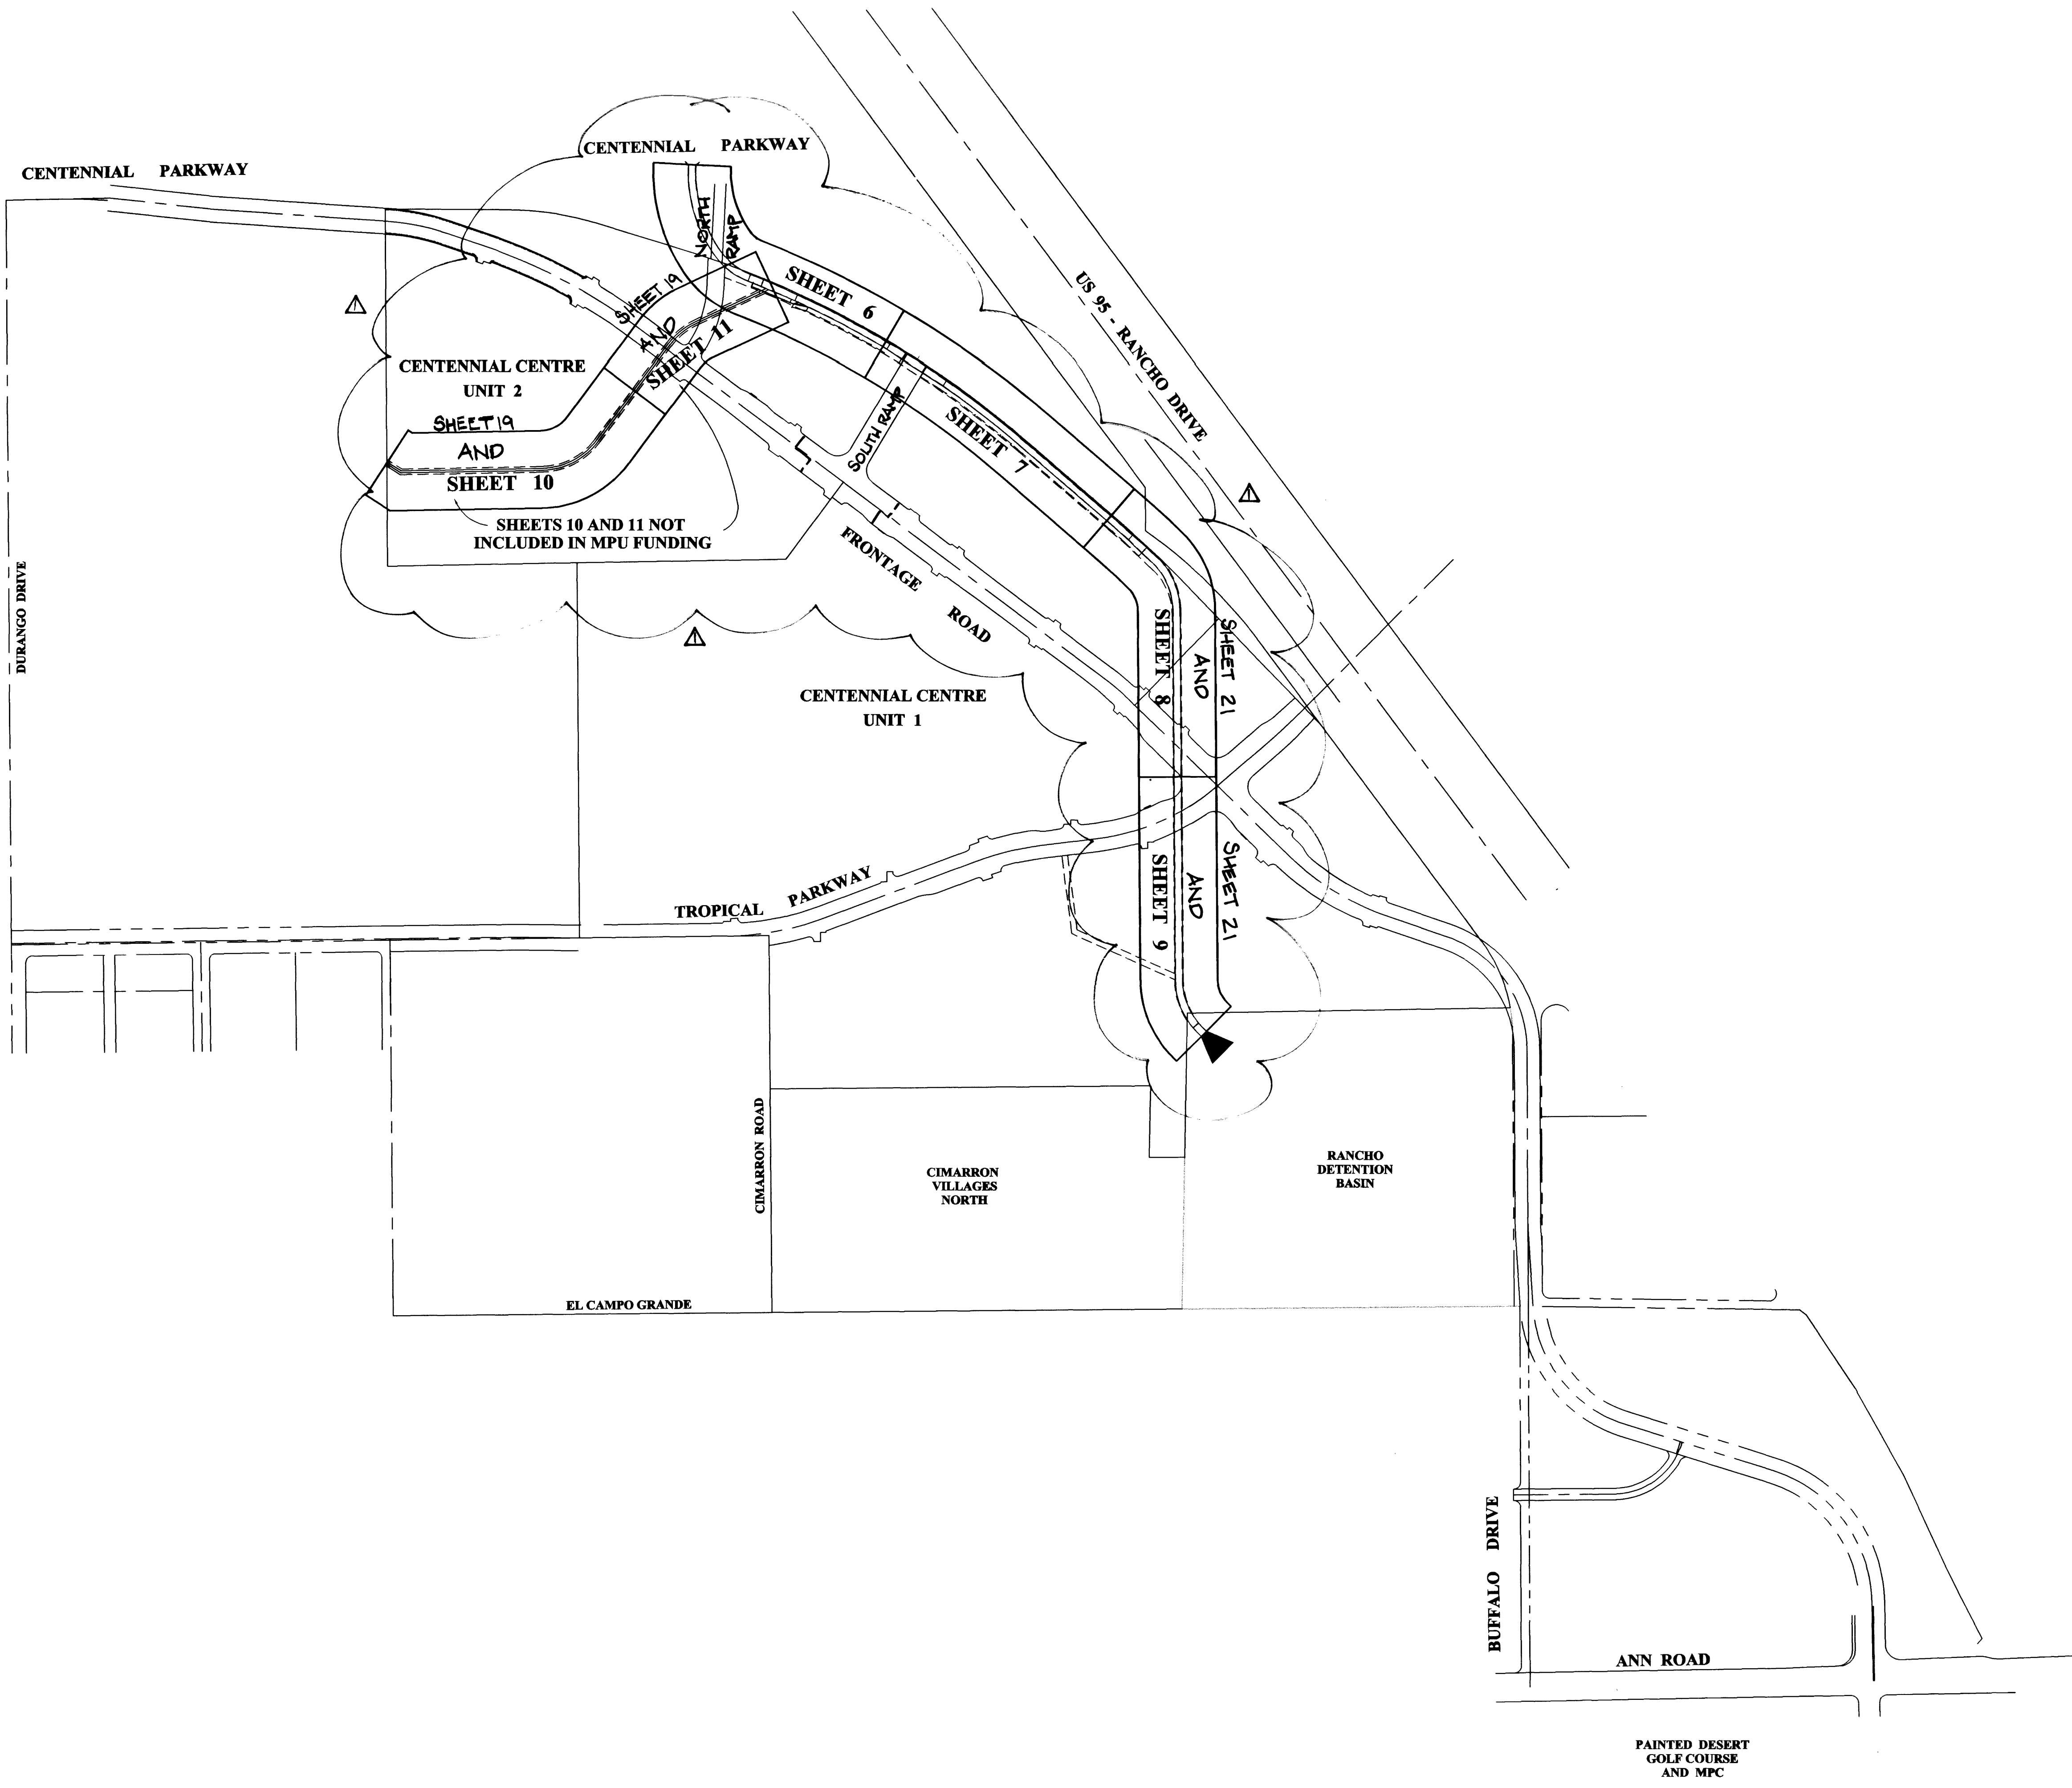

**Call before you OVERHEAD**  
1-702-593-6111  
NEVER TOUCH EQUIPMENT OR SAFETY SERVICES EQUIPMENT

**Call before you Dig.**  
1-800-227-2600  
NEVER DIG WITHOUT A SERVICE ALERT (USA)

|   |  |   |  |   |  |   |  |
|---|--|---|--|---|--|---|--|
| DRAWN BY: D. DECASTRO 11/22/99                                                                                      |  | DESIGNED BY: J. PATTERSON 11/22/99                                                                                  |  | CHECKED BY: J. SHIELDS 11/22/99                                                                                     |  | PROJECT NO: 99-505                                                                                                  |  |
| SEAL   |  | SEAL   |  | SEAL   |  | SEAL   |  |
| PROFESSIONAL ENGINEER - STATE OF NEVADA<br>JOHN J. SHIELDS<br>CIVIL<br>No. 1017                                     |  | PROFESSIONAL ENGINEER - STATE OF NEVADA<br>JOHN J. SHIELDS<br>CIVIL<br>No. 1017                                     |  | PROFESSIONAL ENGINEER - STATE OF NEVADA<br>JOHN J. SHIELDS<br>CIVIL<br>No. 1017                                     |  | PROFESSIONAL ENGINEER - STATE OF NEVADA<br>JOHN J. SHIELDS<br>CIVIL<br>No. 1017                                     |  |
| SHEET 5 OF 24 SHEETS                                                                                                |  | SHEET 5 OF 24 SHEETS                                                                                                |  | SHEET 5 OF 24 SHEETS                                                                                                |  | SHEET 5 OF 24 SHEETS                                                                                                |  |
| DRAWING NO. 107-V.3/78                                                                                              |  | DRAWING NO. 107-V.3/78                                                                                              |  | DRAWING NO. 107-V.3/78                                                                                              |  | DRAWING NO. 107-V.3/78                                                                                              |  |
| CENTENNIAL CENTRE<br>MPU FACILITY RCHO 0097<br>LAS VEGAS, NEVADA                                                    |  |
| INDEX MAP   |  | INDEX MAP   |  | INDEX MAP   |  | INDEX MAP   |  |
| CENTENNIAL CENTRE<br>A Limited Liability Company<br>7448 W. SARARA AVE.<br>LAS VEGAS, NEVADA 8917<br>(702) 222-1400 |  | CENTENNIAL CENTRE<br>A Limited Liability Company<br>7448 W. SARARA AVE.<br>LAS VEGAS, NEVADA 8917<br>(702) 222-1400 |  | CENTENNIAL CENTRE<br>A Limited Liability Company<br>7448 W. SARARA AVE.<br>LAS VEGAS, NEVADA 8917<br>(702) 222-1400 |  | CENTENNIAL CENTRE<br>A Limited Liability Company<br>7448 W. SARARA AVE.<br>LAS VEGAS, NEVADA 8917<br>(702) 222-1400 |  |
| Engineers/Planners/Surveyors<br>205 East Warm Springs Road Suite 108<br>LAS VEGAS, NV 89119 (702) 866-6604          |  | Engineers/Planners/Surveyors<br>205 East Warm Springs Road Suite 108<br>LAS VEGAS, NV 89119 (702) 866-6604          |  | Engineers/Planners/Surveyors<br>205 East Warm Springs Road Suite 108<br>LAS VEGAS, NV 89119 (702) 866-6604          |  | Engineers/Planners/Surveyors<br>205 East Warm Springs Road Suite 108<br>LAS VEGAS, NV 89119 (702) 866-6604          |  |
| EKN<br>ENGINEERING                                                                                                  |  | EKN<br>ENGINEERING                                                                                                  |  | EKN<br>ENGINEERING                                                                                                  |  | EKN<br>ENGINEERING                                                                                                  |  |
| CHANGE/ADD SHEET NUMBERS                                                                                            |  | CHANGE/ADD SHEET NUMBERS                                                                                            |  | CHANGE/ADD SHEET NUMBERS                                                                                            |  | CHANGE/ADD SHEET NUMBERS                                                                                            |  |
| REV. DATE BY   |  | REV. DATE BY   |  | REV. DATE BY   |  | REV. DATE BY   |  |