
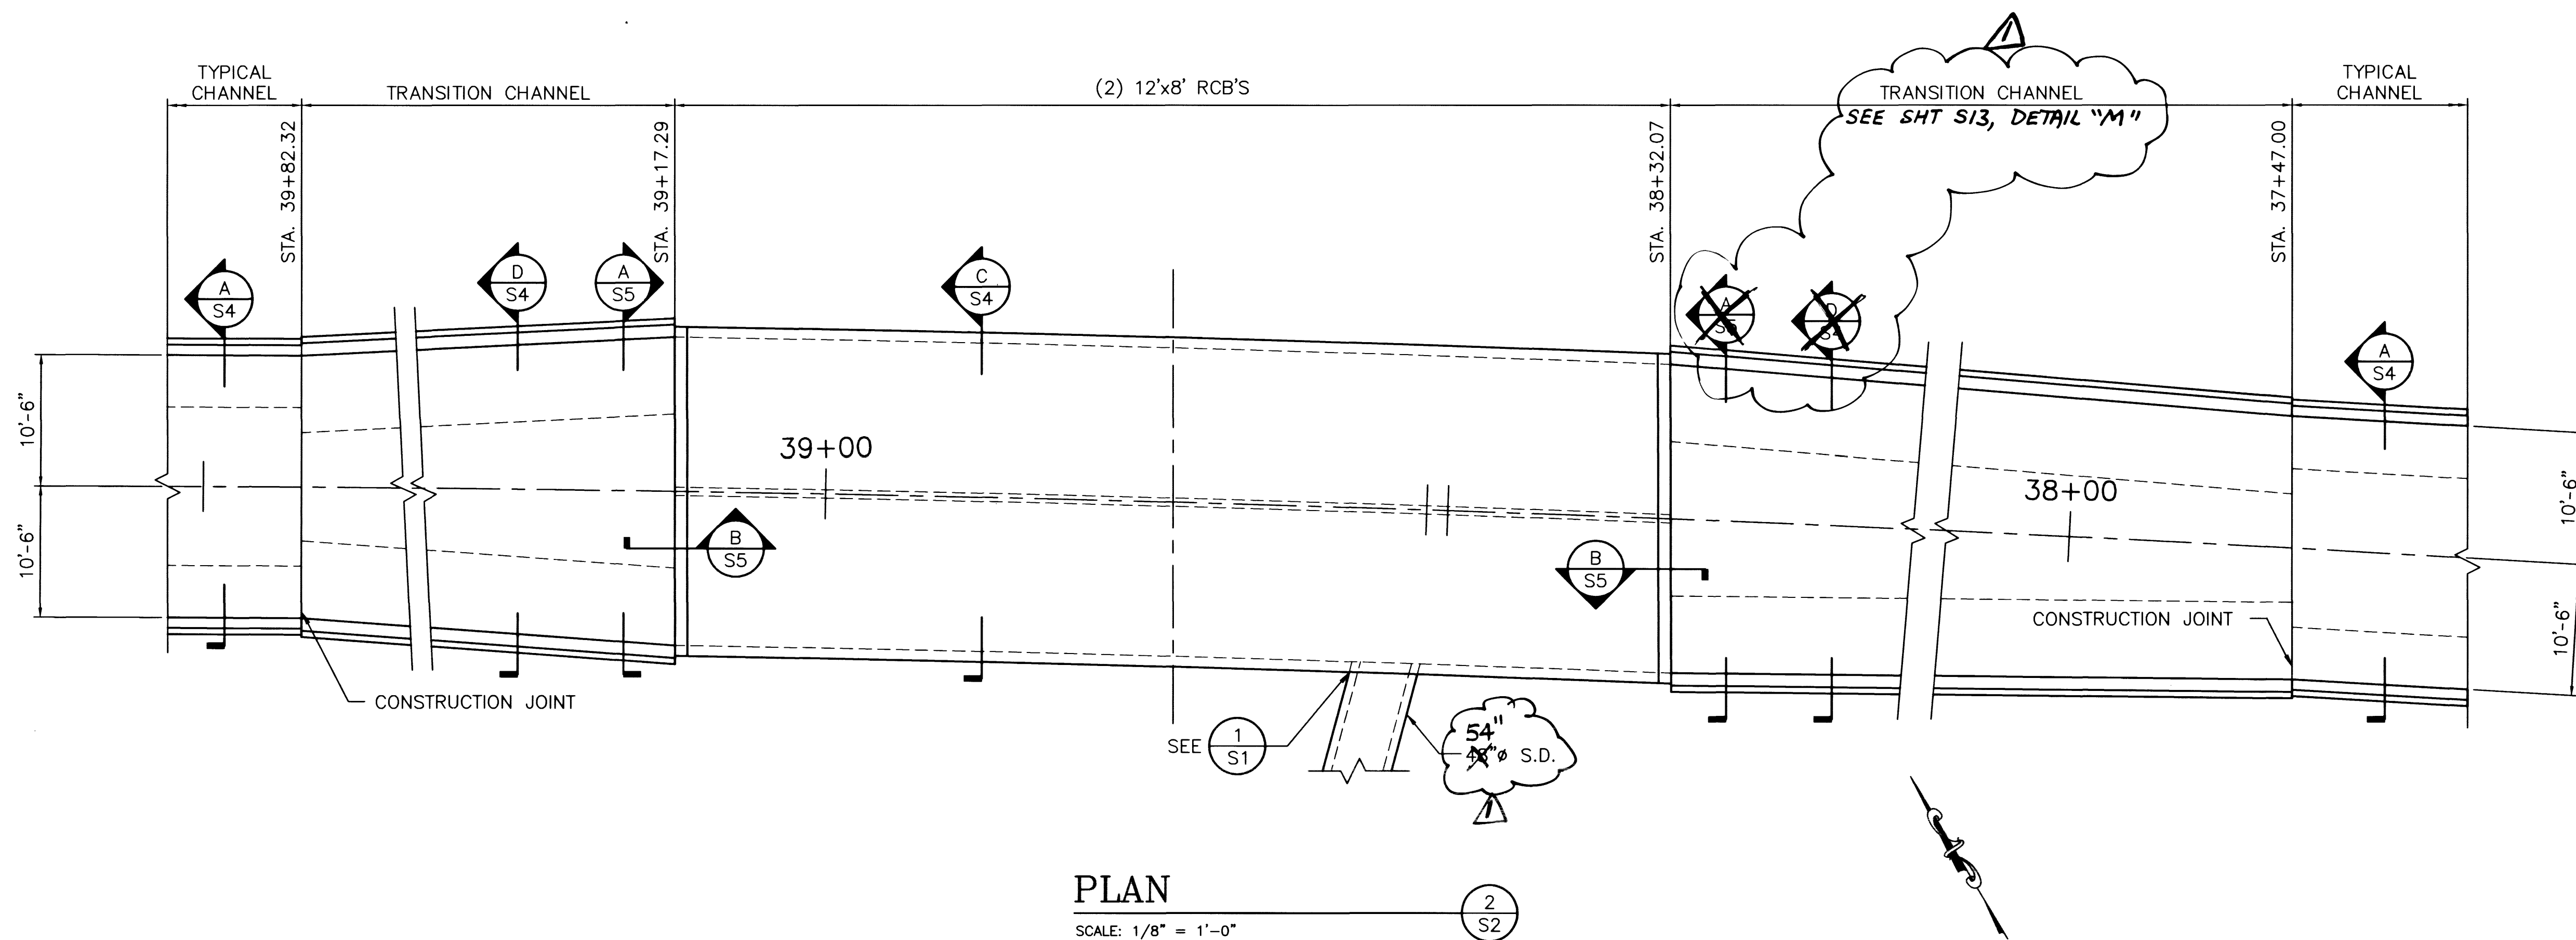


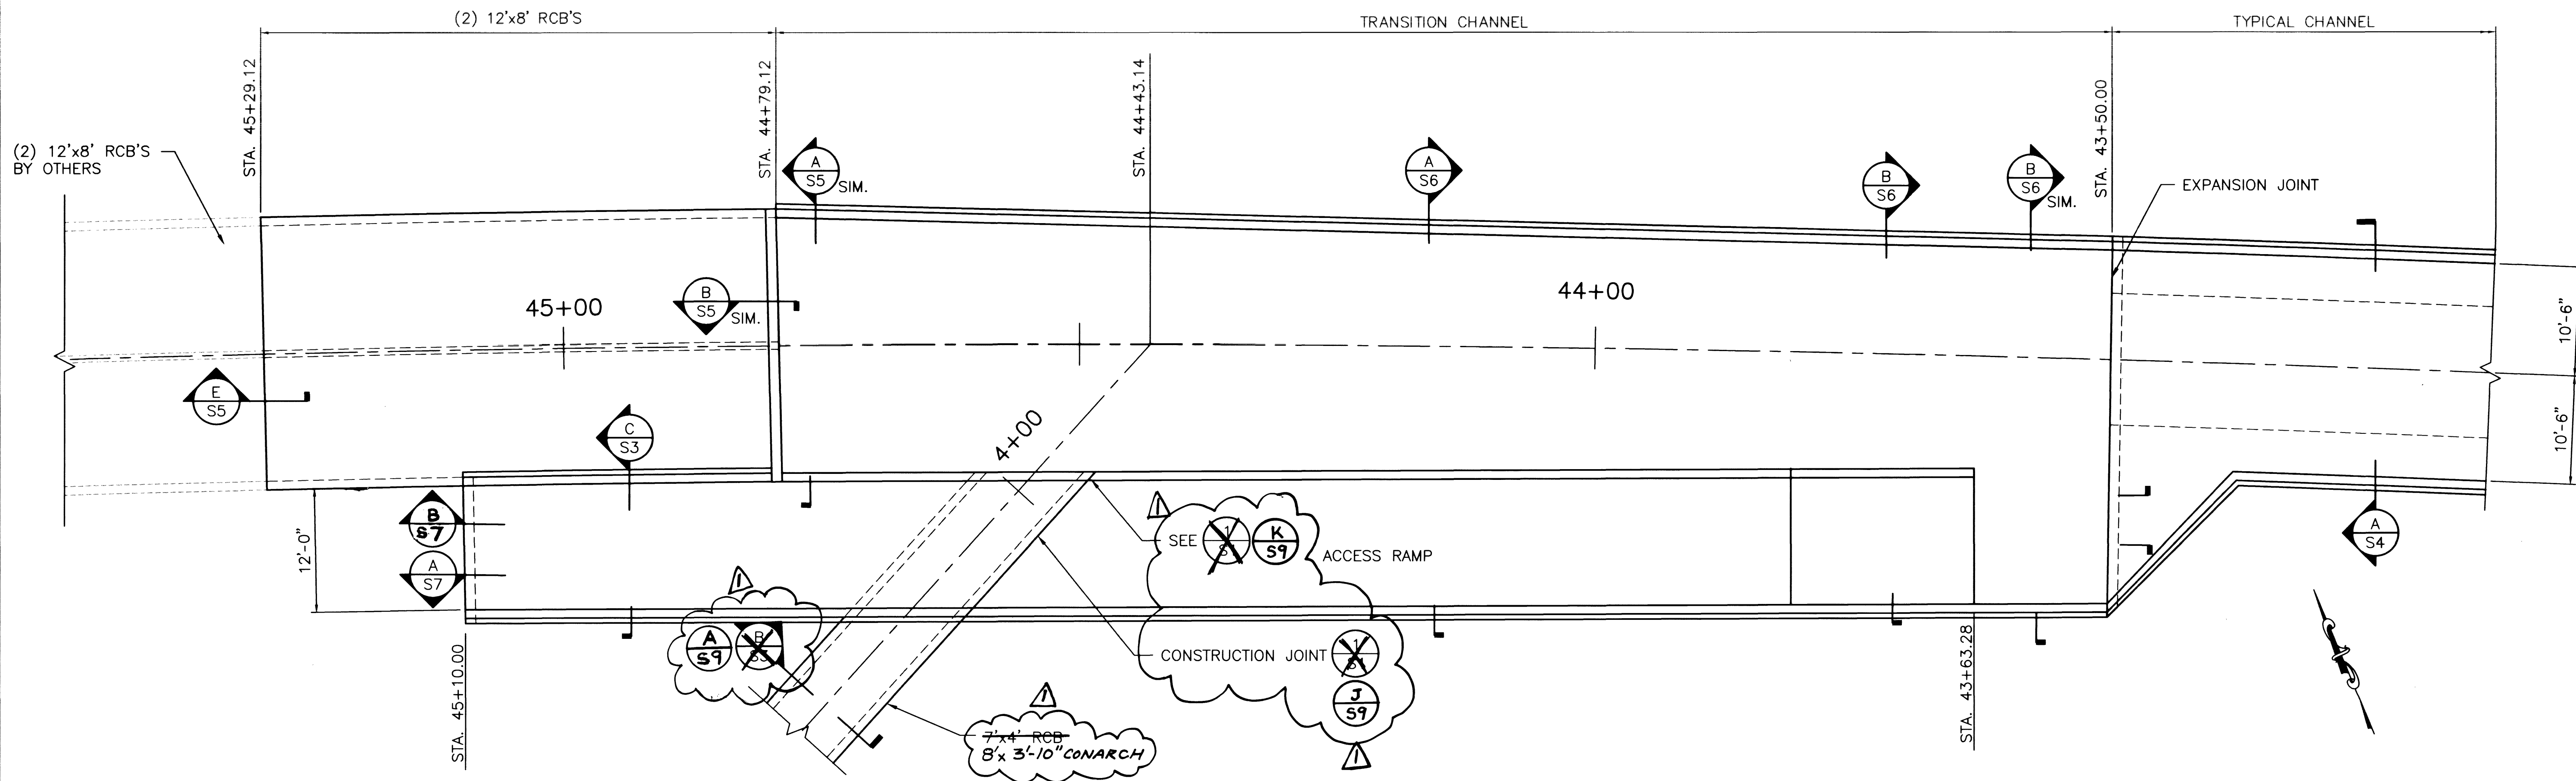

STRUCTURAL CHANNEL AND RCB PLANS CENTENNIAL CENTRE MPU FACILITY RCHO 0087 CITY OF LAS VEGAS		ENGINEERING EKN CENTENNIAL CENTRE A Limited Liability Company 7448 W. SAHARA AVENUE LAS VEGAS, NEVADA 8917 (702) 222-1410 Engineers/Planners/Surveyors 203 East Warm Springs Road, Suite 108 LAS VEGAS, NV 89167 (702) 866-6604		SHEET 13 OF 24 SHEETS DRAWING NO. 107-V3170
DRAWN BY: ALA DESIGNED BY: DWS CHECKED BY: DWS PROJECT NO: 99105	DATE: Oct. 1, 1999 DATE: Oct. 1, 1999 DATE: Oct. 1, 1999	SCALE: AS SHOWN	REVISION BY DATE	

19894
 23558