



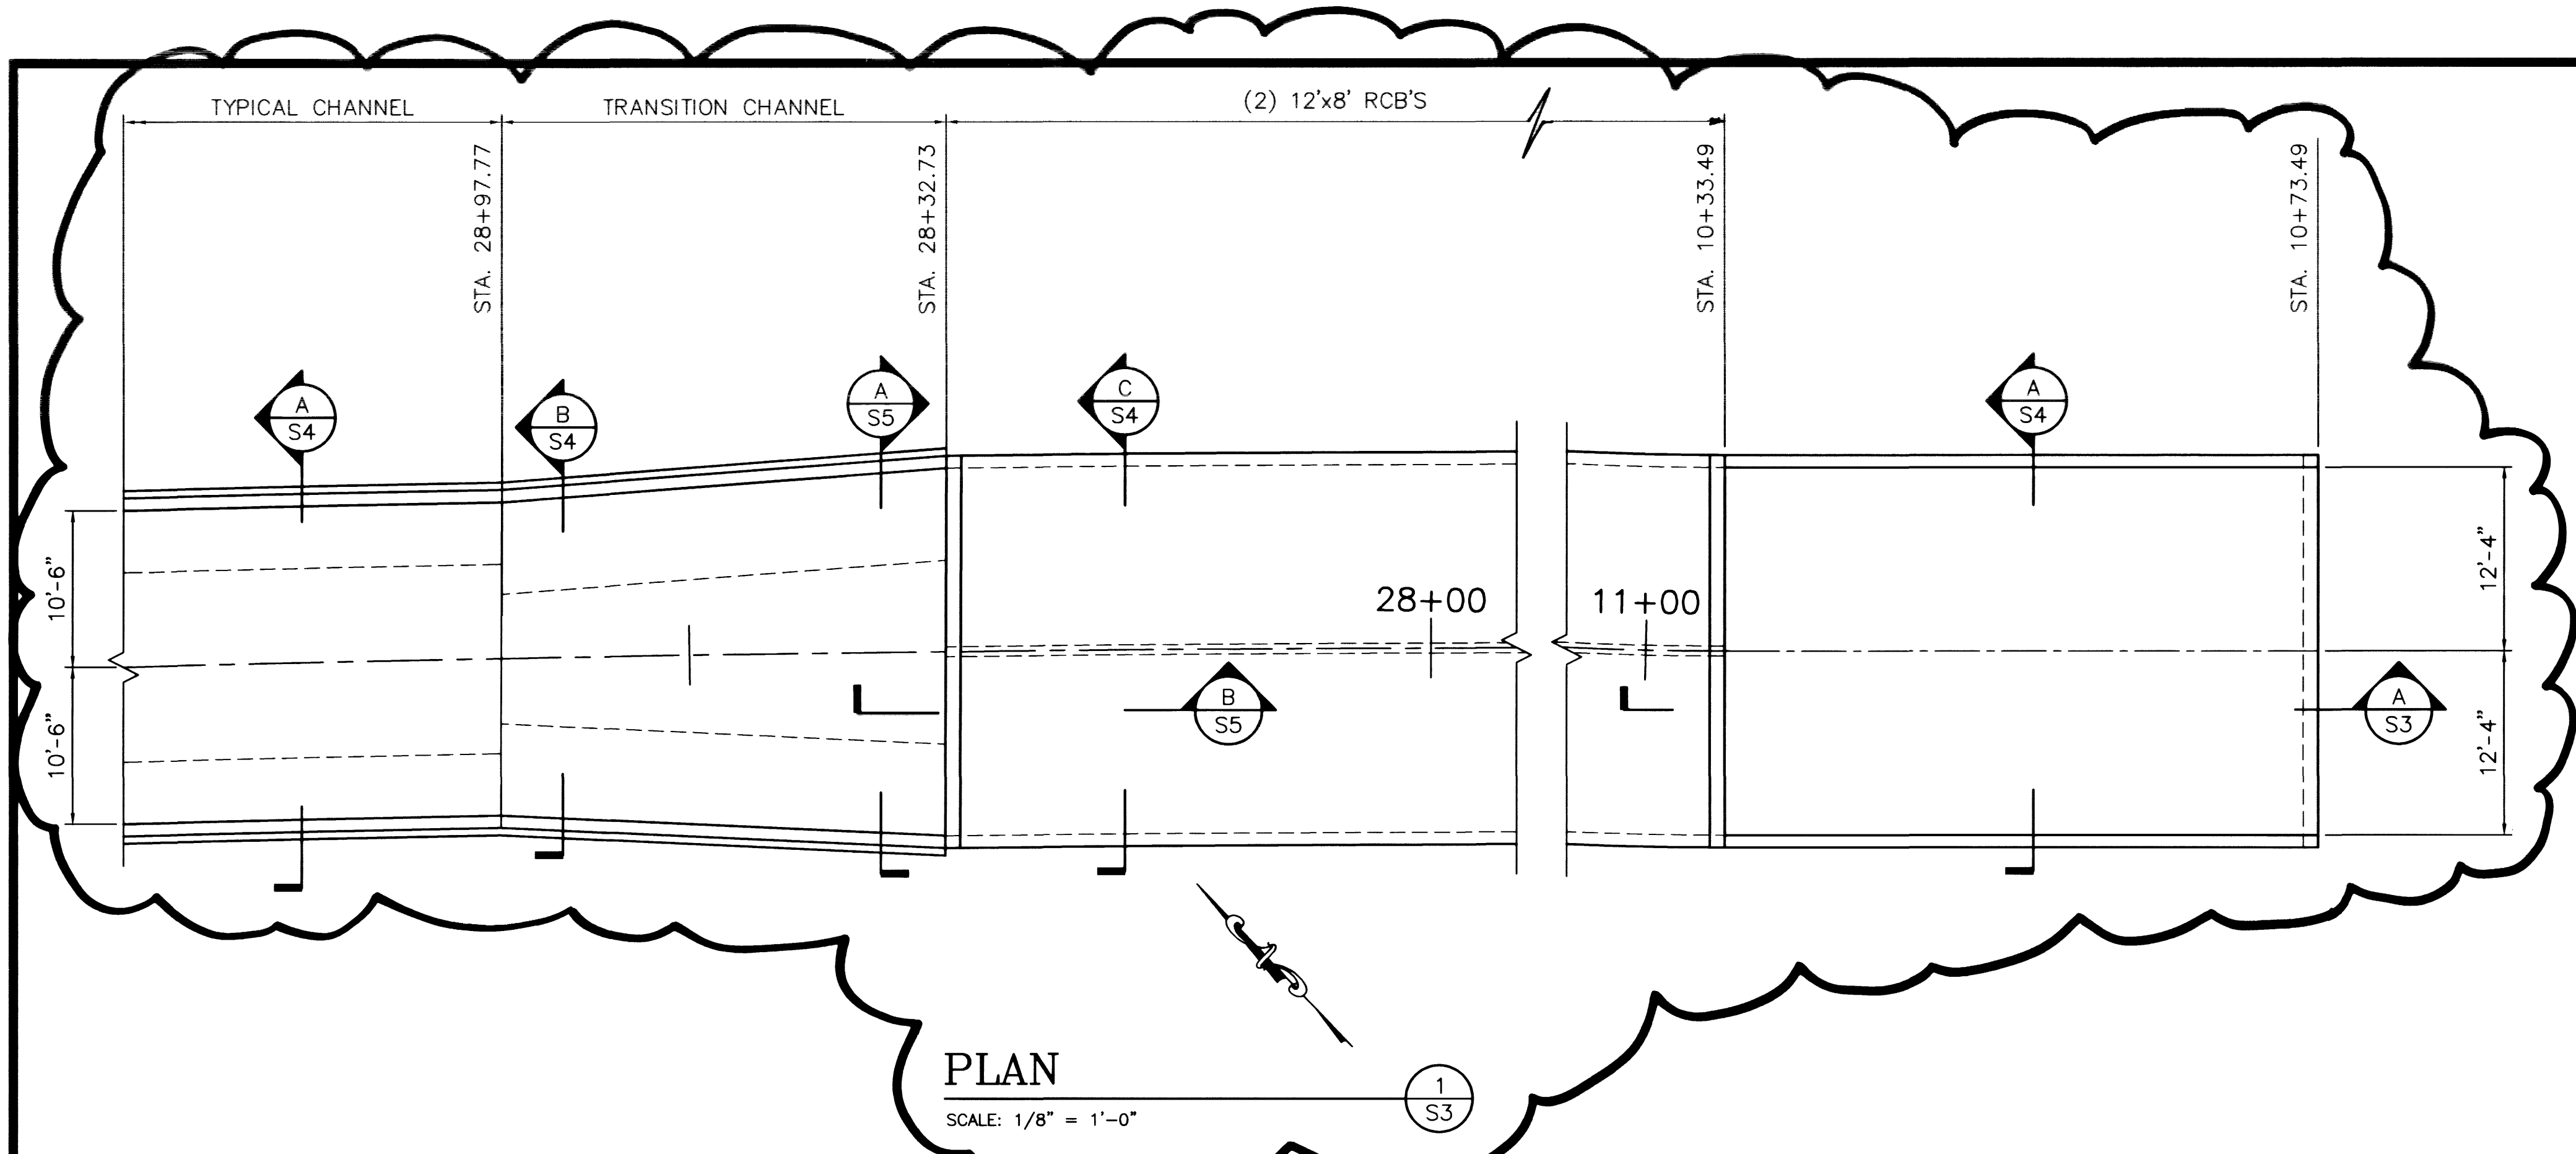

PLAN


SCALE: 1/8" = 1'-0"

SEE CONARCH PLANS
SHT. S-12 DETAILS 'E' & 'L'

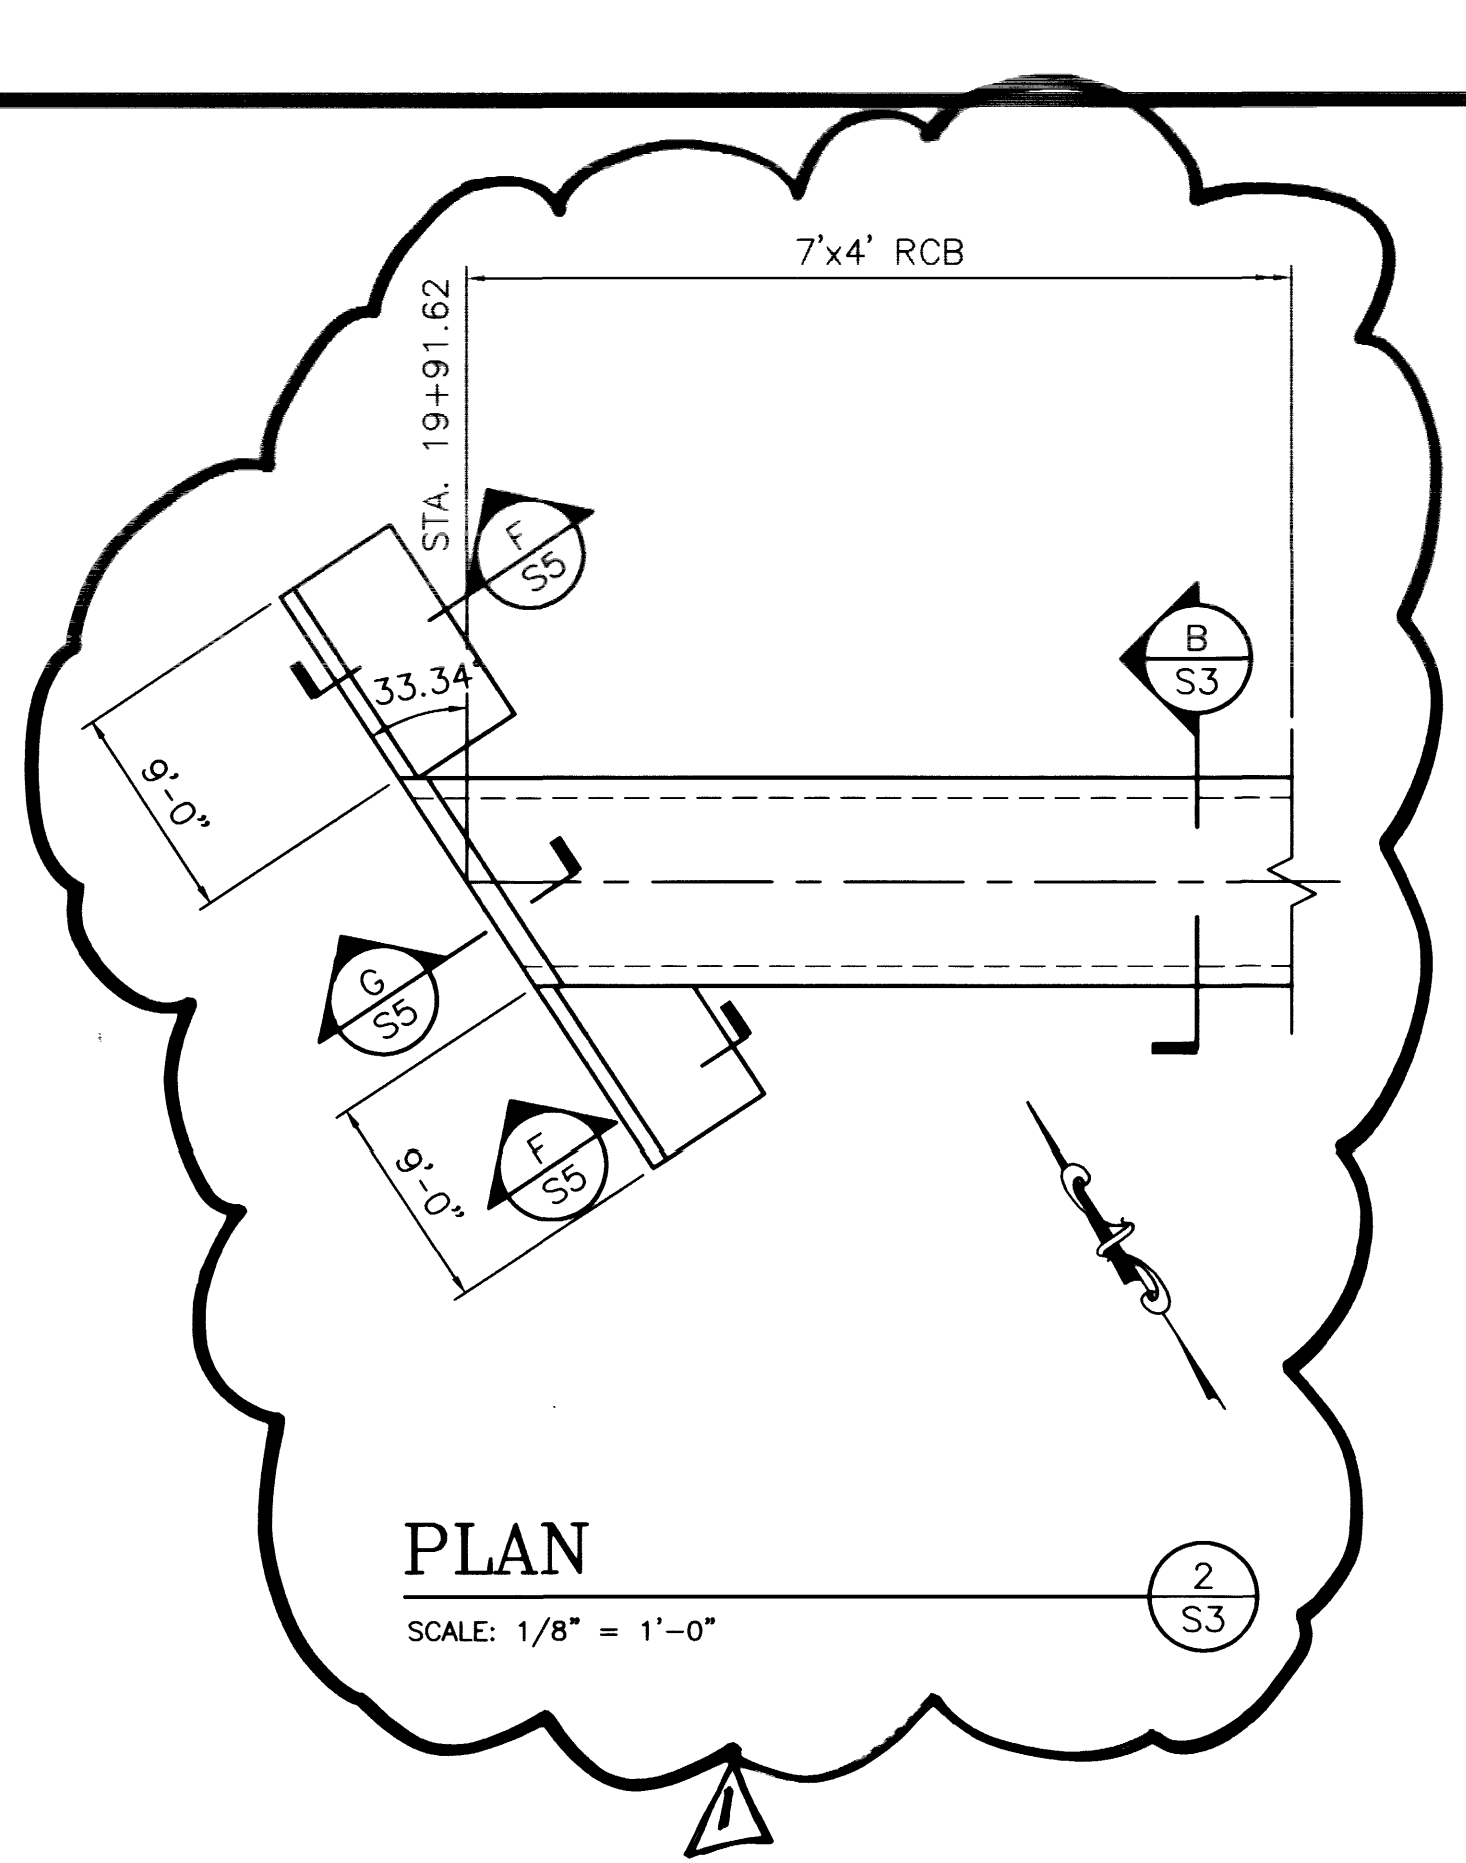


PLAN

SCALE: 1/8" = 1'-0"

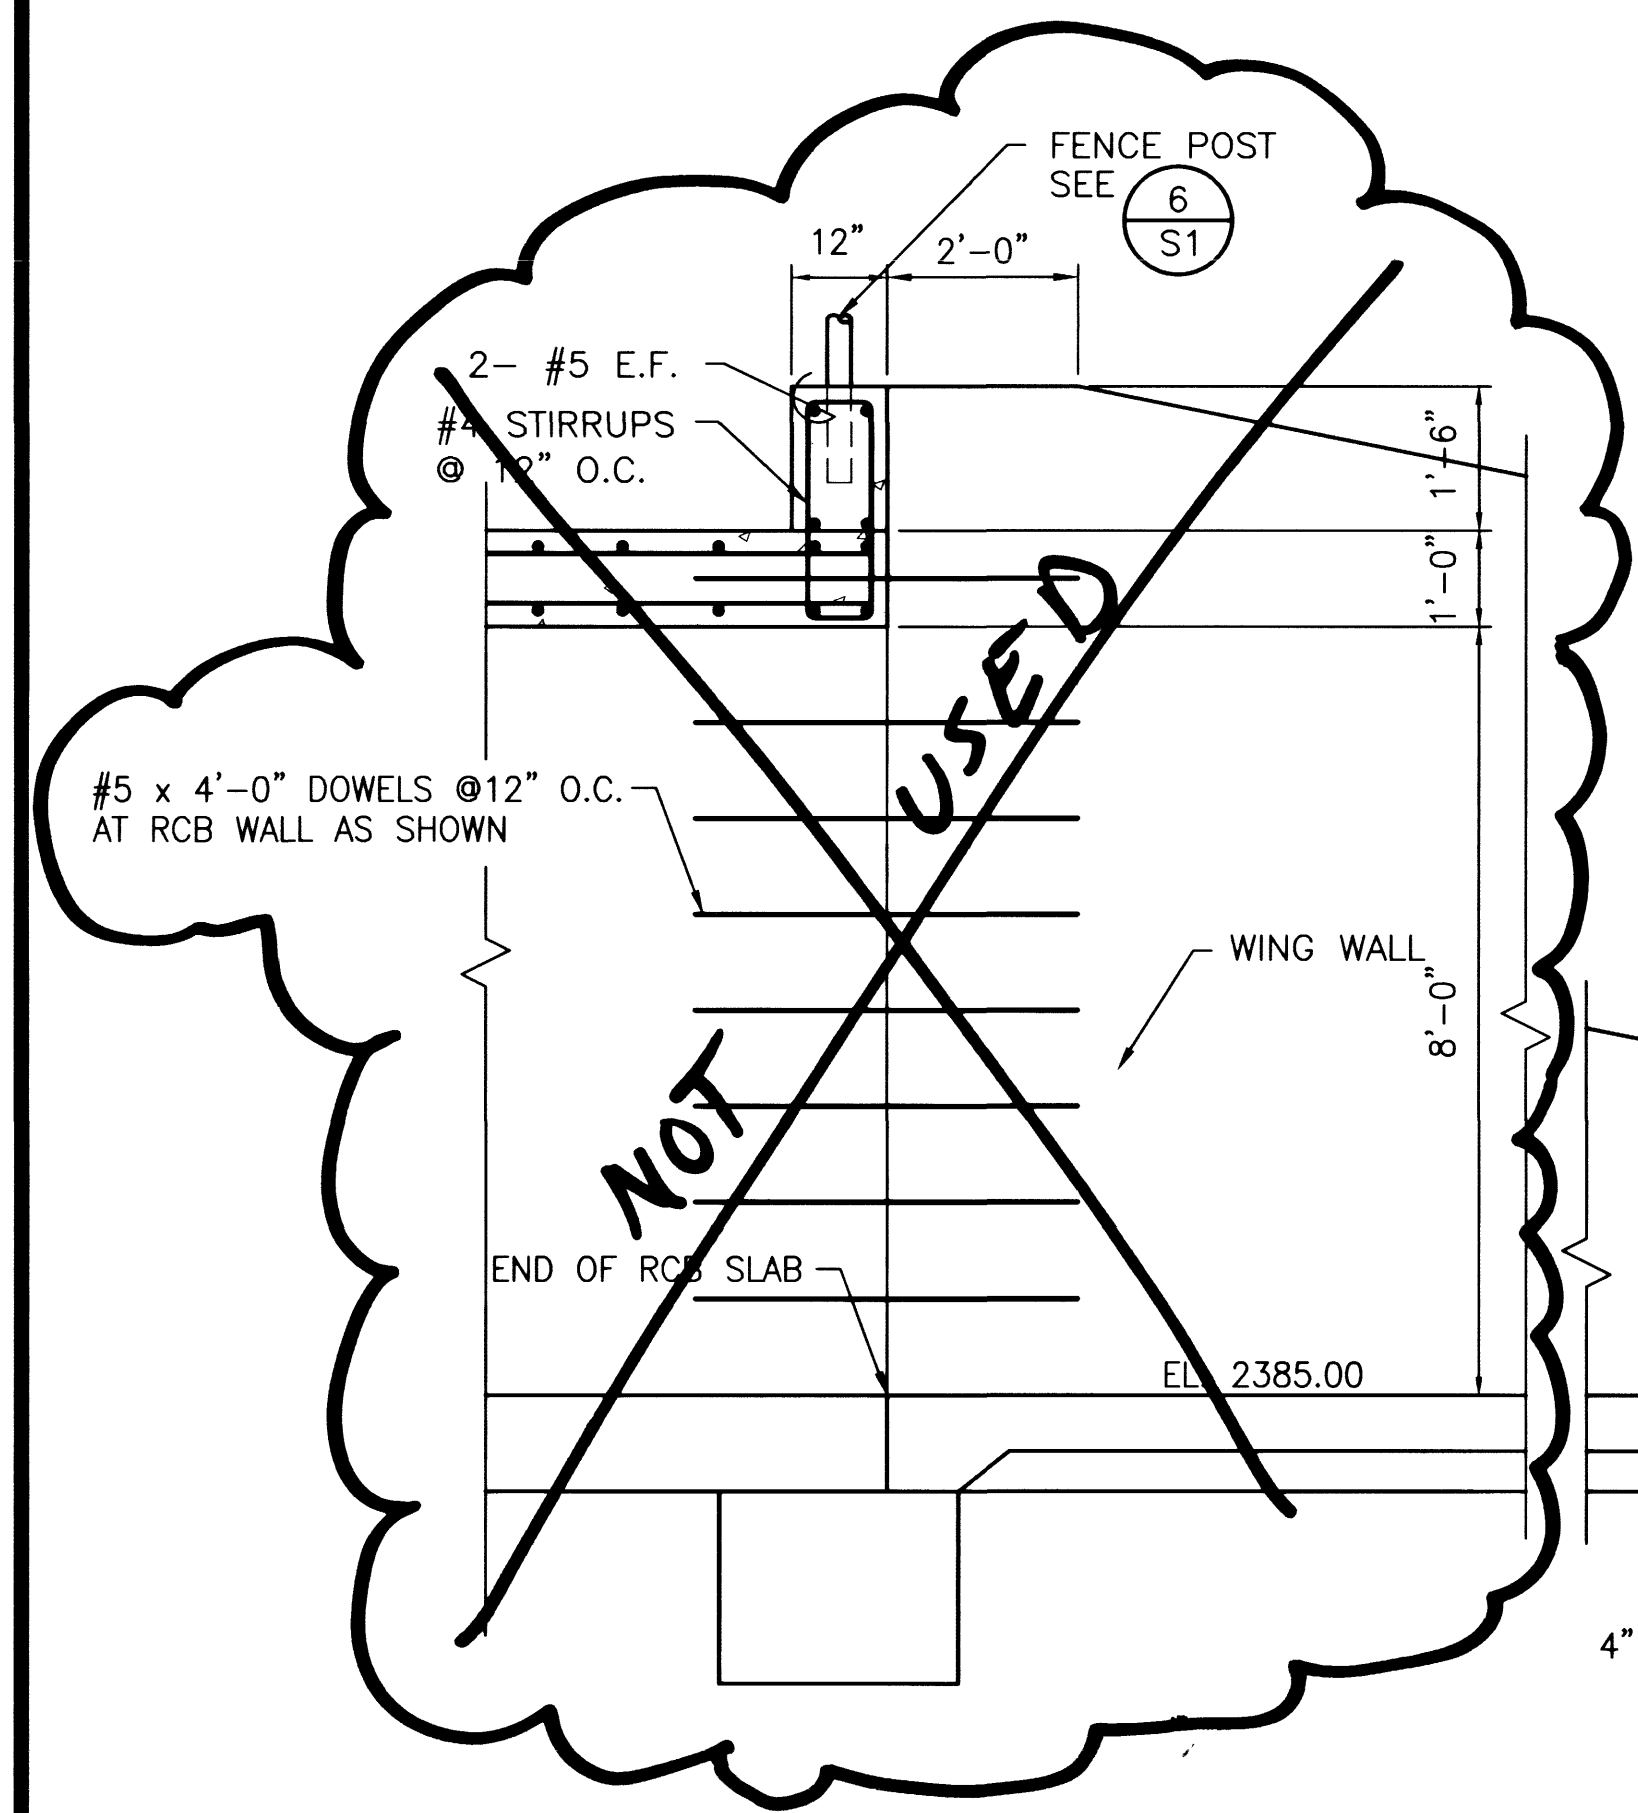


CHANNEL SECTION

SCALE: 1/2" = 1'-0"

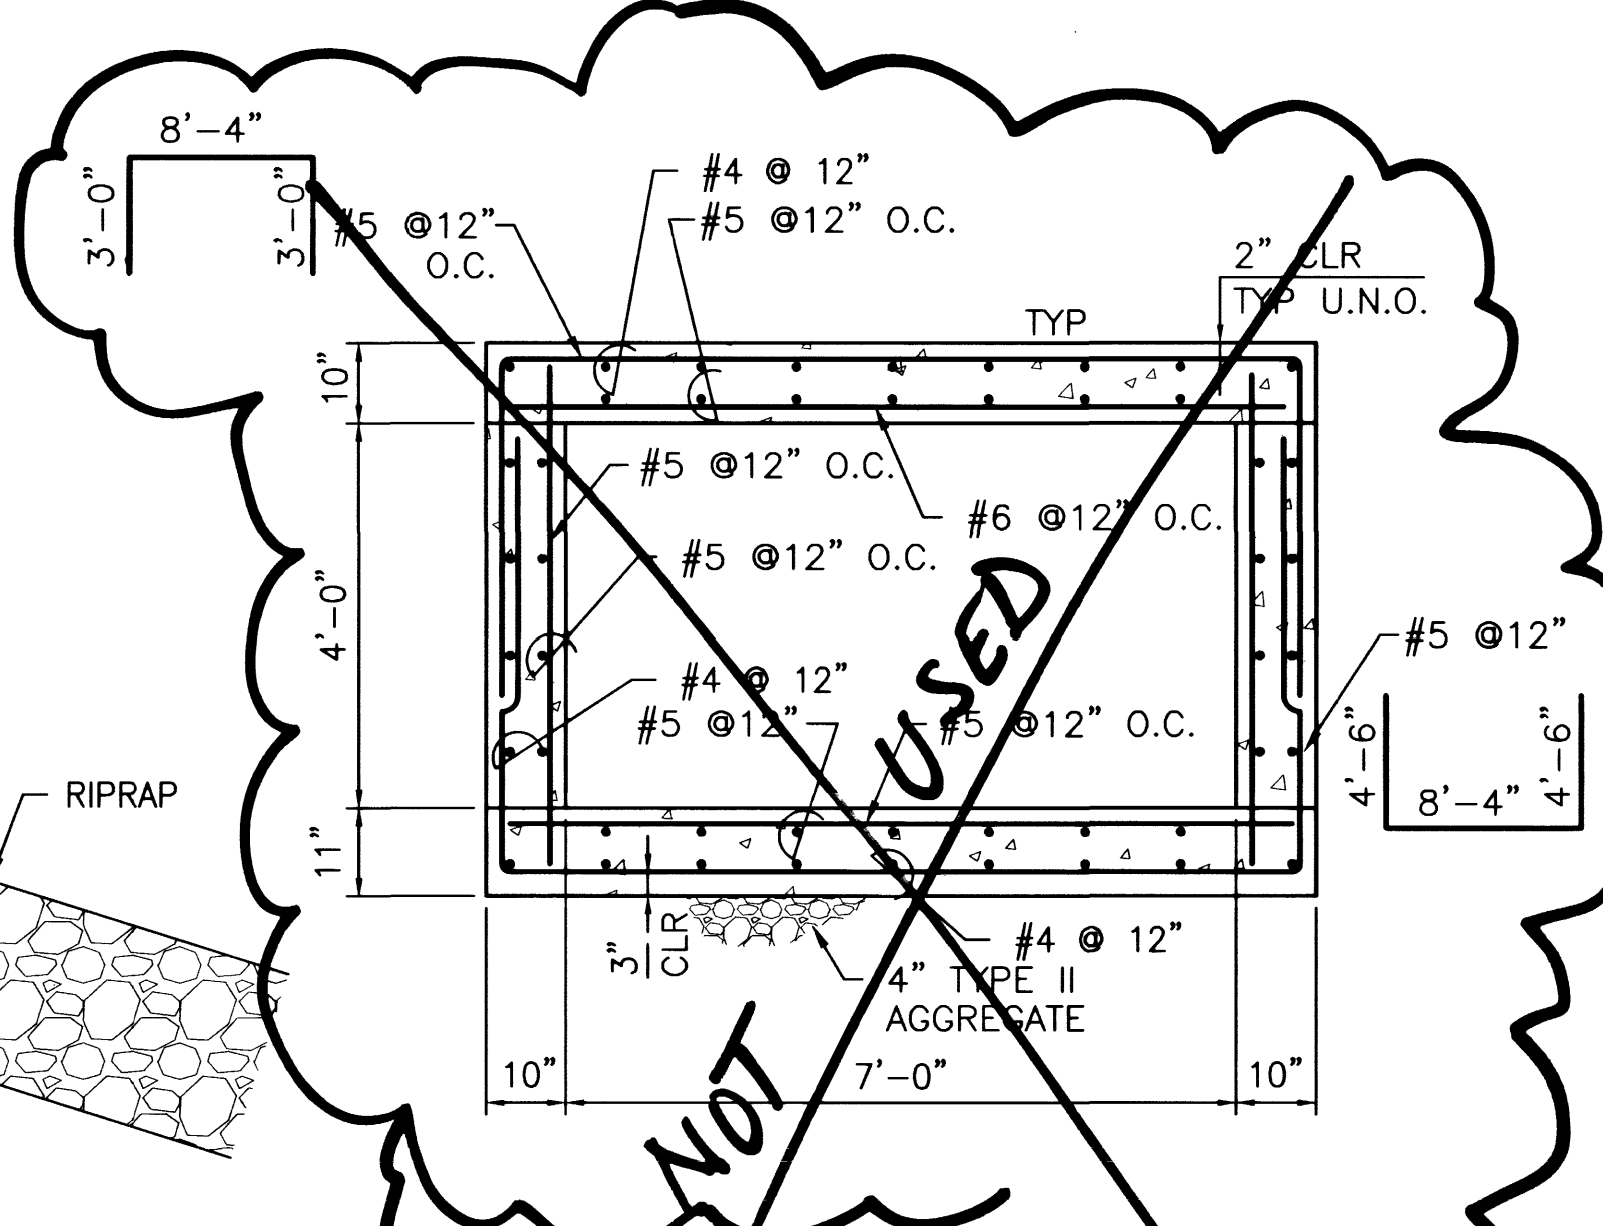

SECTION 7'x4' RCB

SCALE: 1/2" = 1'-0"

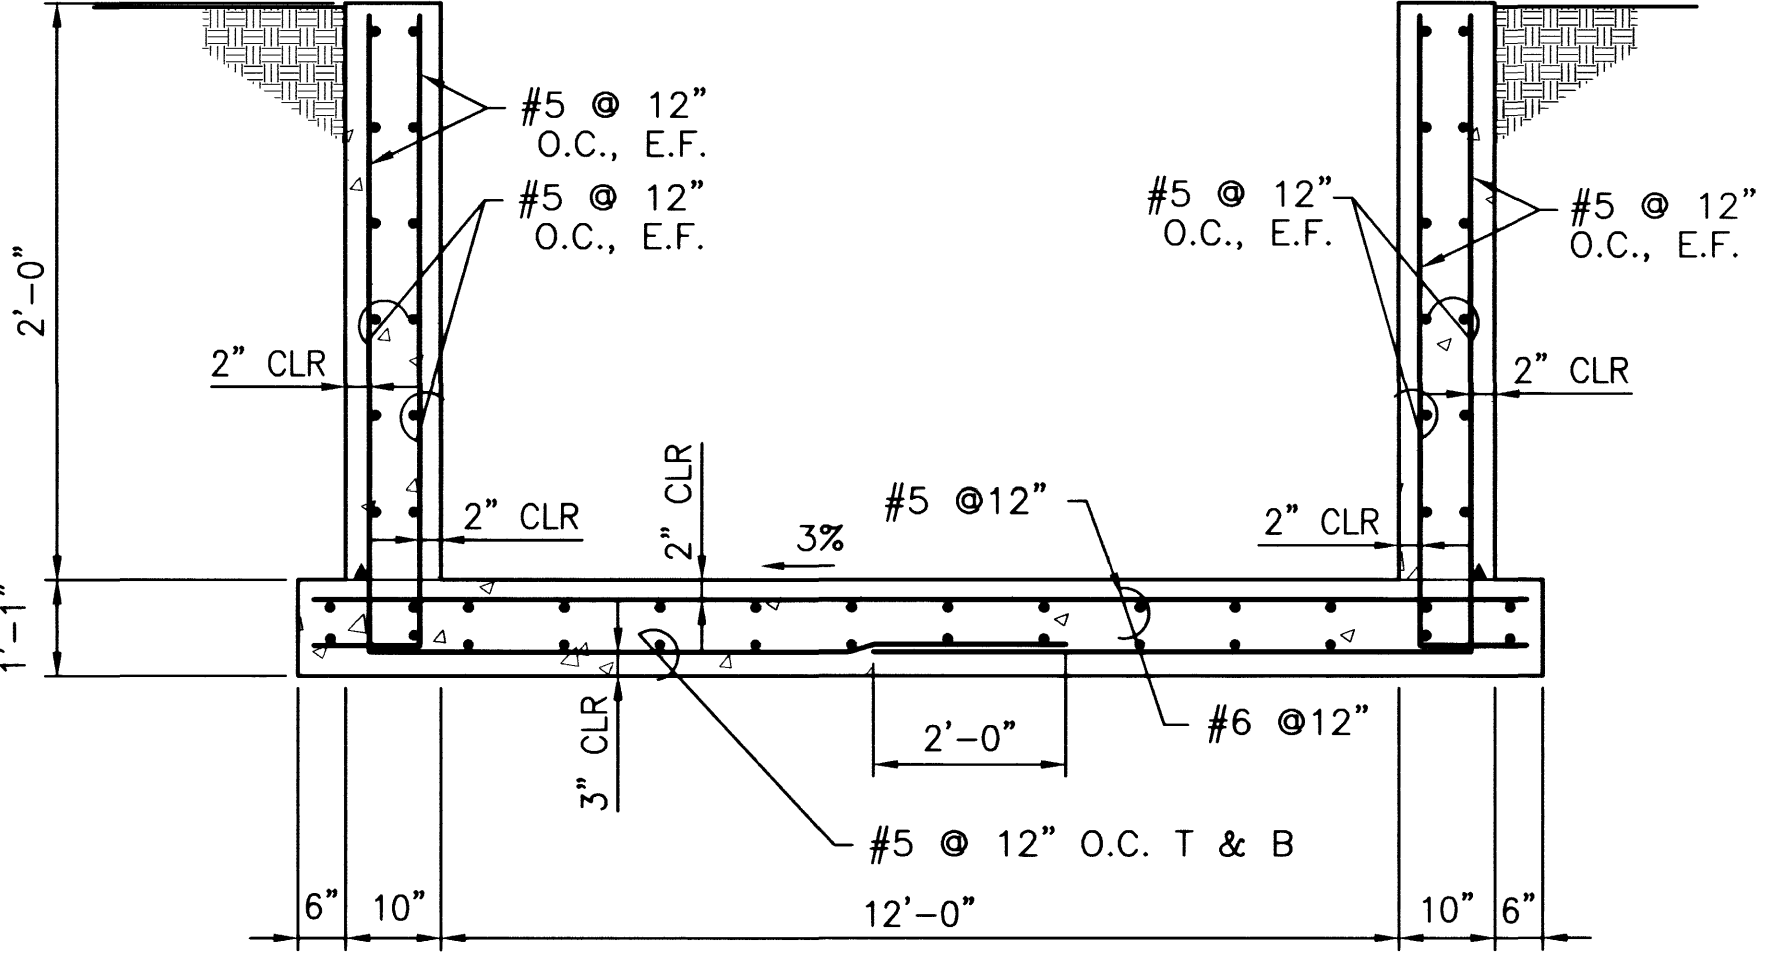

SECTION

SCALE: N.T.S.

CENTENNIAL CENTRE 7448 W. SAHARA AVENUE LAS VEGAS, NEVADA 89117 (702) 922-1400 A Limited Liability Company		Engineers/Planners/Surveyors 205 East Warm Springs Road Suite 105 LAS VEGAS, NV 89119 (702) 866-6604	
STRUCTURAL CHANNEL AND RCB PLANS		CENTENNIAL CENTRE MPJ FACILITY RCHO 0097 CITY OF LAS VEGAS	
DRAWN BY: ALA	DESIGNED BY: DMS	CHECKED BY: DMS	PROJECT NO: 89105
DATE: Oct. 1, 1999	DATE: Oct. 1, 1999	DATE: Oct. 1, 1999	SCALE: AS SHOWN
SHEET S3 14 OF 24 SHEETS DRAWING NO. 107-V3/70			
SEAL PROFESSIONAL ENGINEER-STATE OF NEVADA DAVID W. SEELEY No. 11751 10/5/99			