
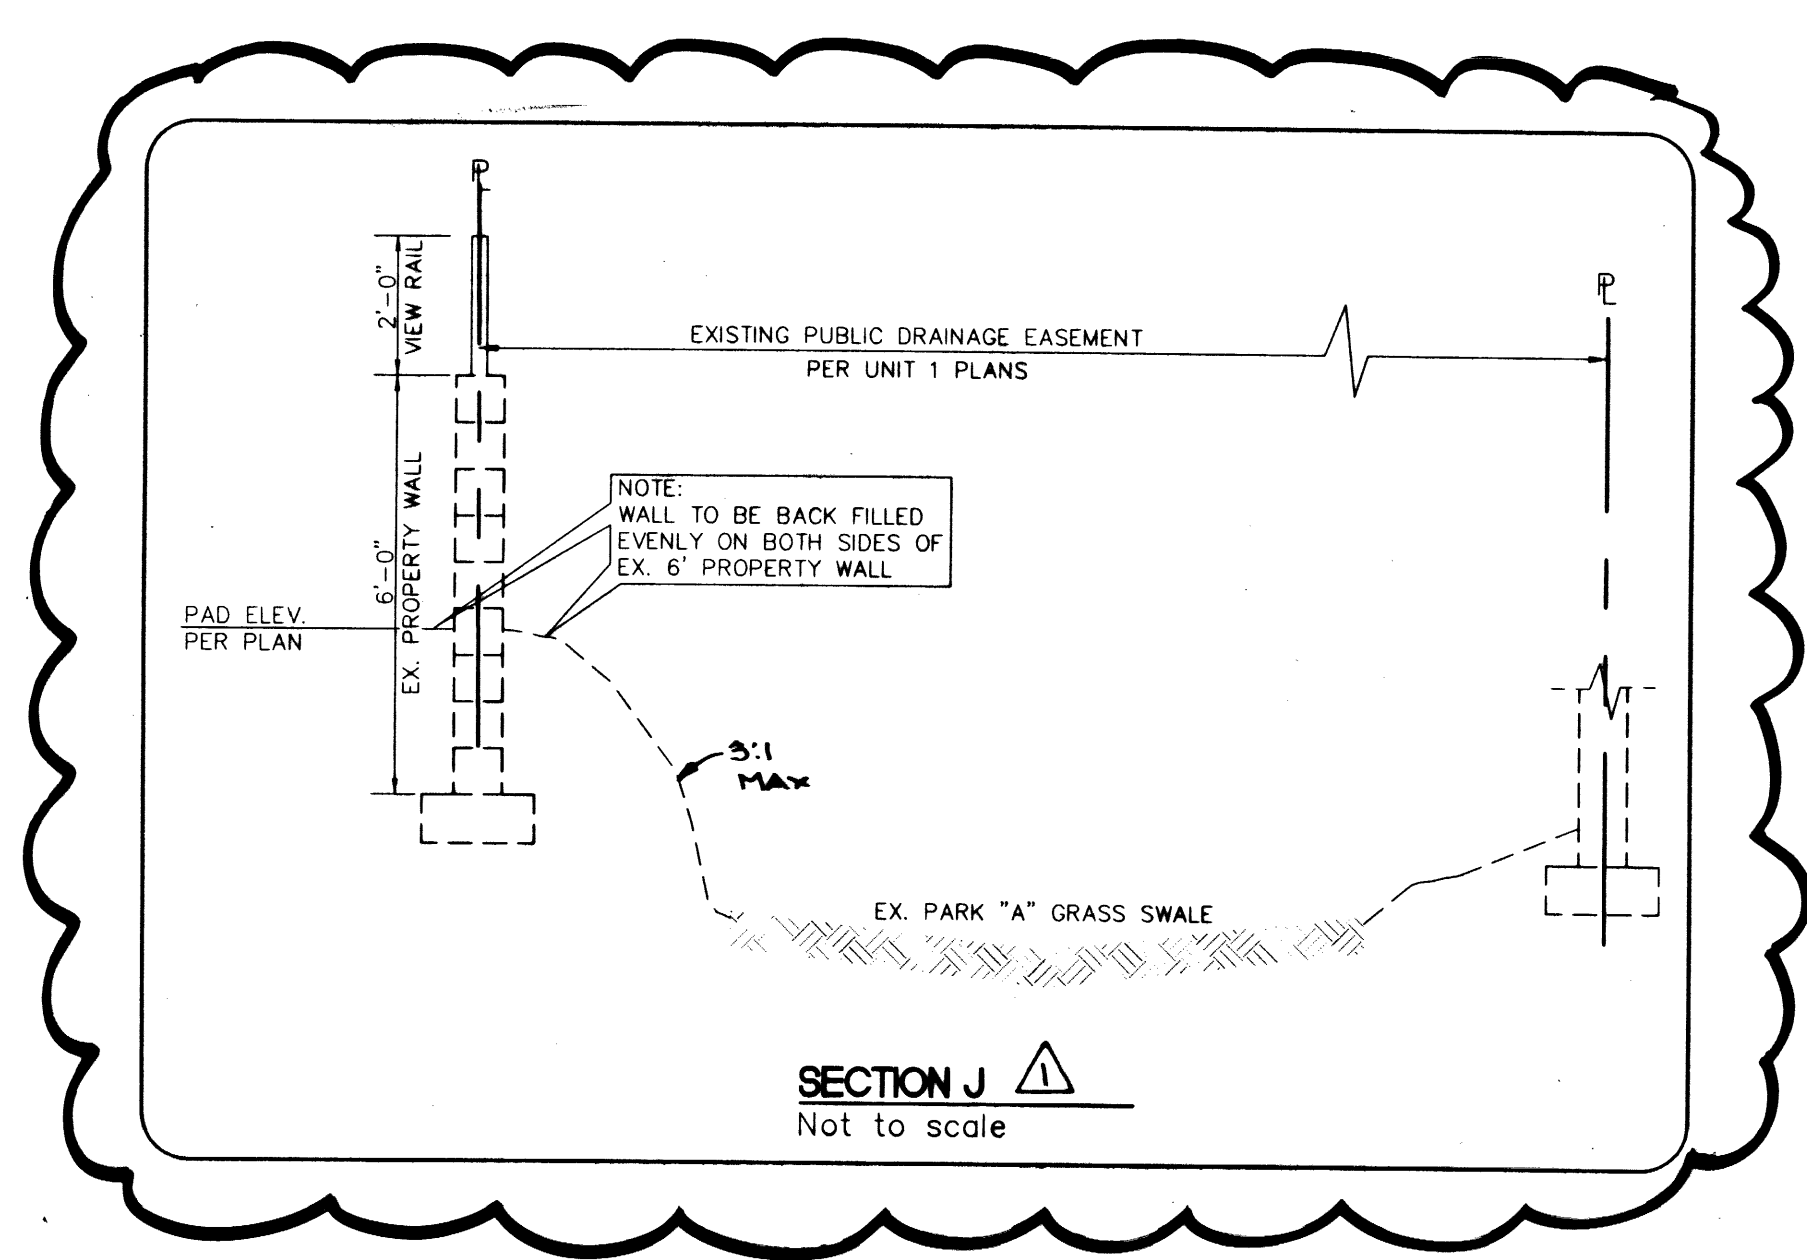
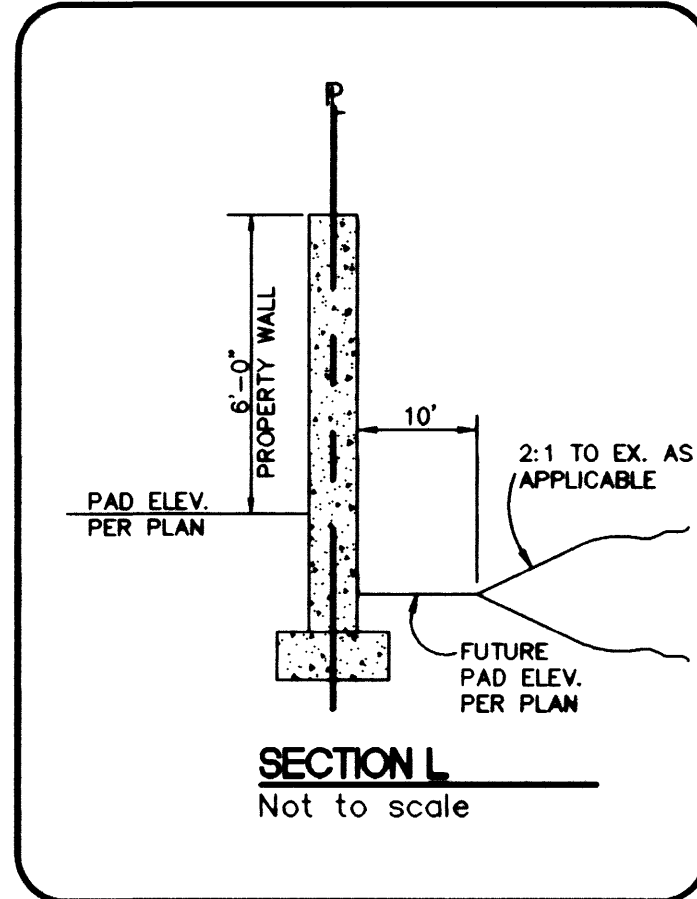
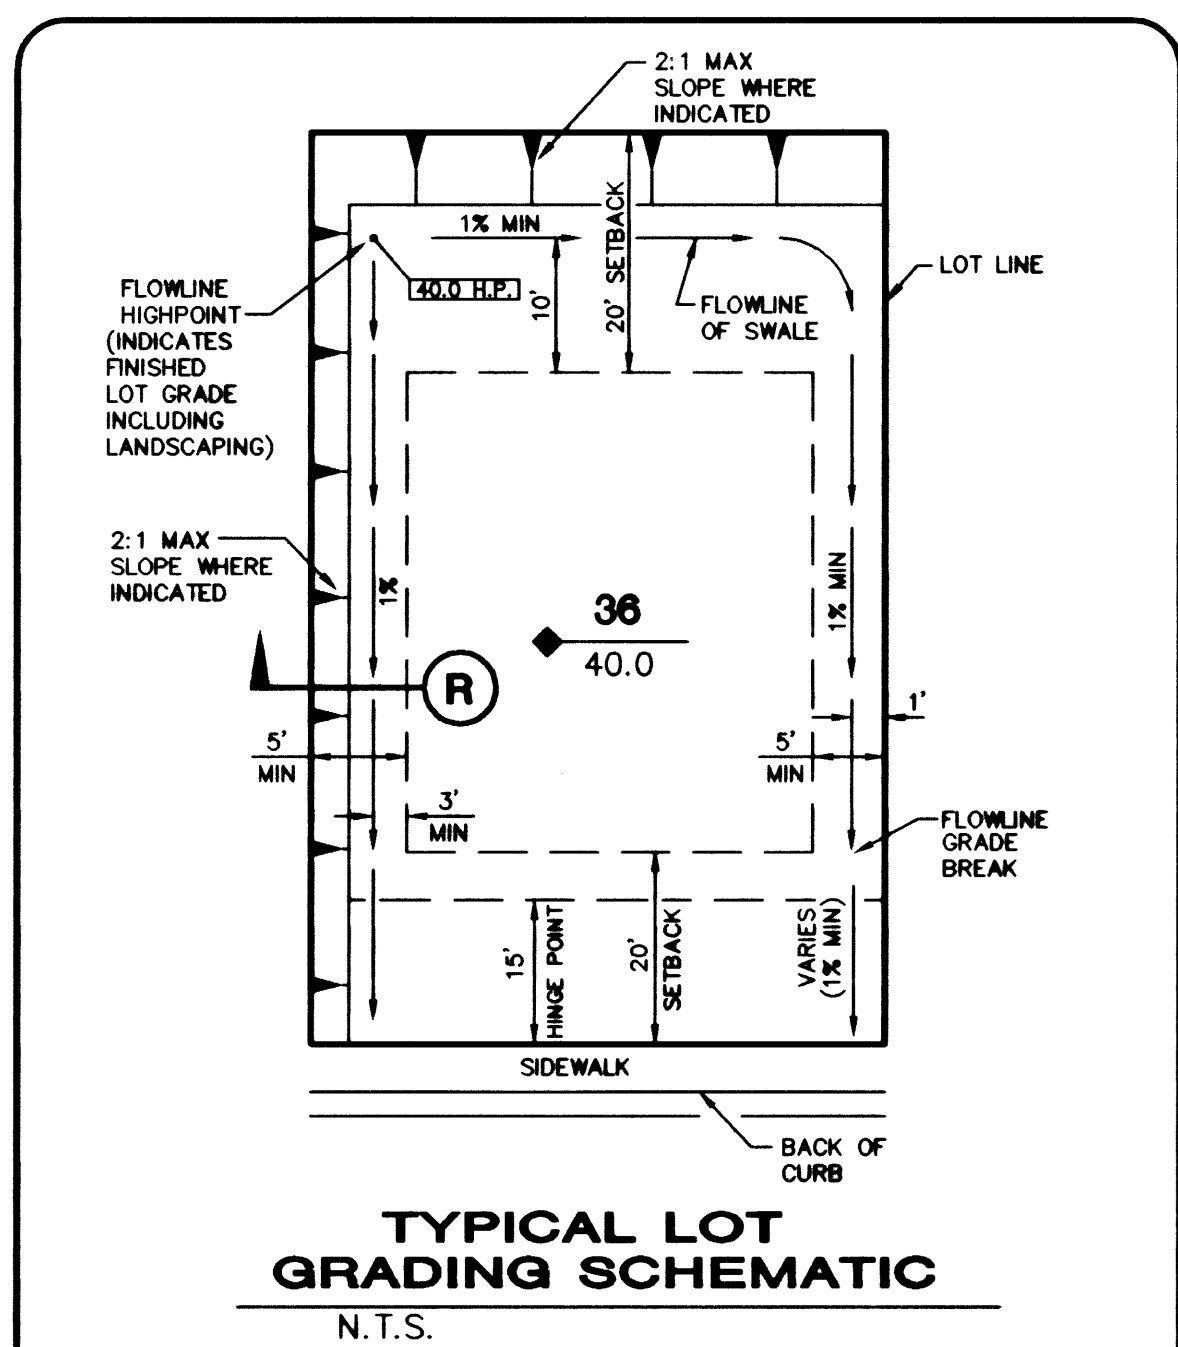
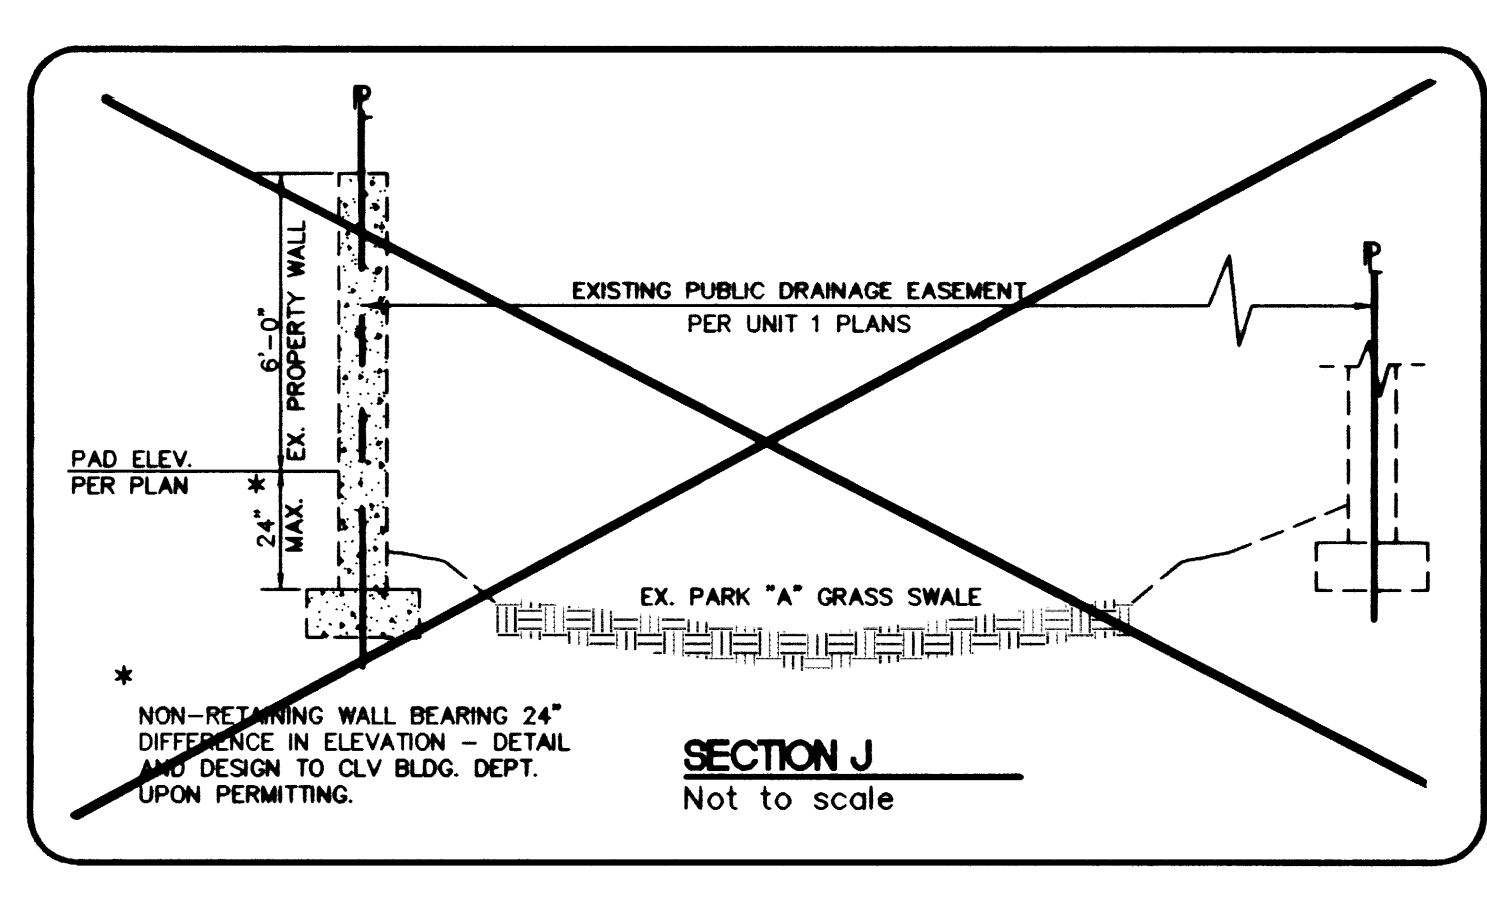
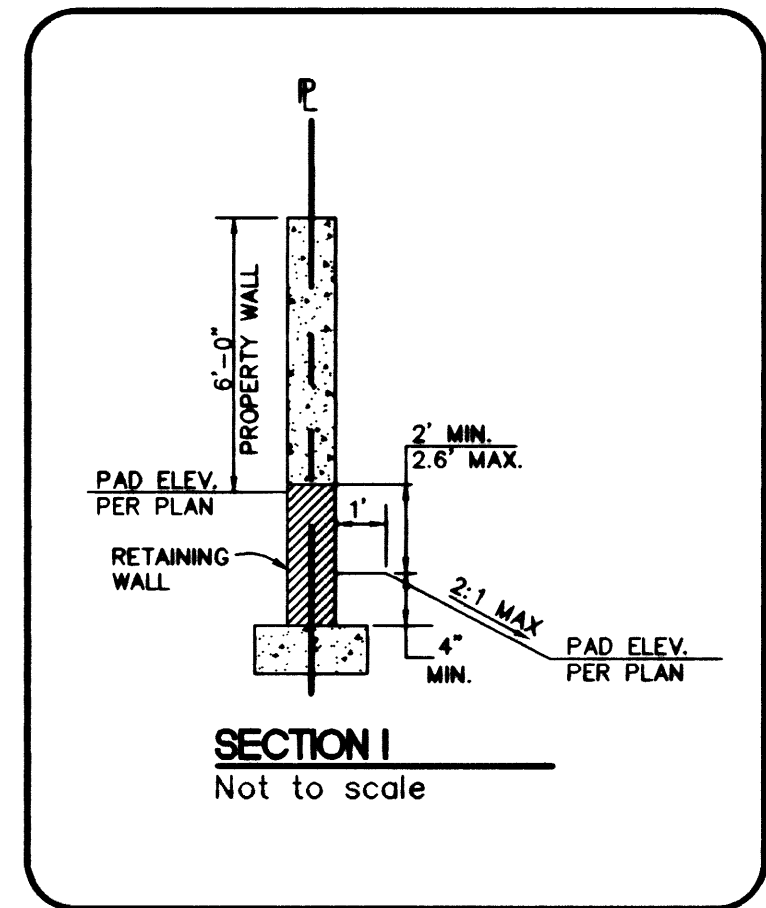
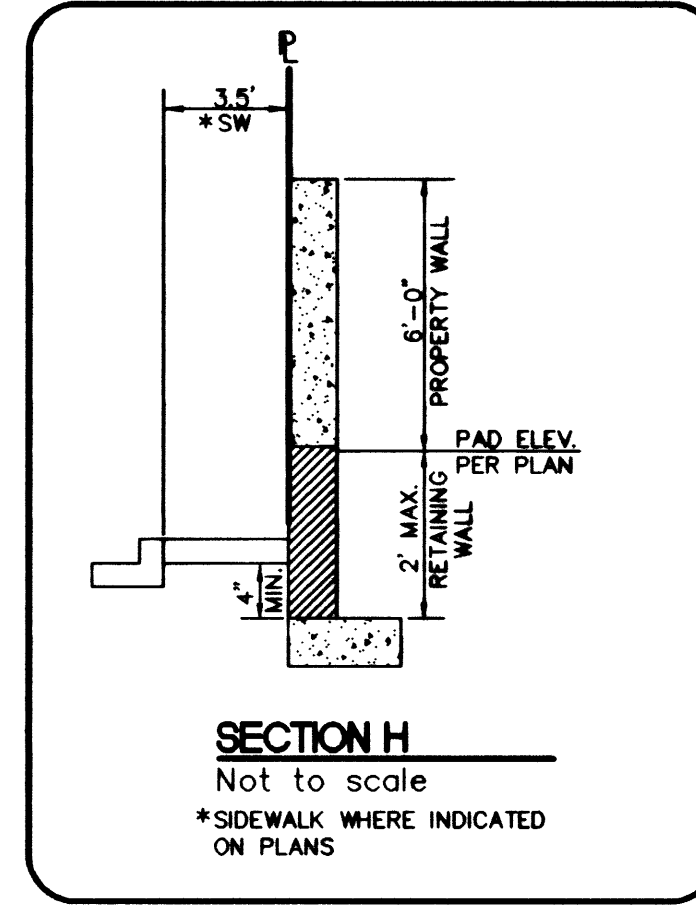
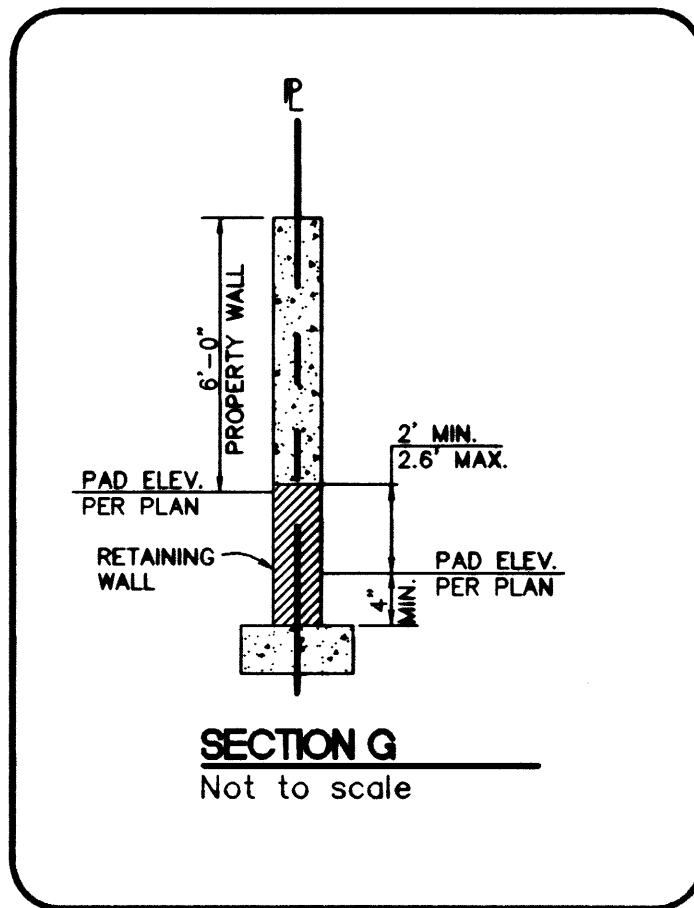
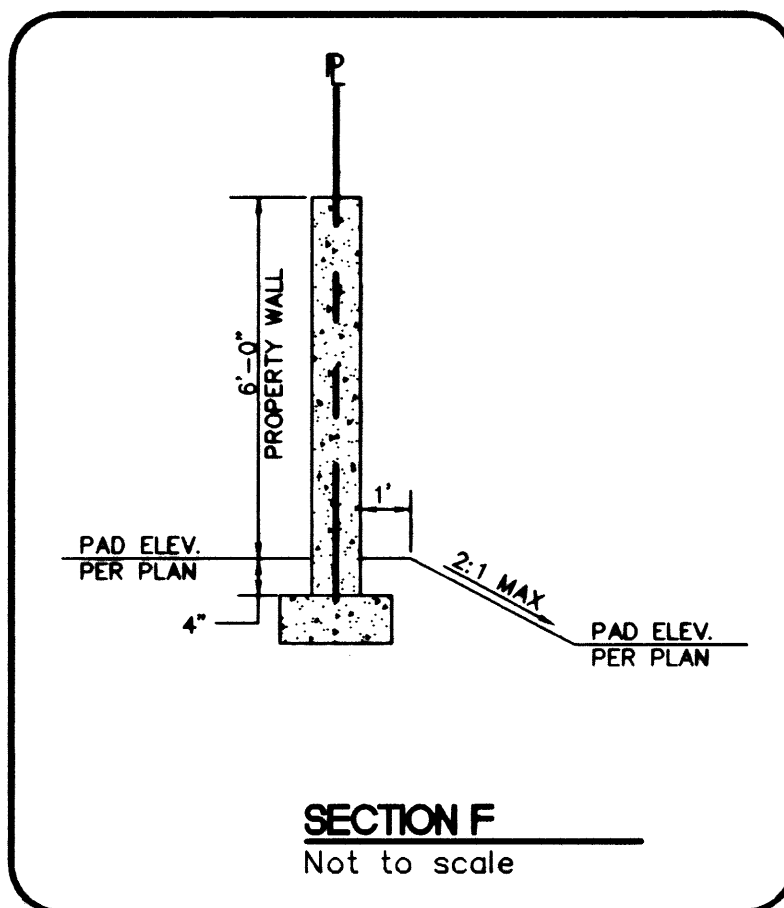
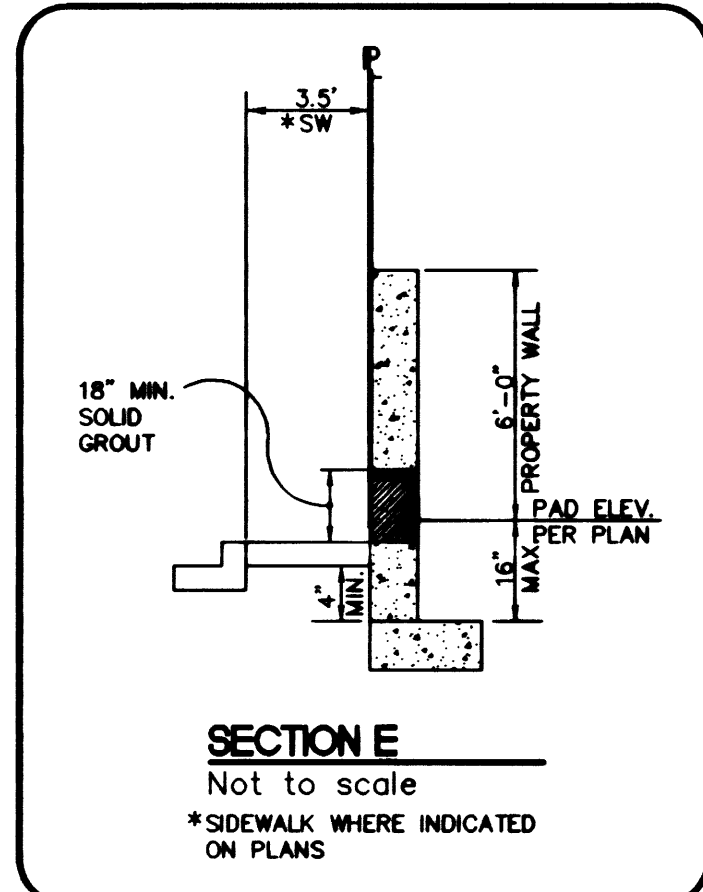
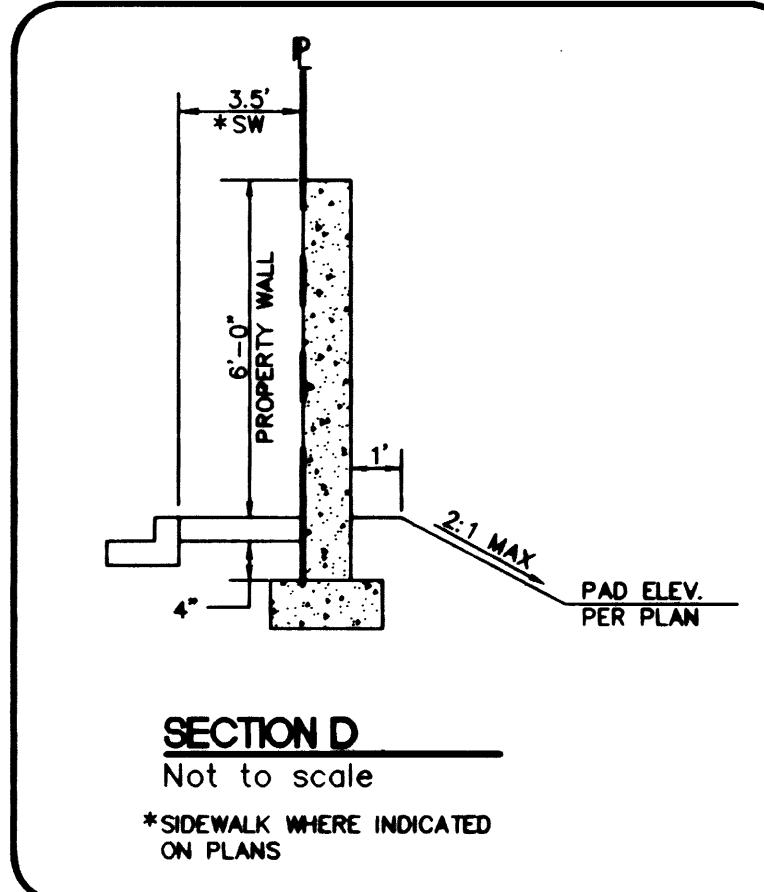
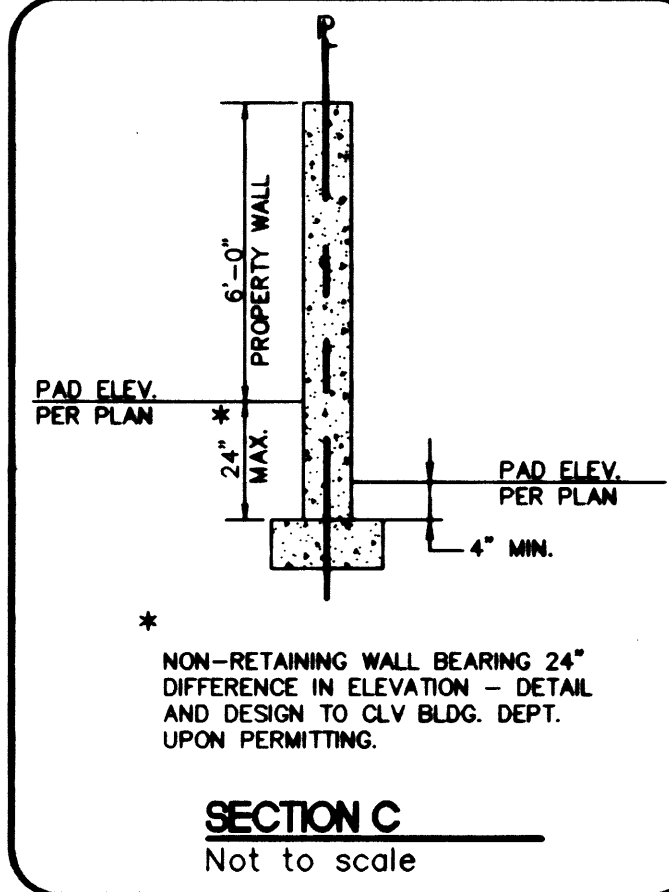
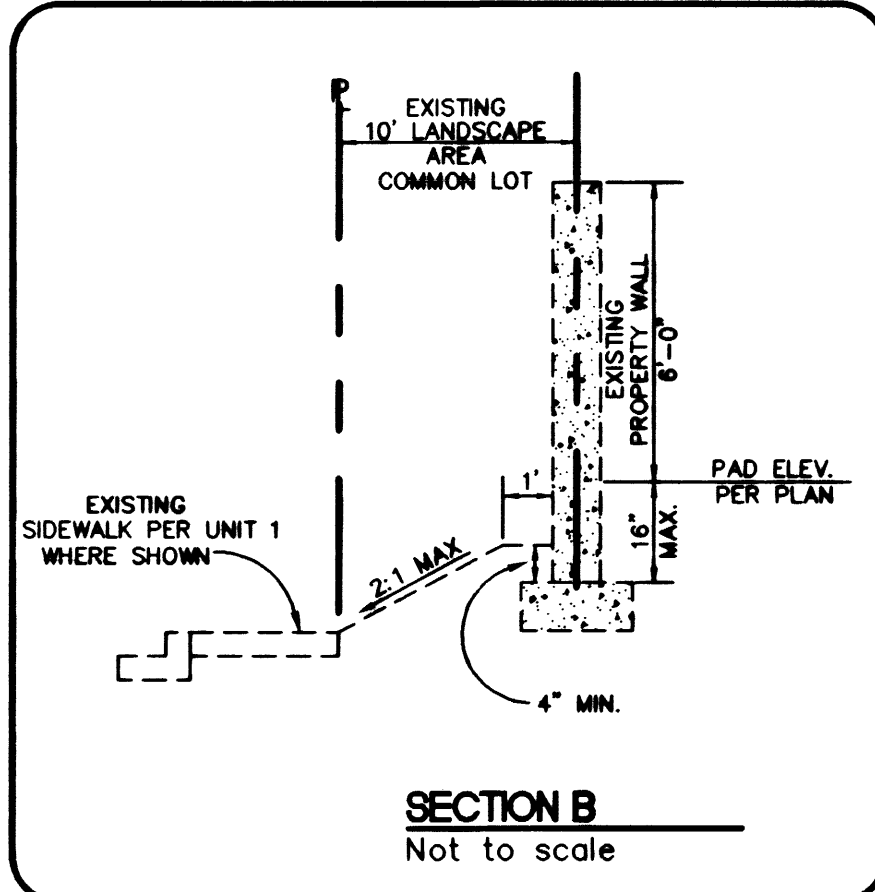
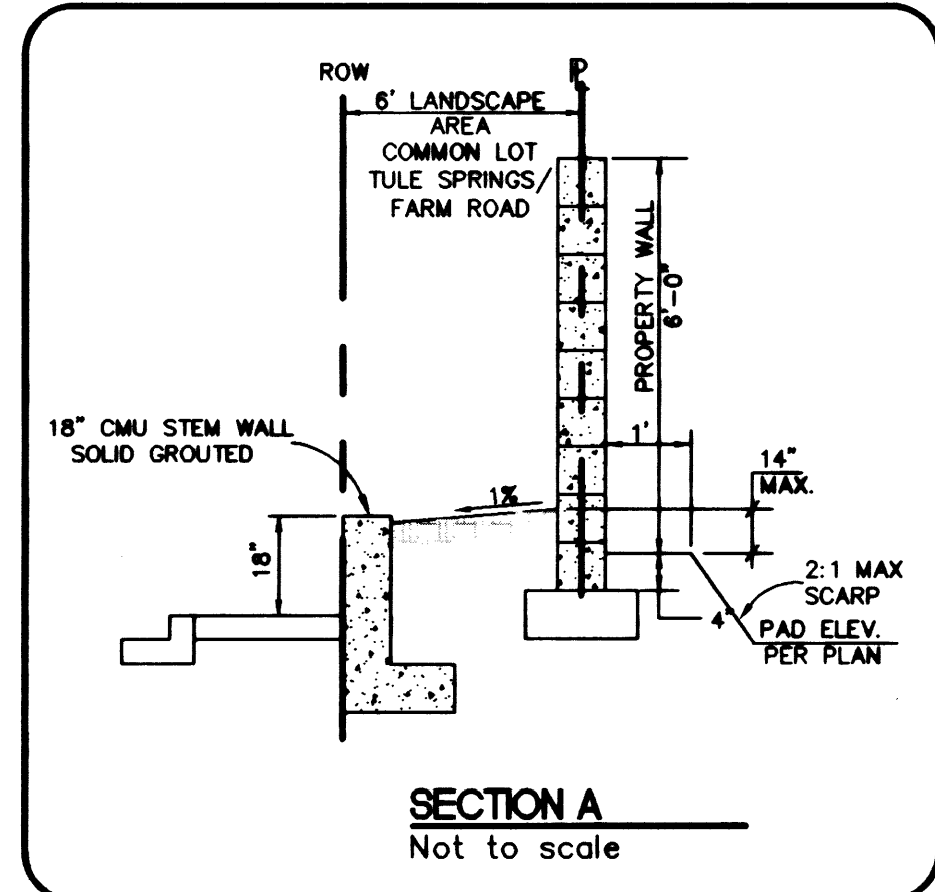
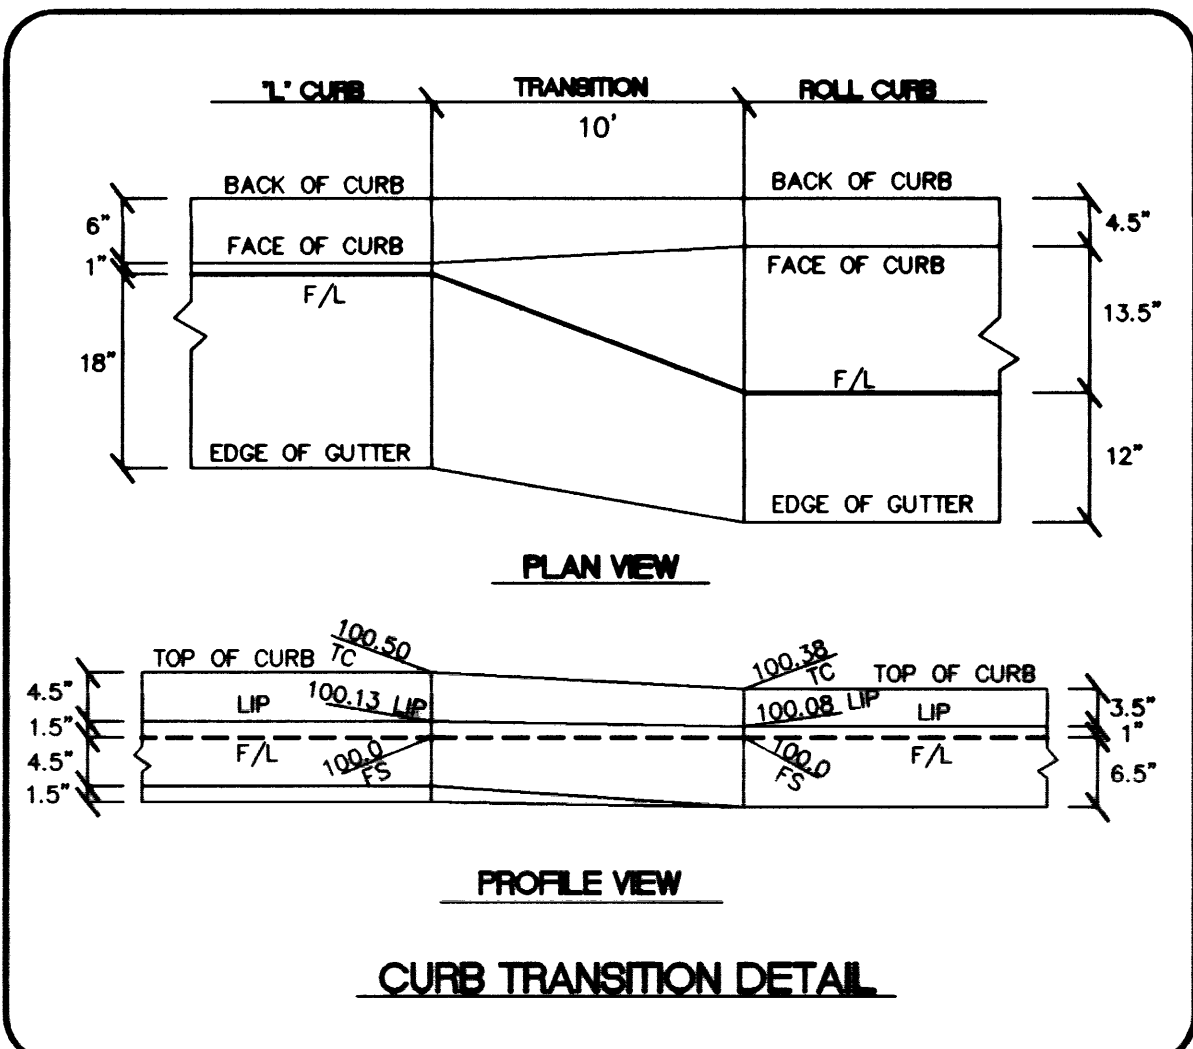
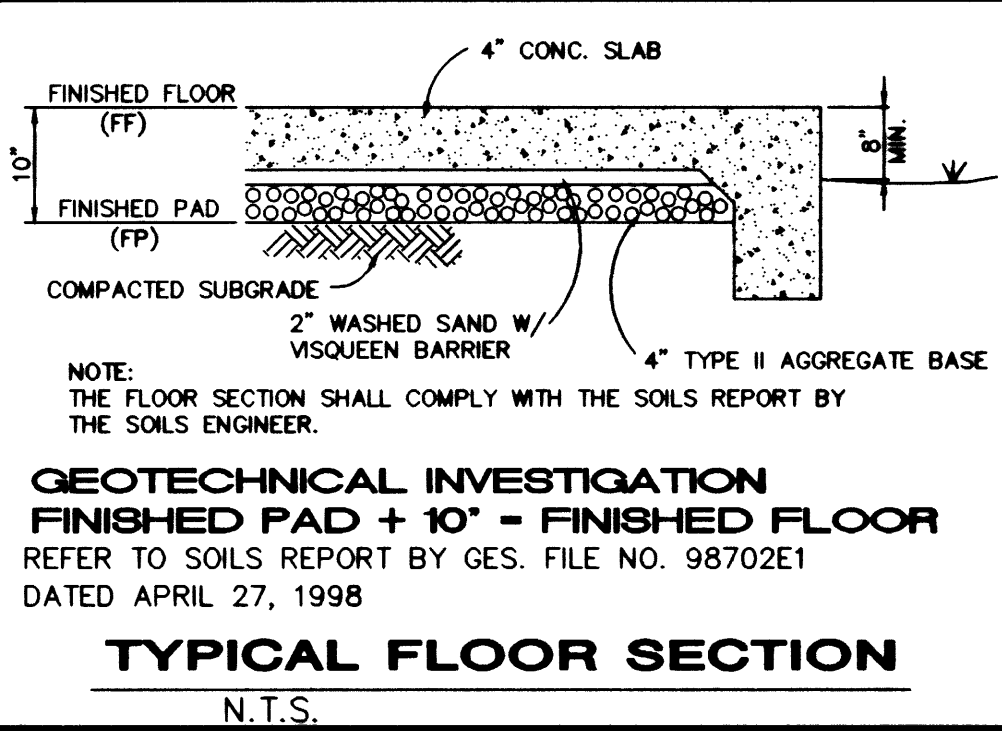
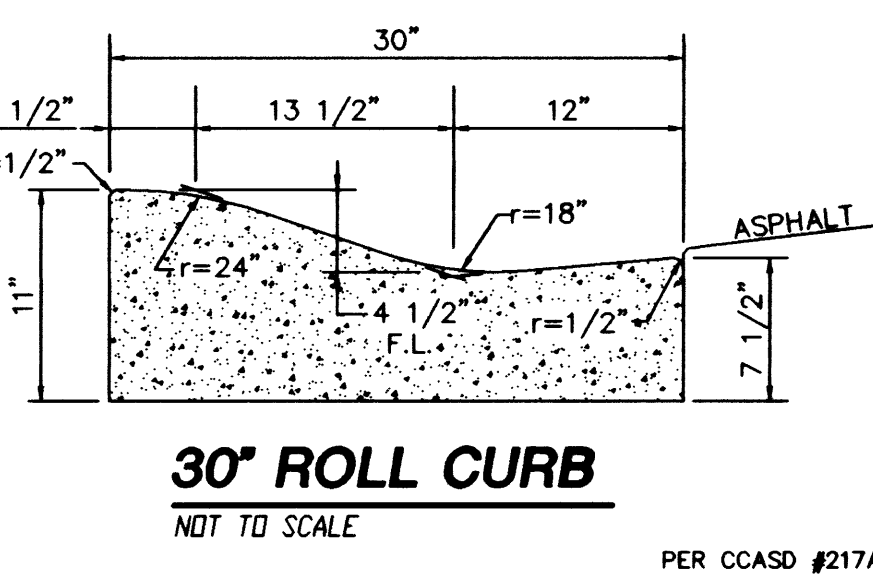
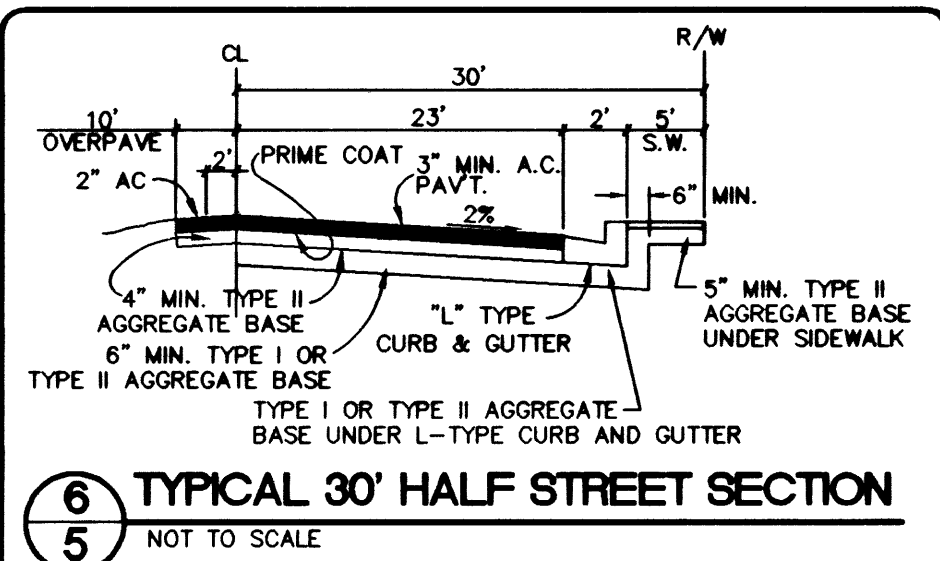
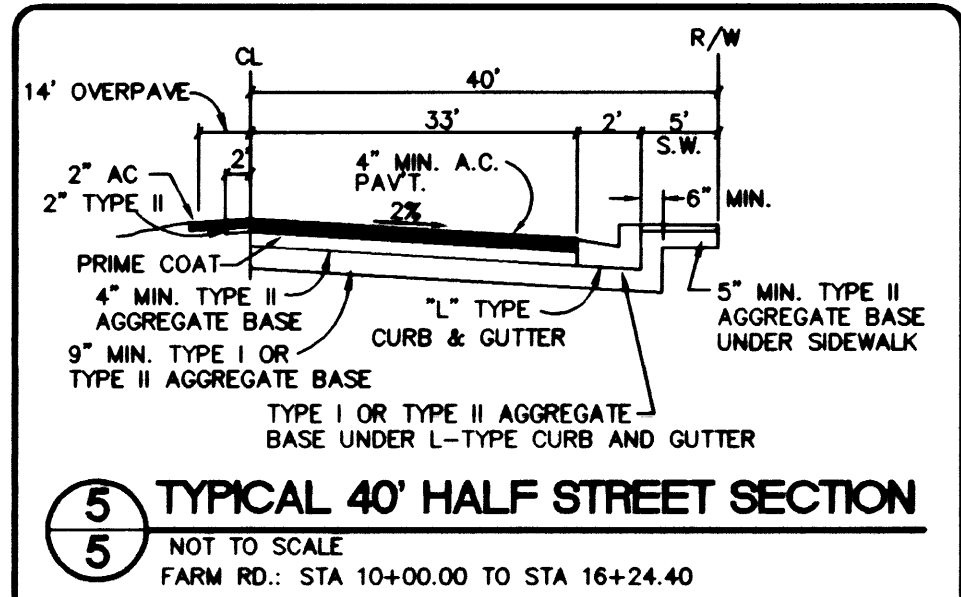


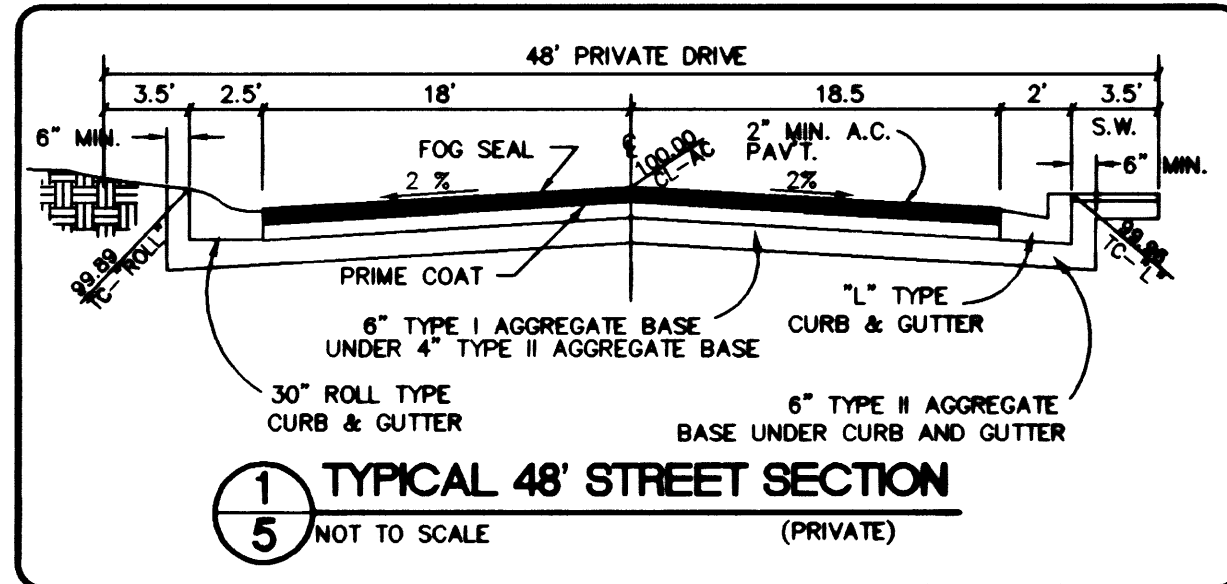

STERLING'S DEVELOPMENT LEGENDARY AMERICAN HOMES		PBS ENGINEERING - PLANNING - SURVEYING - CONSTRUCTION SERVICES	
DETAILS UNIT 1A		APPALOOSA CANYON	
SHEET	6/98	TITLE	SCALE - AS SHOWN
DRAWN BY: RMM	DESIGNED BY: ATB	CHECKED BY: LMF	PROJECT NO: 51580
LISA M. FREESTONE REGISTERED PROFESSIONAL ENGINEER NO. 013671		5/17/99	
5 OF 12 SHEETS DRAWING NO.		1074-4584-1A	