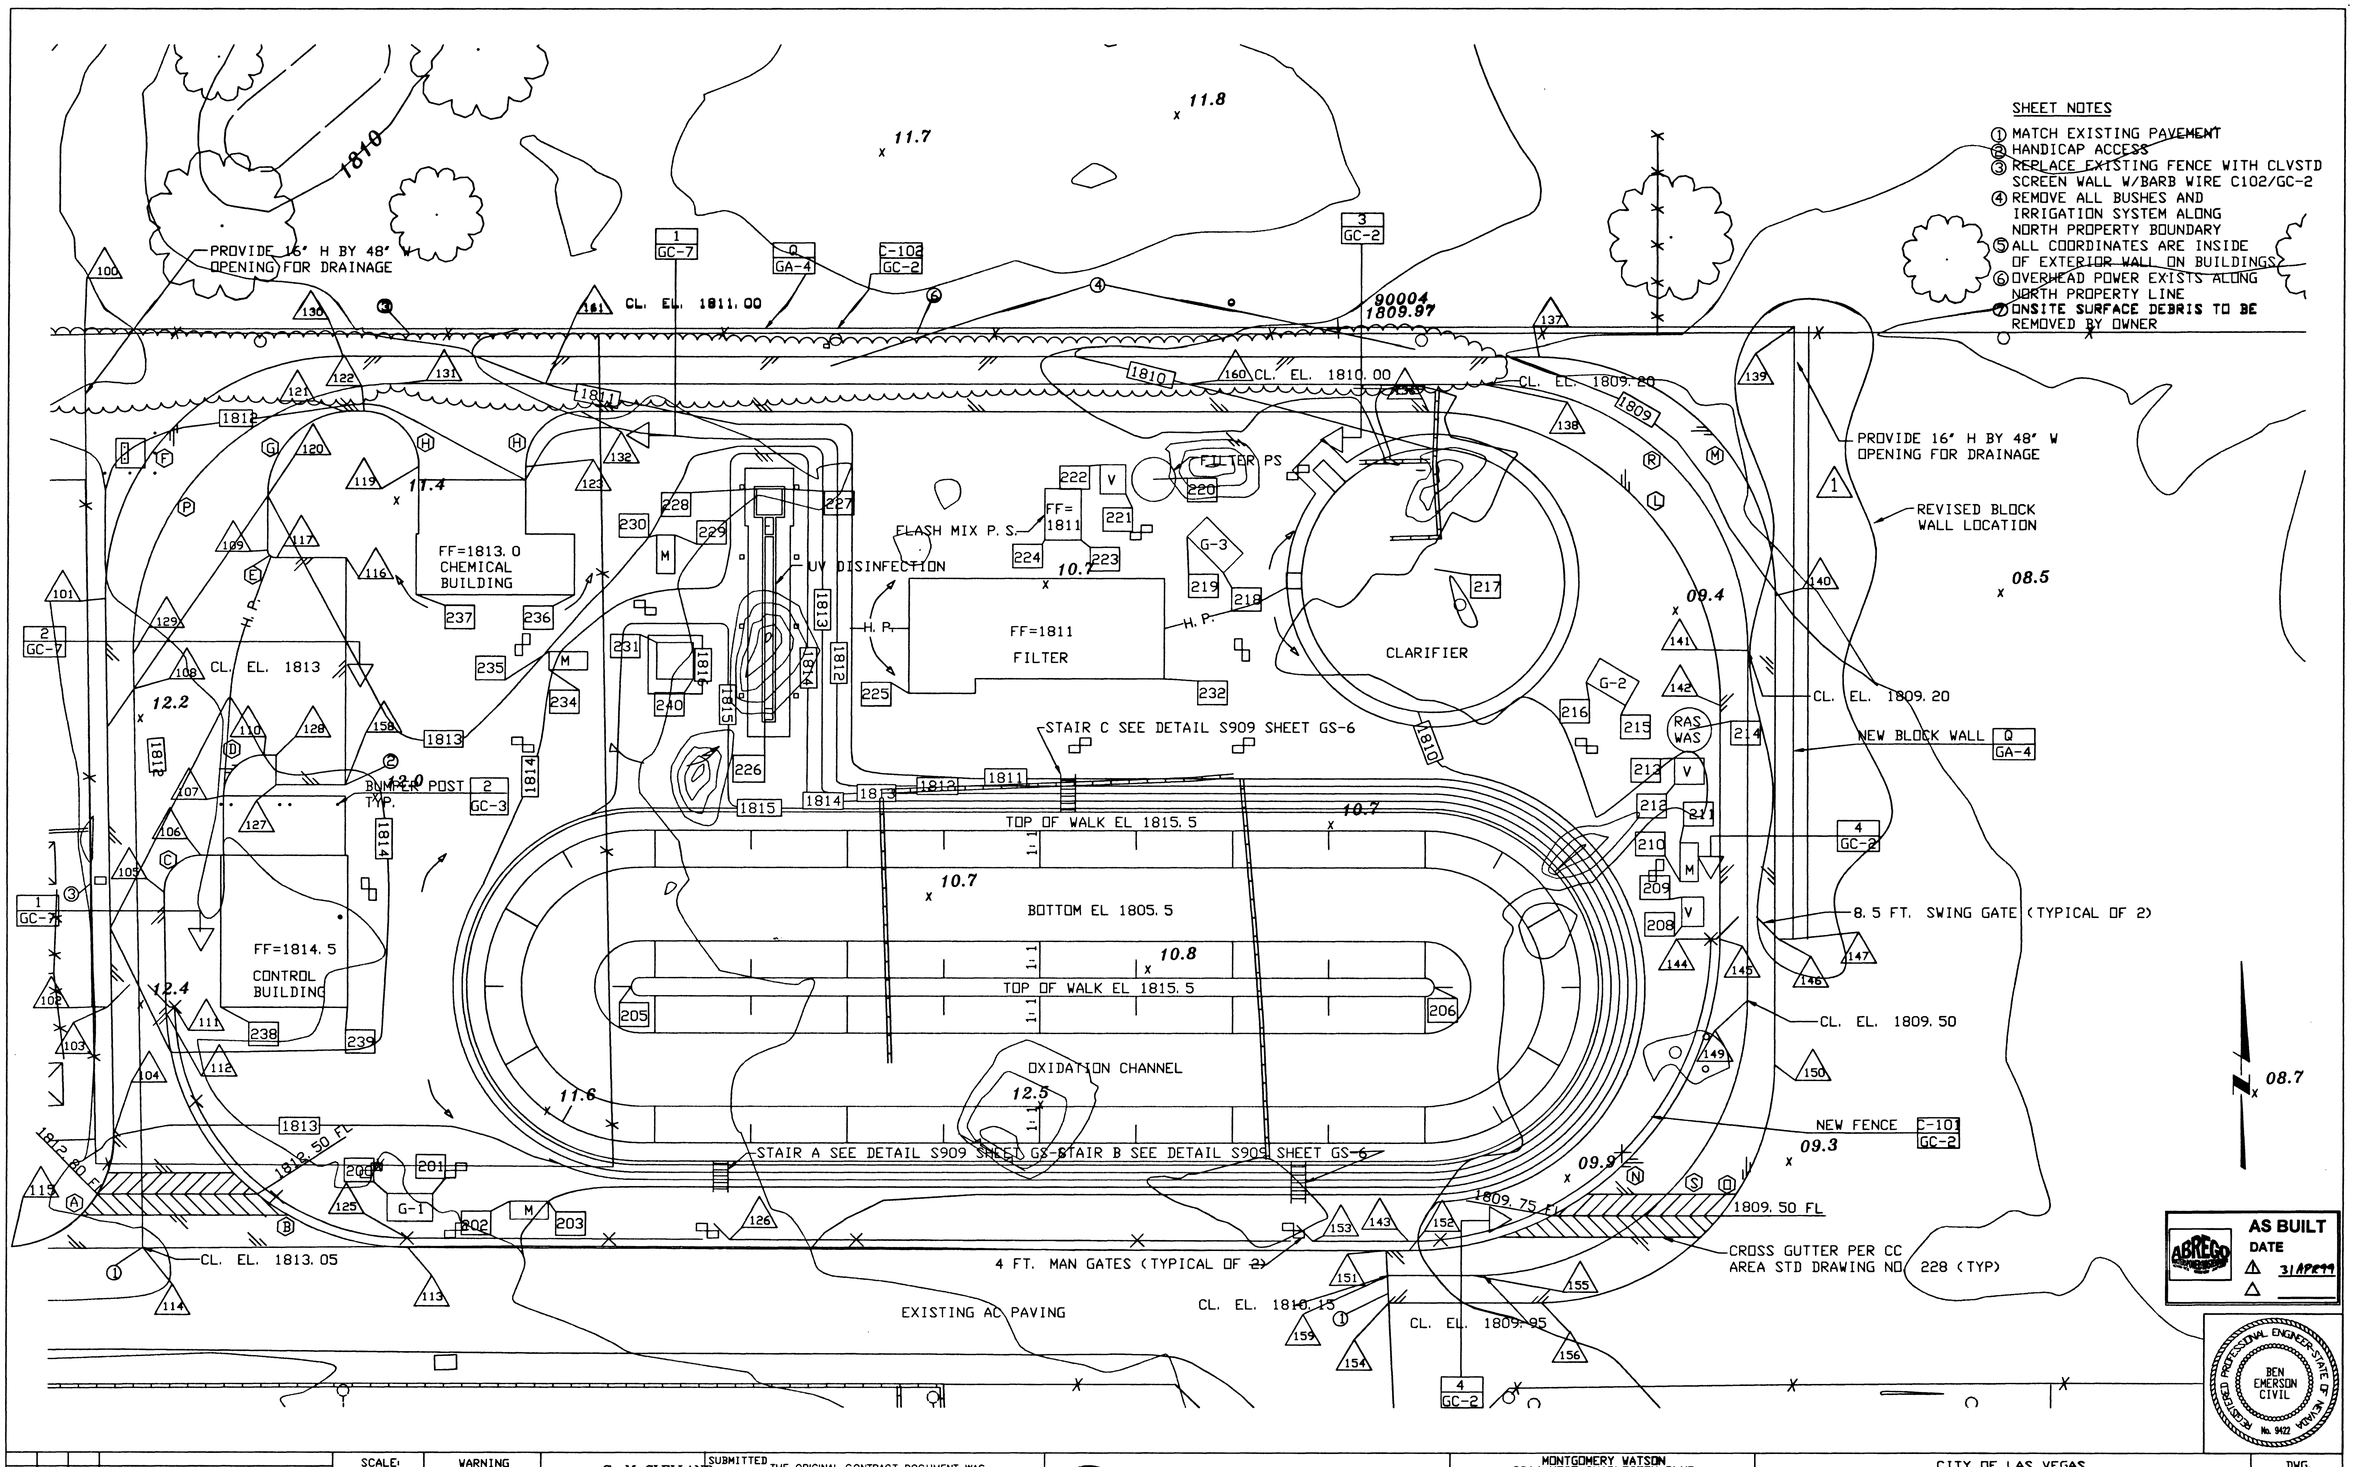

REV	DATE	BY	DESCRIPTION
1	6/7/00	FAO	REVISED BLOCK WALL LOCATION

SCALE: 1"=20'

WARNING: 0 1/2 1 — IF THIS BAR DOES NOT MEASURE 1" THEN DRAWING IS NOT TO SCALE.

DESIGNED S. McCLELLAND
DRAWN S. McCLELLAND
CHECKED B. EMERSON

SUBMITTED: THE ORIGINAL CONTRACT DOCUMENT WAS SIGNED BY BEN EMERSON
PROJECT ENGINEER R. C. E. NO. DATE
RECOMMENDED: THE ORIGINAL CONTRACT DOCUMENT WAS SIGNED BY VICKI J SCARNHORST
MONTGOMERY WATSON R. C. E. NO. DATE

MONTGOMERY WATSON
Las Vegas, Nevada

MONTGOMERY WATSON
3014 WEST CHARLESTON BLVD
LAS VEGAS, NV. 89102-1944
(702) 878-8010

COPYRIGHT © 1996 BY MONTGOMERY WATSON
ALL RIGHTS RESERVED

CITY OF LAS VEGAS
BONANZA/MOJAVE WATER RESOURCE CENTER

GRADING AND PAVING PLAN

513-64

DWG. C-3
SHEET 17 OF SHEETS

JOB No. 1540.0131 FILE No. $$$$$$$$$$directory/filename$$$$$$$$$ DATE/TIME $$$$date$$$$$$time$$

26261