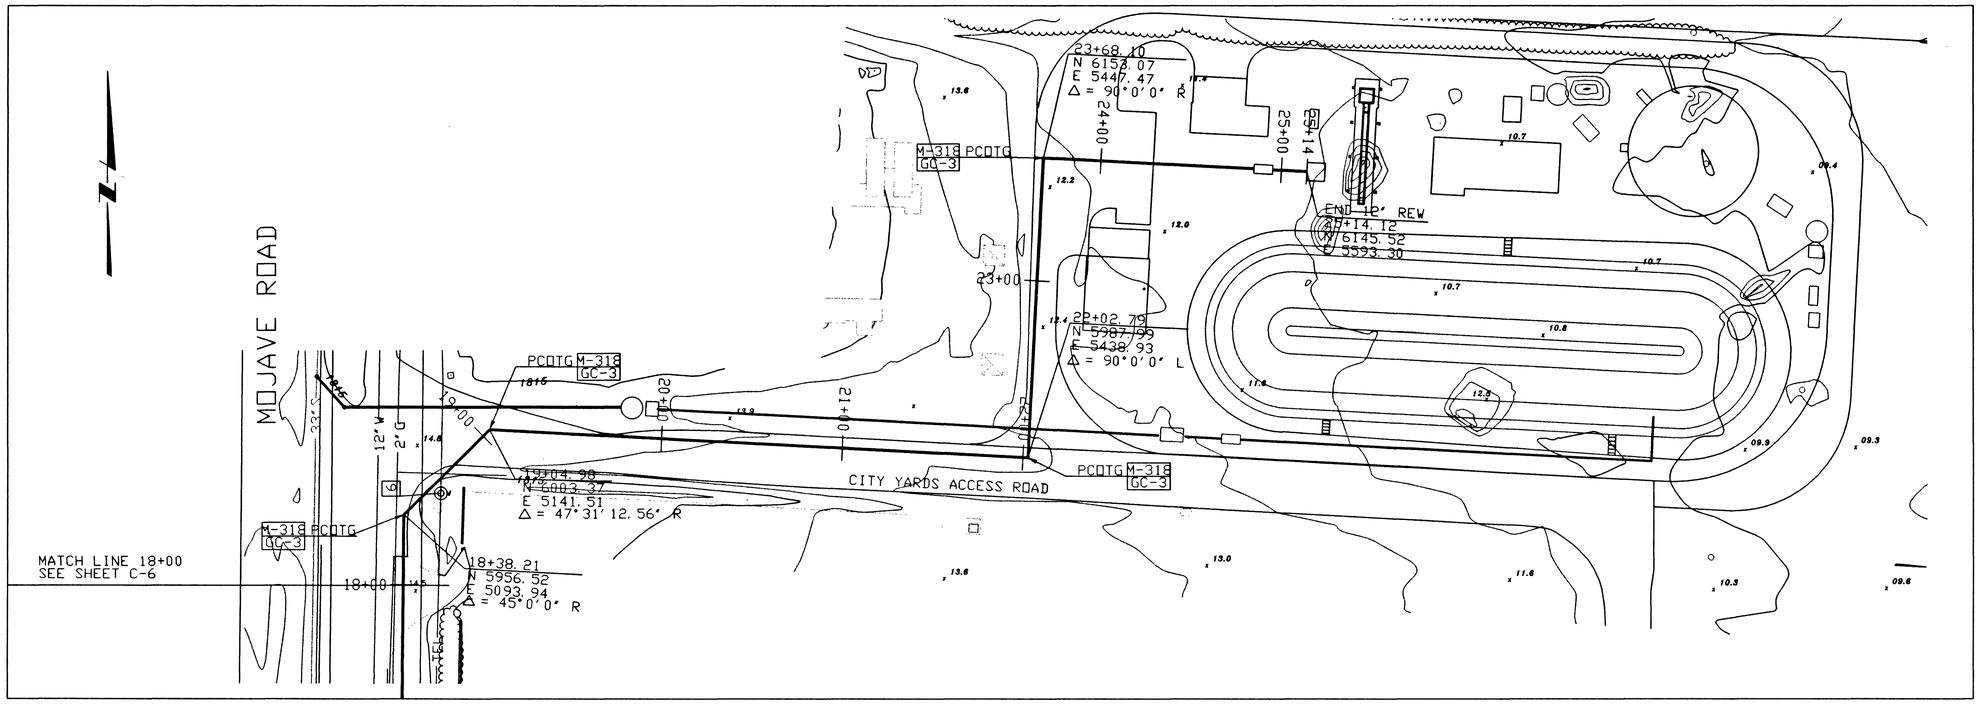

GENERAL NOTES

1. ALL STATIONING IS ALONG THE HORIZONTAL CENTERLINE OF THE NEW PIPELINE.
2. ALL PIPELINE ELEVATIONS ARE INVERT ELEVATIONS UNLESS SHOWN OTHERWISE.
3. PIPELINE SLOPES ARE CALCULATED FROM MANHOLE CENTERLINE. MANHOLE CHANNEL INVERTS SHALL BE TRANSITIONED TO MATCH.
4. UTILITY INVERTS SHOWN HAVE BEEN CALCULATED FROM CLOSEST MANHOLE AND SHALL BE VERIFIED BEFORE CONSTRUCTION.
5. ALL UNDERGROUND UTILITIES SHALL BE SUPPORTED IN ACCORDANCE WITH DETAIL C229/GC-3.
6. FOR PIPE MATERIAL DESCRIPTION, SEE SHEET M-1.

SHEET NOTES

[6] ◎ POTHOLE TELEPHONE LINE

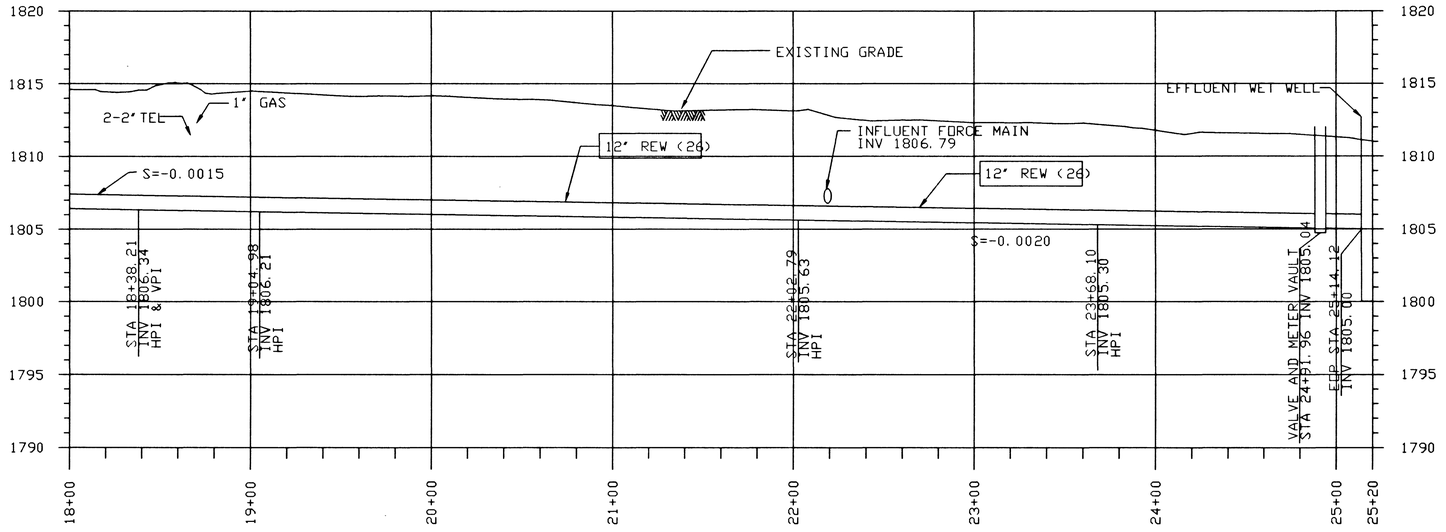

AS BUILT
DATE
⚠ 29APR99
△

BEN EMERSON CIVIL
REGISTERED PROFESSIONAL ENGINEER STATE OF NEVADA No. 9422

REV	DATE	BY	DESCRIPTION

SCALE: HORZ: 1"=40' VERT: 1"=5'

WARNING 0 1/2 1 IF THIS BAR DOES NOT MEASURE 1" THEN DRAWING IS NOT TO SCALE.

DESIGNED S. McCLELLAND
DRAWN S. McCLELLAND
CHECKED B. EMERSON

SUBMITTED THE ORIGINAL CONTRACT DOCUMENT WAS SIGNED BY BEN EMERSON
PROJECT ENGINEER R. C. E. NO. DATE
RECOMMENDED THE ORIGINAL CONTRACT DOCUMENT WAS SIGNED BY VICKI J SCARNHORST
MONTGOMERY WATSON R. C. E. NO. DATE

MONTGOMERY WATSON
Las Vegas, Nevada

MONTGOMERY WATSON
3014 WEST CHARLESTON BLVD
LAS VEGAS, NV. 89102-1944
(702) 878-8010

COPYRIGHT © 1996 BY MONTGOMERY WATSON
ALL RIGHTS RESERVED

CITY OF LAS VEGAS
BONANZA/MOJAVE WATER RESOURCE CENTER

DESERT PINES RECLAIMED WATER LINE
PLAN AND PROFILE STA 18+00 TO STA 25+20

DWG. C-7
SHEET 11 OF 513-64 SHEETS

JOB No. 1540.0131 FILE No. $$$$$$$$$$directory/filename$$$$$$$$$
DATE/TIME $$$$date$$$$$$time$$

26265 26265