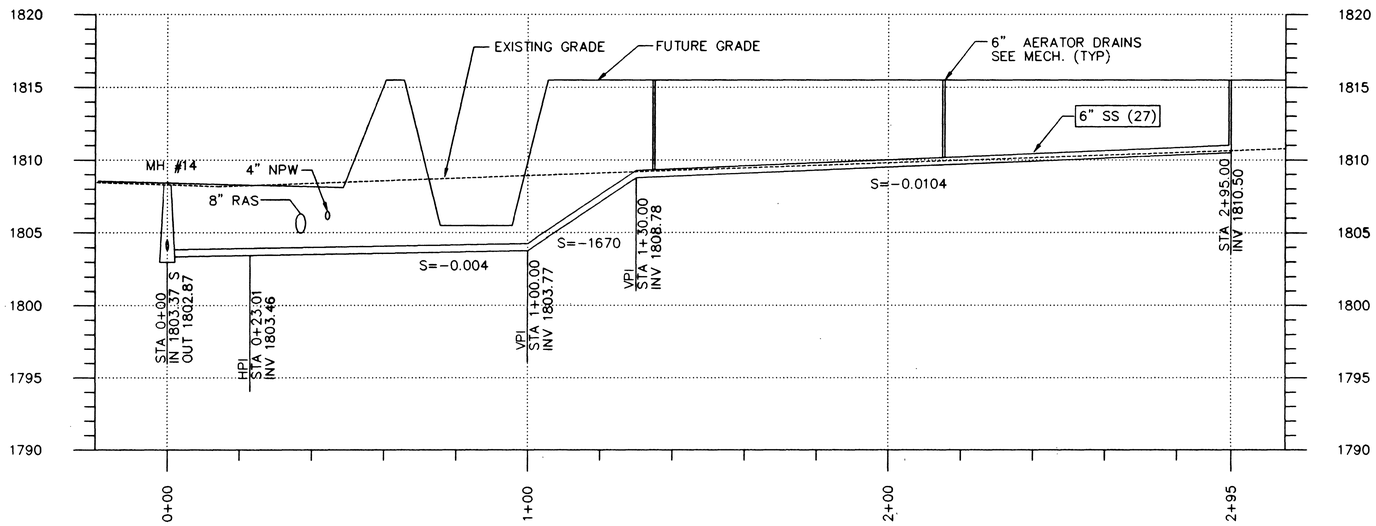

OXIDATION CHANNEL DRAIN CENTER
PROFILE NO. 5

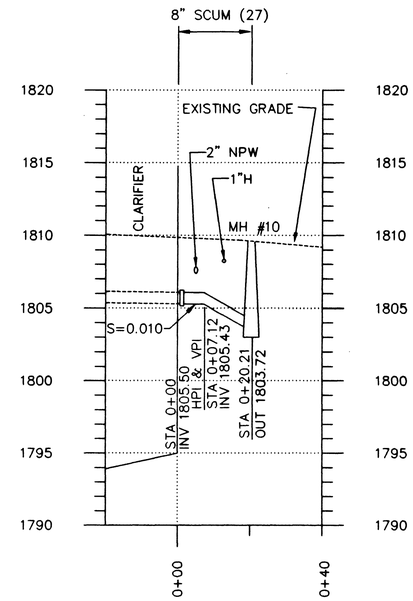

SCUM DRAIN
PROFILE NO. 7

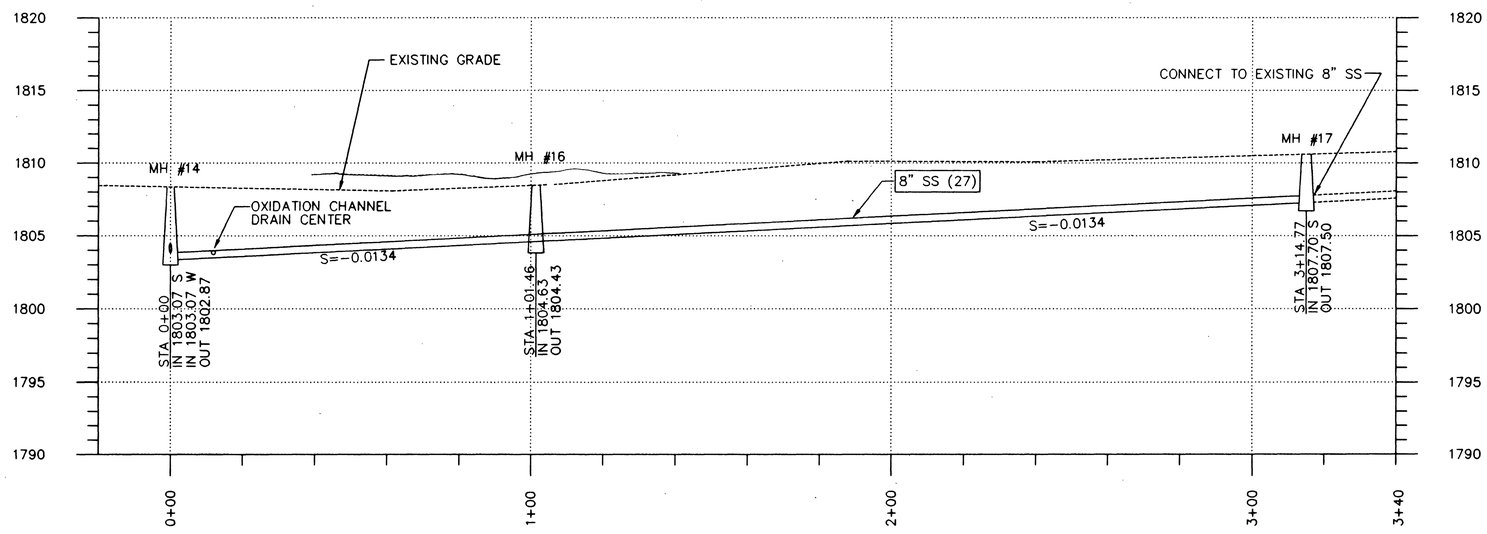

SEWER RELOCATION
PROFILE NO. 16

AS BUILT
DATE
△ 9APR99
△

ABREGO WATER REUSE SYSTEM

RECORDED PROFESSIONAL ENGINEER STATE OF NEVADA
BEN EMERSON CIVIL
No. 9422

REV	DATE	BY	DESCRIPTION

SCALE:
HORZ 1"=20'
VERT 1"=5'

WARNING
0 1/2 1
IF THIS BAR DOES NOT MEASURE 1" THEN DRAWING IS NOT TO SCALE.

DESIGNED S. McCLELLAND
DRAWN S. McCLELLAND
CHECKED B. EMERSON

SUBMITTED
PROJECT ENGINEER R. C. E. NO. DATE
RECOMMENDED
MONTGOMERY WATSON R. C. E. NO. DATE

MONTGOMERY WATSON
Las Vegas, Nevada

MONTGOMERY WATSON
3014 WEST CHARLESTON BLVD
LAS VEGAS, NV 89102-1944
(702) 878-8010

COPYRIGHT © 1996 BY MONTGOMERY WATSON
ALL RIGHTS RESERVED

CITY OF LAS VEGAS
BONANZA/MOJAVE WATER RESOURCE CENTER

YARD PIPING PROFILES - 4

513-64

DWG. C-14
SHEET 28 OF SHEETS

JOB No. 1540.0131 FILE No. $$$$$$$$$directory/filename$$$$$$$$$$ DATE/TIME $$$$date$$$$ $$$time$$

262 72