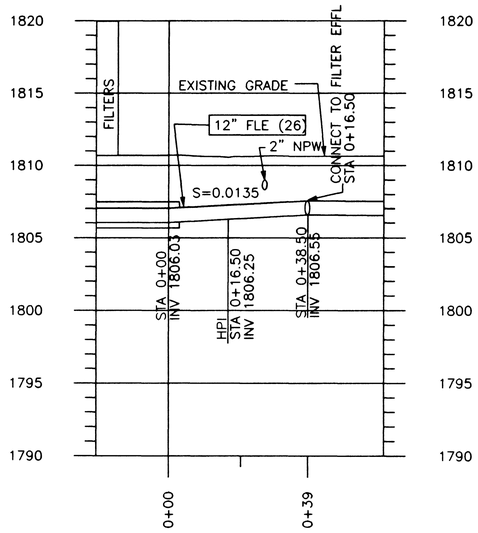

FILTER BYPASS
PROFILE NO. 11

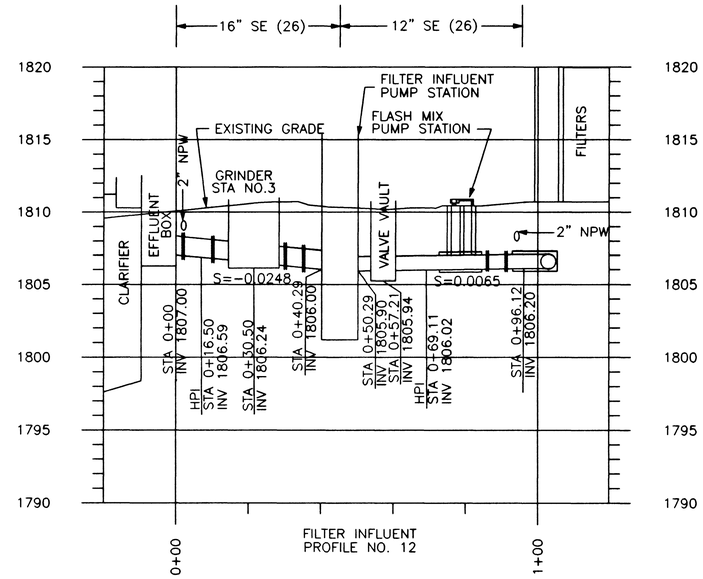

FILTER INFLUENT
PROFILE NO. 12

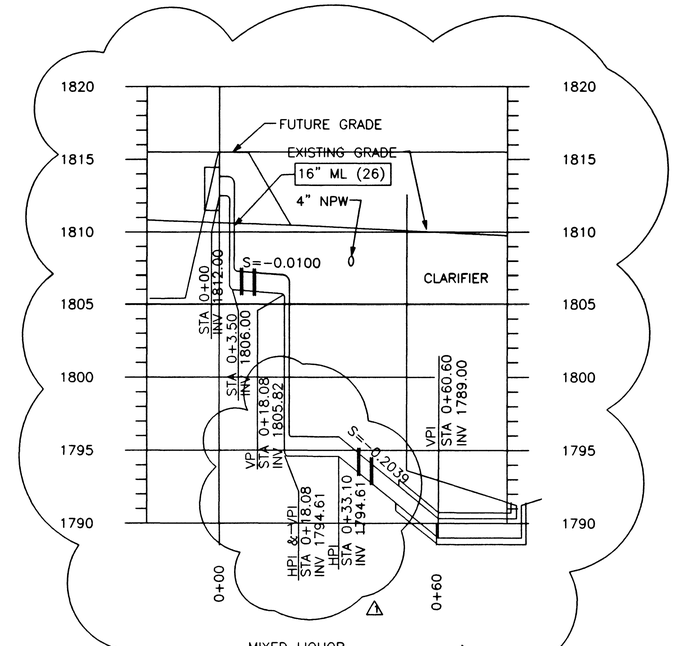

MIXED LIQUOR
PROFILE NO. 13

2 REVISED SEE FO#009 C-4-1

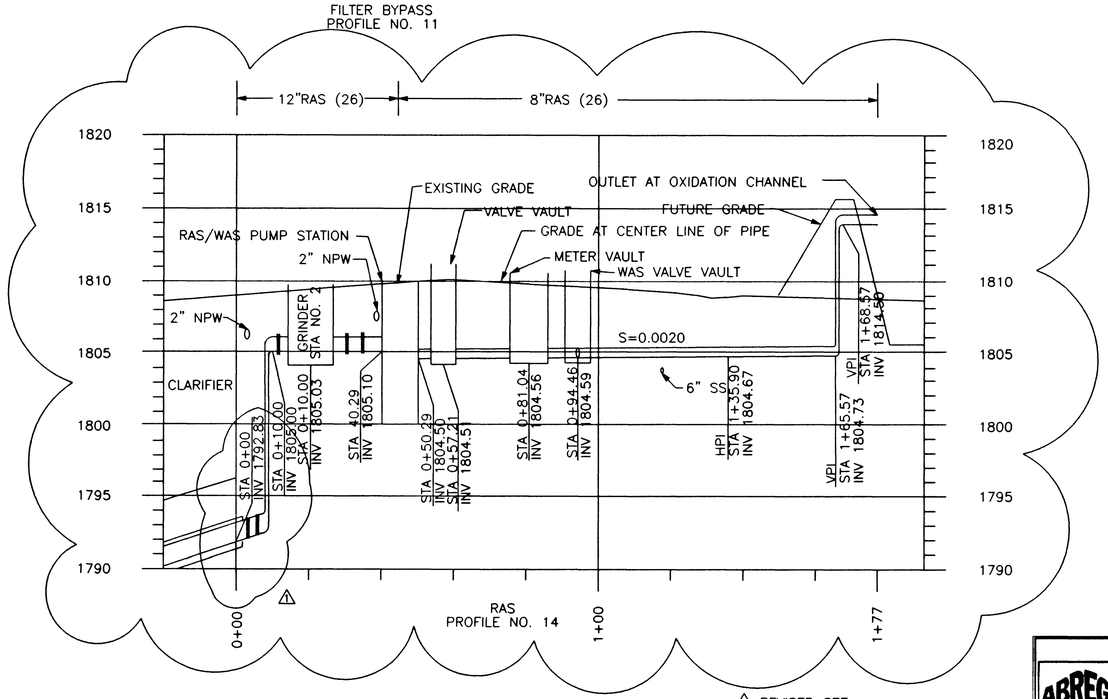

RAS
PROFILE NO. 14

1 REVISED SEE FO#008 C-4-1

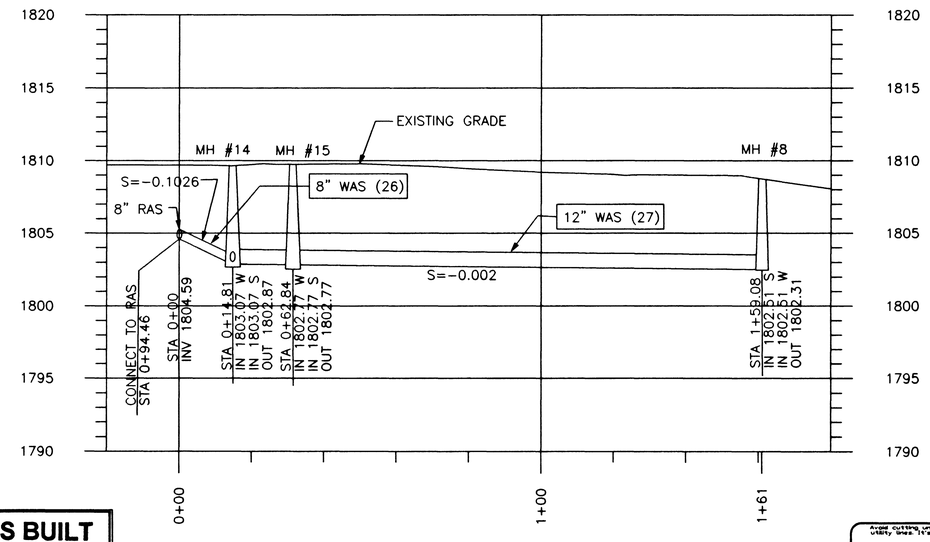

WAS
PROFILE NO. 15

AS BUILT
DATE
0 9 APR 99
1

Call before you Dig 1-800-227-2600

REGISTERED PROFESSIONAL ENGINEER STATE OF NEVADA BEN EMERSON CIVIL No. 9422

THE ORIGINAL CONTRACT DOCUMENT WAS SEALED AND SIGNED BY BEN EMERSON

REV	DATE	BY	DESCRIPTION
1	4/98	SWM	RFI NO.S 32&33 REV. INVERT

SCALE: HORZ 1"=20' VERT 1"=5'

WARNING 0 1/2 1 — IF THIS BAR DOES NOT MEASURE 1" THEN DRAWING IS NOT TO SCALE.

DESIGNED S. McCLELLAND
DRAWN S. McCLELLAND
CHECKED B. EMERSON

SUBMITTED THE ORIGINAL CONTRACT DOCUMENT WAS SIGNED BY BEN EMERSON
PROJECT ENGINEER R. C. E. NO. DATE
RECOMMENDED THE ORIGINAL CONTRACT DOCUMENT WAS SIGNED BY VICKI J SCARNHORST
MONTGOMERY WATSON R. C. E. NO. DATE

MONTGOMERY WATSON
Las Vegas, Nevada

MONTGOMERY WATSON
3014 WEST CHARLESTON BLVD
LAS VEGAS, NV. 89102-1944
(702) 878-8010

COPYRIGHT © 1997 BY MONTGOMERY WATSON
ALL RIGHTS RESERVED

CITY OF LAS VEGAS
BONANZA/MOJAVE WATER RESOURCE CENTER
YARD PIPING PROFILES - 3

DWG. C-13
513-64

JOB No. 1540.0131 FILE No. $$$$$$$$$directory/filename$$$$$$$$$$ DATE/TIME $$$$date$$$$ $$$$time$$

26270