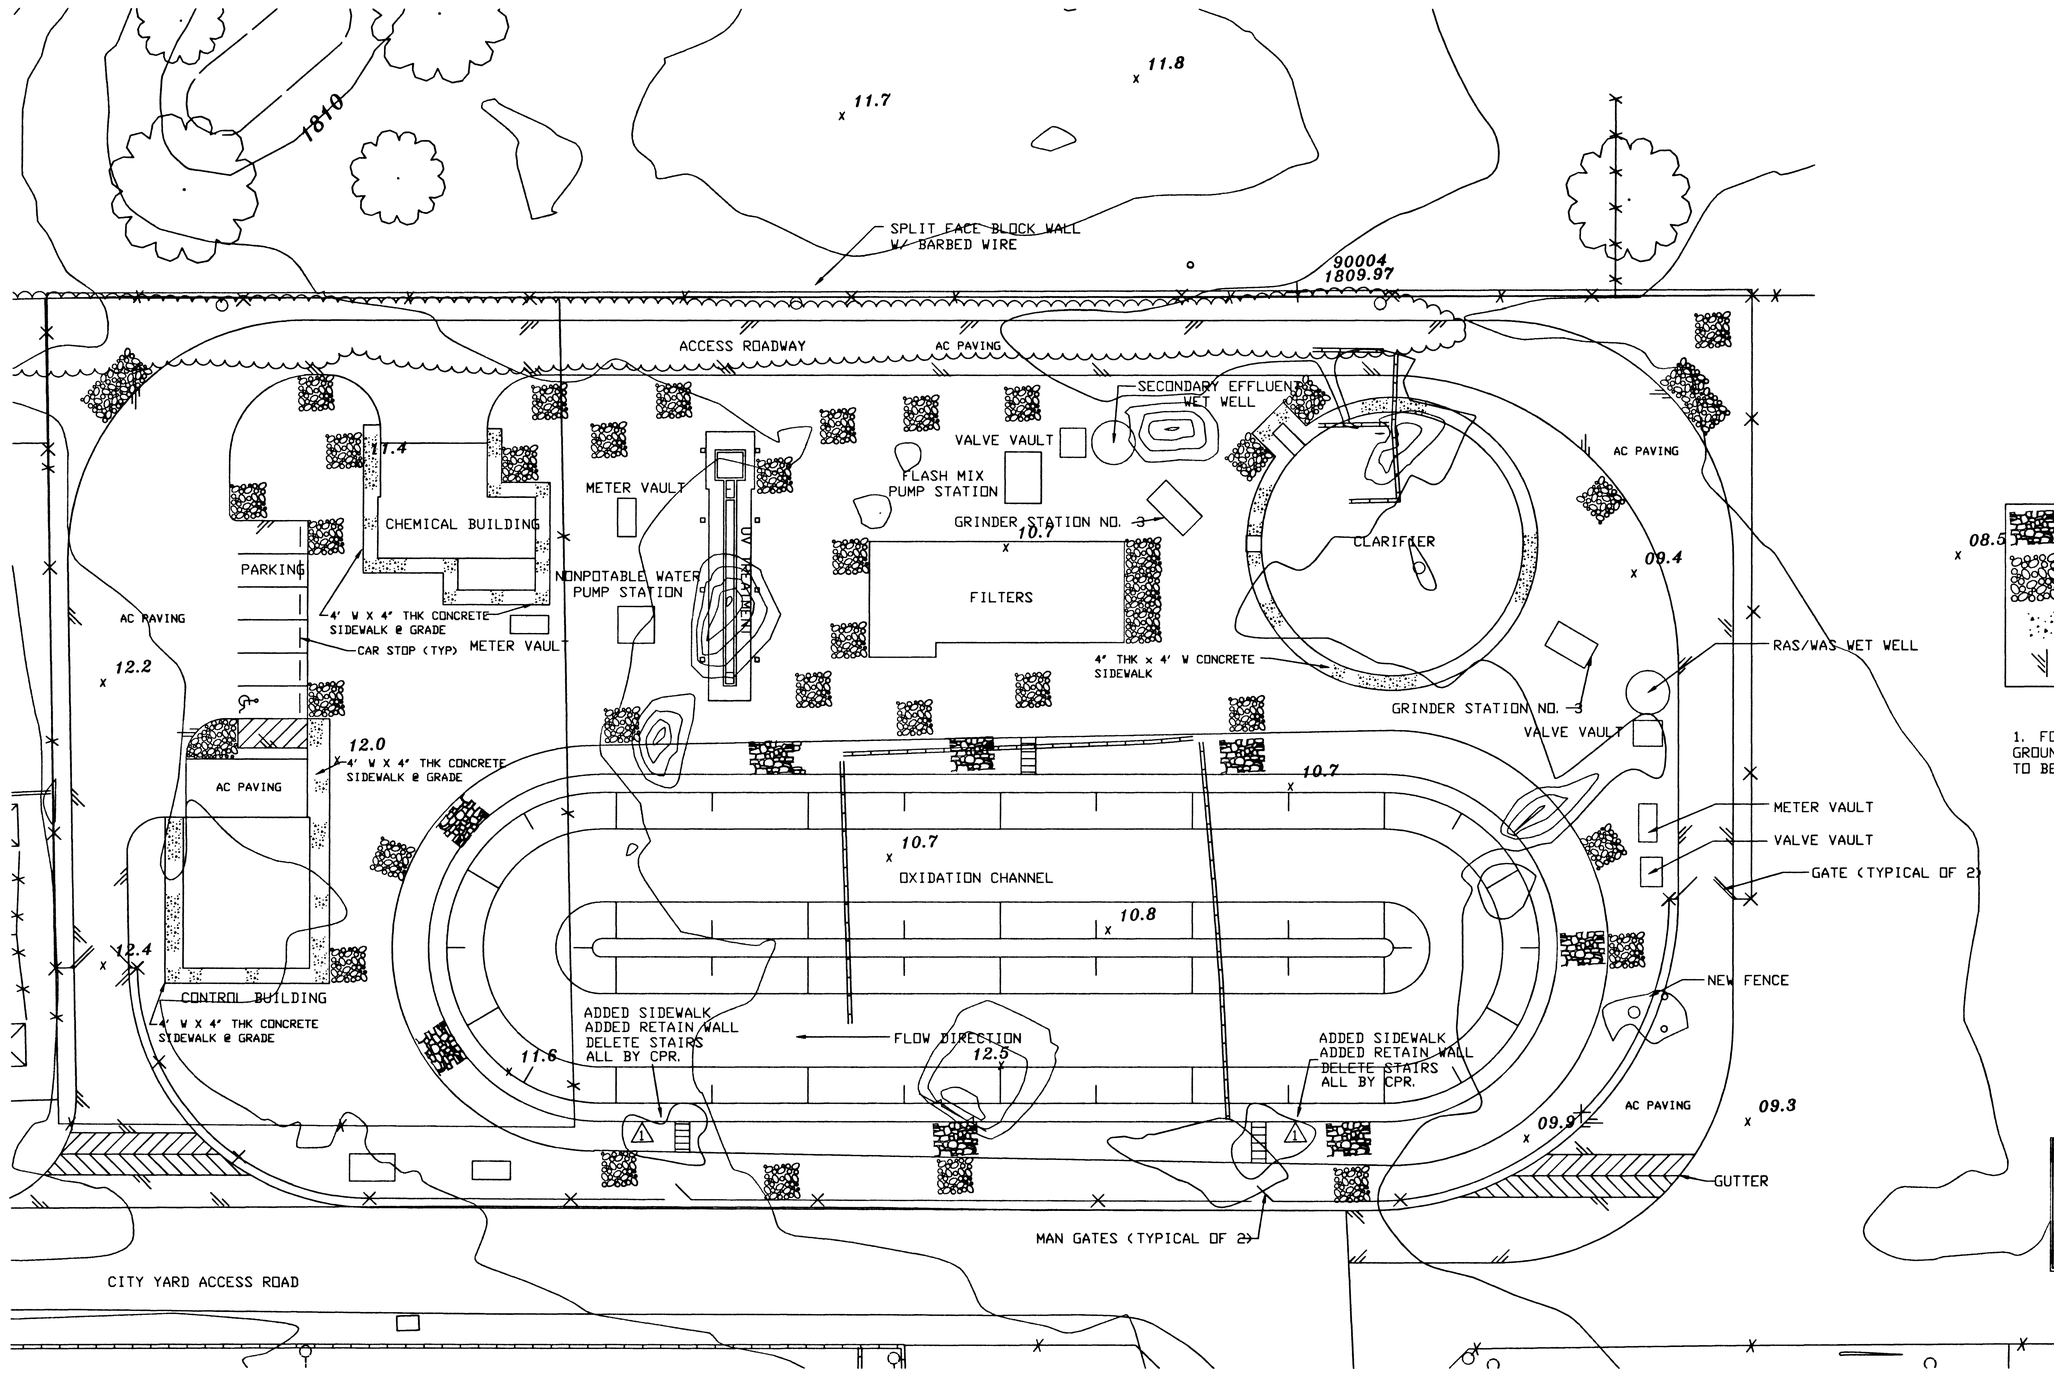


## LEGEND

- 1'-3' | D QUARTZO SANDSTONE
- 2" THK X 3/8" D CRUSHED DECOMPOSED GRANITE
- CONCRETE SIDEWALK
- EDGE OF AC PAVING

SHEET NOTES:

1. FOLLOWING INSTALLATION OF GROUND COVER, SURFLAN HERBICIDE TO BE APPLIED.

**AS BUILT**
DATE
9 APR 99

REGISTERED PROFESSIONAL ENGINEER STATE OF NEVADA
BEN EMERSON CIVIL
No. 9422

| REV | DATE | BY | DESCRIPTION |
|---|---|---|---|
| 1 | | | DELETE STAIRS |

SCALE: 1"=20'

WARNING: 0 1/2 1 — IF THIS BAR DOES NOT MEASURE 1" THEN DRAWING IS NOT TO SCALE.

DESIGNED S. McCLELLAND
DRAWN S. McCLELLAND
CHECKED B. EMERSON

SUBMITTED THE ORIGINAL CONTRACT DOCUMENT WAS SIGNED BY BEN EMERSON
PROJECT ENGINEER R. C. E. NO. DATE
RECOMMENDED THE ORIGINAL CONTRACT DOCUMENT WAS SIGNED BY VICKI J SCARNHORST
MONTGOMERY WATSON R. C. E. NO. DATE

**MONTGOMERY WATSON**
Las Vegas, Nevada

MONTGOMERY WATSON
3014 WEST CHARLESTON BLVD
LAS VEGAS, NV. 89102-1944
(702) 878-8010

COPYRIGHT © 1996 BY MONTGOMERY WATSON
ALL RIGHTS RESERVED

CITY OF LAS VEGAS
BONANZA/MOJAVE WATER RESOURCE CENTER

SURFACE TREATMENT

513-64

DWG. C-15
SHEET 29 OF SHEETS

JOB No. 1540.0131 FILE No. $$$$$$$$$$directory/filename$$$$$$$$$$ DATE/TIME $$$$$date$$$$$time$$

26273