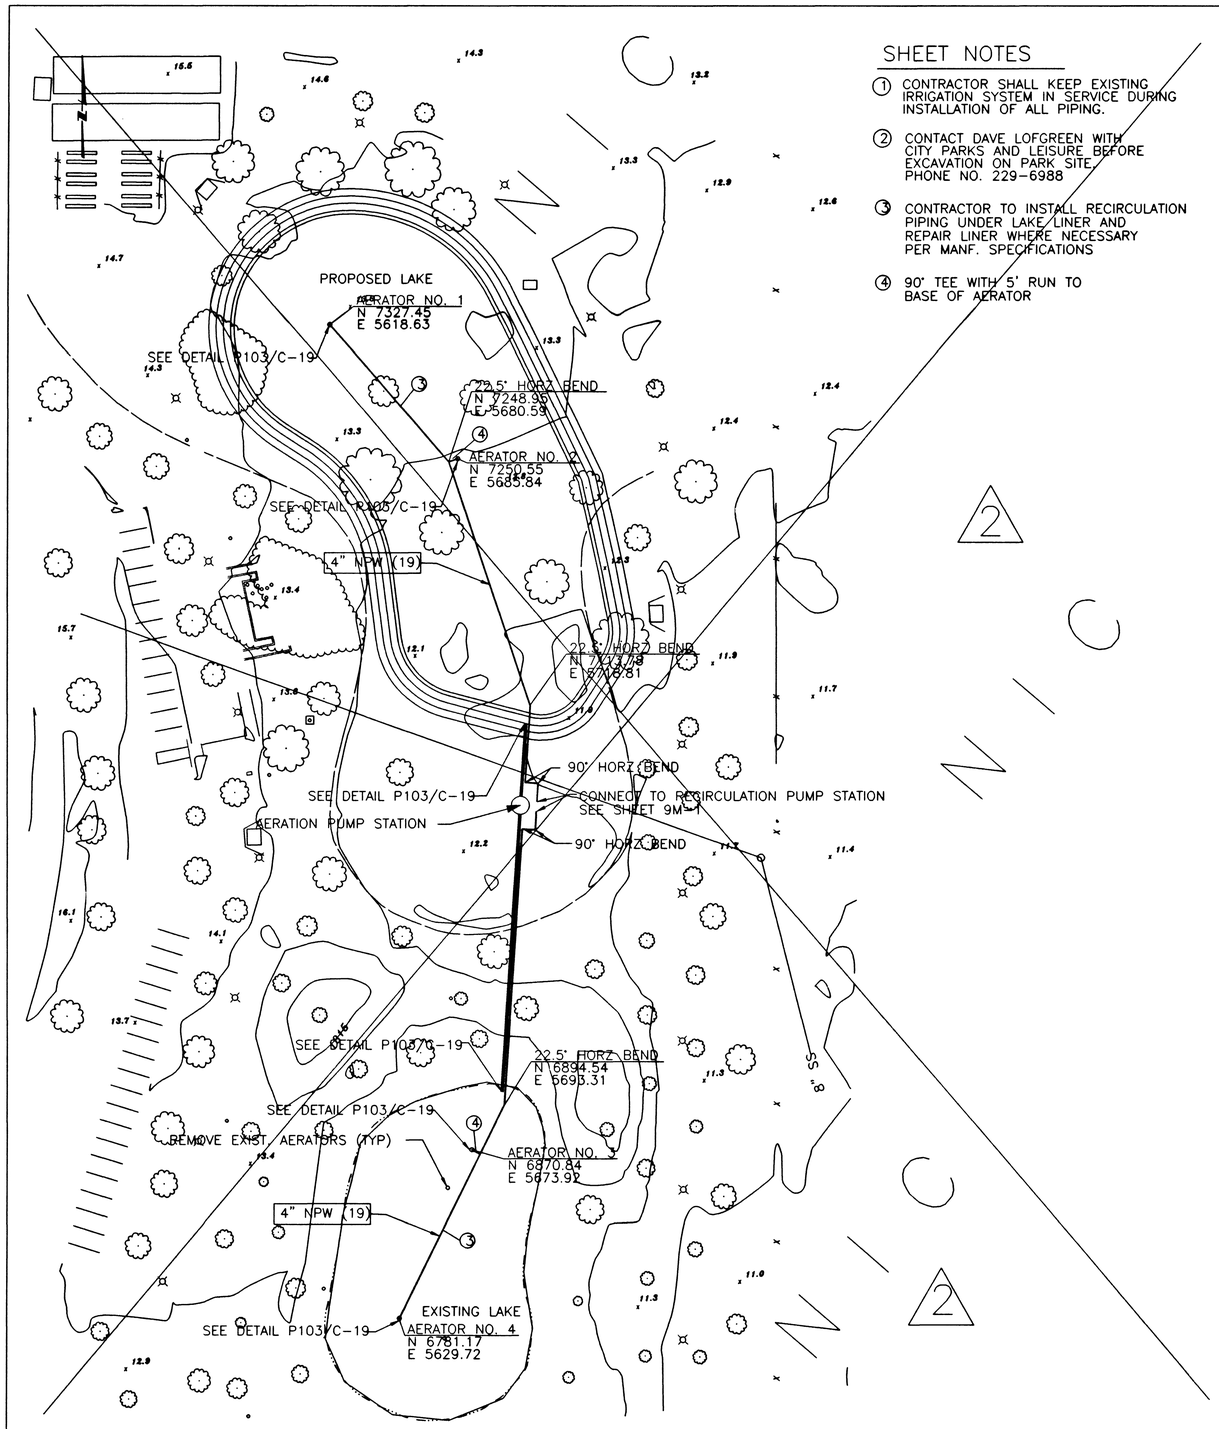

SHEET NOTES

1. CONTRACTOR SHALL KEEP EXISTING IRRIGATION SYSTEM IN SERVICE DURING INSTALLATION OF ALL PIPING.
2. CONTACT DAVE LOFGREEN WITH CITY PARKS AND LEISURE BEFORE EXCAVATION ON PARK SITE. PHONE NO. 229-6988
3. CONTRACTOR TO INSTALL RECIRCULATION PIPING UNDER LAKE LINER AND REPAIR LINER WHERE NECESSARY PER MANF. SPECIFICATIONS
4. 90° TEE WITH 5' RUN TO BASE OF AERATOR

GENERAL NOTES

1. ALL STATIONING IS ALONG THE HORIZONTAL CENTERLINE OF THE NEW PIPELINE.
2. ALL PIPELINE ELEVATIONS ARE INVERT ELEVATIONS UNLESS SHOWN OTHERWISE.
3. PIPELINE SLOPES ARE CALCULATED FROM MANHOLE CENTERLINE. MANHOLE CHANNEL INVERTS SHALL BE TRANSITIONED TO MATCH.
4. UTILITY INVERTS SHOWN HAVE BEEN CALCULATED FROM CLOSEST MANHOLE AND SHALL BE VERIFIED BEFORE CONSTRUCTION.
5. ALL UNDERGROUND UTILITIES SHALL BE SUPPORTED IN ACCORDANCE WITH DETAIL C229/GC-3

SHEET NOTES

1. CONTRACTOR SHALL INSTALL 48" MANHOLES PER STANDARD DRAWING SD-1 (STANDARD ECCENTRIC MANHOLE)

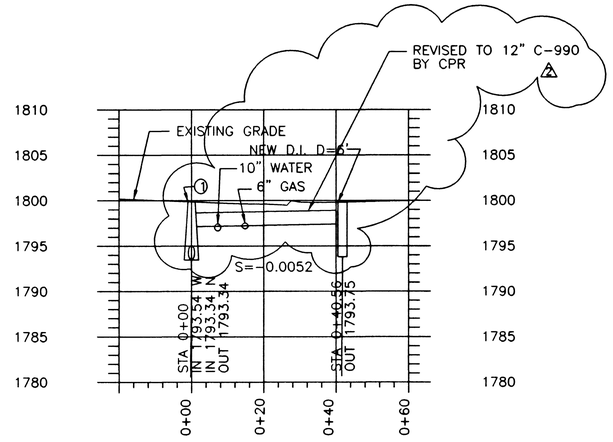

PECOS RD STORM DRAIN LATERAL PROFILE NO. 17

SCALE: HORZ 1" = 20'
VERT 1" = 5'

AS BUILT
DATE
2 9 APR 99
1

Avoid cutting underground utility lines. It's costly.
Call before you Dig
1-800-227-2600

REGISTERED PROFESSIONAL ENGINEER STATE OF NEVADA
BEN EMERSON CIVIL
No. 9422

THE ORIGINAL CONTRACT DOCUMENT WAS SEALED AND SIGNED BY BEN EMERSON

REV	DATE	BY	DESCRIPTION

SCALE: 1" = 40'

WARNING 0 1/2 1 IF THIS BAR DOES NOT MEASURE 1" THEN DRAWING IS NOT TO SCALE.

DESIGNED S. McCLELLAND
DRAWN S. McCLELLAND
CHECKED B. EMERSON

SUBMITTED THE ORIGINAL CONTRACT DOCUMENT WAS SIGNED BY BEN EMERSON
PROJECT ENGINEER R. C. E. NO. DATE
RECOMMENDED THE ORIGINAL CONTRACT DOCUMENT WAS SIGNED BY VICKI J SCARNHORST
MONTGOMERY WATSON R. C. E. NO. DATE

MONTGOMERY WATSON
Las Vegas, Nevada

MONTGOMERY WATSON
3014 WEST CHARLESTON BLVD
LAS VEGAS, NV. 89102-1944
(702) 878-8010

COPYRIGHT © 1997 BY MONTGOMERY WATSON
ALL RIGHTS RESERVED

CITY OF LAS VEGAS
BONANZA/MOJAVE WATER RESOURCE CENTER

RECIRCULATION PIPING AND AERATOR LOCATIONS

DWG. C-21
SHEET 30
513-64

JOB No. 1540.0131 FILE No. $$$$$$$$$$directory/filename$$$$$$$$$$
DATE/TIME $$$$date$$$$ $$$$time$$

26274