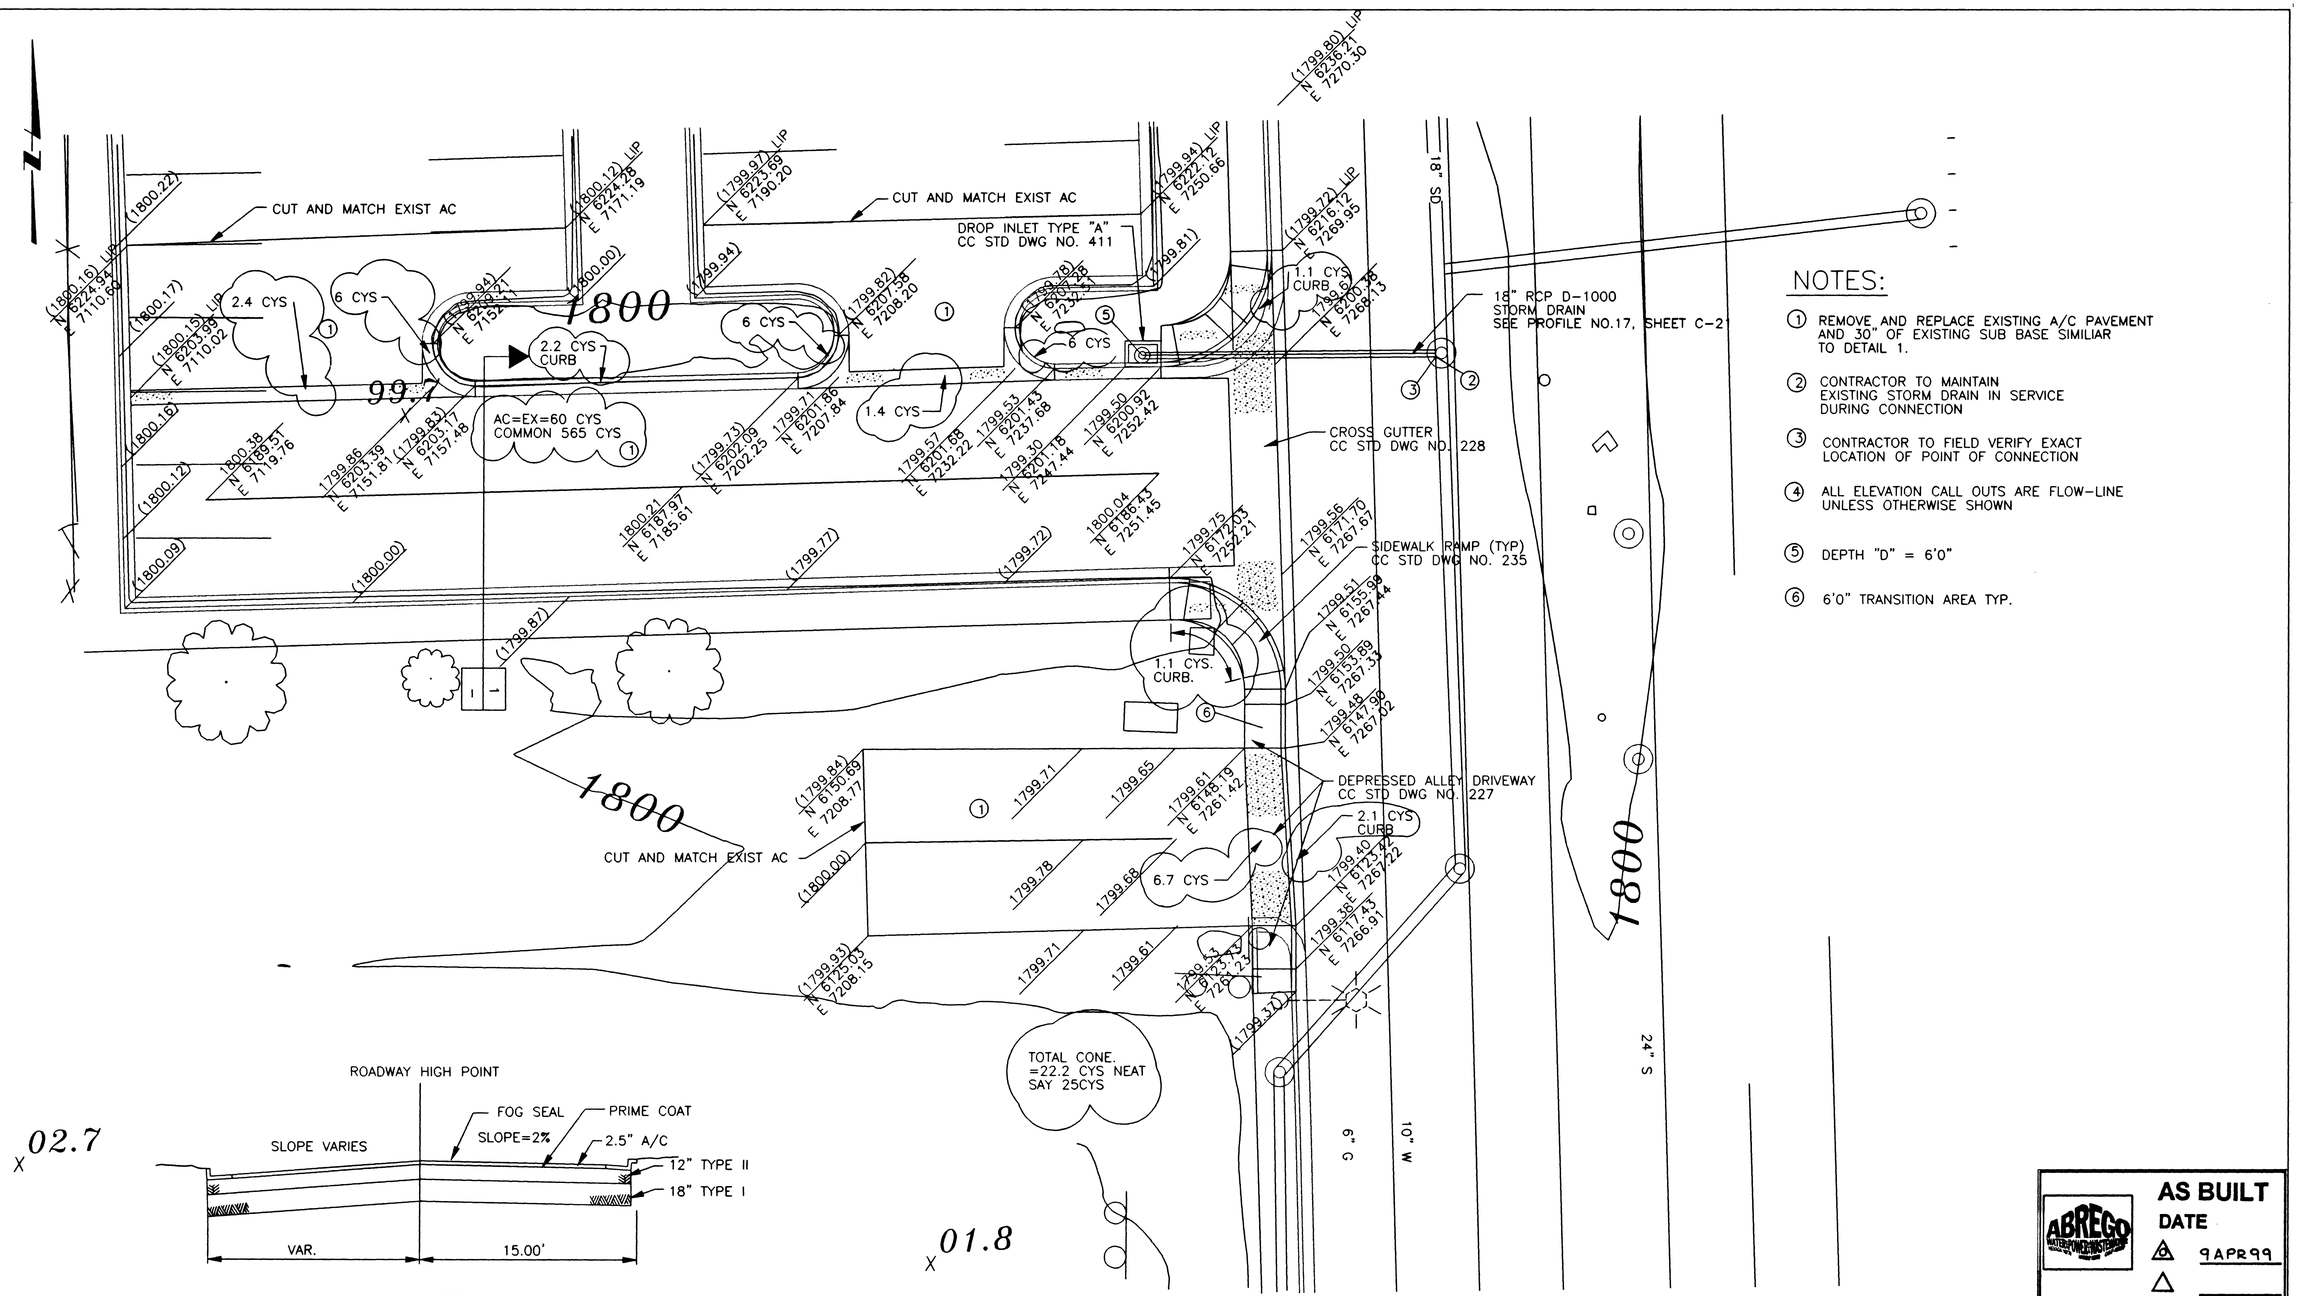

NOTES:

1. REMOVE AND REPLACE EXISTING A/C PAVEMENT AND 30" OF EXISTING SUB BASE SIMILIAR TO DETAIL 1.
2. CONTRACTOR TO MAINTAIN EXISTING STORM DRAIN IN SERVICE DURING CONNECTION
3. CONTRACTOR TO FIELD VERIFY EXACT LOCATION OF POINT OF CONNECTION
4. ALL ELEVATION CALL OUTS ARE FLOW-LINE UNLESS OTHERWISE SHOWN
5. DEPTH "D" = 6'0"
6. 6'0" TRANSITION AREA TYP.

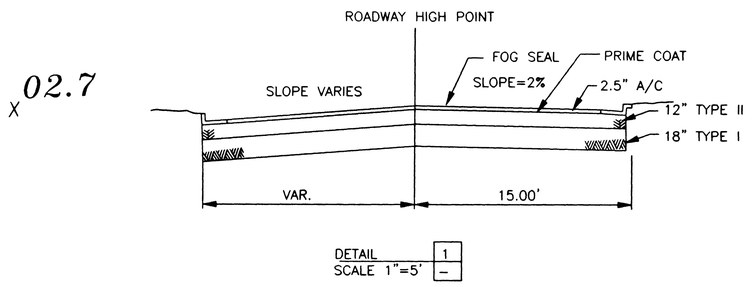

DETAIL 1
SCALE 1"=5'

AS BUILT
DATE
9APR99

Call before you Dig 1-800-227-2600

THE ORIGINAL CONTRACT DOCUMENT WAS SEALED AND SIGNED BY BEN EMERSON

REV	DATE	BY	DESCRIPTION

SCALE:
HORZ 1" = 10'
VERT 1"=5'

WARNING
0 1/2 1
IF THIS BAR DOES NOT MEASURE 1" THEN DRAWING IS NOT TO SCALE.

DESIGNED S. McCLELLAND
DRAWN S. McCLELLAND
CHECKED B. EMERSON

SUBMITTED
THE ORIGINAL CONTRACT DOCUMENT WAS SIGNED BY BEN EMERSON
PROJECT ENGINEER R. C. E. NO. DATE

RECOMMENDED
THE ORIGINAL CONTRACT DOCUMENT WAS SIGNED BY VICKI J SCARNHORST
MONTGOMERY WATSON R. C. E. NO. DATE

MONTGOMERY WATSON
Las Vegas, Nevada

MONTGOMERY WATSON
3014 WEST CHARLESTON BLVD
LAS VEGAS, NV. 89102-1944
(702) 878-8010

COPYRIGHT © 1997 BY MONTGOMERY WATSON
ALL RIGHTS RESERVED

CITY OF LAS VEGAS
BONANZA/MOJAVE WATER RESOURCE CENTER

FREEDOM PARK PECOS ROAD
PARKING LOT REHABILITATION

DWG. C-24
31
513-64

JOB No. 1540.0131 FILE No. $$$$directory/filename$$$$ DATE/TIME $$$$date$$$$time$$

26275