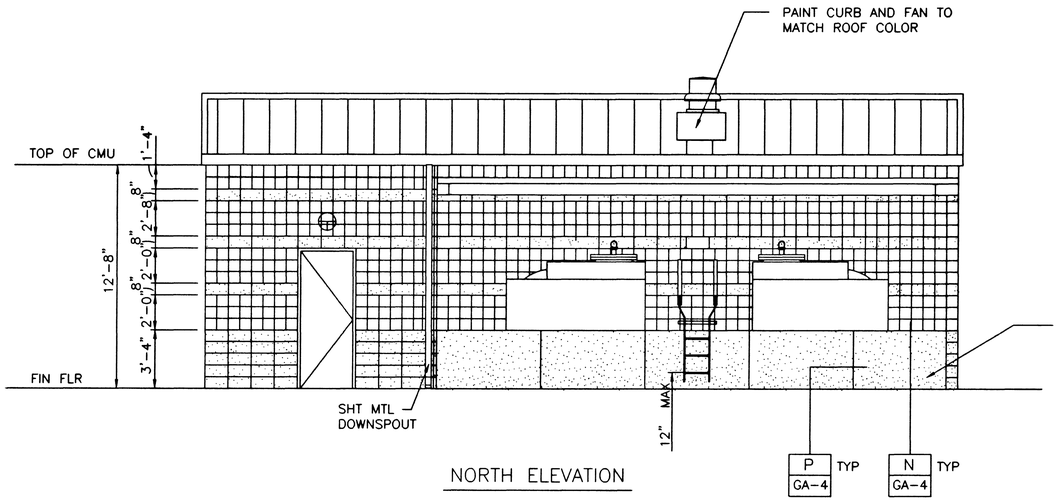

NORTH ELEVATION

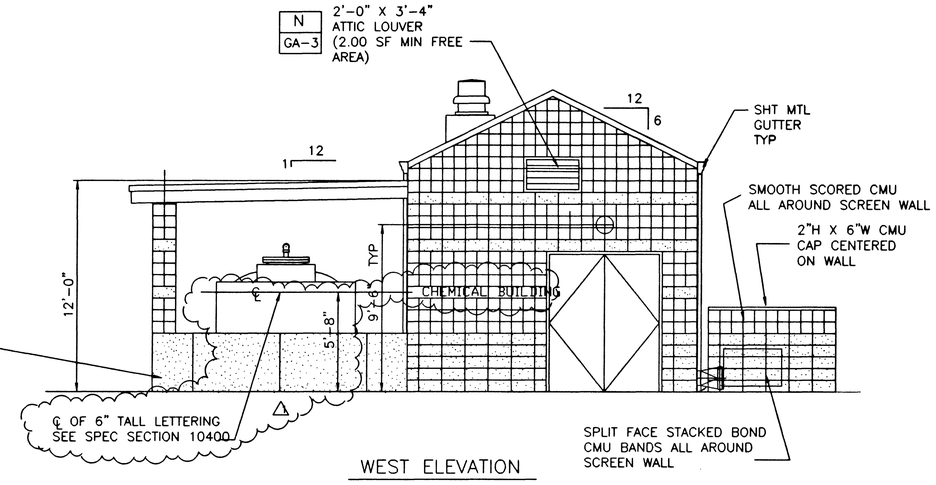

WEST ELEVATION

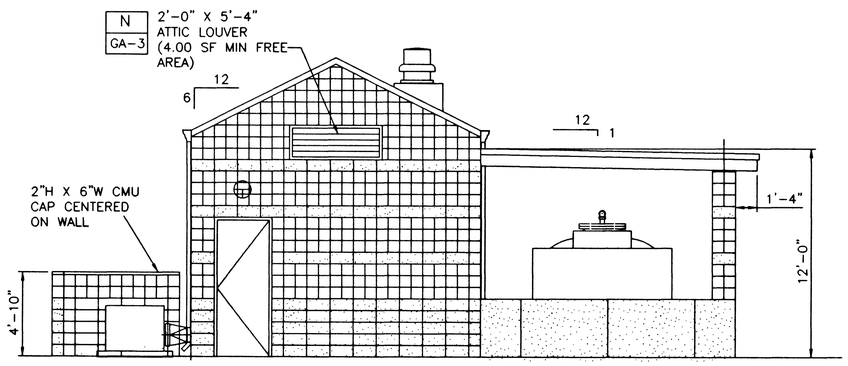

EAST ELEVATION

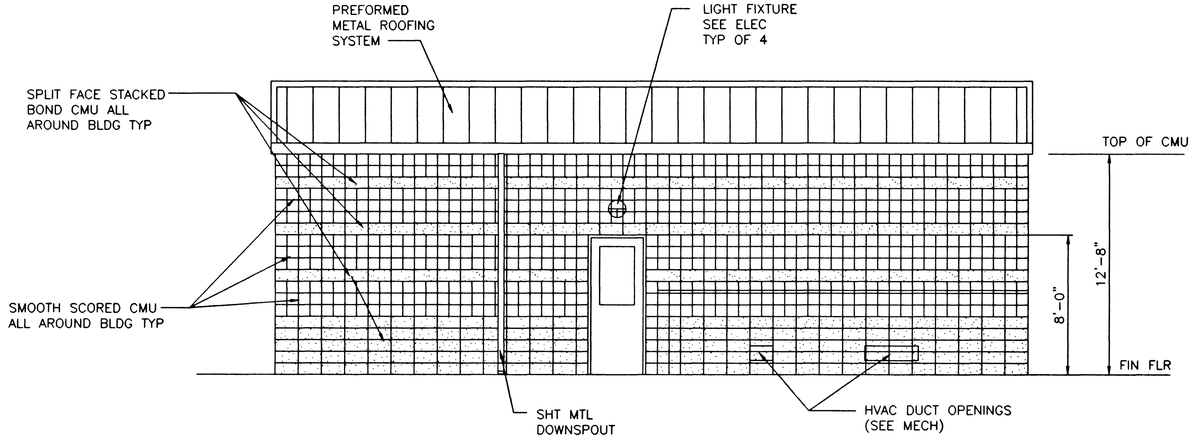

SOUTH ELEVATION

NOTES:

- ALL EXTERIOR SURFACES OF CMU SHALL BE COATED WITH WATER RETARDER PER SPEC SECTION 09800

THE ORIGINAL CONTRACT DOCUMENT WAS SEALED AND SIGNED BY WILLIAM H. BRUMM

AS BUILT
DATE
0 10APR99
1

REV	DATE	BY	DESCRIPTION
1	7/98	VEC	SK1-CPR-012

SCALE: 1/4 "=1'-0"

WARNING 0 1/2 1 IF THIS BAR DOES NOT MEASURE 1" THEN DRAWING IS NOT TO SCALE.

DESIGNED A. ELHADARY
DRAWN P. WANG
CHECKED W. BRUMM

SUBMITTED THE ORIGINAL CONTRACT DOCUMENT WAS SIGNED BY SATISH KAMATH
PROJECT ENGINEER R. C. E. NO. DATE
RECOMMENDED THE ORIGINAL CONTRACT DOCUMENT WAS SIGNED BY WILLIAM H. BRUMM
MONTGOMERY WATSON R. C. E. NO. DATE

MONTGOMERY WATSON
Las Vegas, Nevada

MONTGOMERY WATSON
3014 WEST CHARLESTON BLVD
LAS VEGAS, NV. 89102-1944
(702) 878-8010

COPYRIGHT © 1996 BY MONTGOMERY WATSON
ALL RIGHTS RESERVED

CITY OF LAS VEGAS
BONANZA/MOJAVE WATER RESOURCE CENTER
CHEMICAL BUILDING
EXTERIOR ELEVATIONS
513-64

DWG. 33
7A-2

DATE/TIME dd-mmm-yyyy hh:mm
JOB No. FILE No. $$$$$$$$$$directory/filename$$$$$$$$$