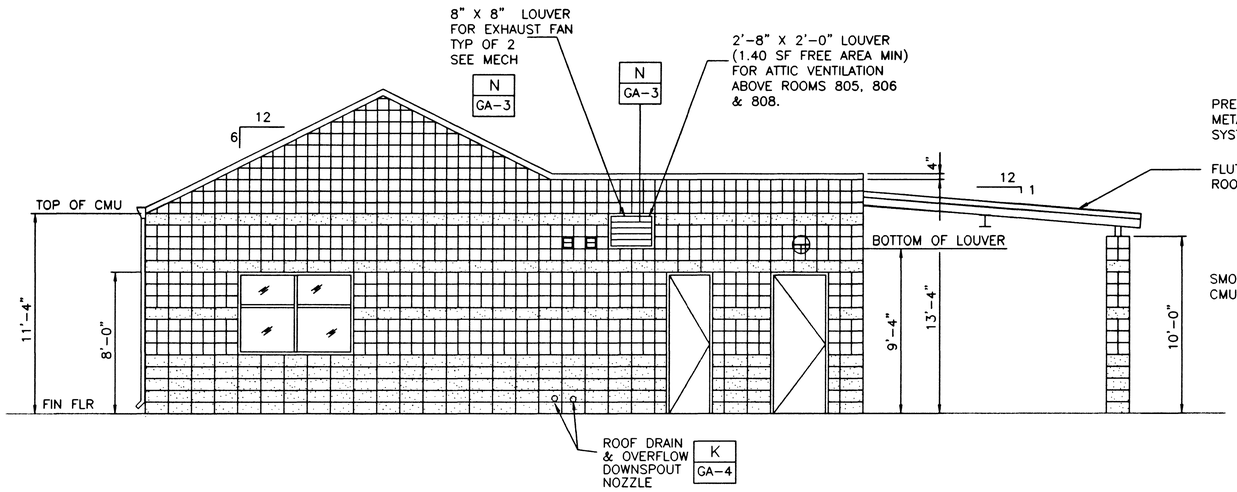

EAST ELEVATION

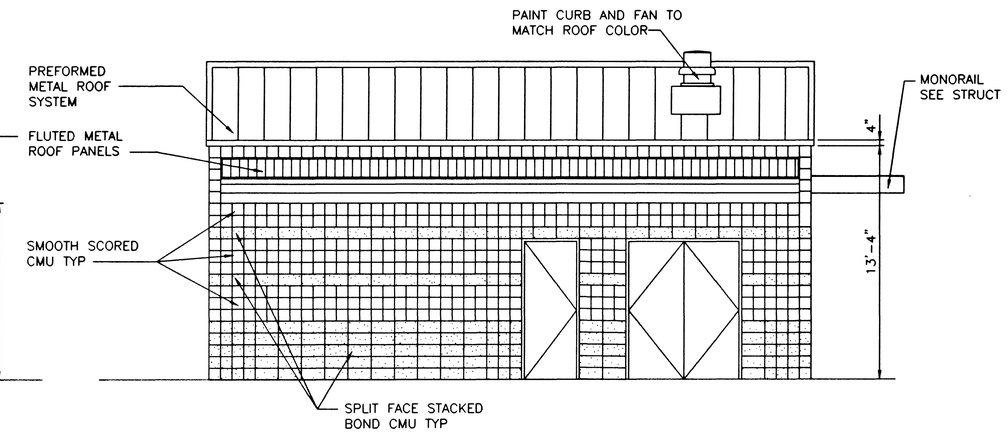

NORTH ELEVATION

NOTE:

– ALL EXTERIOR SURFACES OF CMU SHALL BE COATED WITH WATER RETARDER PER SPEC SECTION 09800

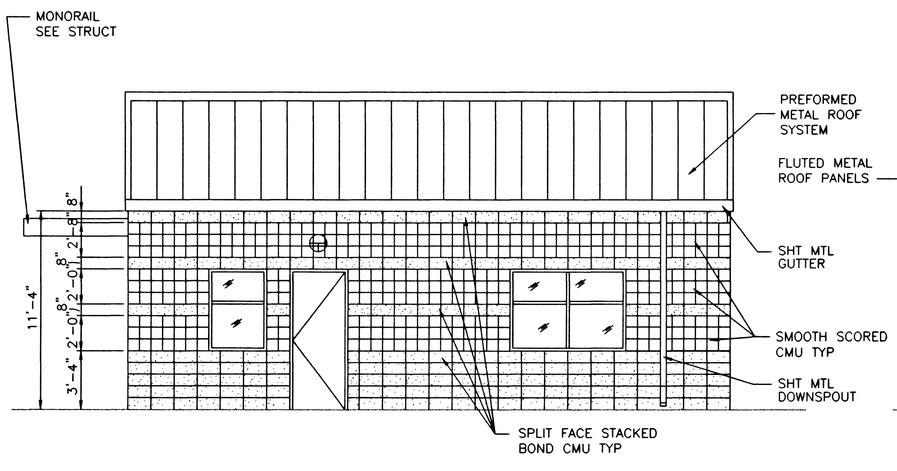

SOUTH ELEVATION

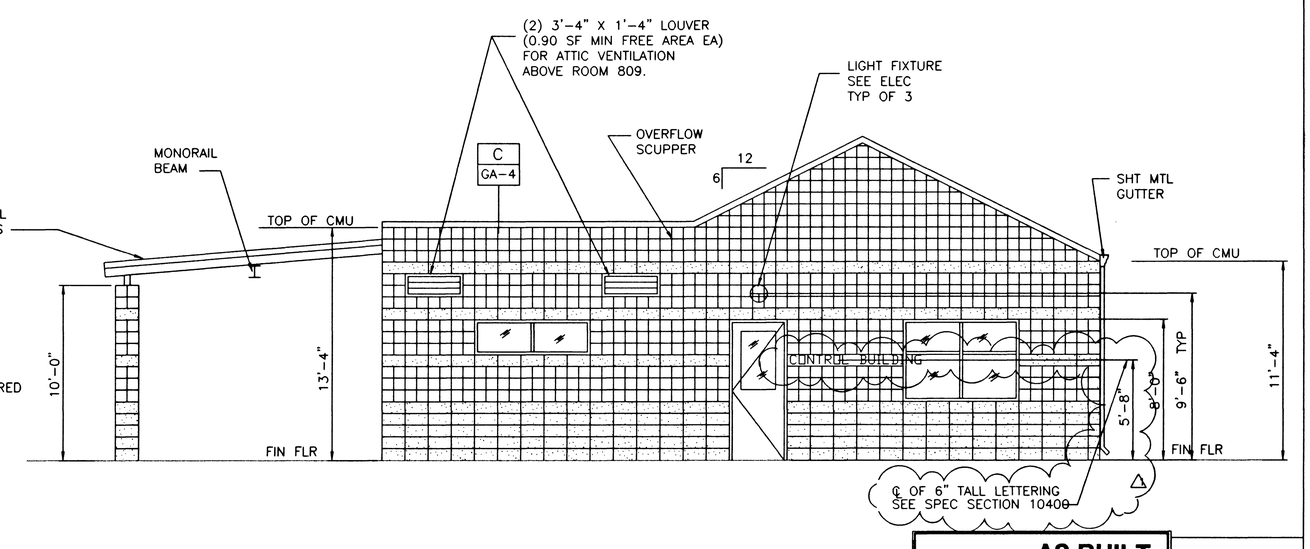

WEST ELEVATION

AS BUILT
DATE
10APR99

THE ORIGINAL CONTRACT DOCUMENT WAS SEALED AND SIGNED BY WILLIAM H. BRUMM

DATE/TIME dd-mmm-yyyy hh:mm
JOB No. _____ FILE No. $$$$$$$$$directory/filename$$$$$$$$