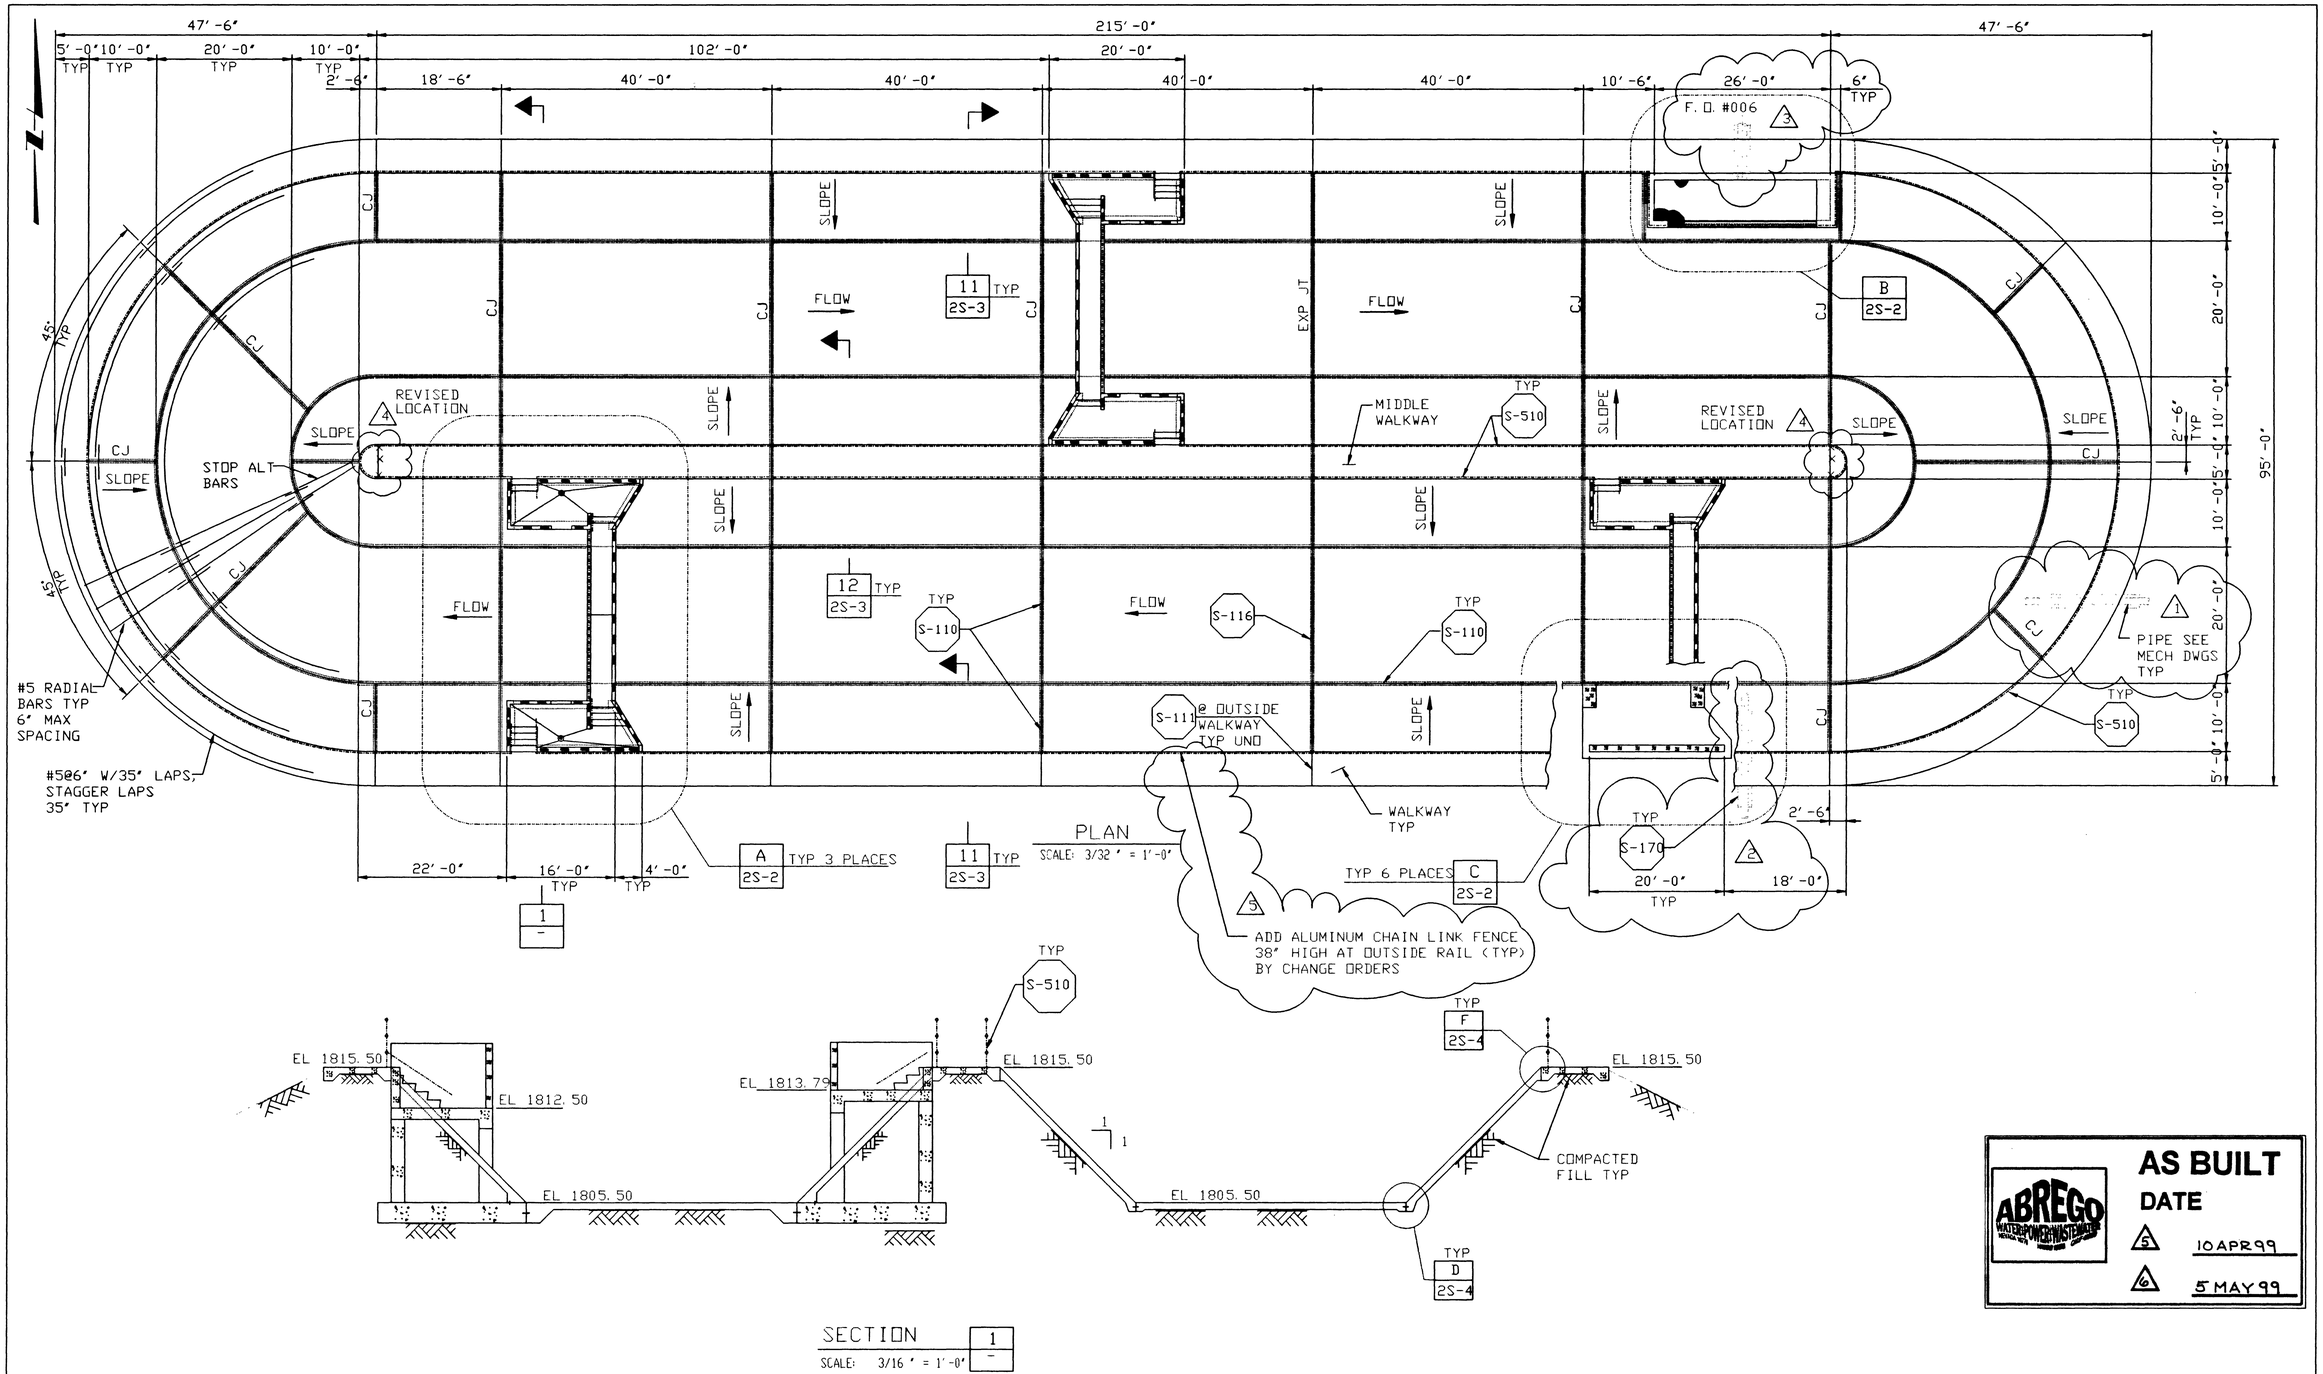

PLAN

SCALE: 3/32" = 1'-0"

SECTION 1

SCALE: 3/16" = 1'-0"

AS BUILT

DATE

5 10APR99

6 5MAY99

THE ORIGINAL CONTRACT DOCUMENT WAS SEALED AND SIGNED BY SAM MOUAWAD

REV	DATE	BY	DESCRIPTION

SCALE: AS SHOWN

WARNING 0 1/2 1 — IF THIS BAR DOES NOT MEASURE 1" THEN DRAWING IS NOT TO SCALE.

DESIGNED S. MOUAWAD
DRAWN S. MOUAWAD
CHECKED C. LEE

SUBMITTED THE ORIGINAL CONTRACT DOCUMENT WAS SIGNED BY SAM MOUAWAD
PROJECT ENGINEER R. C. E. NO. DATE
RECOMMENDED THE ORIGINAL CONTRACT DOCUMENT WAS SIGNED BY VICKI J SCHARNHORST
MONTGOMERY WATSON R. C. E. NO. DATE

MONTGOMERY WATSON
Las Vegas, Nevada

MONTGOMERY WATSON
3014 WEST CHARLESTON BLVD
LAS VEGAS, NV 89102-1944
(702) 878-8010

COPYRIGHT © 1996 BY MONTGOMERY WATSON
ALL RIGHTS RESERVED

CITY OF LAS VEGAS

BONANZA/MOJAVE WATER RESOURCE CENTER

OXIDATION CHANNEL
PLAN AND SECTION

DWG. 90
2S-1
513-64

JOB No. ____ FILE No. P:\proj\lvwr-f\str\ozn0ksm.dgn DATE/TIME DD-MMM-YYYY HH:MM

26794