LEGEND

— — —	STREET CENTERLINE
TMH	TOP OF MANHOLE
MH	MANHOLE
INV.	INVERT
PVC	POLYVINYL SEWER PIPE

SEWER

□	EXISTING STANDARD MANHOLE
●	STANDARD MANHOLE
———	8" AND 12" PVC SEWER MAIN

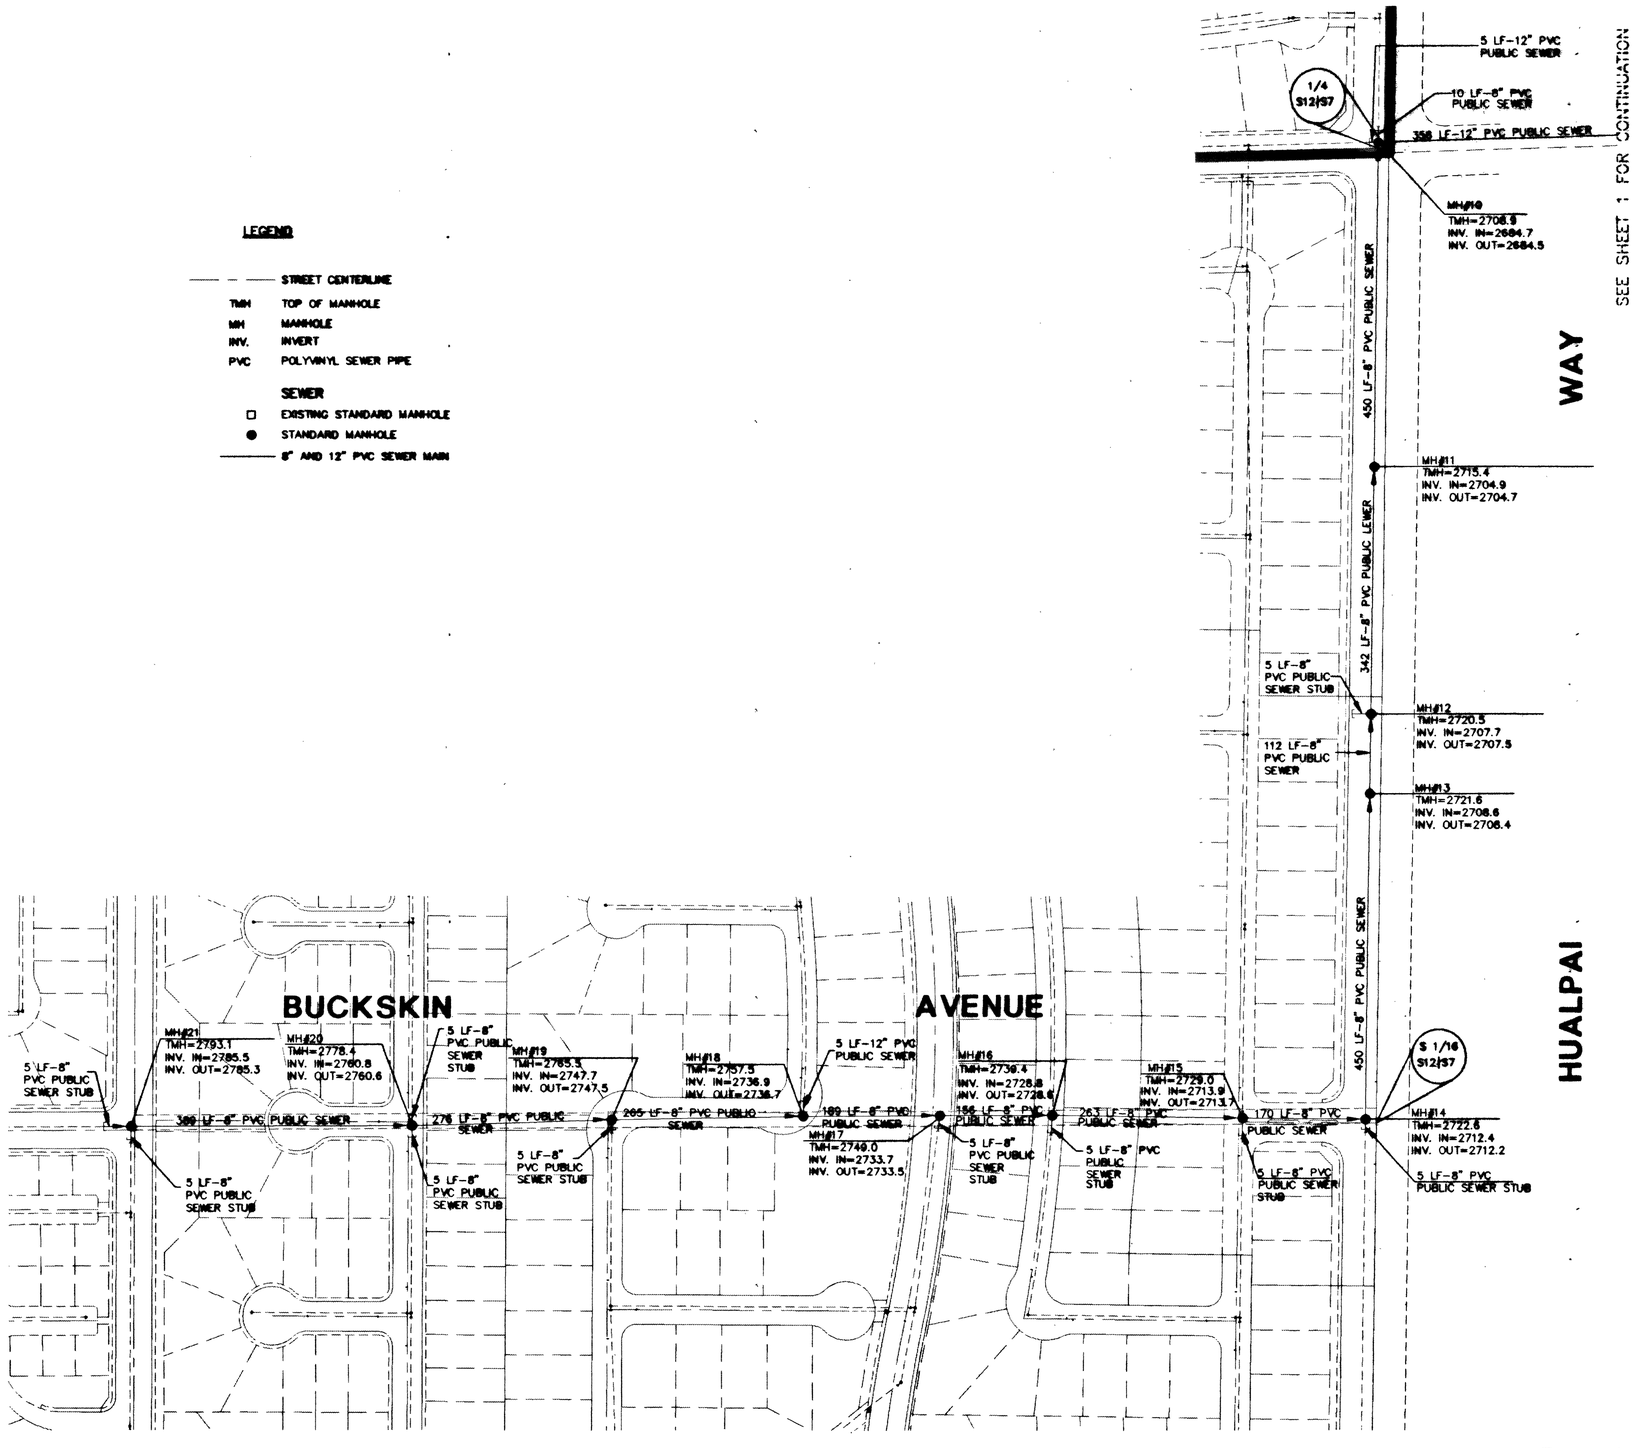

GRAPHIC SCALE

(IN FEET)
1 inch = 100 ft.

REV.	DATE	BY	REVISION
A			
B			
C			
D			

PERMA-BILT HOMES

CITY OF LAS VEGAS

vtn nevada

CONSULTING ENGINEERS ● PLANNERS ● LAND SURVEYORS
2727 SOUTH RAINBOW BOULEVARD
LAS VEGAS, NEVADA 89146-5148 PHONE (702) 873-7550 FAX (702) 383-2307

TITLE: SEWER ASBUILT

PROJECT: CHEYENNE/HUALAPAI OFFSITE SEWER

SEAL

W.O. NO. 5018
BY CZ
DATE 10-8-09
SCALE HORIZ. 1"=100' VERT. N.A.
SHEET 2 OF 2 SHEETS

27289

AS-BUILT

3027-4524-03