
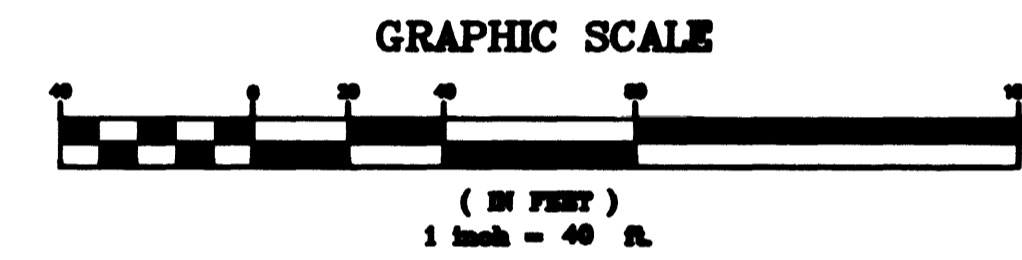
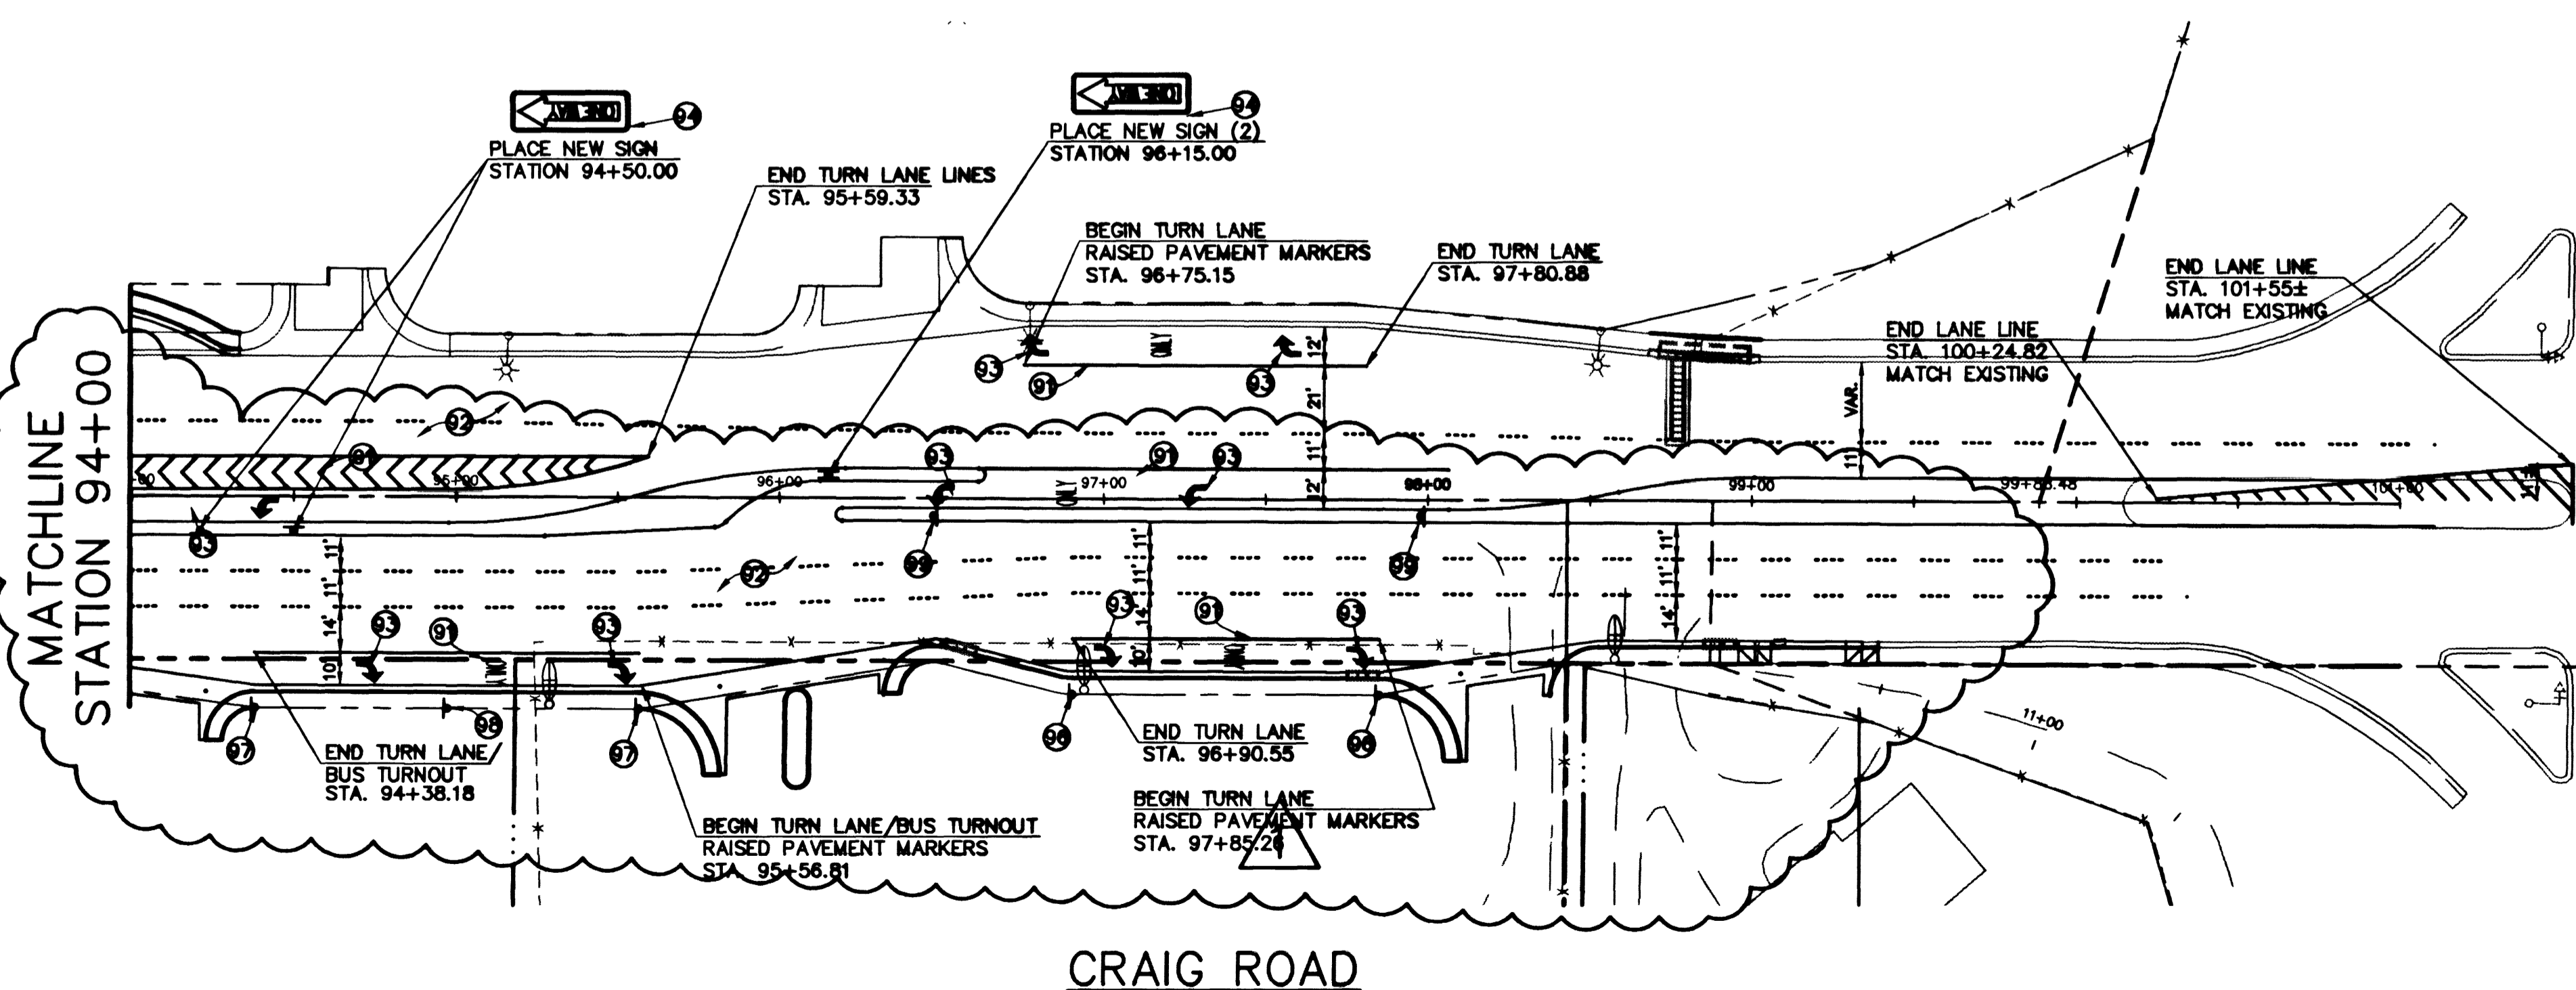


**CONSTRUCTION NOTES:**


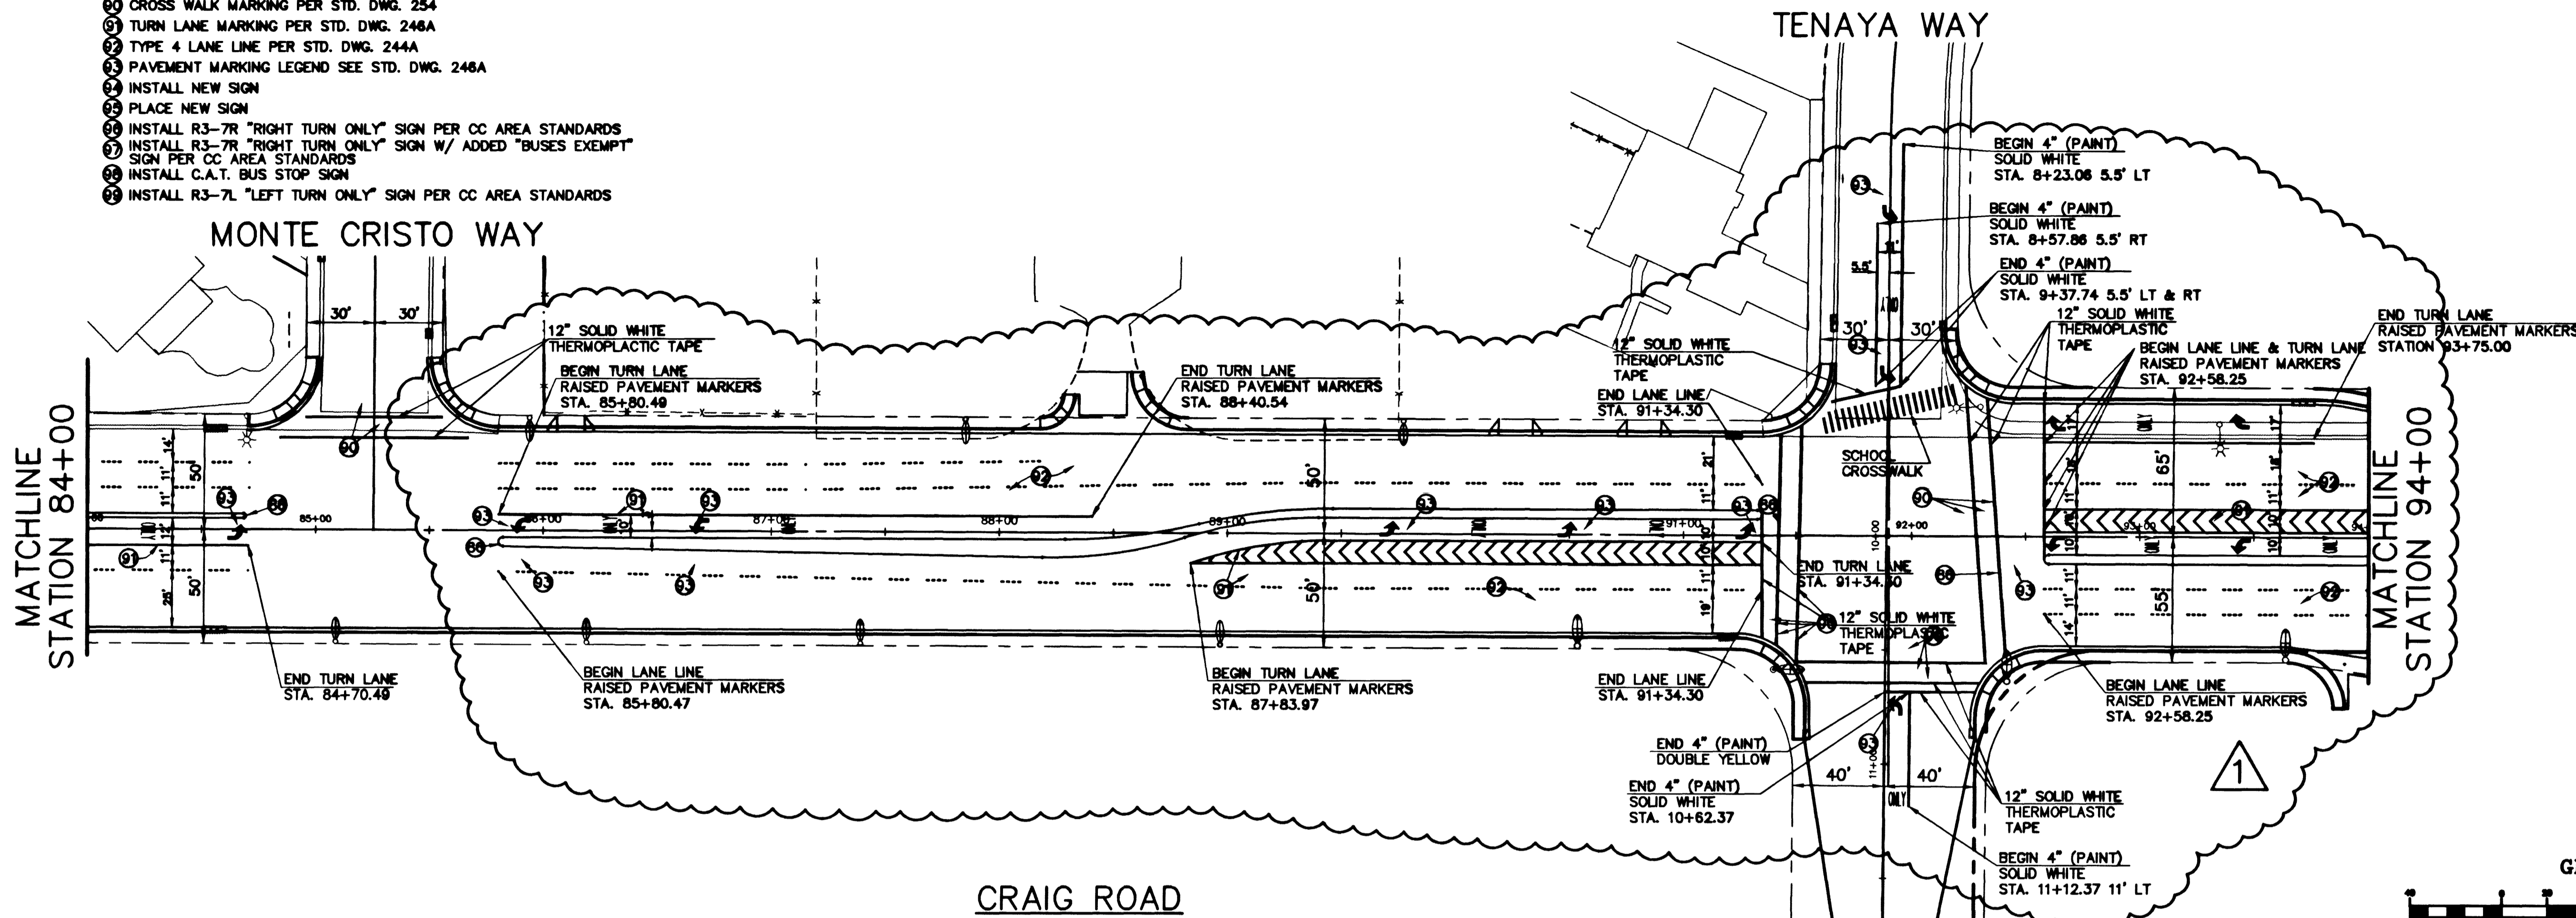

SCHOOL CROSSING SIGNS CRAIG RD. & TENAYA WAY			
DIRECTION		SIGN	STATION
EAST BOUND	WEST BOUND		
X		S1-1	87+00
X		12 MONTH SCHOOL	87+00
X		S4-3	89+00
X		R2-1	89+00
X		S4-1	89+00
	X	END SCHOOL ZONE	90+00
X		S2-1	91+00
X		12 MONTH SCHOOL	91+00
	X	S2-1	92+50
	X	12 MONTH SCHOOL	92+50
X		END SCHOOL ZONE	94+00
	X	S4-3	94+50
	X	R2-1	94+50
	X	S4-1	94+50
	X	S1-1	98+50
	X	12 MONTH SCHOOL	98+50

- SCHOOL ZONE NOTES:**
- R2-1 POST 25 MPH SPEED LIMIT
  - S4-1 TIME LIMIT 8:30 AM TO 3:30 PM
  - SIGNS LOCATIONS MAY BE FIELD ADJUSTED.
  - SIGNS TO BE PLACED AT BACK OF SIDEWALK OR AS DIRECTED BY THE ENGINEER.
  - PLACE SIGN LOCATED @ STATION 98+50 NB ON EXISTING LIGHT POLE.
  - SEE MUTCD FOR SIGN INFORMATION.

<p><b>CITY OF LAS VEGAS</b> 731 SOUTH FOURTH STREET LAS VEGAS, NEVADA 89101</p> <p><b>URS Greiner</b> 2785 EAST DESERT INN ROAD LAS VEGAS, NEVADA 89121 (702)-796-7775 FAX (702)-796-1803</p>	<p><b>TRAFFIC CONTROL &amp; STRIPING PLAN</b></p> <p><b>CRAIG ROAD IMPROVEMENTS</b> BID NO. 00.1730.23</p> <p>SHEET: 7/20/98 DESIGNED BY: DMS/ARA 7/20/98 CHECKED BY: DMS/ARA 7/20/98 PROJECT NO: 44-300 SCALE: 1" = 40' HOR. NONE VERT.</p>												
<p>FOR REVISION ONLY</p> <table border="1" style="width: 100%; border-collapse: collapse;"> <tr> <th>NO.</th> <th>DATE</th> <th>BY</th> <th>REVISION</th> </tr> <tr> <td> </td> <td> </td> <td> </td> <td> </td> </tr> <tr> <td> </td> <td> </td> <td> </td> <td> </td> </tr> </table>		NO.	DATE	BY	REVISION								
NO.	DATE	BY	REVISION										
<p><b>107-V3048</b></p>													

E:\CRAIG\94\CON\CONSULTANTS\ENR\KTC\_change\4301502.dwg Fr: Aug 11 08 23:43 2000 TEMPLATE  
 HP Designer: 650C Hewlett-Packard HP-GL/2 devices, ADI 4.3 - for Autodesks by HP

24289