CONSTRUCTION NOTES:

- (15) SAWCUT & MATCH EXISTING PAVEMENT
- (25) CUT & JOIN 18" RCP PER DETAIL ON SHEET SD-10
- (31) INSTALL 9' DROP INLET PER DETAIL 4 ON SHEET DS-1
- (34) INSTALL 48" TYPE II MANHOLE PER STD. DWG. 405
- (38) INSTALL 18" RCP STORM DRAIN
- (45) INSTALL 3' DROP INLET PER DETAIL 3 ON SHEET DS-1
- (46) INSTALL 6' DROP INLET PER DETAIL 4 ON SHEET DS-1
- (48) INSTALL 48" TYPE I OR 1A MANHOLE PER STD. DWG(S) 403 & 404
- (49) INSTALL 6'x2' RCB STORM DRAIN
- (95) INSTALL 14"x 23" RCEP STORM DRAIN

PIPE TRENCH NOTES:

1. IN EXISTING PAVED AREAS & STREET CROSSING INSTALL PIPE PER STD. DETAIL #504 EXCEPT USE TYPE II AGGREGATE IN AREA 2 FEET BELOW PAVEMENT COMPACTED TO 95%.
2. IN NEW PAVED AREA INSTALL PIPE PER STD. DETAIL #504.

GRAPHIC SCALE

(IN FEET)
1 inch = 40 ft.

BASIS OF BEARING

NORTH 39°40'38" WEST BEING THE BEARING OF THE LINE FROM POINT 825 TO POINT No. 808 AS SHOWN BY THAT CERTAIN RECORD OF THE SURVEY ON FILE IN THE OFFICE OF THE CLARK COUNTY RECORDER, CLARK COUNTY, NEVADA IN FILE 88, PAGE 53. SAID BEARING BEING BASED ON THE NORTH AMERICAN DATUM OF 1983 (NAD '83), NEVADA STATE PLANE EAST ZONE(2701)

BENCHMARK

NAVD 88– CLV BENCH 1LV003W4
CLV PIN & PLATE IN TOP OF ELEC. BASE
SOUTH SIDE OF CRAIG RD., 250' +/– EAST
OF BUFFALO DR.
ELEVATION 714.730 METERS, 2344.91 FEET

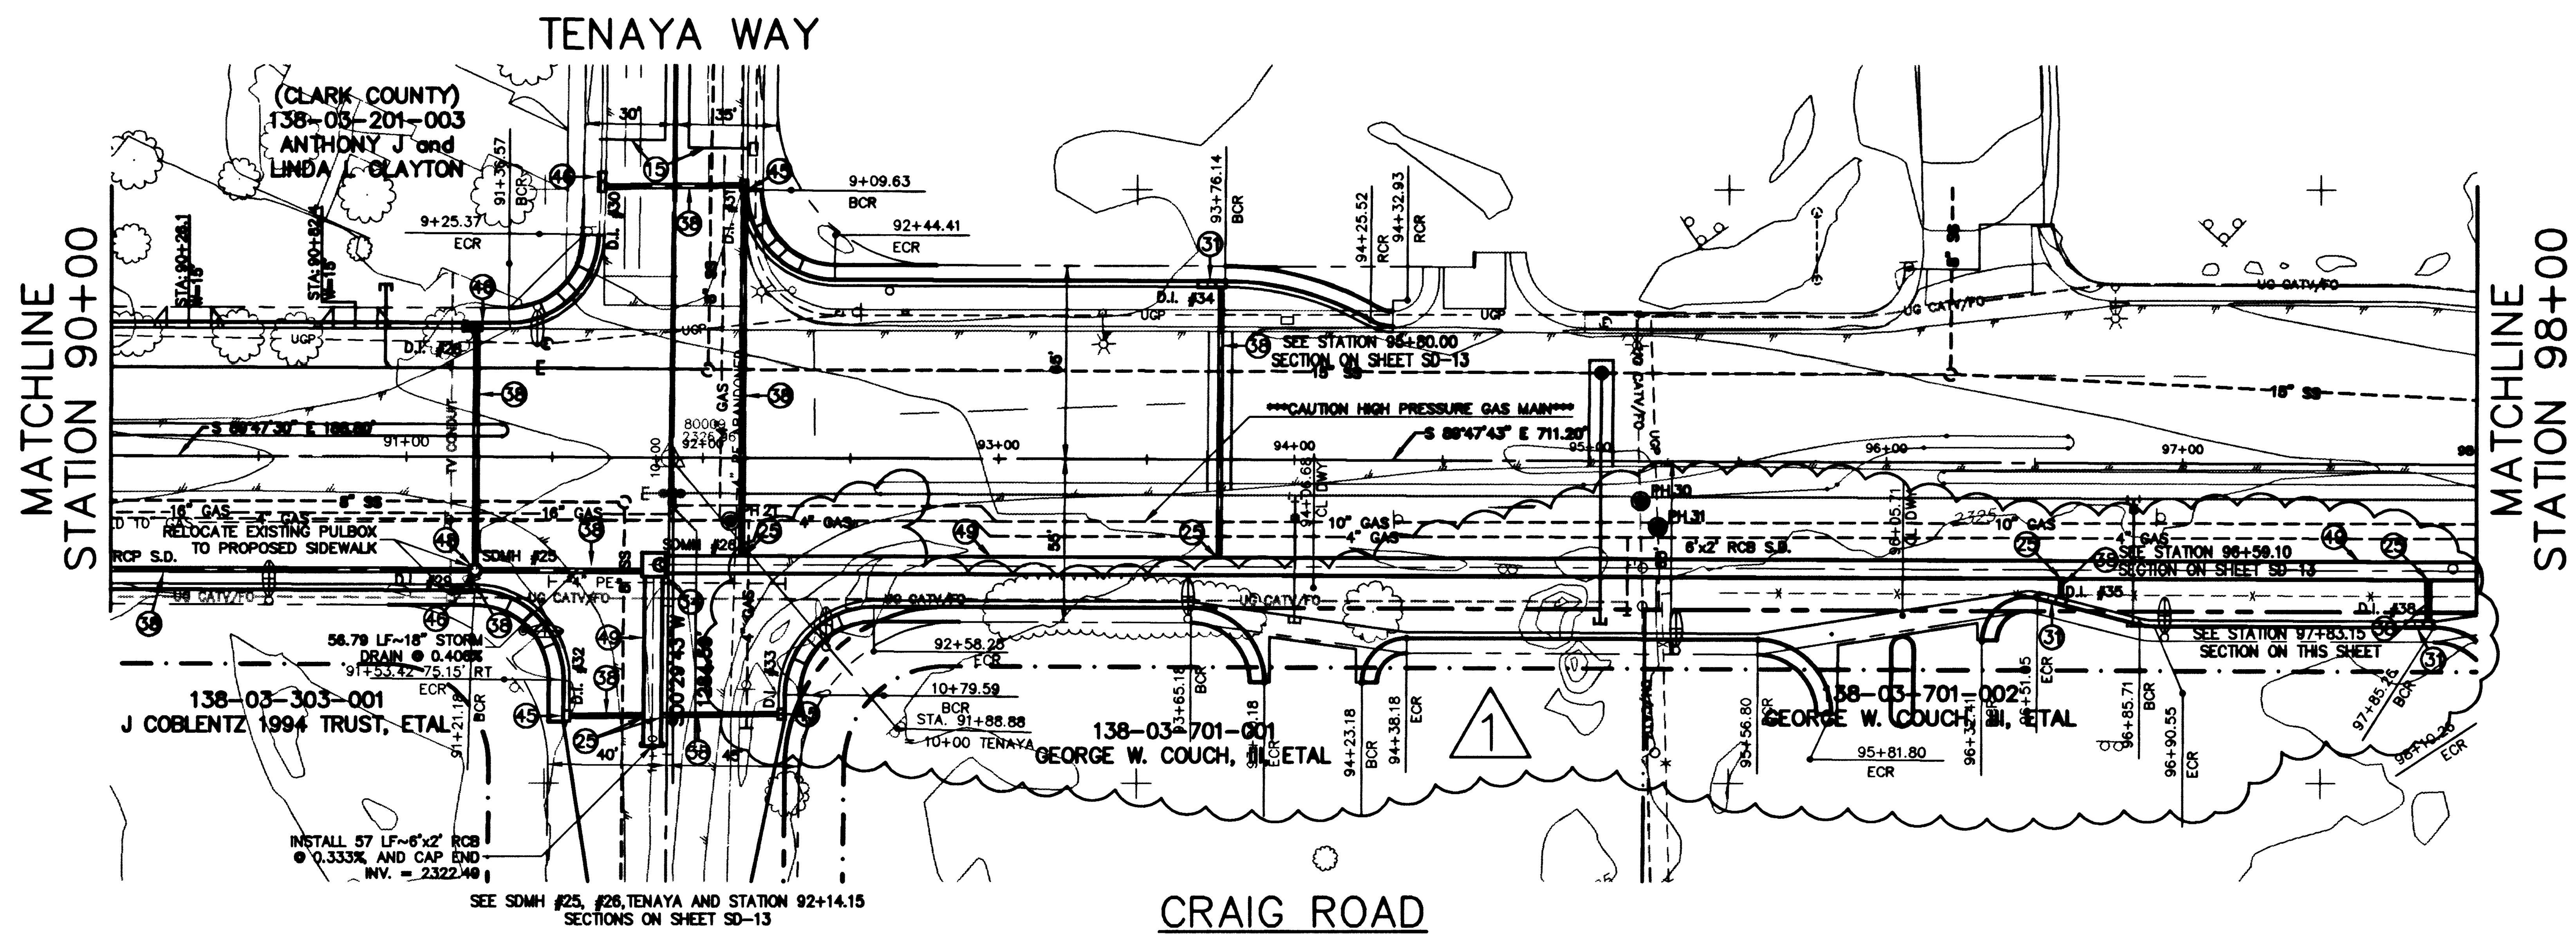

**** CAUTION ****
CONTACT SOUTHWEST GAS 7 DAYS PRIOR TO CONSTRUCTION FOR ABANDONMENT VERIFICATION OF EXISTING 10" STL GAS MAIN. (365-2296)

LAS VEGAS VALLEY WATER DISTRICT ______ DATE

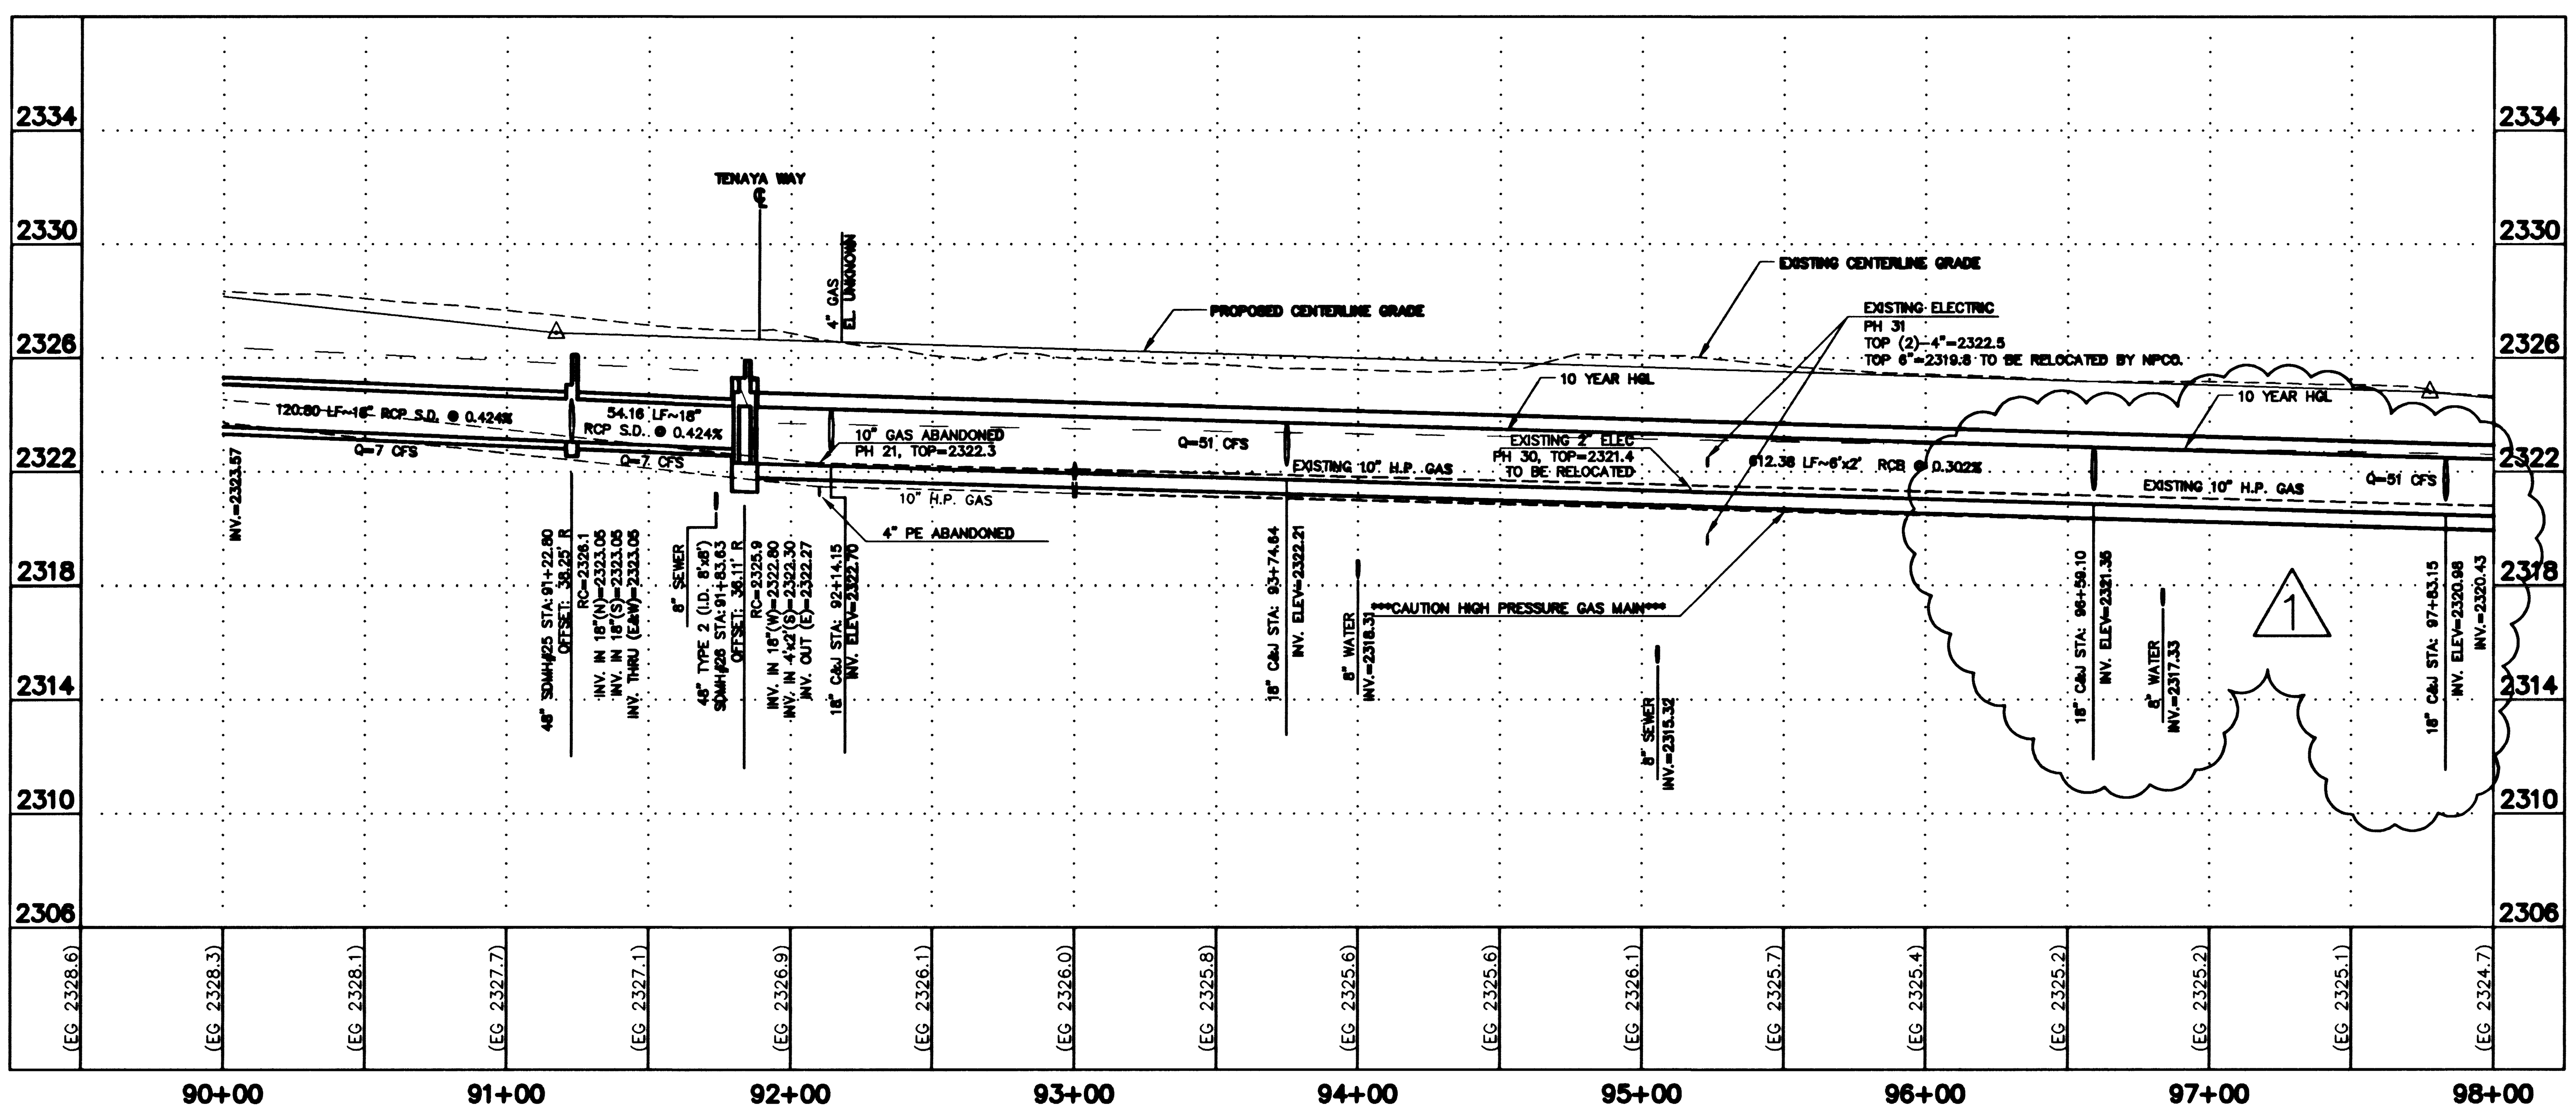

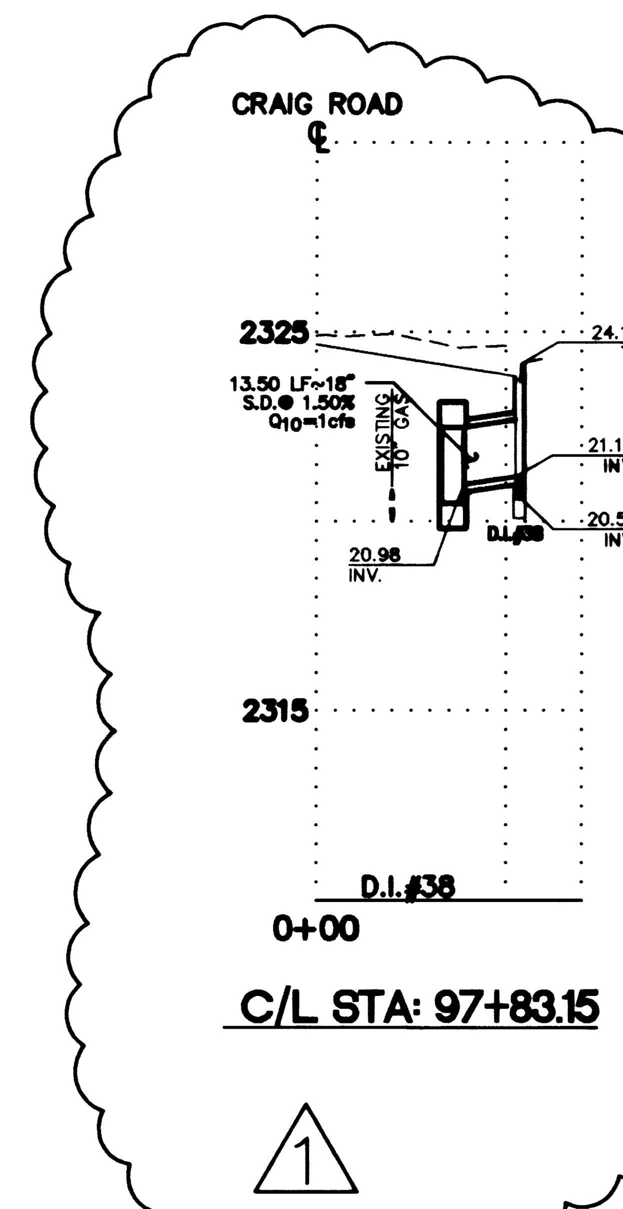

Call before you Overhead
1-702-598-6811

Call before you Dig
1-800-227-2600

REV.	DATE	BY	REVISION
1	3/17/00	EJT	REVISED DIs/ADDED LAT. PROF.

FOR REVISION △ ONLY

CITY OF LAS VEGAS
731 SOUTH FOURTH STREET
LAS VEGAS, NEVADA 89101

URS Greiner
2785 EAST DESERT INN ROAD
LAS VEAGAS, NEVADA 89121
(702)–796–7775 FAX (702)–796–1803

SHEET: 24"x38" &6'x2'RCB STORM DRN PLAN AND PROFILE STA. 90+00 TO STA. 98+00

TITLE: CRAIG ROAD IMPROVEMENTS BID NO. 00.1730.23

DRAWN BY: DMS/MRA	7/20/98	
DESIGNED BY: DMS/MRA	7/20/98	
CHECKED BY: DM	7/20/98	
PROJECT NO: 44300	SCALE:	1"=40' HOR. 1"=4' VERT.

SHEET SD–9
45 OF 55 SHEETS

DRAWING NO. 107–V3048

E:\CRAIG394\DWG\CONSULTANTS\ENG\URSGREINER\TKC_changed\4430SD-09.dwg Thu Aug 10 08:57:32 2000 TEMPLATE
HP DesignJet 650C Hewlett-Packard HP-GL/2 devices, ADI 4.3 - for Autodesk by HP

28291