


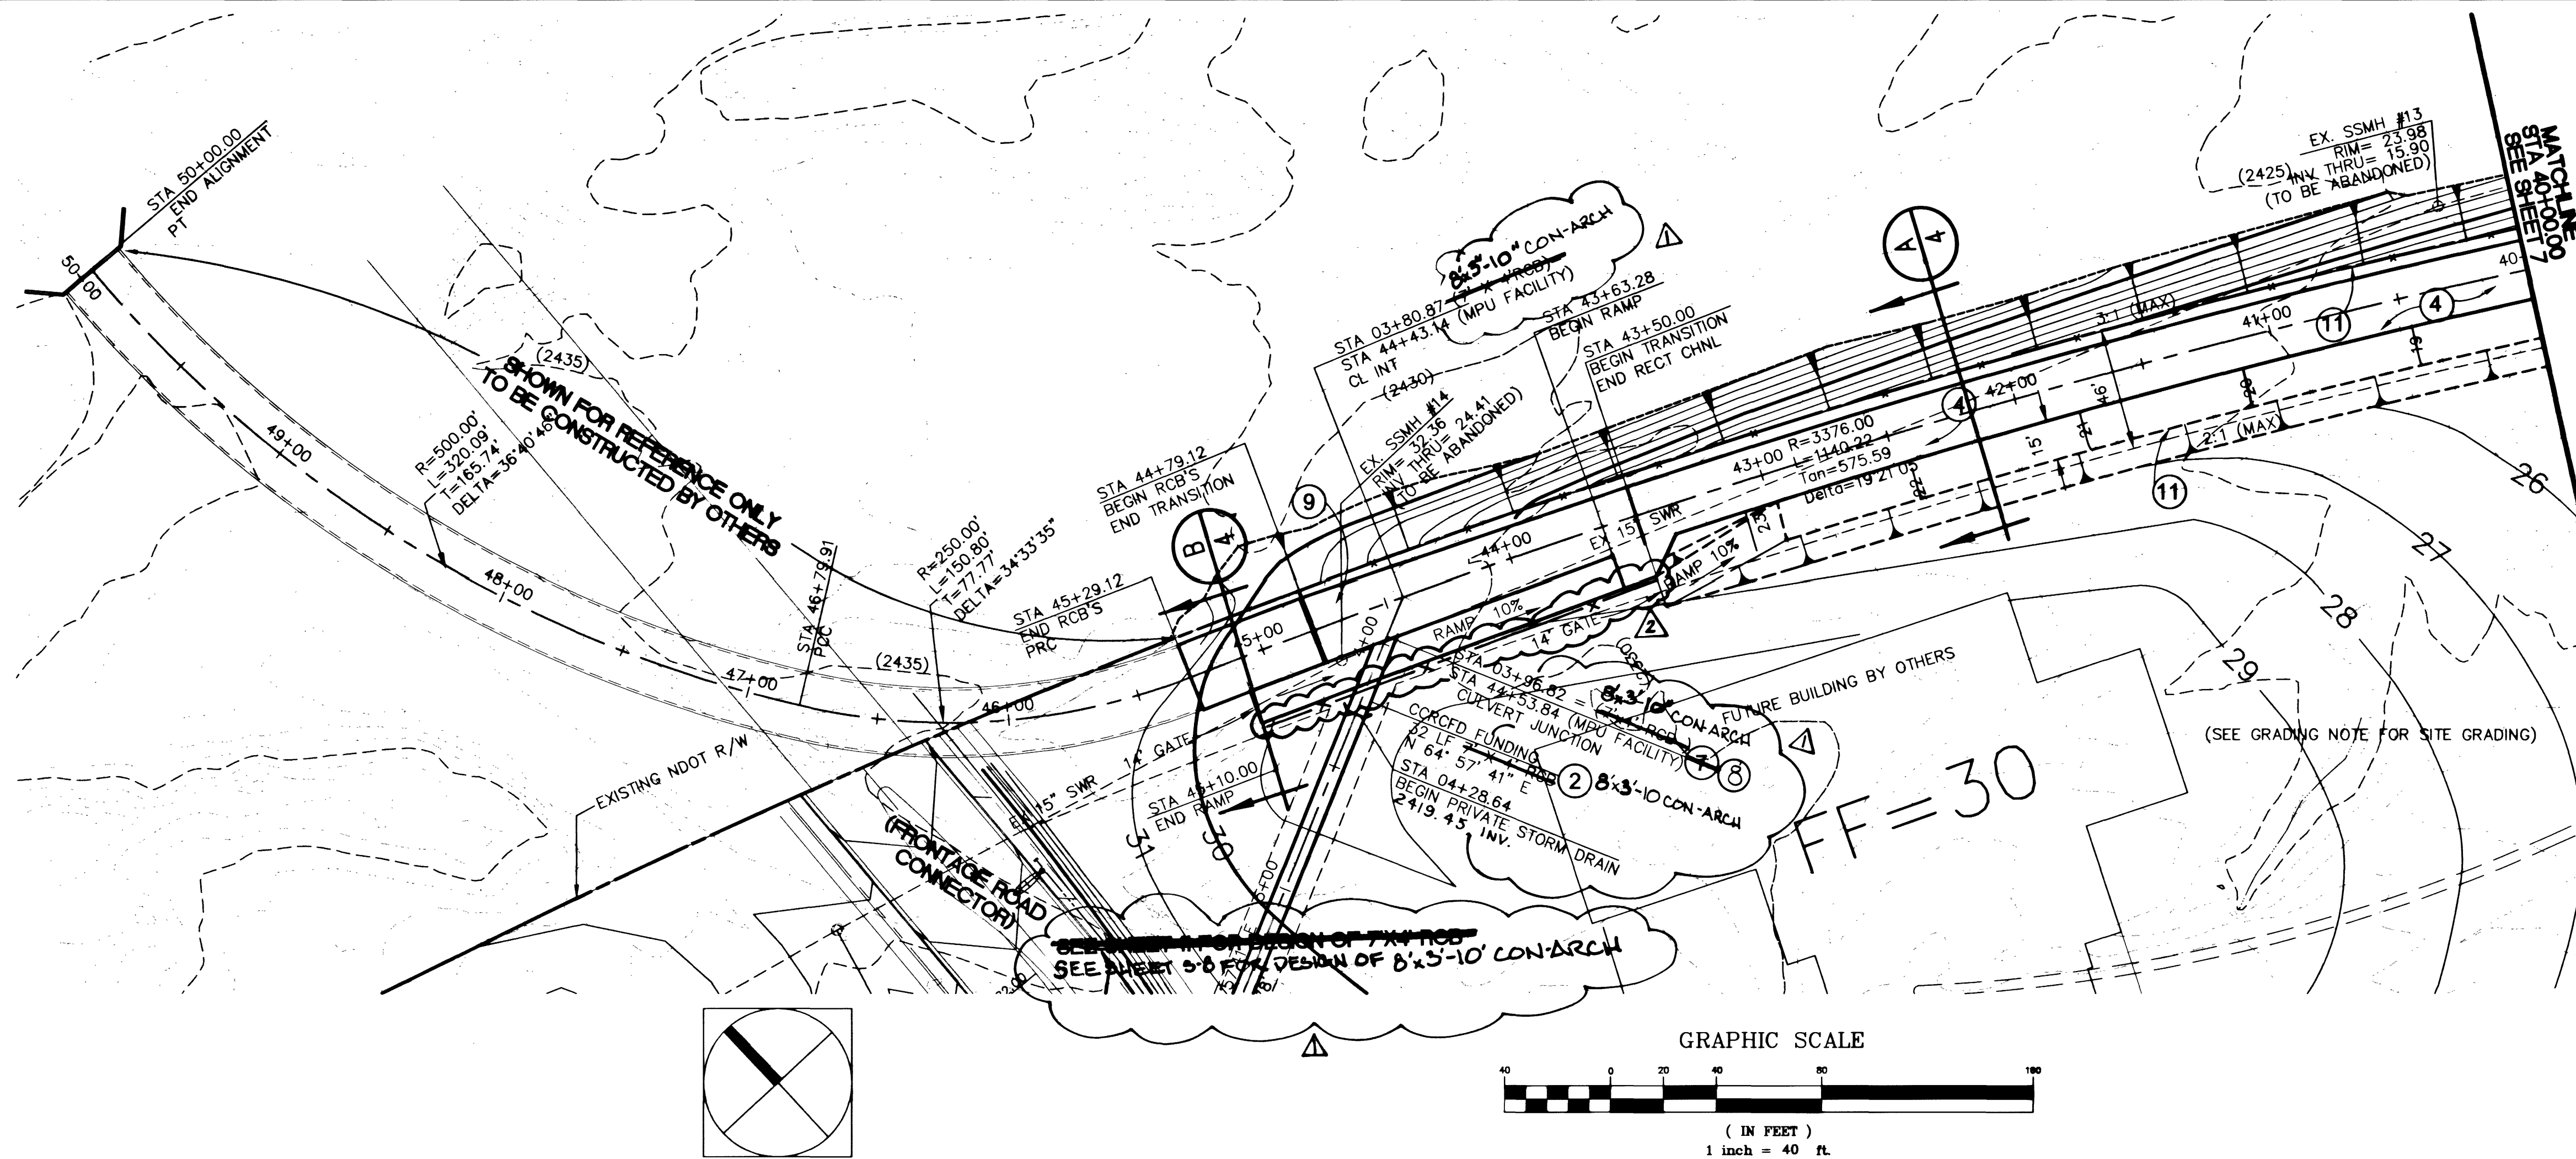

CONSTRUCTION NOTES:

1. CONSTRUCT DOUBLE 12'x8' RECT. CHANNEL PER DETAIL "A" ON SHEET NO. 15 (CAST IN PLACE) ON SHEET S-11.
2. CONSTRUCT 21'x8' RECT. CHANNEL PER DETAIL "A" SHOWN ON SHEET 15. INSTALL CHAIN LINK FENCE PER CLARK COUNTY STD. DWG. NO. 252.
3. CONSTRUCT JUNCTION STRUCTURE PER DETAIL "A" ON SHEET NO. 15 (CAST IN PLACE) ON SHEET S-12.
4. CONSTRUCT 21'x8' RECT. CHANNEL PER DETAIL "A" SHOWN ON SHEET 15. INSTALL CHAIN LINK FENCE PER CLARK COUNTY STD. DWG. NO. 252.
5. CONSTRUCT INLET AND OUTLET STRUCTURES PER DETAILS SHOWN ON SHEETS 11 AND 12.
6. INSTALL RIP RAP PER CLARK COUNTY REGIONAL FLOOD CONTROL DISTRICT REQUIREMENTS (D50=3', T=6').
7. CONSTRUCT JUNCTION STRUCTURE PER DETAIL "A" (SEE SHEET S-10).
8. CONSTRUCT PIER WINDOW PER DETAIL "A" ON SHEET NO. 15 (CAST IN PLACE) ON SHEET S-2.
9. CONSTRUCT TRANSITION CHANNEL PER SHEET 11 SECTION 1/52 (SEE SHEET S-2 SECTION 1/52).
10. PROVIDE A 15' WIDE ACCESS ALONG SIDE OF THE OPEN CHANNEL. INSTALL CHAIN LINK FENCE PER CLARK COUNTY STD. DWG. NO. 252.
11. INSTALL CHAIN LINK FENCE PER CLARK COUNTY STD. DWG. NO. 252.
12. INSTALL RIP RAP PER CLARK COUNTY REGIONAL FLOOD CONTROL DISTRICT REQUIREMENTS (D50=6', T=1').
13. CONSTRUCT DOUBLE 12'x8' RCB'S PER DETAIL "C" ON SHEET NO. 15 (CAST IN PLACE).
14. CONSTRUCT TRANSITION CHANNEL PER SHEET S-13, DETAIL "M".

NOTE:

EXISTING 15" SANITARY SEWER TO BE ABANDONED PRIOR TO CONSTRUCTION

GRADING NOTE:


PRECISE GRADING PLAN FOR THIS AREA TO BE SUBMITTED WITH FUTURE PLANS. CONTOURS SHOWN ARE MASS-GRADING TO BE CONSTRUCTED WITH CHANNEL.

BASIS OF BEARING:

NORTH 88°42'47" EAST FROM THE NORTHWEST CORNER OF SECTION 28, TOWNSHIP 19 SOUTH, RANGE 60 EAST, M.D.M., MARKED WITH A 3" BLM BRASS CAP, STAMPED "1956" TO THE NORTH QUARTER CORNER OF SAID SECTION 28, MARKED WITH A 1-1/2" ALUMINUM CAP, PER RECORD MAP OF SURVEY FOR NORTHWEST-WESTERN SEGMENT OF THE LAS VEGAS BELTWAY, RECORDED IN FILE 89, PAGE 3, OF SURVEYS, CLARK COUNTY RECORDS, NEVADA.


BENCHMARK:

CITY OF LAS VEGAS
STATION 11V90 33NES
RIVET & PLATE IN TOP OF CURB, ANN ROAD & BUFFALO DRIVE, SOUTH CURB LINE
ELEV = 723.0679 (METERS) NAVD88 DATUM
3.28083333 U.S. SURVEY FEET = 1 METER
ELEVATION = 2372.265 FEET

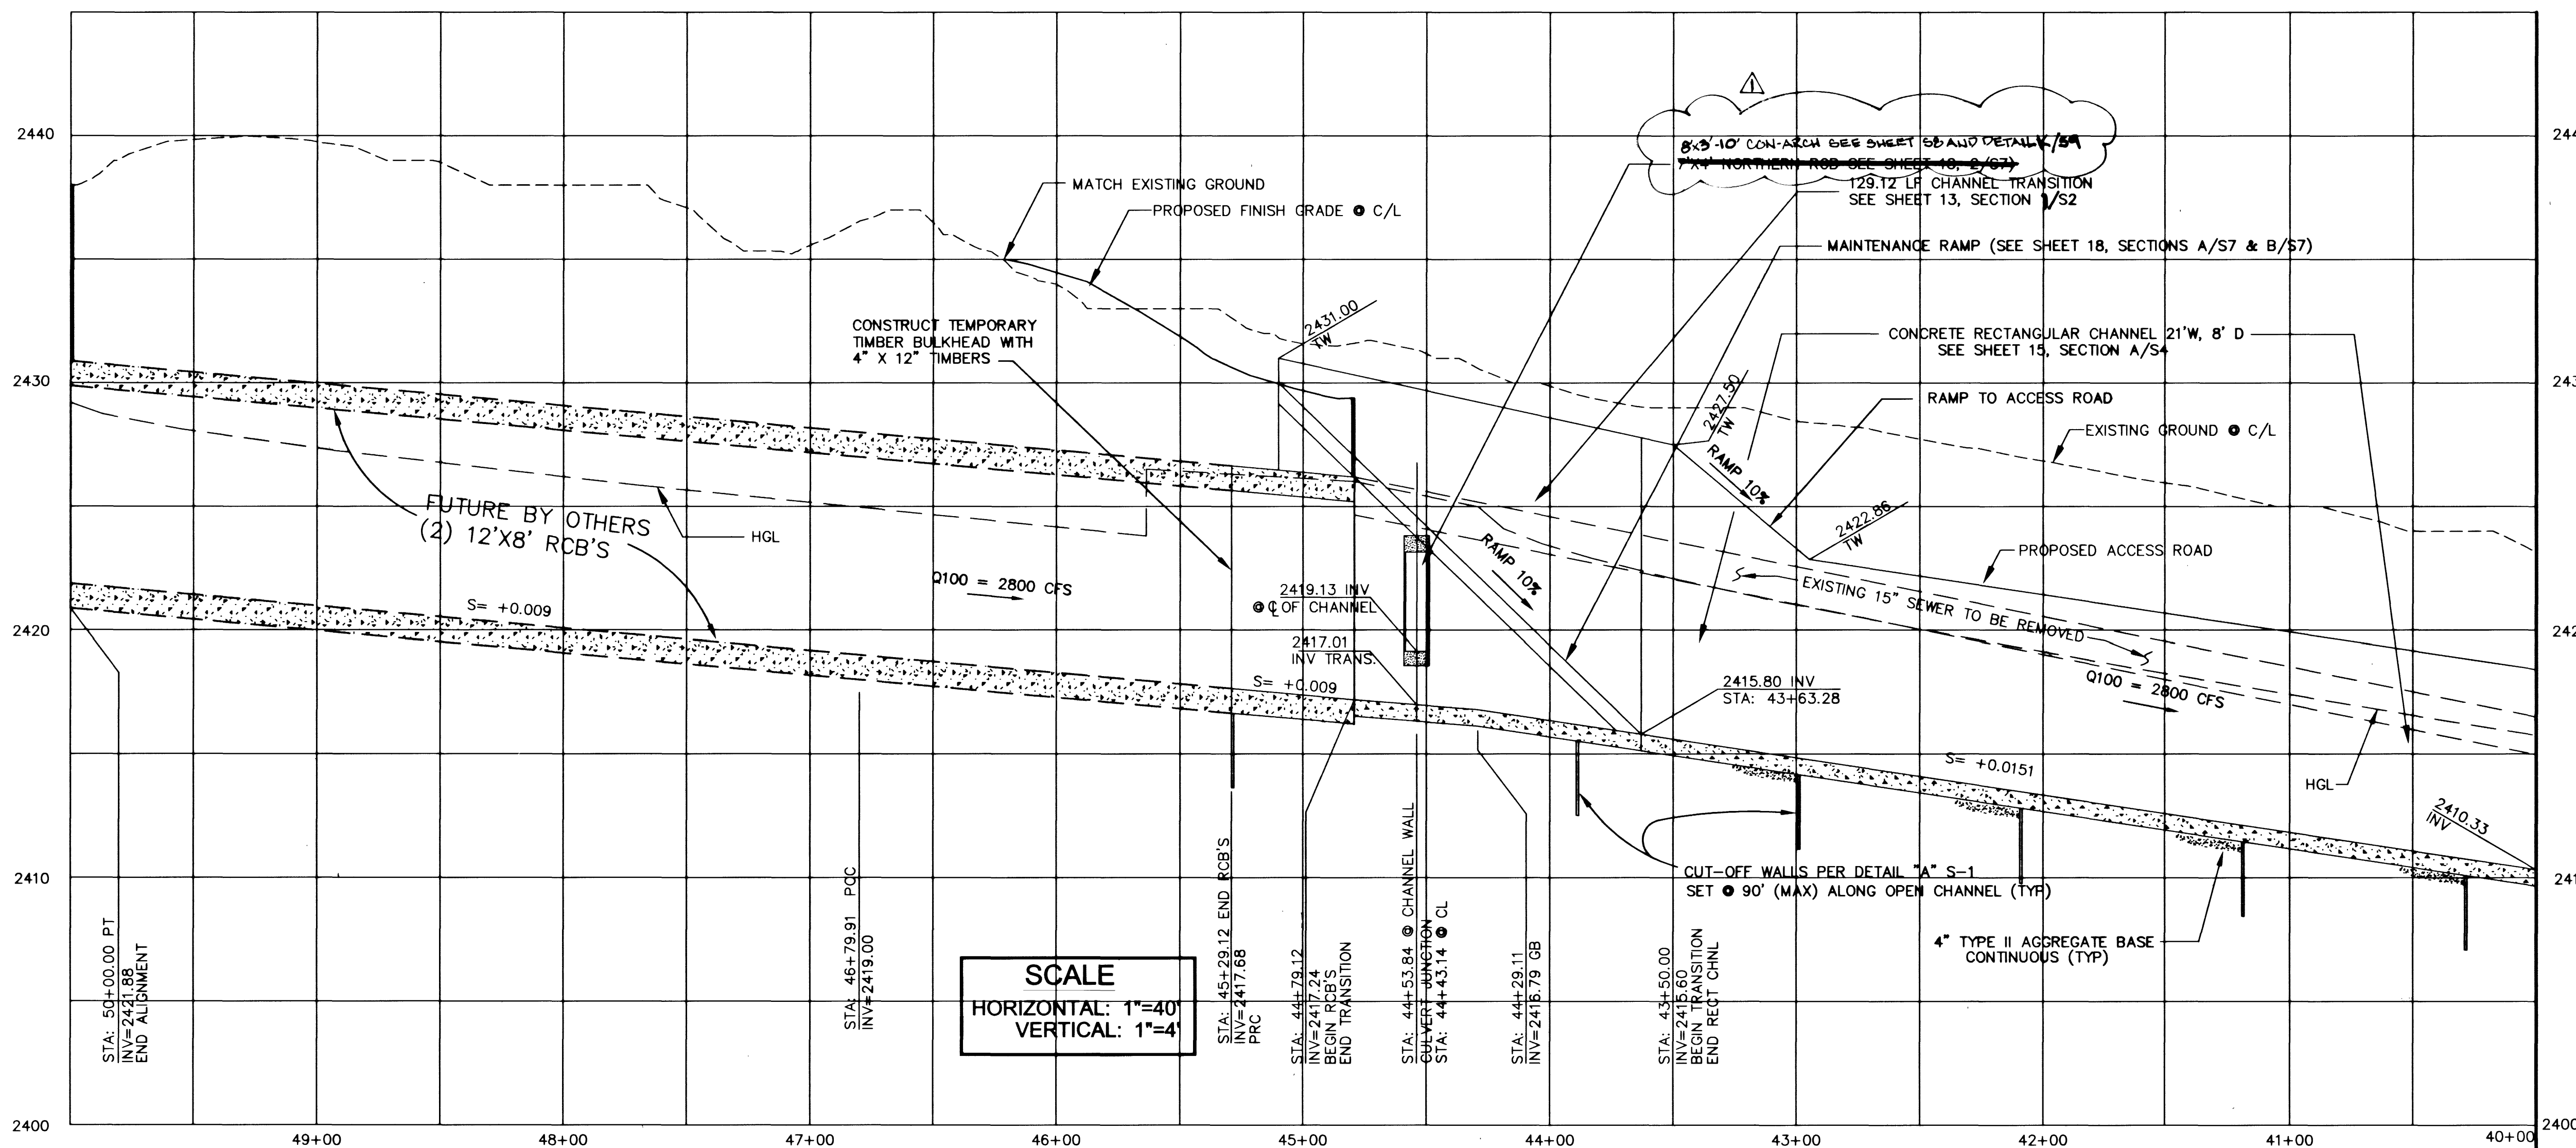

Call before you OVERHEAD
1-702-593-6111
ELECTRIC, GAS, CABLE, TELEPHONE, SATELLITE

Call before you Dig.
1-800-227-2600
UNDERGROUND SERVICE ALERT (USA)

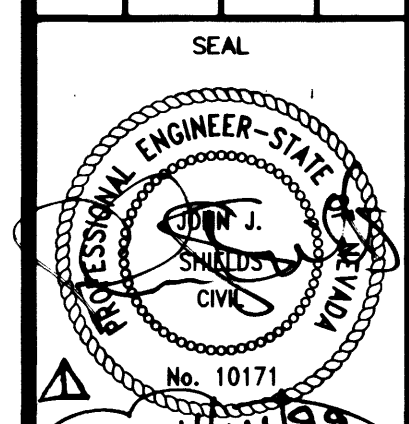

SHEET
C-1
6 OF 24 SHEETS
DRAWING NO.
107-V-370

STA: 40+00.00 TO STA: 44+79.12
PLAN AND PROFILE
CENTENNIAL CENTRE
MPU FACILITY RCHO 0097
CITY OF LAS VEGAS

7448 W. SAHARA AVENUE
LAS VEGAS, NEVADA 89107
(702) 222-1440
Engineers/Planners/Surveyors
205 East Warm Springs Road, Suite 108
LAS VEGAS, NV 89119 (702) 886-6604

CENTENNIAL CENTRE
A Limited Liability Company
EKN
ENGINEERING

REV	DATE	BY	REVISION

