




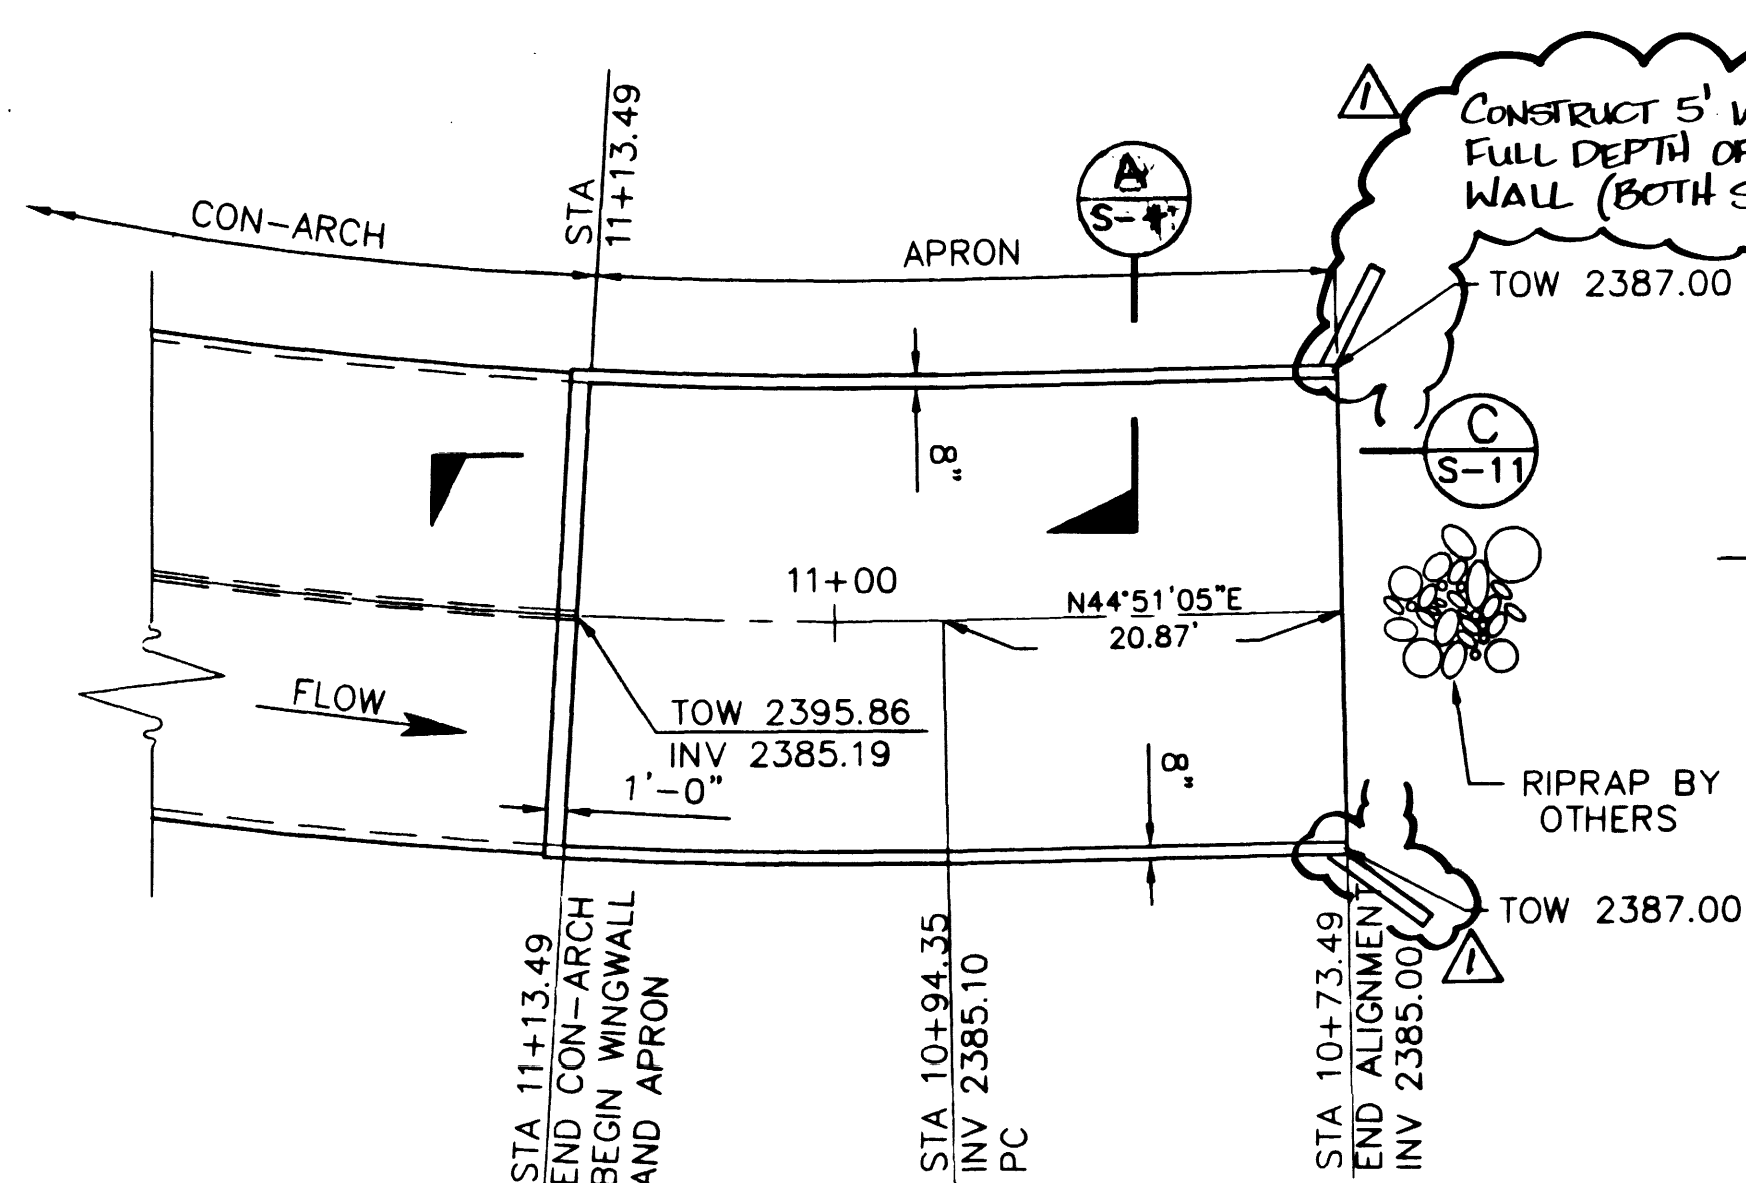



(E) OUTLET DETAIL
1"=10'

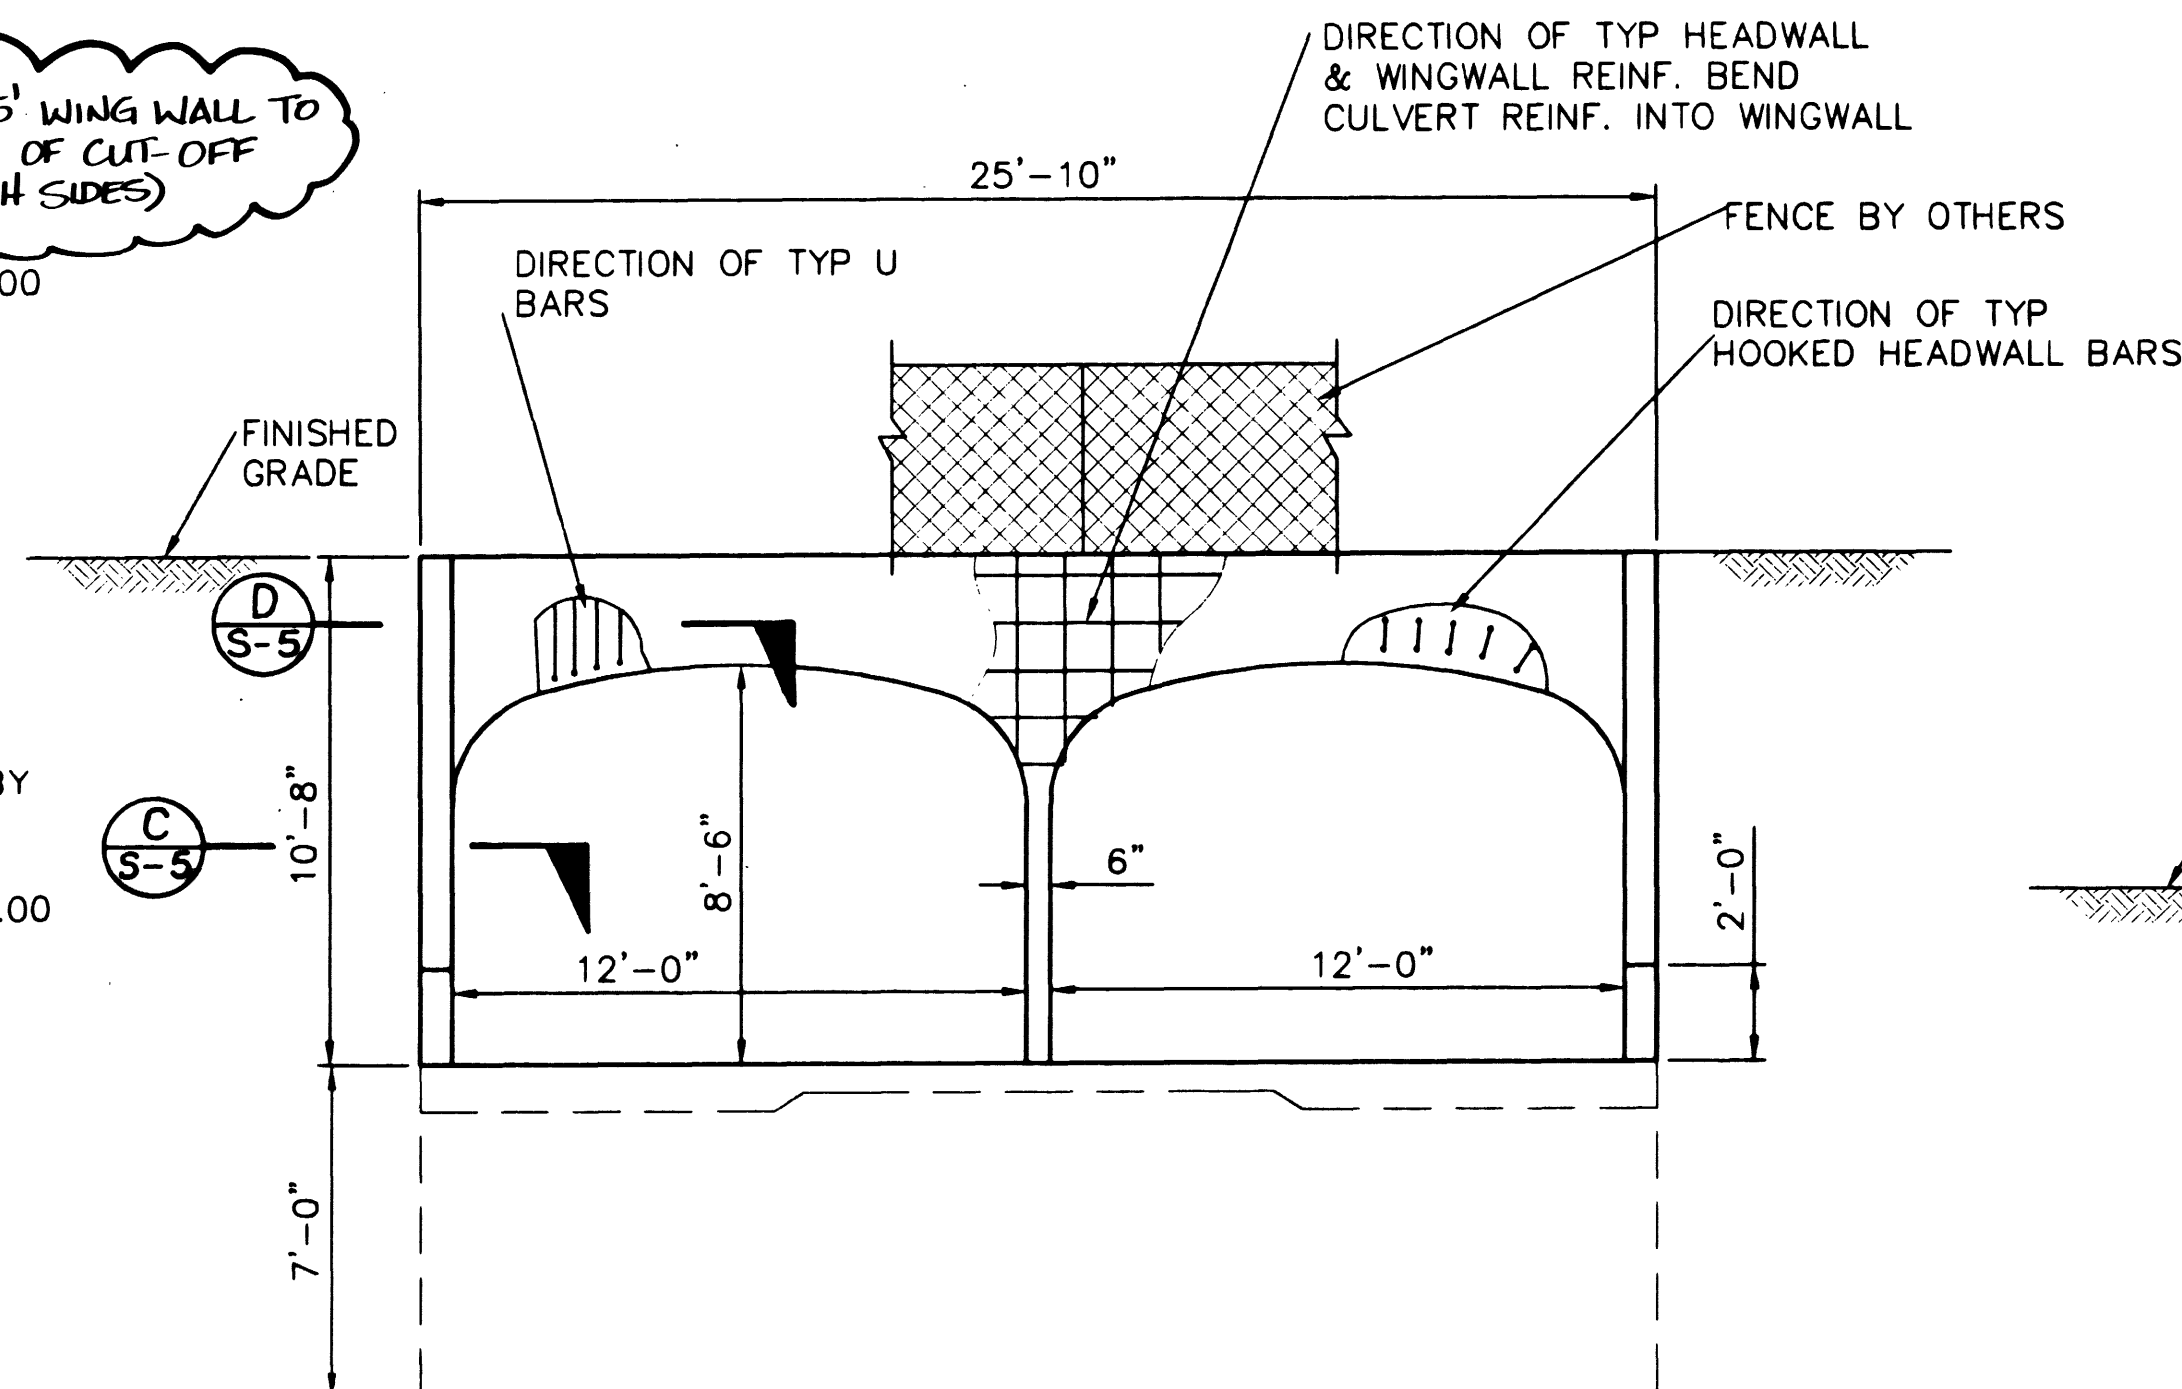


(F) OUTLET ELEVATION
STA 11+13.49 1/4"=1'-0"

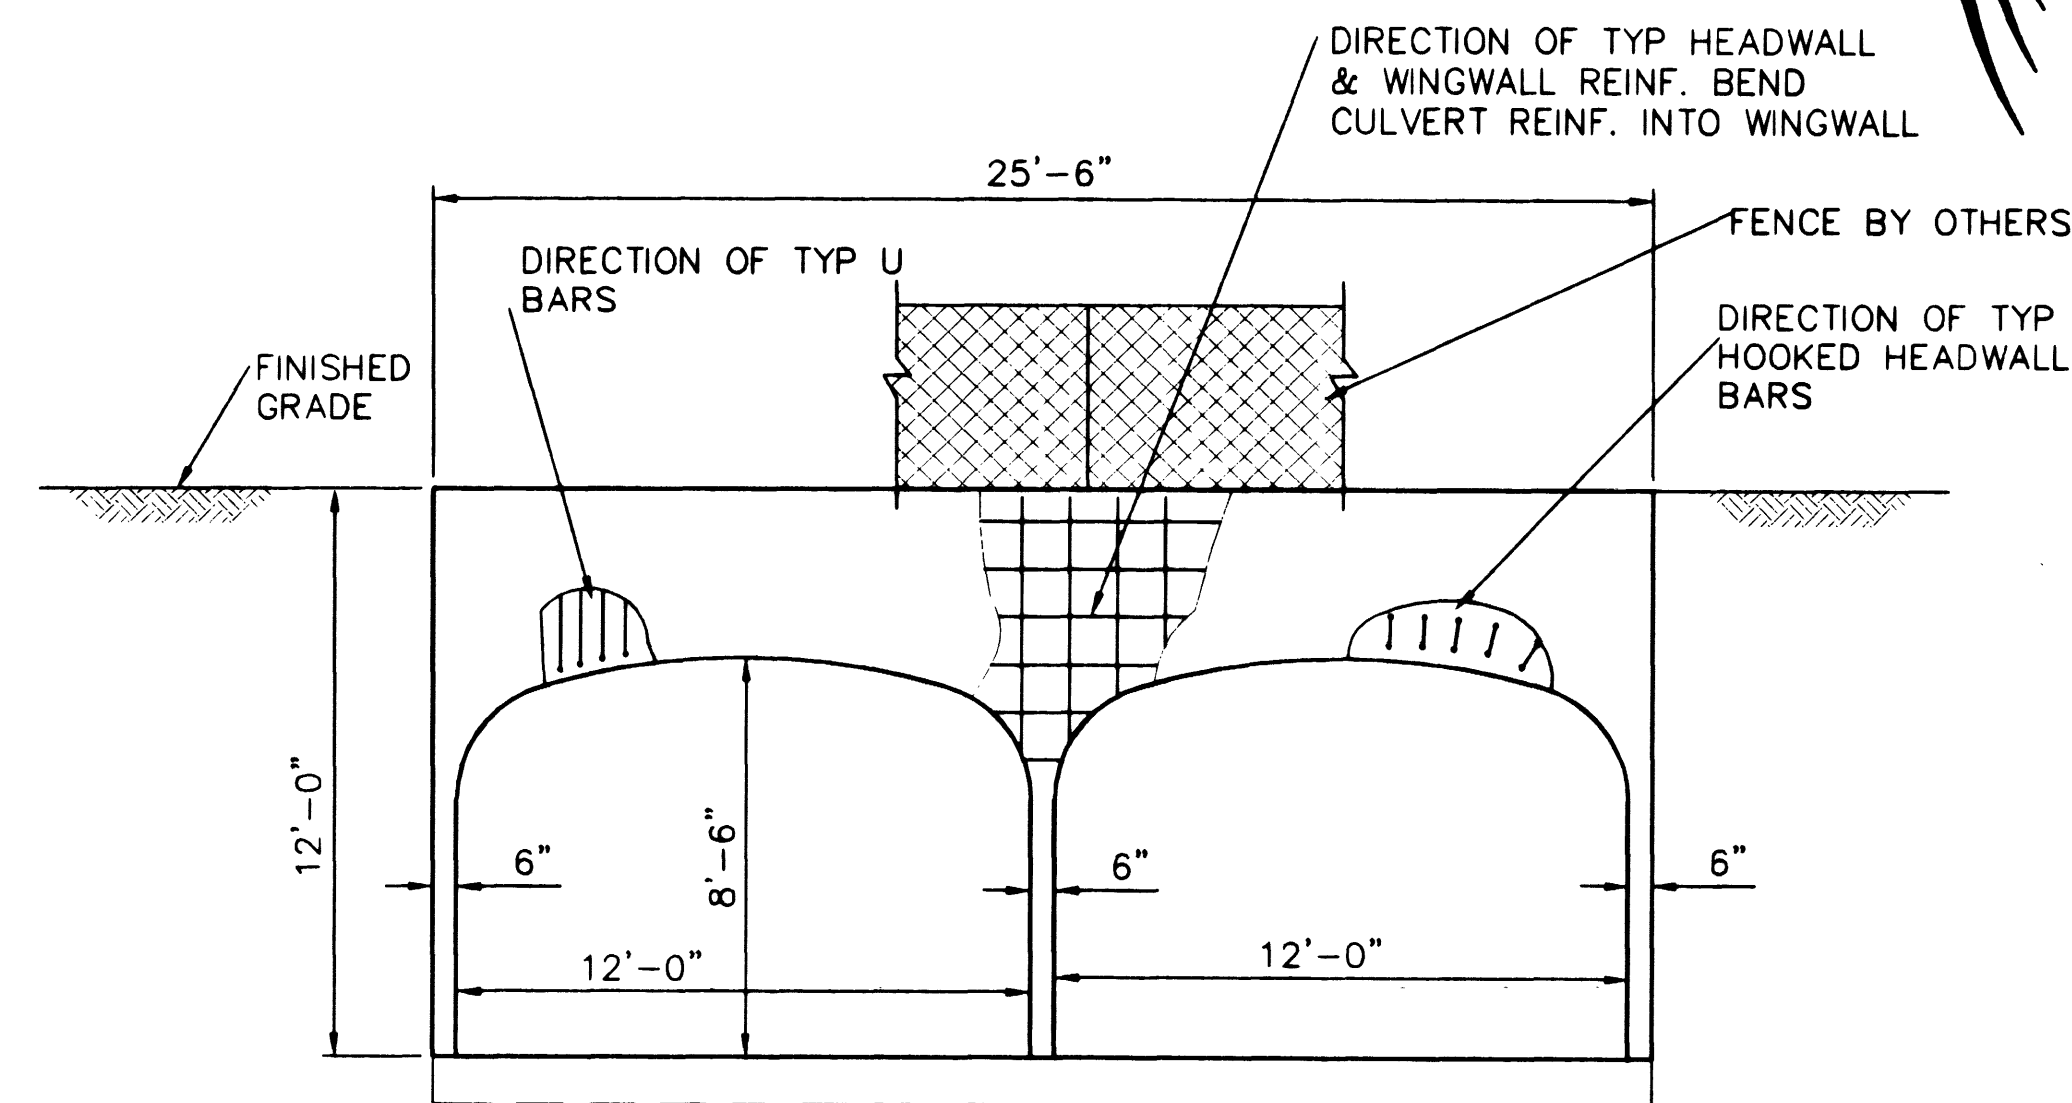

(G) INLET ELEVATION
STA 28+32.73 1/4"=1'-0"

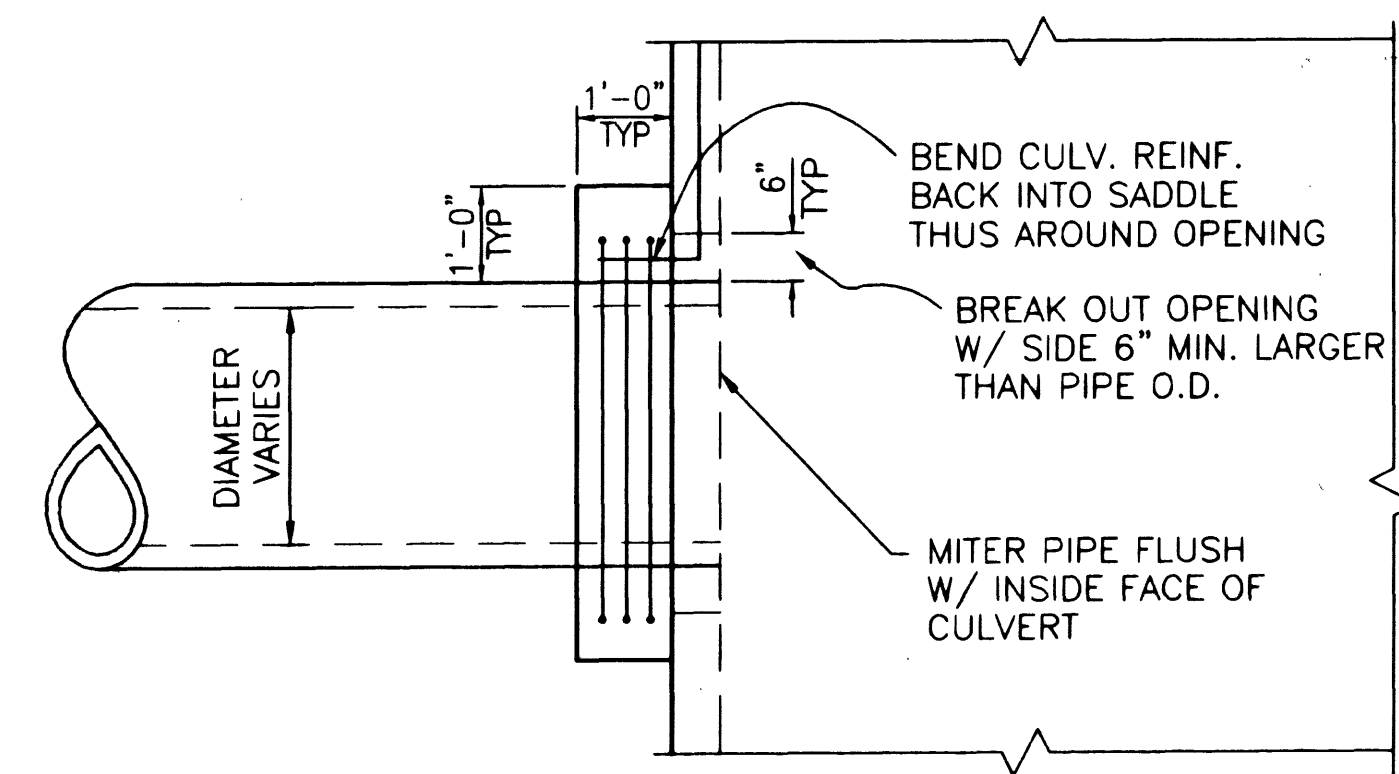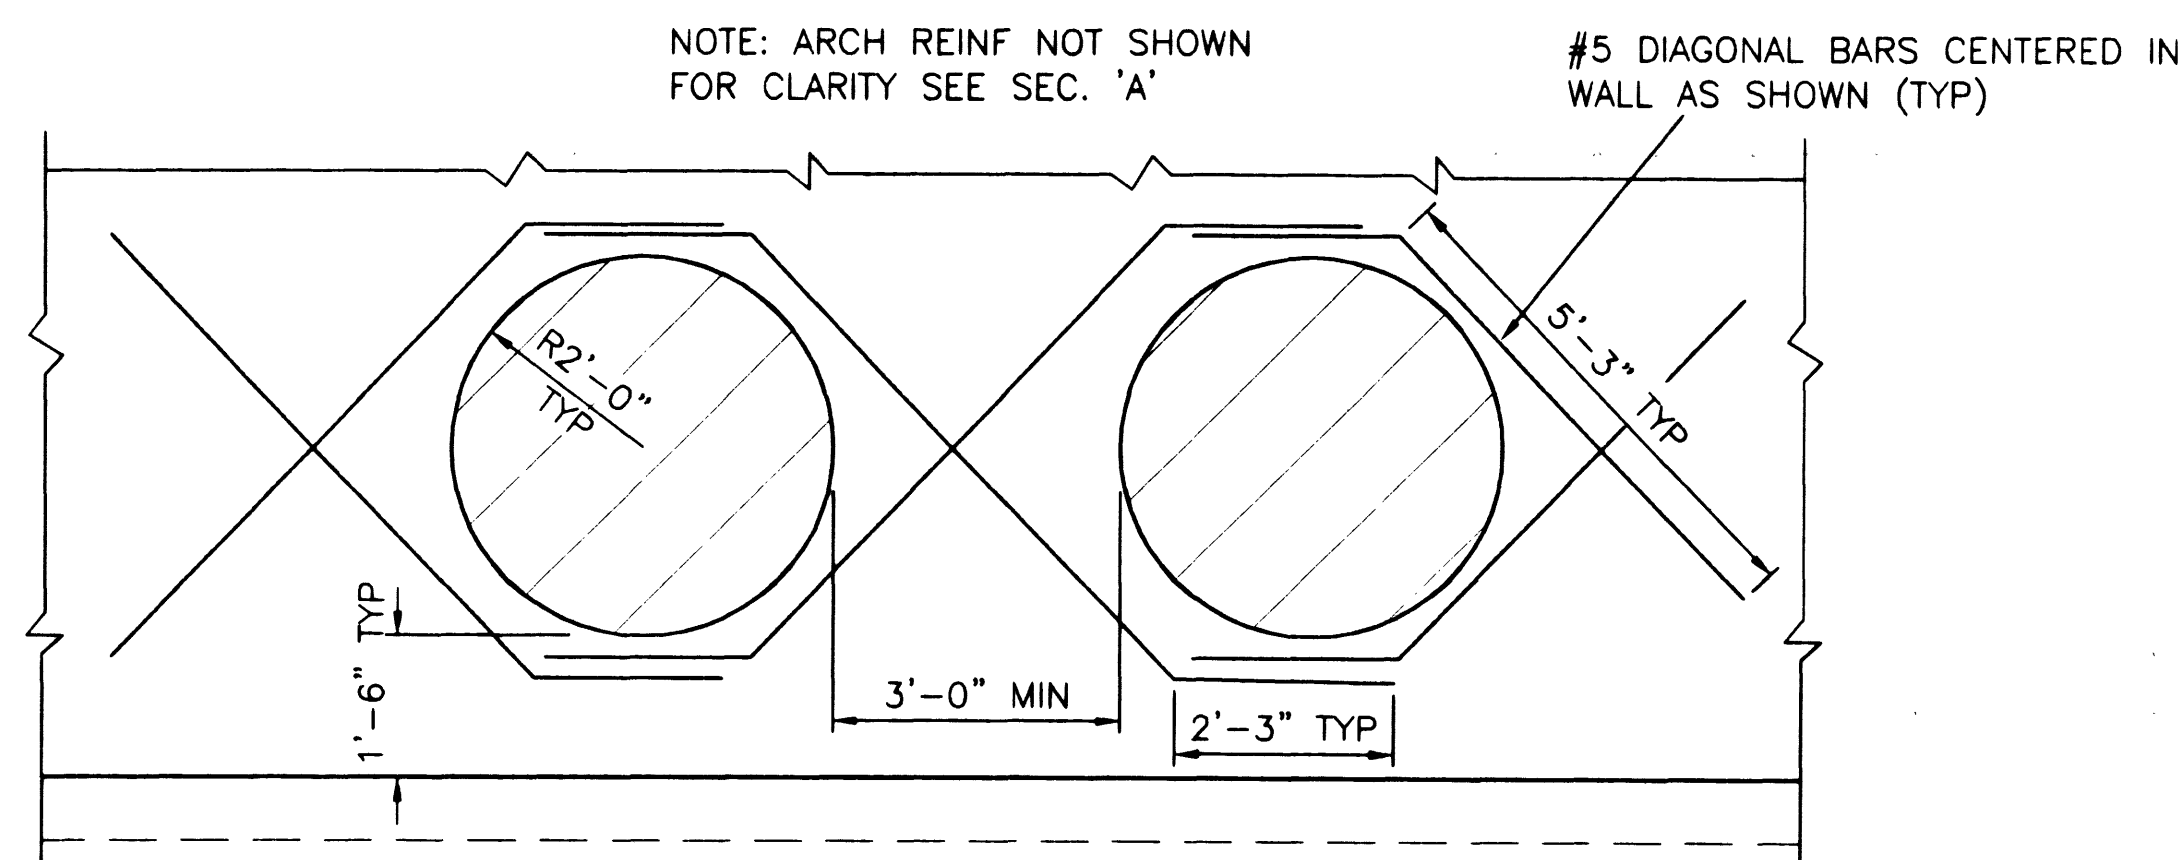


PLAN

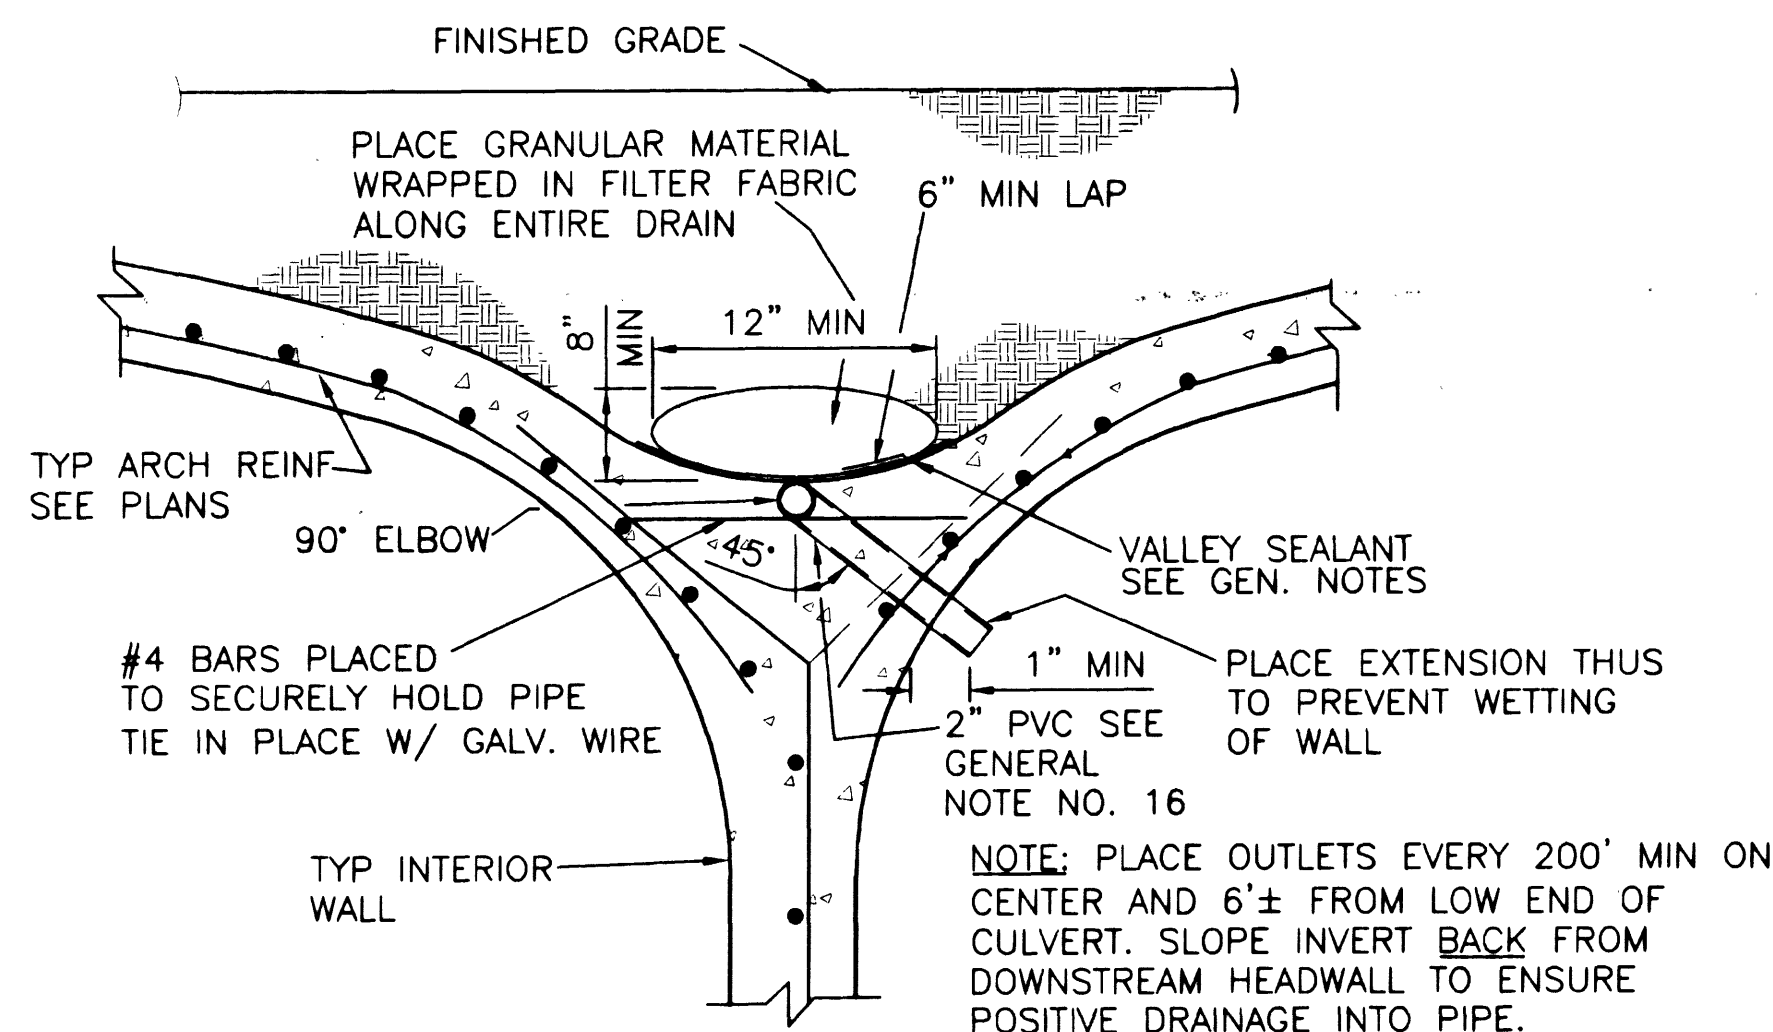


(I) TYP WEEPHOLE DETAIL
1"=1'-0"


(K) TYPICAL BALANCE PORT OPENING
1/2"=1'-0"

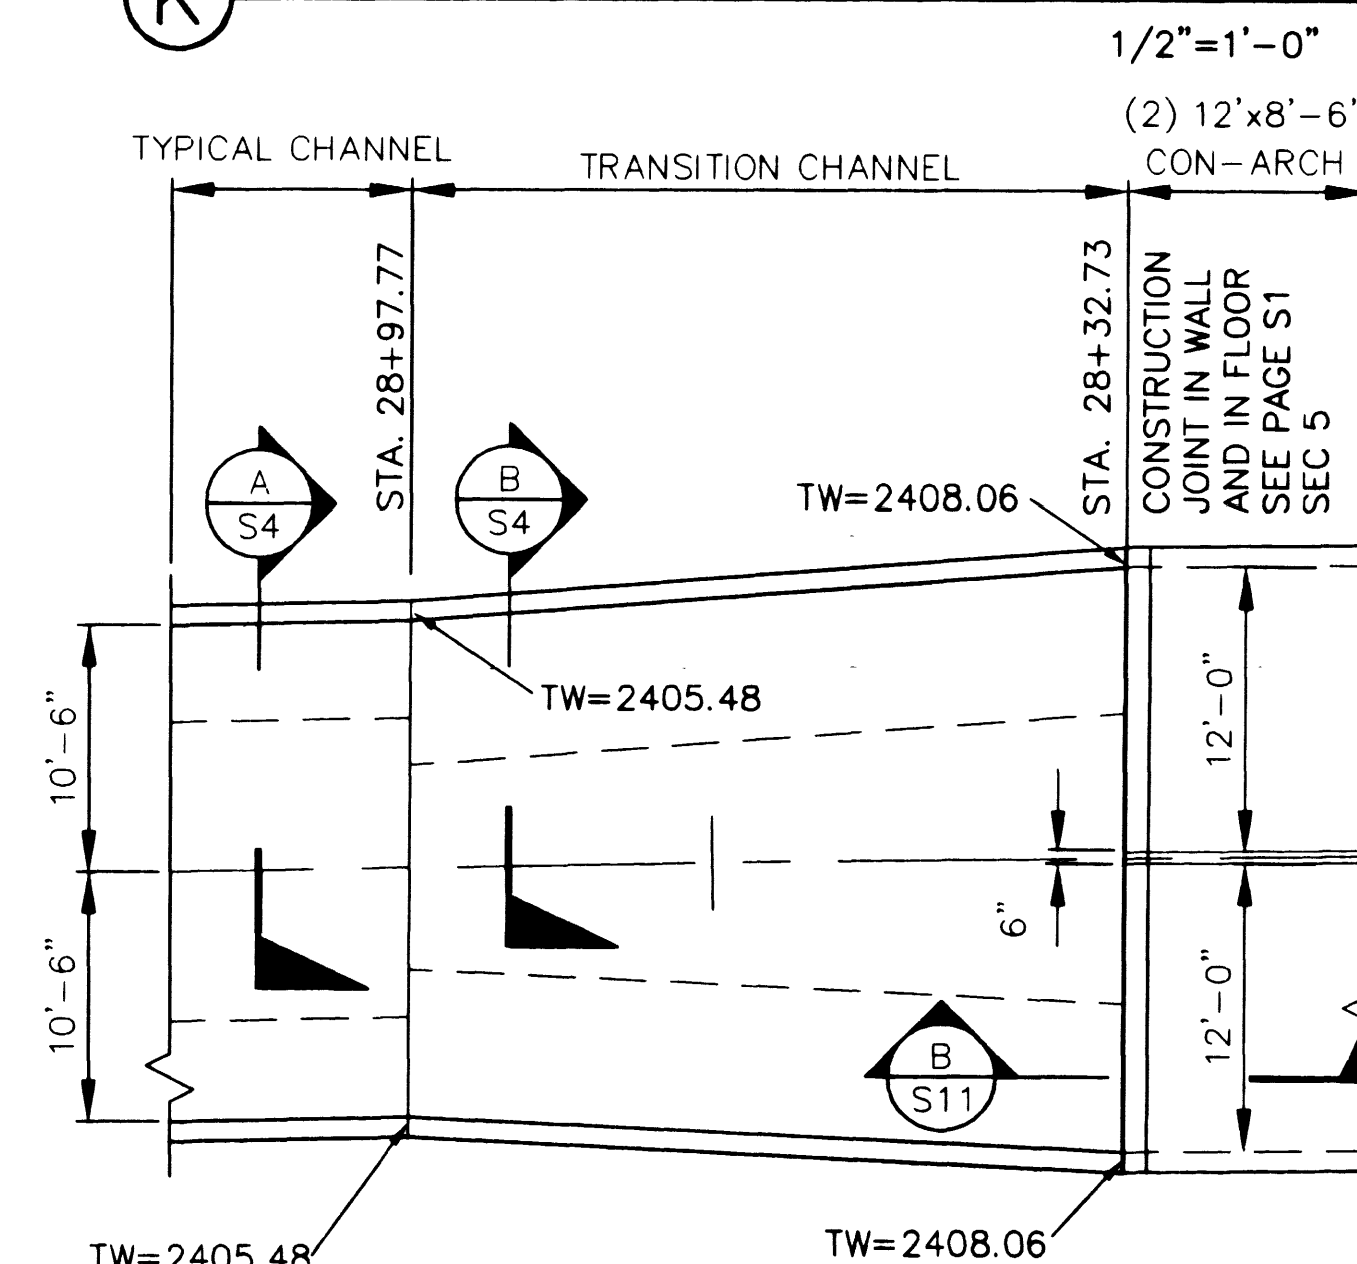

(L) TRANSITION DETAIL @ INLET
1/8"=1'-0"

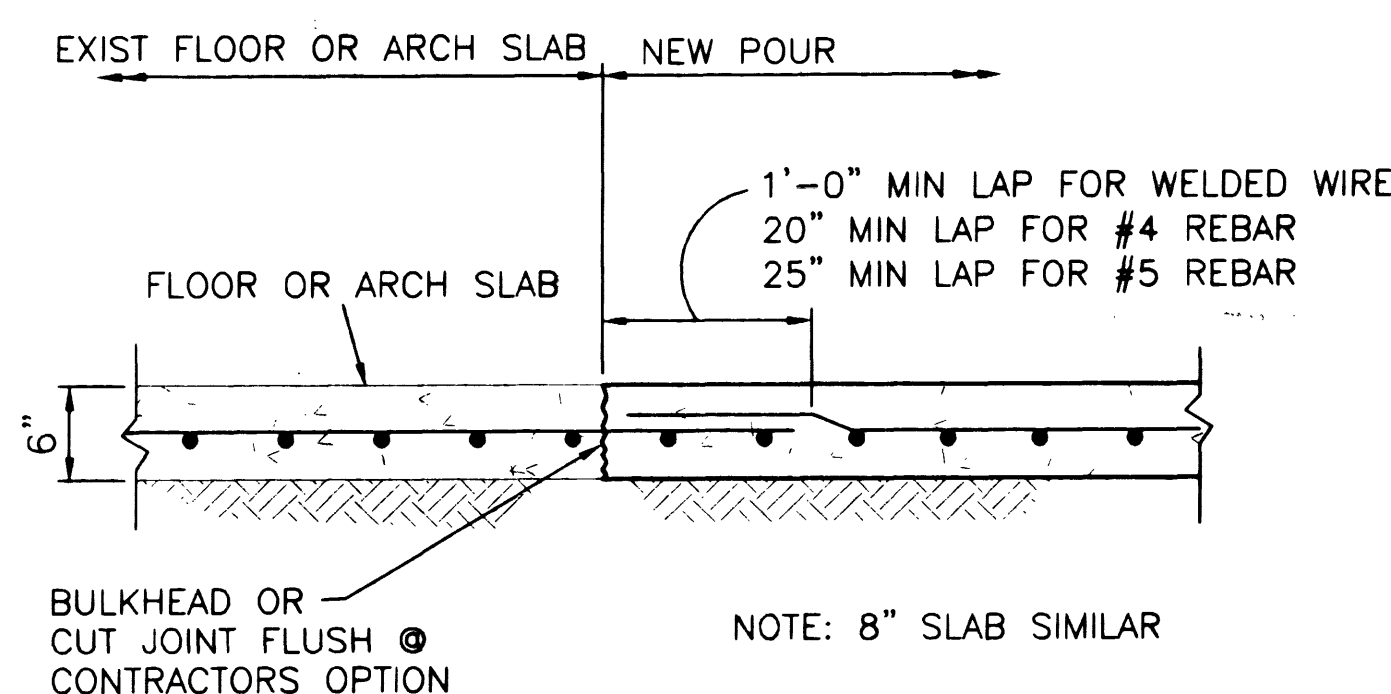

(J) FLOOR OR ARCH JOINT DETAIL
1"=1'-0"

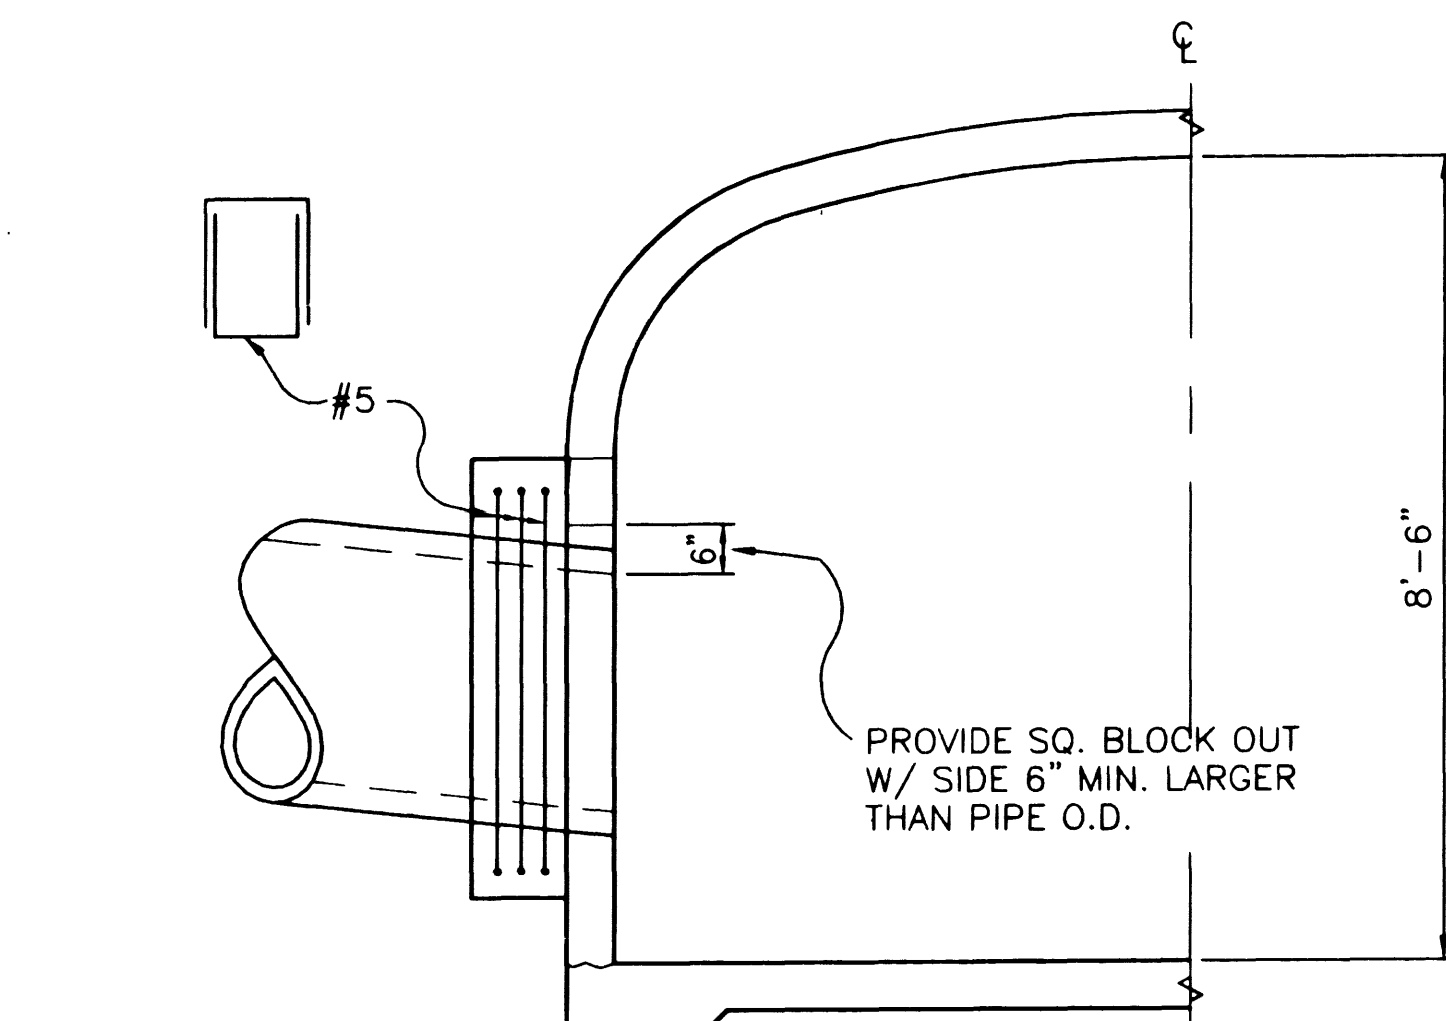


(H) PIPE PENETRATION DETAIL
1/2"=1'-0"




CON-ARCH
NOTE: These drawings and the information contained herein are the property of C.L. Watson Engineering, Inc. and are not to be reproduced, stored in a retrieval system, or transmitted in any form or by any means, electronic, mechanical, photocopying, recording, or by any information storage and retrieval system, without the prior written permission of C.L. Watson Engineering, Inc. The unauthorized use of these drawings is strictly prohibited.

107-V3170 SHEET S-12 23 OF 24 SHEETS DRAWING NO. 99-104 SCALE: AS NOTED PROJECT NO. 10039 CHECKED BY: J. SAKRA DESIGNED BY: T. SAKRA DRAWN BY: A. SAKRA		3/14/00 3/14/00 3/14/00 SHEET MAIN CON-ARCH DETAILS CENTENNIAL CENTRE CITY OF LAS VEGAS NEVADA MPU FACILITY RCHO 0097		WATSON ENGINEERING, LLC CONSULTING ENGINEERS 2450 WEST POPPY AVENUE TUCSON, ARIZONA 85705 PH: (520) 888-6468 FAX: (520) 292-6974 CENTENNIAL CENTRE A Limited Liability Company 7448 W. SAHARA AVENUE LAS VEGAS, NEVADA 89117 (702) 222-1410		3/14/00 3/14/00 3/14/00 REV DATE BY REVISION	
--	--	--	--	---	--	---	--

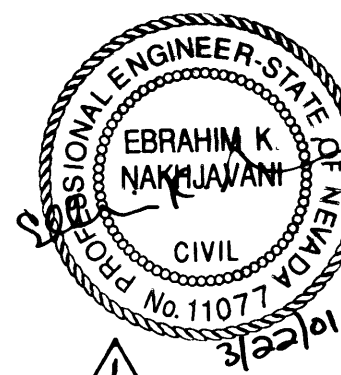


SEAL PERTAINS ONLY TO WORK RELATED TO CON-ARCH CULVERT STRUCTURE, SURVEY DATA, INVERT ELEVATIONS & HYDRAULIC ANALYSIS PROVIDED BY OTHERS.

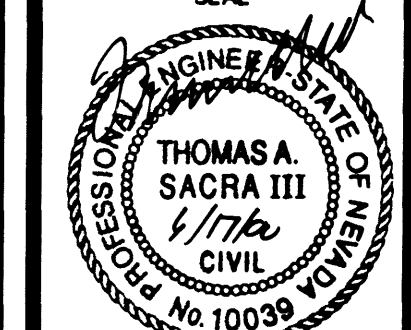






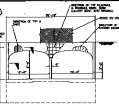



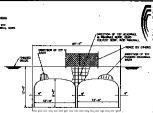


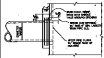



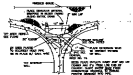






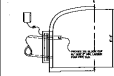





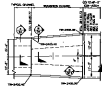






