


Avoid cutting underground utility lines. It's costly.

Call before you Dig.

1-800-227-2600

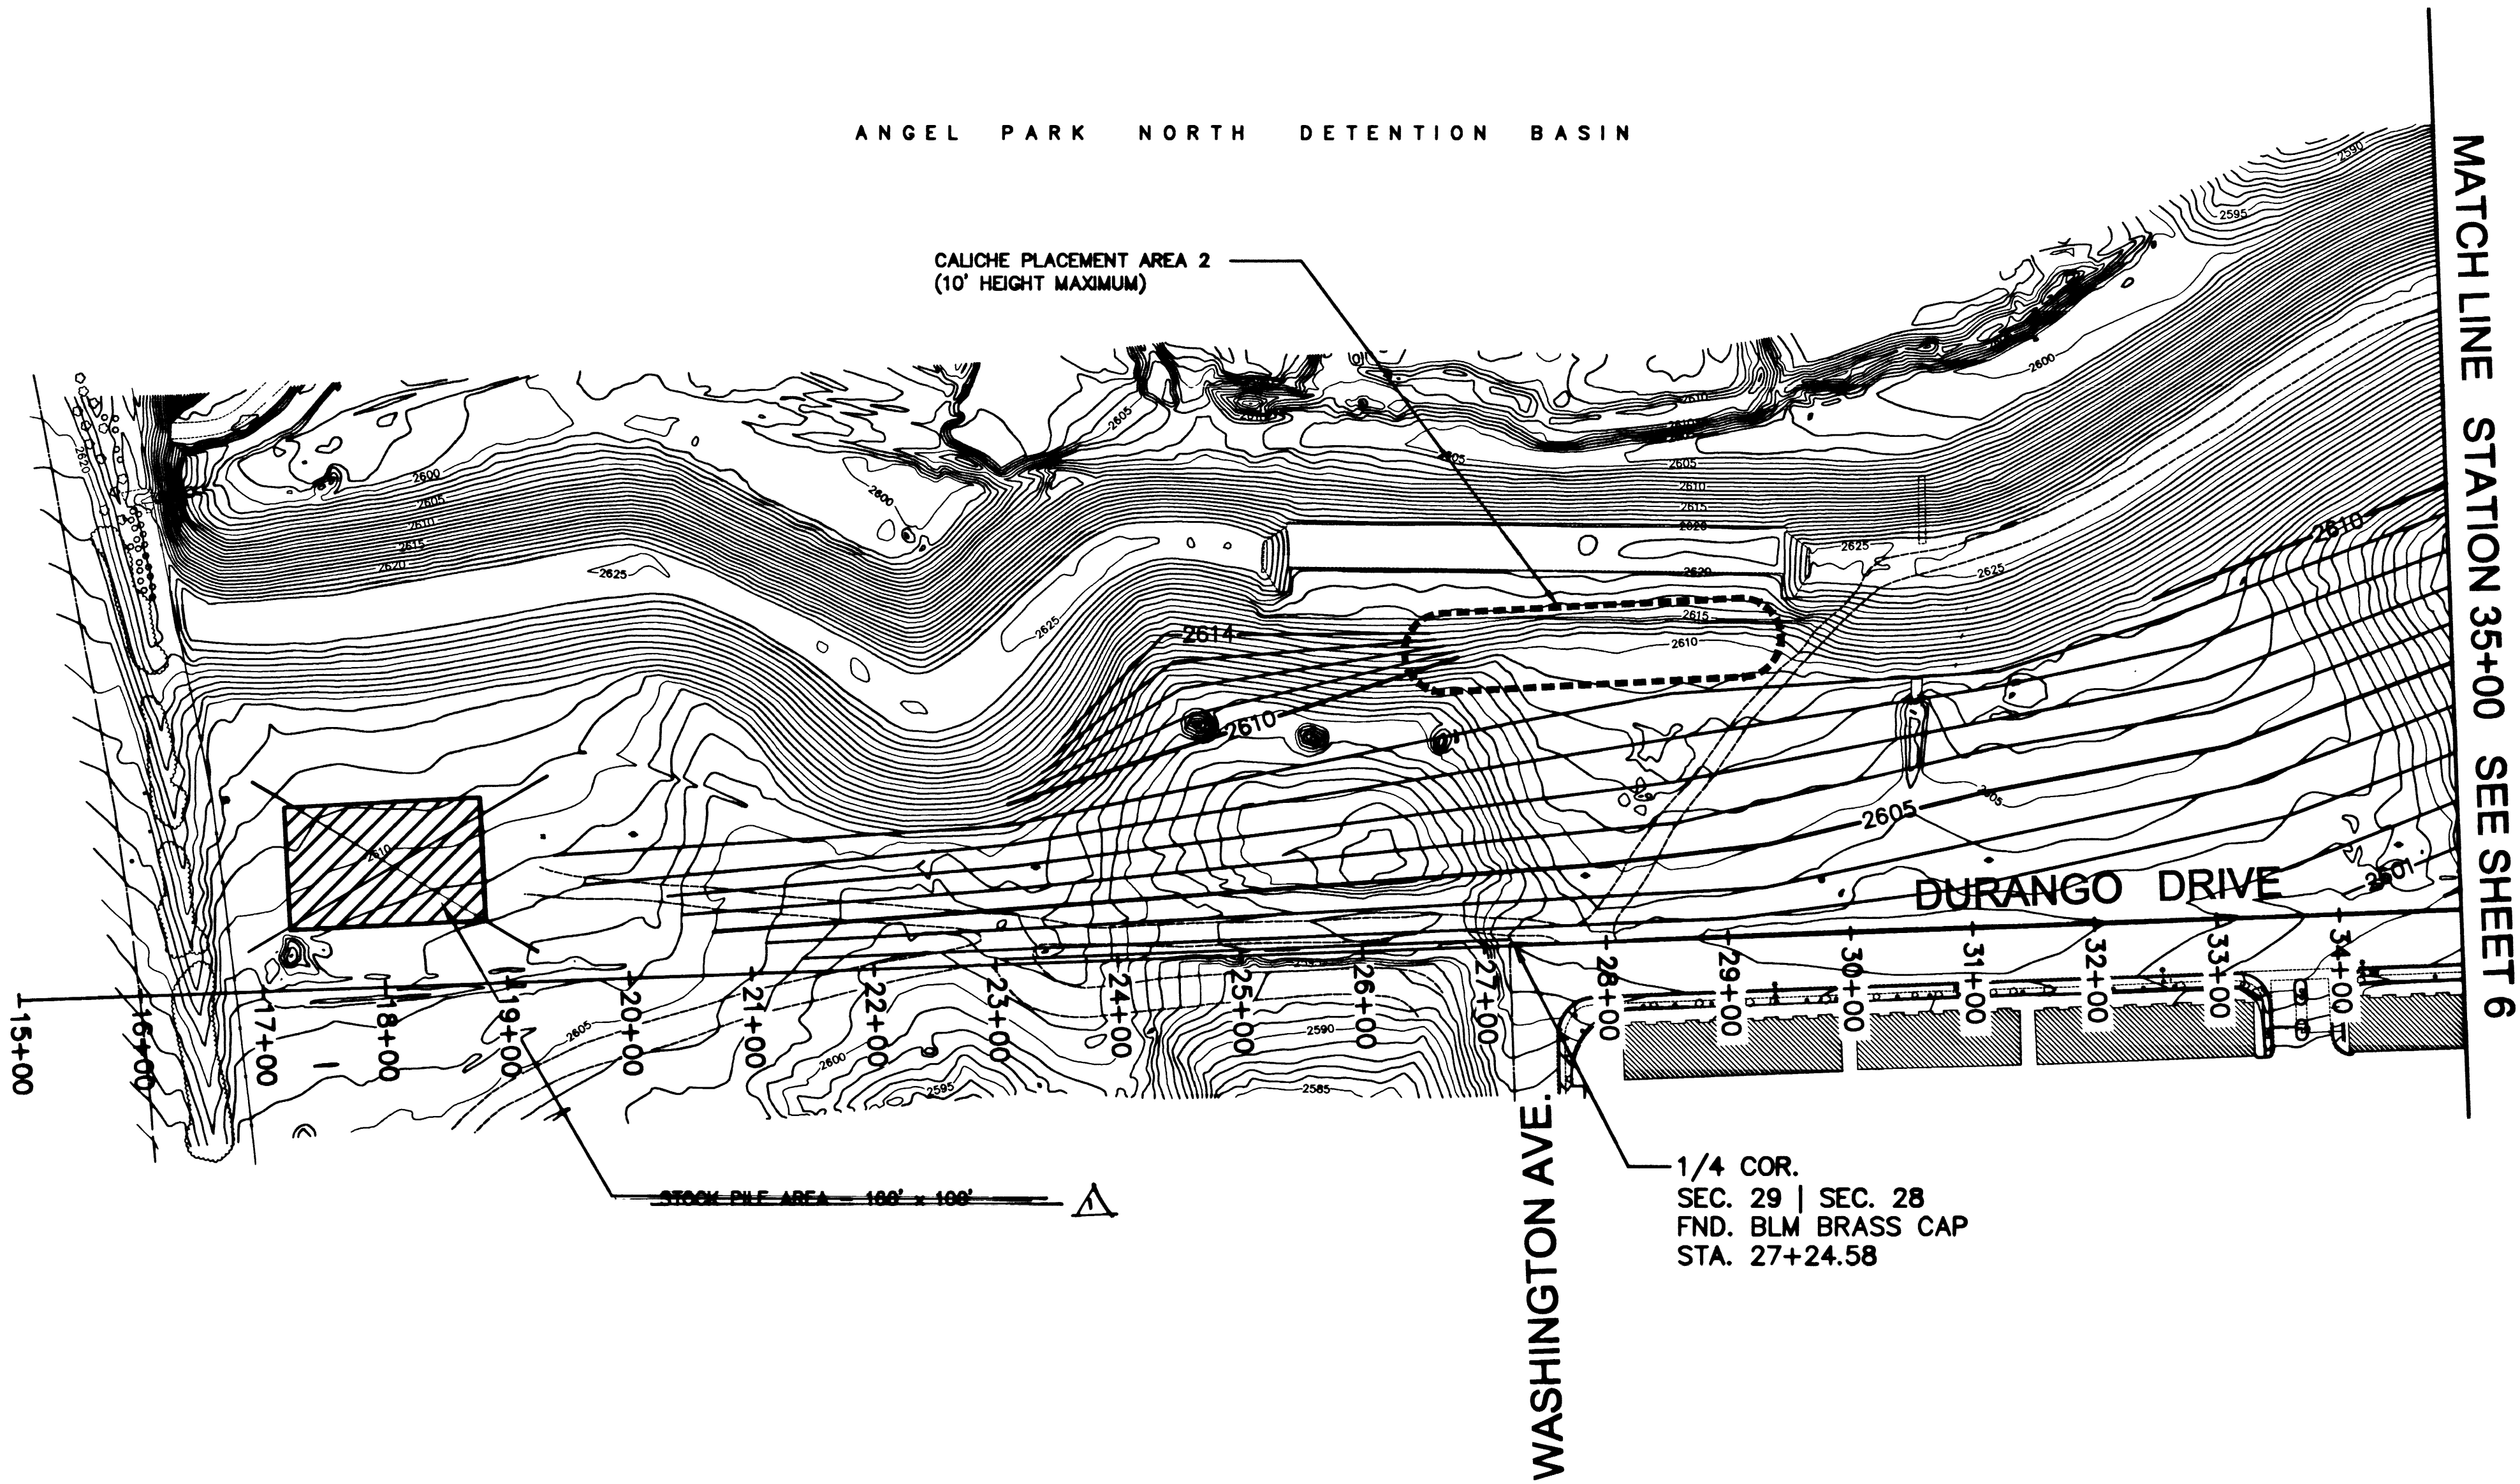

- CALICHE PLACEMENT NOTES
1. PLACE ONE ROW AT A TIME FOR THE LENGTH OF THE AREA SHOWN ON THE PLANS OR AS DIRECTED BY THE ENGINEER
- △ INCLUDE CALICHE PLACEMENT IN UNIT COST FOR EXCAVATION

	SHEET: DURANGO PLAN VIEW STATION 15+00 TO 35+00		PROJECT: ANGEL PARK NORTH DETENTION BASIN PHASE 3 EXCAVATION AND GRADING			SCALE (H) 1" = 100' FLD. BK. #	SCALE (V) N/A DATE 6/99	W.A. # DESIGN BY R.E.	REVISIONS △ REVISION BY DAY 3-16-01	DATE
	DEPARTMENT OF PUBLIC WORKS									

PROJECT ENGINEERING
CONSULTANTS, LTD.
7320 SMOKE RANCH ROAD, SUITE H
LAS VEGAS, NV. 89128

DRAWING NO. 731-49F 5/26