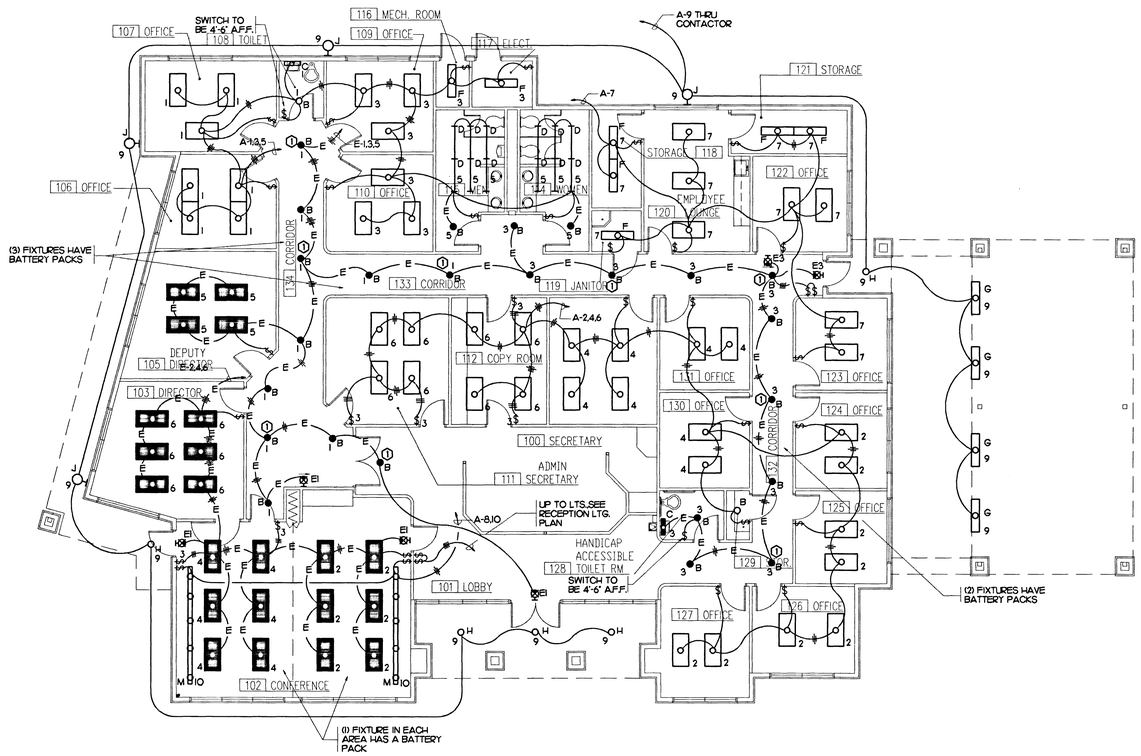


## LIGHTING FLOOR PLAN

SCALE: 1/8"=1'-0"

NORTH

| LIGHTING FIXTURE SCHEDULE | | | | | | | | | |
|---|---|---|---|---|---|---|---|---|---|
| FIXTURE TYPE | VOLT | FLUOR | INCAN | OTHER | MOUNTING | LAMP(S) | CONTROL MEDIA (LENS, LOUVER, ETC.) | MANUFACTURER'S CATALOG NUMBER(S) | DESCRIPTIONS AND/OR REMARKS |
| A | 120 | X | | | RECESSED | (4)F40/D841/SS | 32 CELL PARABOLIC LOUVER | LITHONIA 2PM4GB440-32S-120-ES | |
| B | 120 | X | | | RECESSED | (2) F26DTT | CLEAR ALZAK | LITHONIA AF2/26QT6AR | |
| C | 120 | X | | | SURFACE | (2) F30WW | ACRYLIC PRISMATIC DIF. | LITHONIA W230 120 | MOUNT 6" ABOVE MIRROR |
| D | 120 | X | | | SURFACE | (2)F40/D841/SS | LUMINOUS CEILING | LITHONIA ALC240120 ES | SEE ARCH. DETAILS |
| D1 | 120 | X | | | SURFACE | (2)F30WW | LUMINOUS CEILING | LITHONIA ALC-230120 ES | |
| E | 120 | X | | | RECESSED | F8T5 | STENCIL FACE | LITHONIA F2RPWIRCA 120 F2RPWIRC 120 | 4 WITHOUT ARROWS 2 WITH ARROWS |
| E1 | 120 | X | | | SURFACE | (2)F8T5 | EDGE-LIT EXIT SIGN | LITHONIA F2RP-X-1-RC-120 | VERIFY COLOR WITH ARCHITECT |
| F | 120 | X | | | SURFACE | (2)F40 D841/SS | ACRYLIC PRISMATIC DIFFUSER | LITHONIA VC 240A 120 ES | |
| G | 120 | X | | | SURFACE | (2)F40 D841/SS | POLYCARBONATE | KENALL 7140-0 | |
| H | 120 | | | HPS | RECESSED | LU50/D/MED | CLEAR ALZAK | LITHONIA AH50S6AR | |
| J | 120 | | | HPS | SURFACE | LU50S | POLYCARBONATE | LITHONIA TWL50S120 | |
| K | 120 | | | HPS | 25'SQ.STEEL POLE | LU150S | TEMPERED GLASS LENS | LITHONIA 150KSI 150S RBF | |
| L | 120 | | | HPS | SURFACE | LU50S | GLASS LENS | ELLIPTIPAR H452050S | PROVIDE FOR NIGHT-TIME AIMING TO LIGHT SIGN AND BUILDING |
| M | 120 | | X | | SURFACE | 50W, R20 | BLACK BAFFLE | HALO L762C WITH L651W TRACK | SEE PLANS FOR TRACK LENGTH, CIRCLES INDICATES QUANTITY OF FIXTURES, WHITE TRACK CHROME FIXTURE |

## GENERAL NOTES

THIS SYMBOL INDICATES A TYPE "A" LIGHT FIXTURE UNLESS NOTED OTHERWISE

## NOTES

1. THIS FIXTURE IS A NIGHT LIGHT TO BE ON 24/DAY.




## RECEPTION LIGHTING PLAN

SCALE: 1/8"=1'-0"

NORTH

AS-BUILTS
10-1-1992
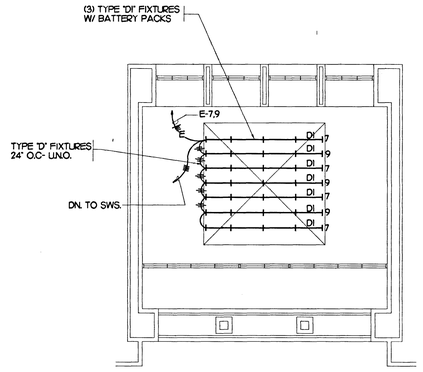
| REVISIONS | | | |
|---|---|---|---|
| REV | DESCRIPTION | DATE | BY |
| | | | |

© DOMINGO CAMBEIRO CORPORATION 1990

DUNHAM ASSOCIATES
CONSULTING ENGINEERS
MECHANICAL / ELECTRICAL
3075 East Flamingo Road, Suite 100
Las Vegas, NV 89121
(702) 369-7011 FAX (702) 369-5853

All designs, arrangements and plans indicated or presented by this drawing, as instruments of service, are owned by and the property of DOMINGO CAMBEIRO CORPORATION. The use of these plans and/or specifications shall be restricted to the original site for which they were prepared and publication thereof is expressly limited to such use. Reproduction, publication or re-use by any method, in whole or part, is prohibited. None of such designs, arrangements or plans shall be used by or disclosed to any person, firm, agency, or corporation without the written permission of DOMINGO CAMBEIRO CORPORATION. Visual contact with these plans and specifications shall constitute prima facie evidence of acceptance of these restrictions.

DRAWN BY: M.Z.
CHECKED BY: R.G.K.
ISSUED DATE: 1-16-1992

LIGHTING PLAN

ADMINISTRATION BUILDING
DETENTION FACILITY EXPANSION
CITY OF LAS VEGAS, NEVADA

Domingo Cambeiro Corporation
INTERIORS
PLANNING
ENGINEERING
ARCHITECTURE
3555 PECOS-McLEOD IC. LAS VEGAS, NEVADA 89121 (702) 732-0084



E1.01

FILE NO.: 91HERVIZING
JOB NO.: 91139

515-55Z