## NOTES

1. PROVIDE UNISTRUT RACK TO SUPPORT DISCONNECT SWITCH.
2. 60 AMPS RATED - 3R
3. 30 AMPS RATED - 3R
4. A. TRANSFER SWITCH - A.T.S. 70A,208/120V,4P,4W
5. 60A LIGHTING CONTACTOR - 4 HOLE SQUARE D SERIES 8903
6. TIME SWITCH FOR EXHAUST FAN, TORK #7100

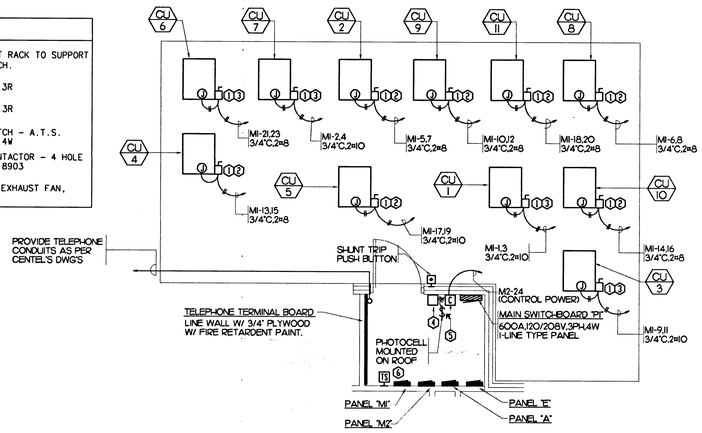


## CONDENSING UNIT PAD AND ELECTRICAL ROOM DETAIL

SCALE: 1/4"=1'-0"

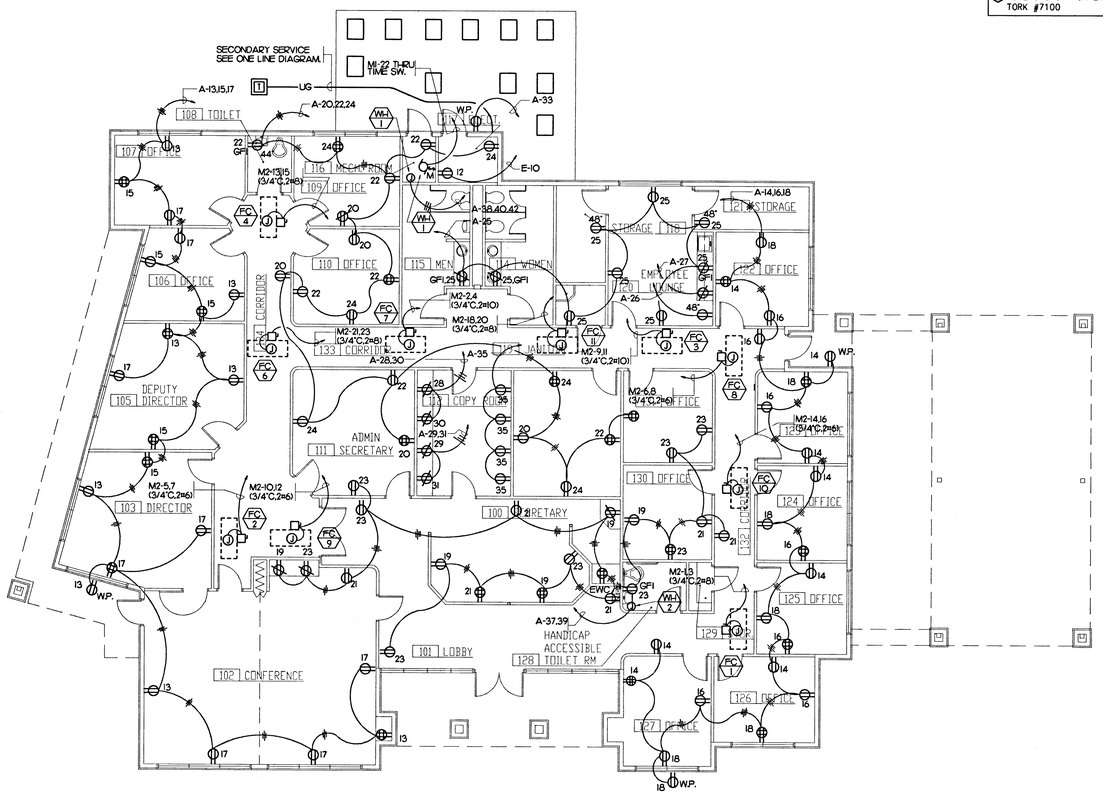


## POWER FLOOR PLAN

SCALE: 1/8"=1'-0"

NORTH

AS-BUILTS
10-1-1992

| REVISIONS | | | |
|---|---|---|---|
| REV | DESCRIPTION | DATE | BY |
| | | | |

© DOMINGO CAMBEIRO CORPORATION 1990

DUNHAM ASSOCIATES
CONSULTING ENGINEERS
MECHANICAL / ELECTRICAL
3075 East Flamingo Road, Suite 100
Las Vegas, NV 89121
(702) 369-7011 FAX (702) 369-5853

All designs, arrangements and plans indicated or presented by this drawing, as instruments of service, are owned by and the property of DOMINGO CAMBEIRO CORPORATION. The use of these plans and/or specifications shall be restricted to the original site for which they were prepared and publication thereof is expressly limited to such use. Reproduction, publication or re-use by any method, in whole or part, is prohibited. None of such designs, arrangements or plans shall be used by or disclosed to any person, firm, agency, or corporation without the written permission of DOMINGO CAMBEIRO CORPORATION. Visual contact with these plans and specifications shall constitute prima facie evidence of acceptance of these restrictions.

DRAWN BY: M.Z.
CHECKED BY: R.G.K.
ISSUED DATE: 1-16-1992

POWER AND SIGNAL FLOOR PLAN

ADMINISTRATION BUILDING
DETENTION FACILITY EXPANSION
CITY OF LAS VEGAS, NEVADA

Domingo Cambeiro Corporation
INTERIORS
ARCHITECTURE ENGINEERING PLANNING
3555 PECOS-McLEOD IC. LAS VEGAS, NEVADA 89121 (702) 732-0084



E2.01

FILE NO.: 9114E2.DWG
JOB NO.: 9114

513-55 Z