


WATER CONSTRUCTION NOTES




- INSTALL FIRE HYDRANT PER UDACS PL. #7
- INSTALL 8"x6" WET-TAPPING SLEEVE W/ TAPPING VALVE
- EXIST. FDC TO BE RELOCATED AS SHOWN. CONTRACTOR TO CONNECT TO EXIST. WATER LINE

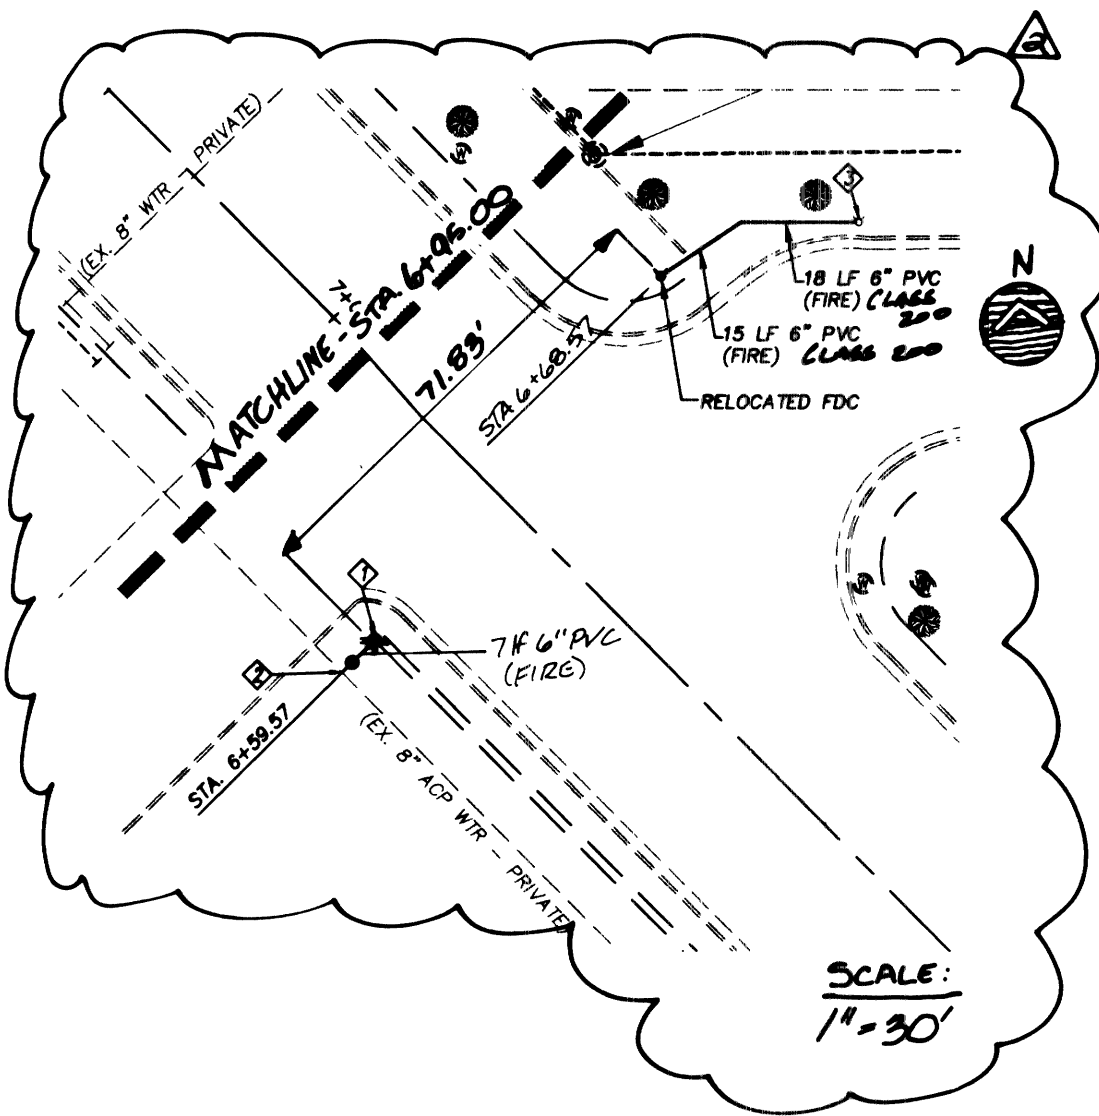

NOTE

CIVILWORKS, INC. ASSUMES NO RESPONSIBILITY FOR EXISTING UTILITY LOCATIONS AND/OR ELEVATIONS. THE UTILITIES SHOWN ON THIS DRAWING HAVE BEEN PLOTTED FROM AVAILABLE INFORMATION. IT IS, HOWEVER, THE CONTRACTOR'S RESPONSIBILITY TO FIELD VERIFY THE LOCATION OF ALL UTILITIES AND SITE ELEVATIONS PRIOR TO THE COMMENCEMENT OF ANY CONSTRUCTION. CONTRACTOR TO FIELD VERIFY ALL EXISTING SITE CONDITIONS PRIOR TO CONSTRUCTION. IF A CONFLICT EXISTS BETWEEN WHAT IS SHOWN ON THESE DRAWINGS AND WHAT EXISTS IN THE FIELD, THE CONTRACTOR IS TO NOTIFY THE ARCHITECT OR ENGINEER IMMEDIATELY.

36719 40109

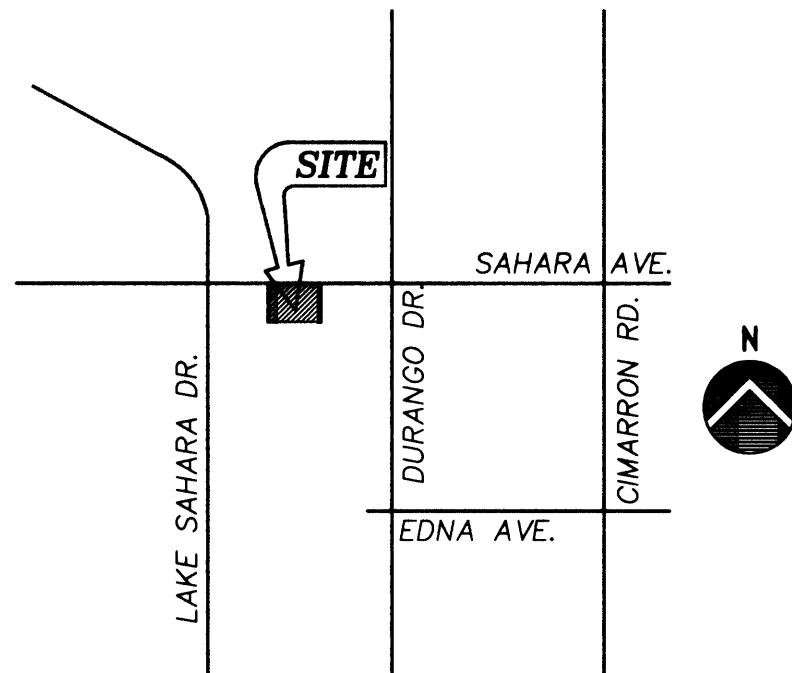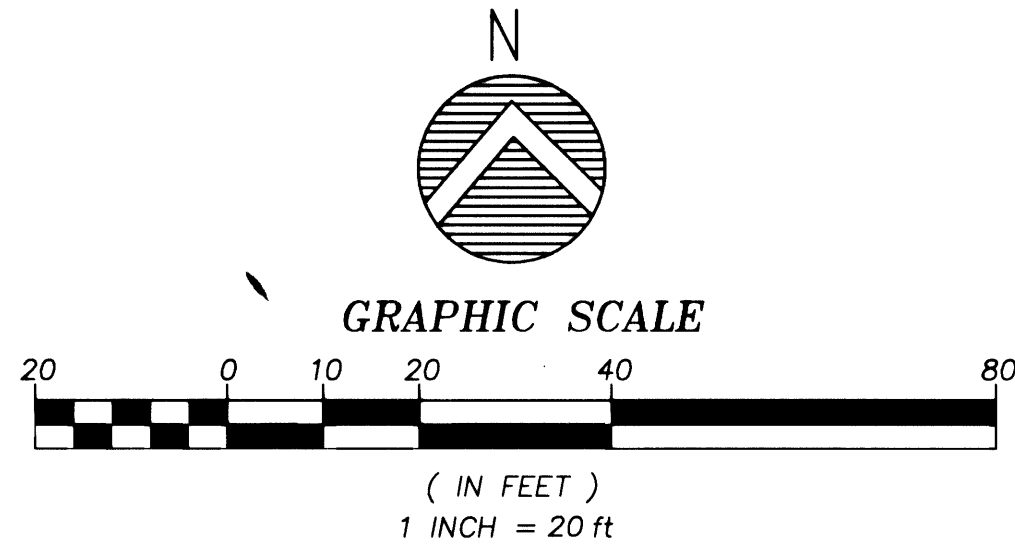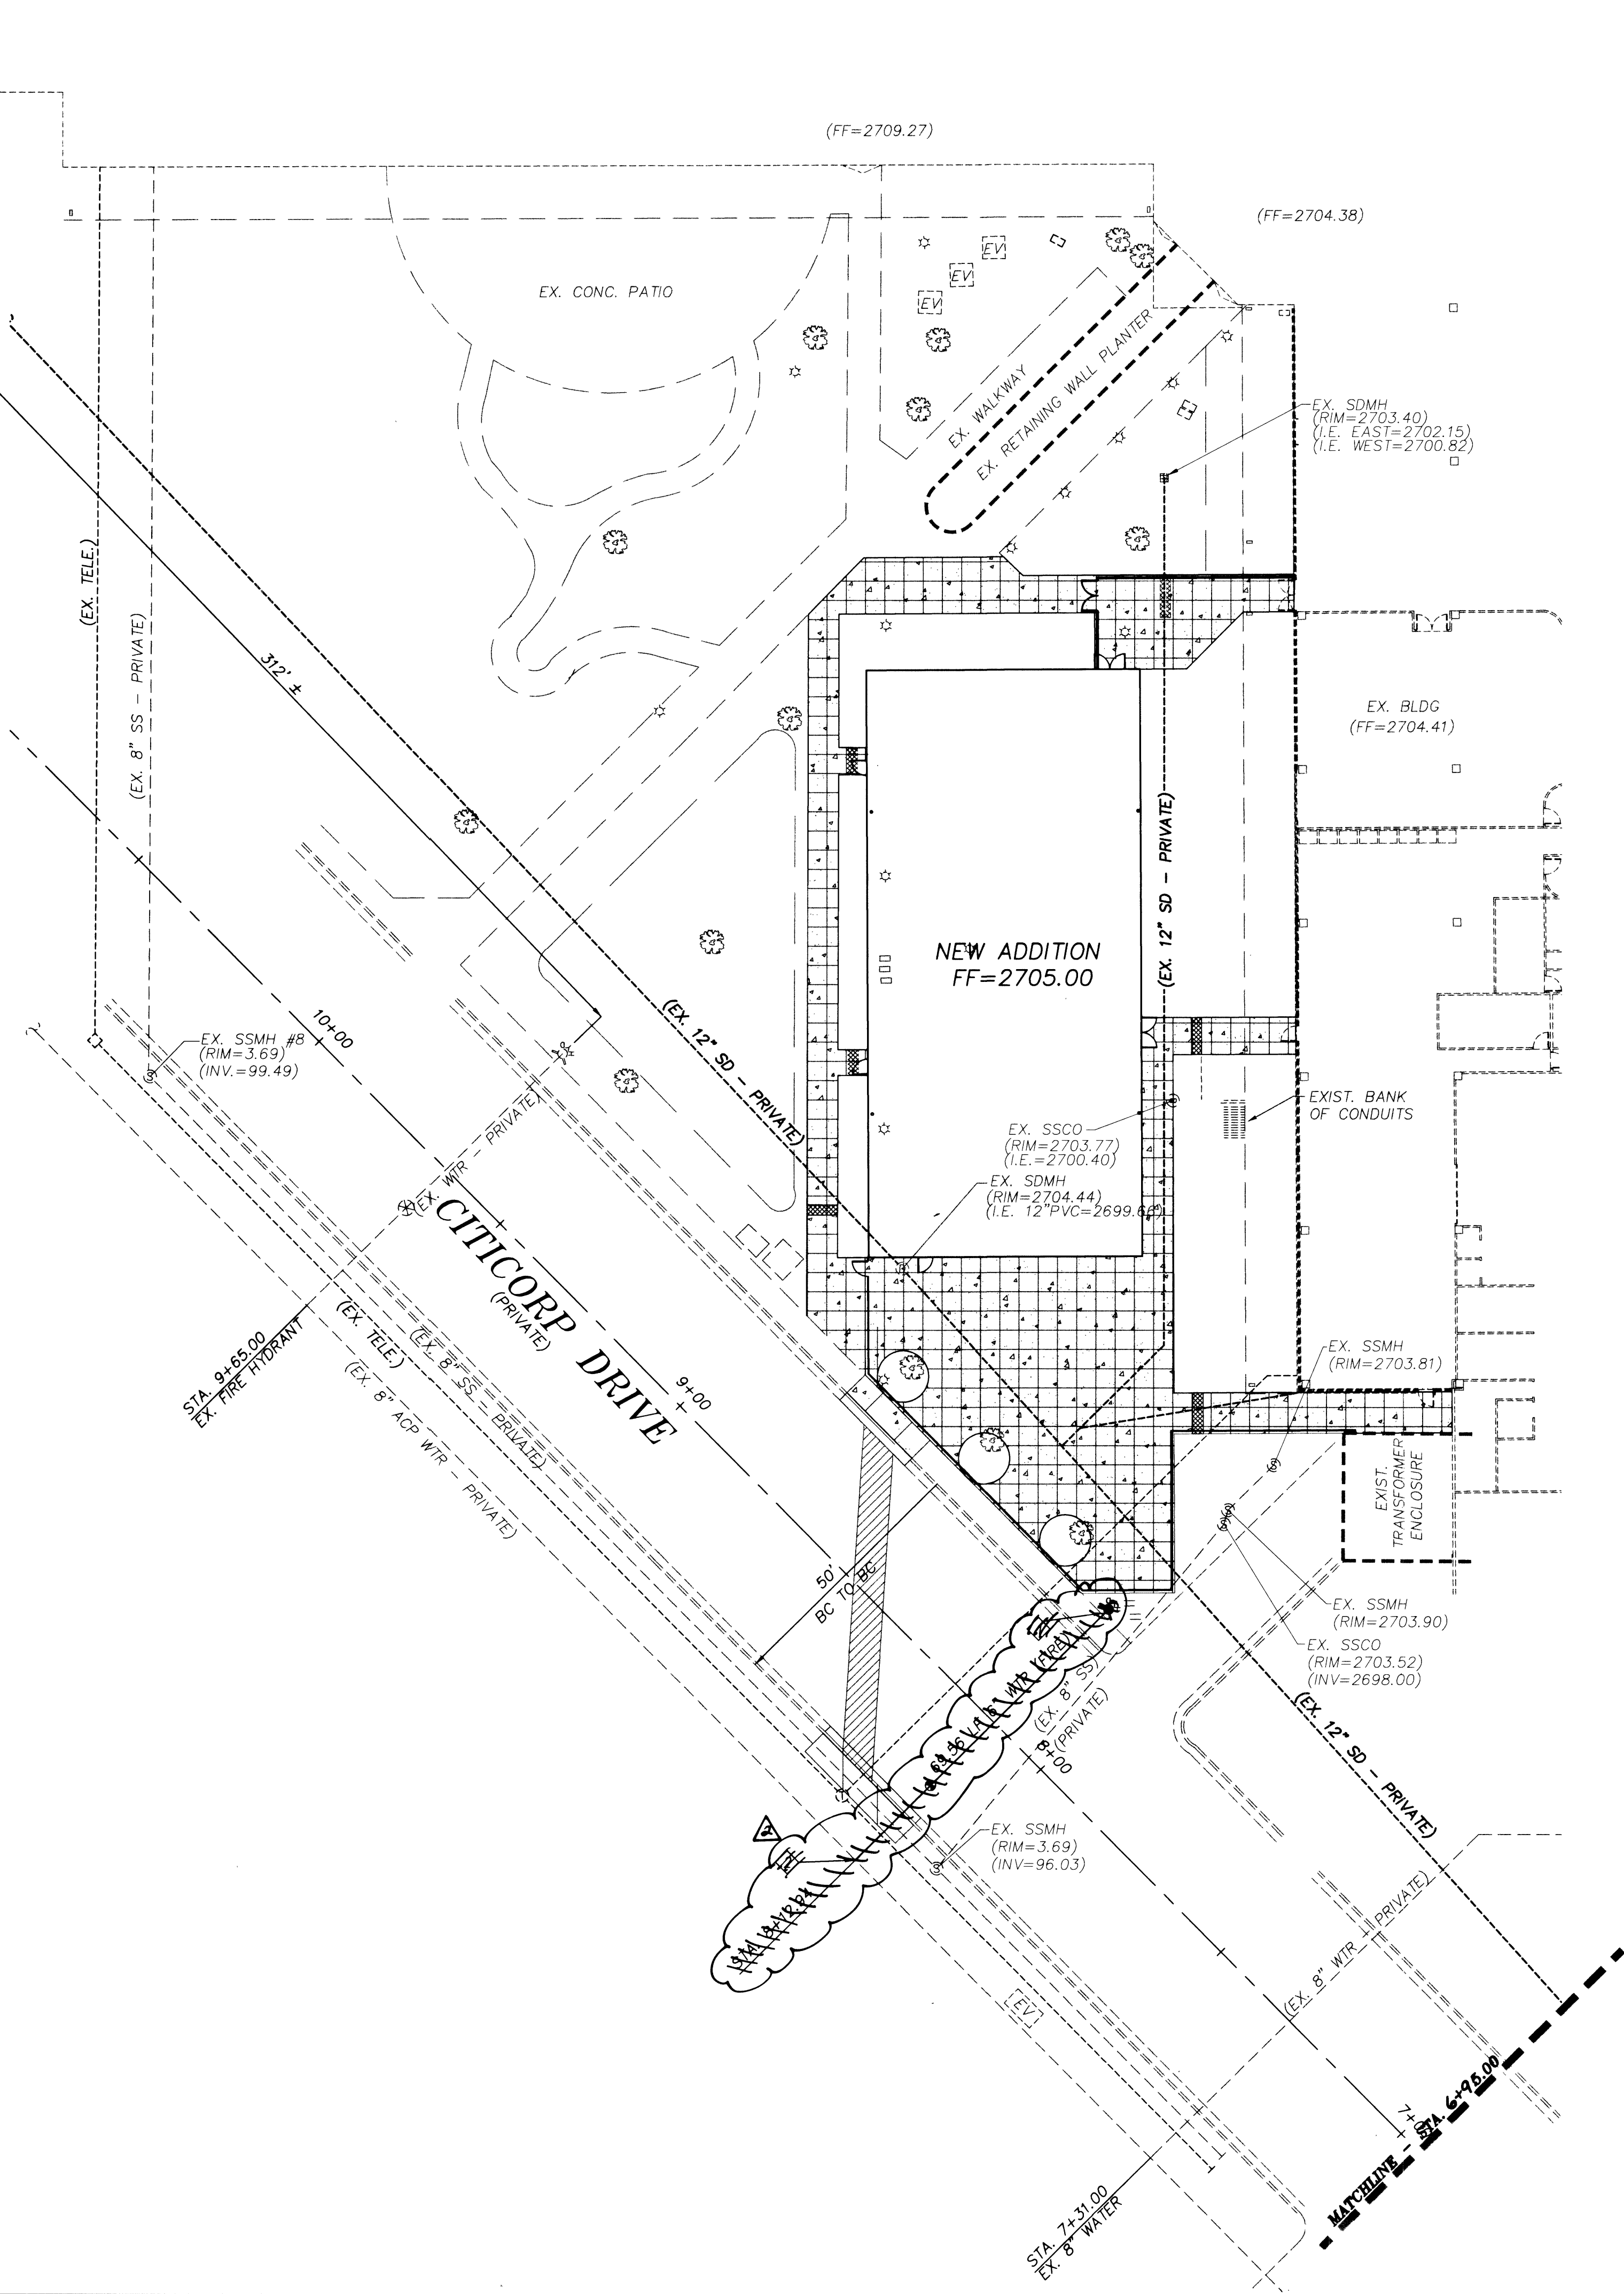

LOCATION MAP

BASIS OF BEARING

THE CENTERLINE OF CRYSTAL WATER WAY AS SHOWN ON PARCEL MAP, FILE 68, PAGE 96 OF CLARK COUNTY RECORDS. BEING N 00 08'24" W.

BENCHMARK

CITY OF LAS VEGAS VERTICAL CONTROL NO. 37 1LV10 5SSE6. RIVET & PLATE IN TOP OF CURB ON SAHARA AVE., 180' WEST OF LAKE SAHARA DR., NORTH CURB LINE.

NAVD88 METERS = 820.3105m or 2691.30'

APPROVALS

CITY OF LAS VEGAS FIRE DEPT.

BY: *[Signature]* DATE 12/3/01

APPROVAL OF THESE PLANS SHALL NOT BE CONSTRUED TO BE A PERMIT FOR, OR AN APPROVAL OF, ANY VIOLATION OF ANY OF THE PROVISIONS OF STATE OR OF COUNTY LAWS.

FIRE FLOW 2,375 GPM FOR A MINIMUM OF 4 HOURS

EXIST. BUILDING AREA= 105,100 sf
NEW BUILDING AREA = 6,116 sf
TOTAL BUILDING AREA = 111,216 sf
BLDG. CONSTRUCTION TYPE IS= II-1hr
BLDG. SPRINKLER SYSTEM: YES ☒ NO ☐
NUMBER OF STORIES= 1
OCCUPANCY= A-2.1

CivilWorksInc

Engineering with sensible solutions tailored to your needs.
2970 West Sahara Ave., Suite #100 • Las Vegas, Nevada • 89102
Office #: (702) 876-3474 • Facsimile #: (702) 876-3493


ARCH: Dekker Perich Holmes Sabatini Architects

CITIBANK ADDITION
AT SAHARA AVE. & DURANGO DR.

CITIBANK
8725 WEST SAHARA AVENUE
LAS VEGAS, NEVADA

CITY OF LAS VEGAS, NEVADA

PROJ. NO.	01330141.00	DATE	16 NOV 01
PROJ. ENGR.	B.A. POTTS	TECHN.	ING
PROJ. ENGR.	B.A. POTTS	ENGR. CHG.	BAB
REVISIONS	Δ	REVISED UTILITIES	12/01/01
Δ	Revised Hydrant Location / FDC Location	12/01/01	
Δ			
Δ			
Δ			

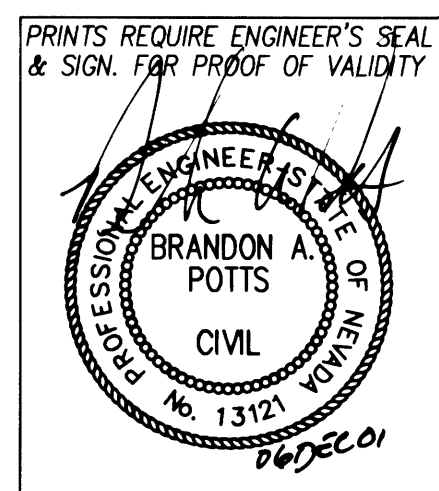

PRINTS REQUIRE ENGINEER'S SEAL & SIGN. FOR PROOF OF VALIDITY

1/07-V 3403

Replot