
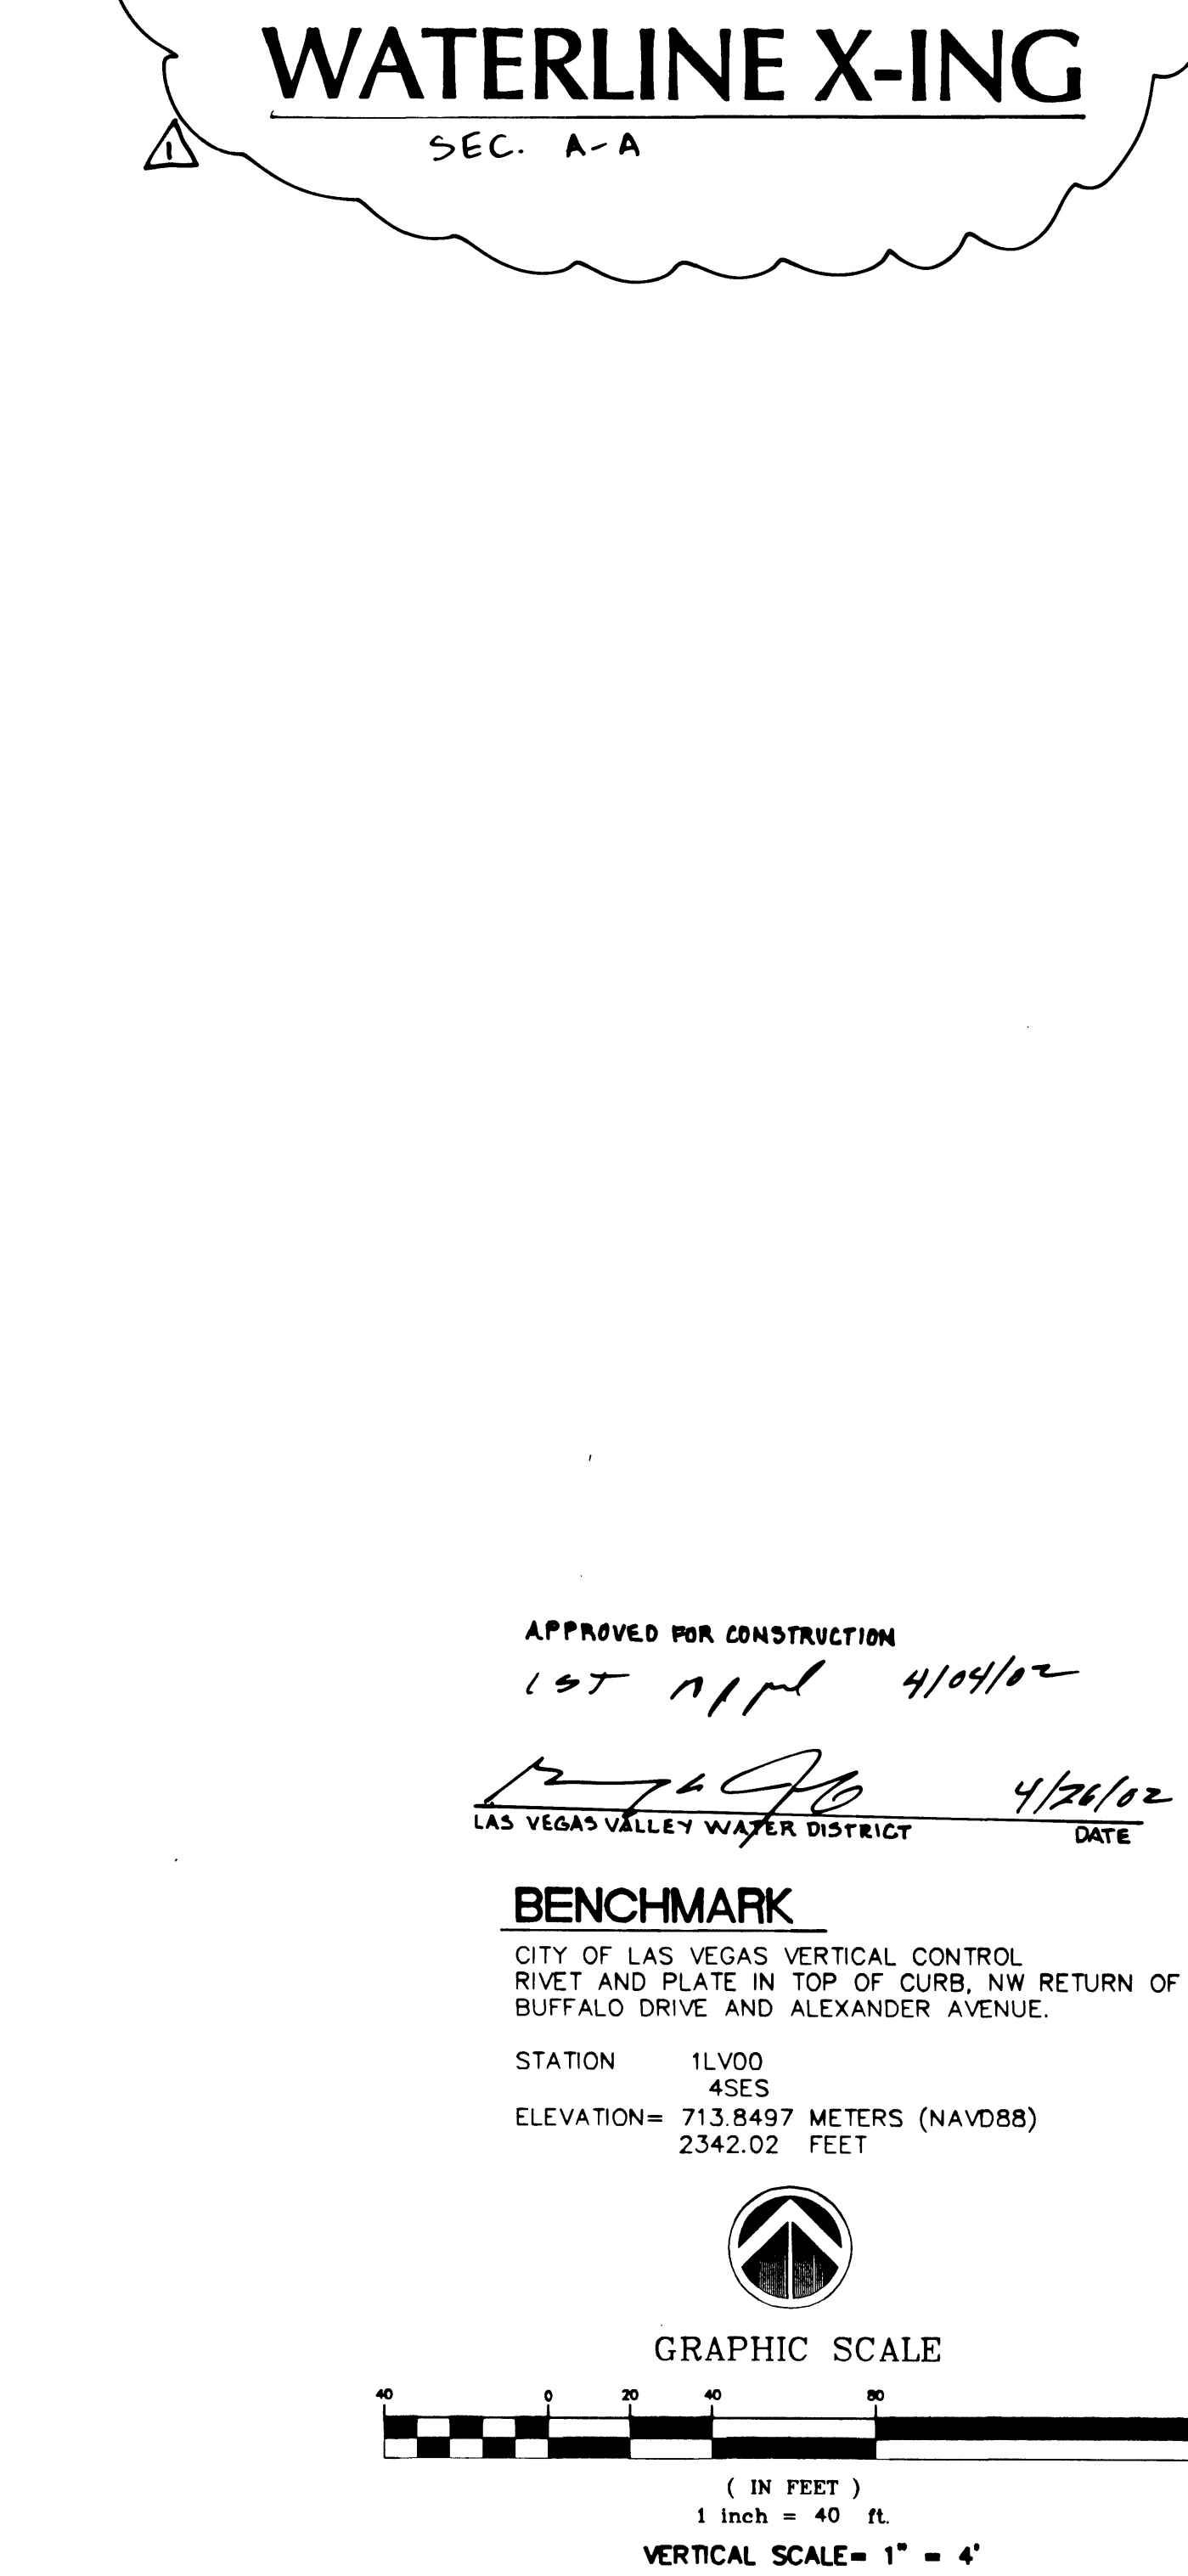


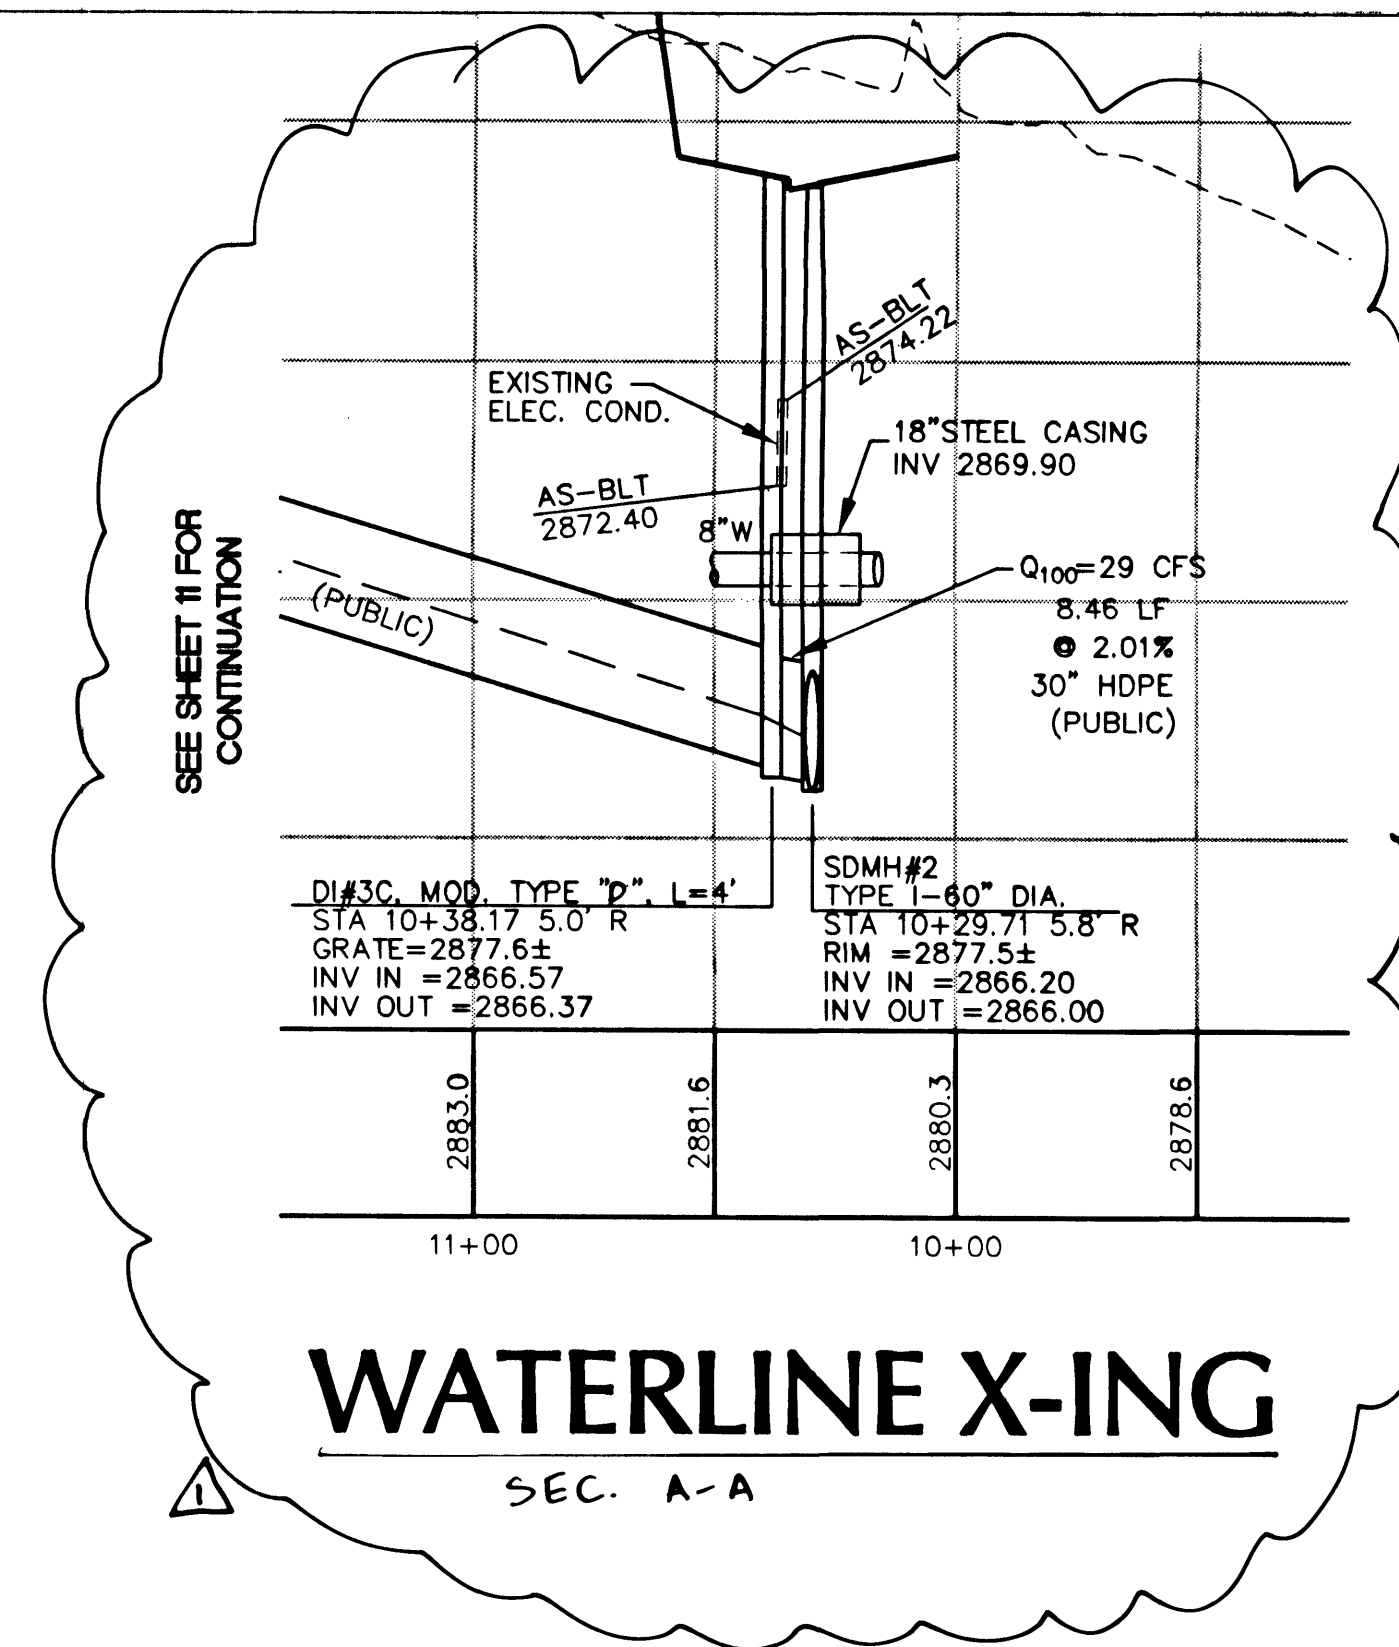

TITLE	STREET PLAN & PROFILE ALEXANDER ROAD
PROJECT	ALEXANDER APARTMENTS
CITY OF LAS VEGAS	NEVADA

WORK ORDER NO.	010404
DESIGN BY:	CP, AM
DATE:	07-10-01
SCALE:	1"=40'
CADFILE:	AAPPSTI
SHEET	9 OF 14 SHEETS
CLV DWG NO.	107-V3525