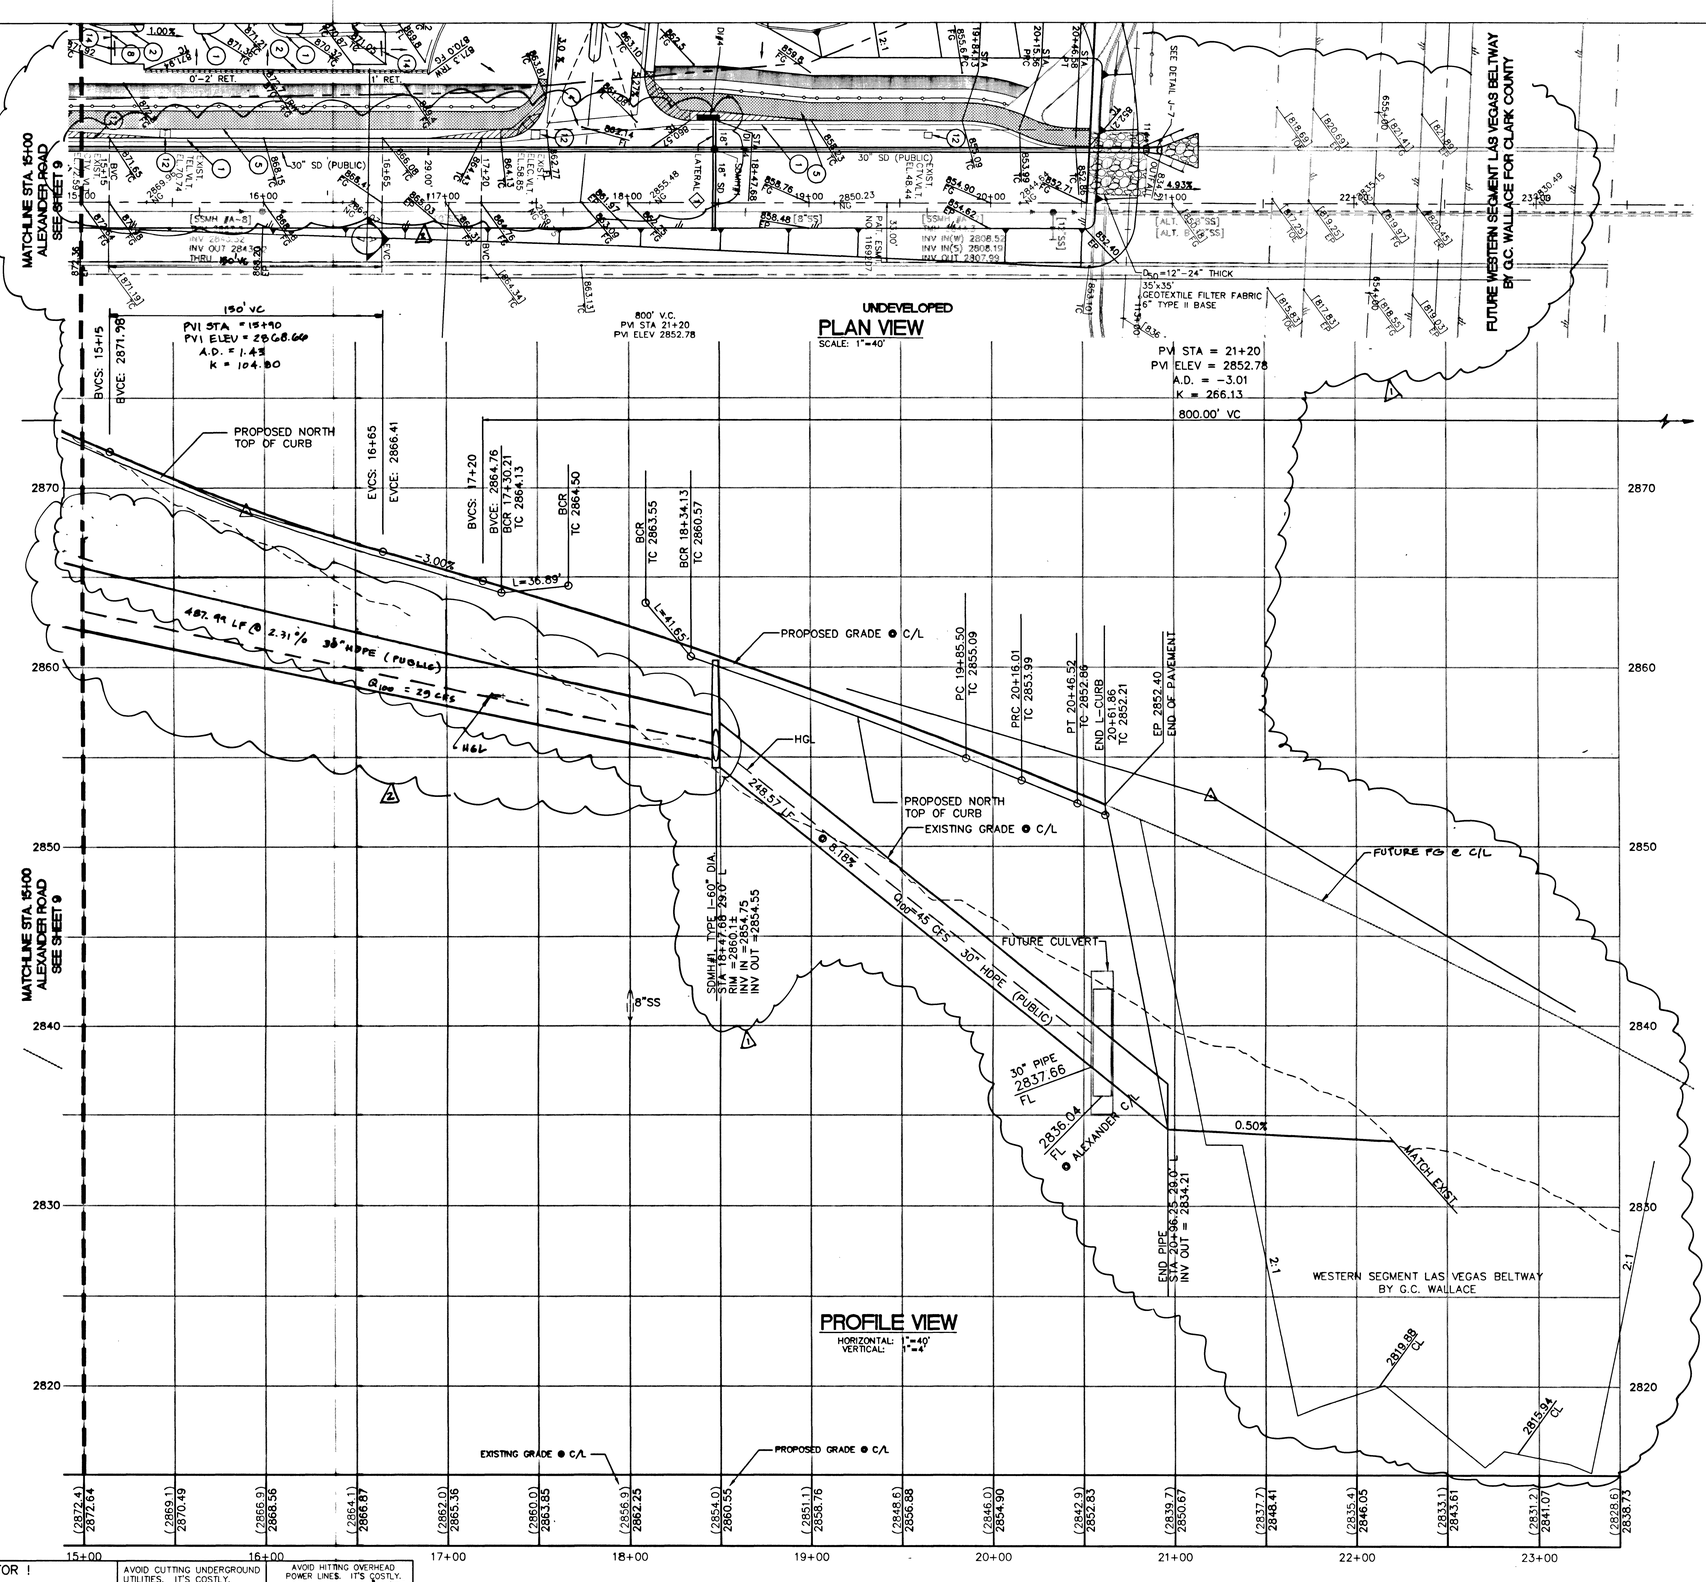

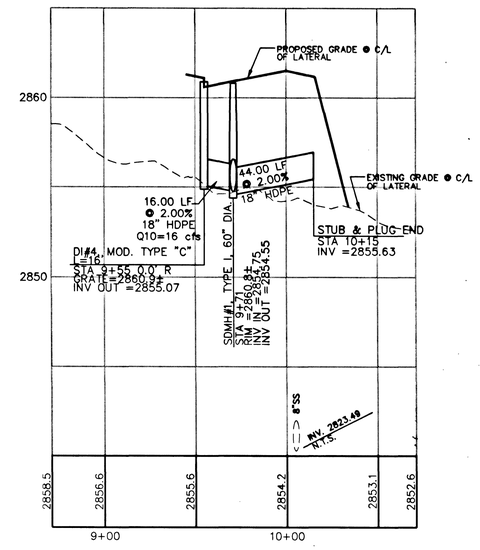

SD LATERAL 1
(PUBLIC)

GRAPHIC SCALE

(IN FEET)
1 inch = 40 ft.
VERTICAL SCALE= 1" = 4'

BENCHMARK

CITY OF LAS VEGAS VERTICAL CONTROL
RIVET AND PLATE IN TOP OF CURB, NW RETURN OF
BUFFALO DRIVE AND ALEXANDER AVENUE.

STATION 1LV00
4SES
ELEVATION= 713.8497 METERS (NAVD88)
2342.02 FEET

NO.	DATE	BY	APPV'D.	REVISION DESCRIPTION
1	5-7-02	CSP	MRC	PER C.L. CONFLICT WITH BUILT COND.
2	4-12-02	CSP	MRC	PER LANDER SUBMIT & D.I. REV. PER NEW BELTWAY DESIGN

STAMP 4/15/02

SOUTHWEST ENGINEERING
LAND PLANNING • MAPPING • DEVELOPMENT
3610 North Rancho Drive
Las Vegas, Nevada 89130
Telephone: (702) 648-9700
Fax: (702) 648-4143

TITLE: STREET PLAN & PROFILE
ALEXANDER ROAD

PROJECT: ALEXANDER APARTMENTS

CITY OF LAS VEGAS NEVADA

WORK ORDER NO. 010404
DESIGN BY: TEAM 1
DATE: 07-10-01
SCALE: 1"=40'
CADFILE: AAPPST1
SHEET 10 OF 14 SHEETS
CLV DWG NO. 107-V3525

REPLOT

NOTICE TO CONTRACTOR !

EXISTING UTILITY LOCATIONS SHOWN HEREON ARE APPROXIMATE ONLY. IT SHALL BE THE CONTRACTOR'S RESPONSIBILITY TO DETERMINE THE EXACT VERTICAL AND HORIZONTAL LOCATION OF ALL EXISTING UNDERGROUND UTILITIES PRIOR TO COMMENCING CONSTRUCTION. NO REPRESENTATION IS MADE THAT ALL EXISTING UTILITIES ARE SHOWN HEREON. THE ENGINEER ASSUMES NO RESPONSIBILITY FOR UTILITIES NOT SHOWN OR UTILITIES NOT SHOWN IN THEIR PROPER LOCATION.

AVOID CUTTING UNDERGROUND UTILITIES. IT'S COSTLY.
CALL before you Dig
1-800-227-2600
UNDERGROUND SERVICE (USA)

AVOID HITTING OVERHEAD POWER LINES. IT'S COSTLY.
CALL BEFORE YOU DO OVERHEAD
CALL 1-702-593-6111