
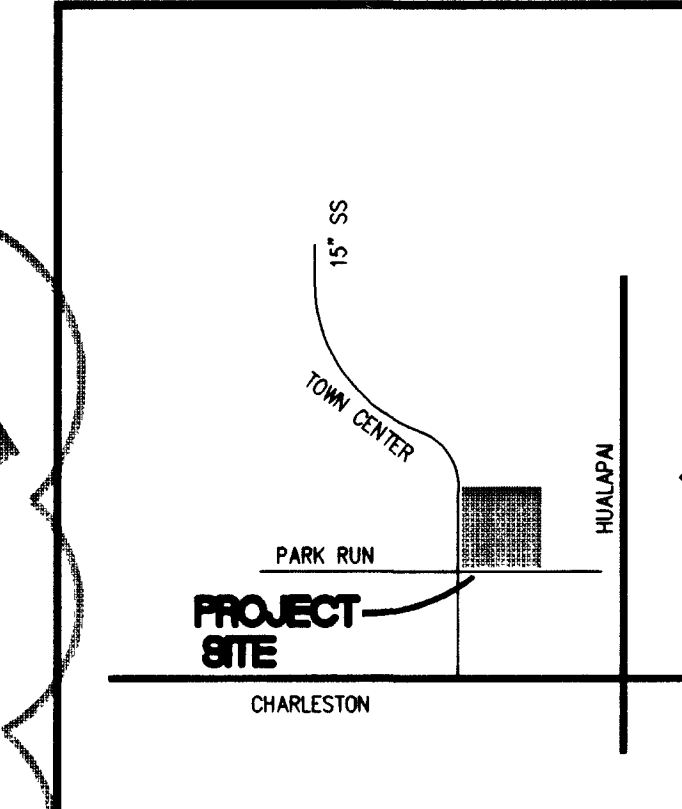


INSTALLATION OF METER AND VAULT (2) 6' X 3' FMCT

THE METER(S) AND VAULT(S) WITH NON-TRAFFIC BEARING COVER(S) SHALL BE INSTALLED IN ACCORDANCE WITH THE UDACS PLATE NO. 210 AND WITH STANDARD VAULT DRAWING C-475, LATEST REVISION.

ANY BLOCK WALL OR OTHER FENCE MATERIAL SHALL BE DESIGNED AND CONSTRUCTED DIRECTLY OUTSIDE OF THE EASEMENT(S) TO ALLOW THE DISTRICT DIRECT ACCESS TO THE VAULT(S) FROM THE ADJACENT RIGHT-OF-WAY.

METERS MUST BE SET IN A HORIZONTAL POSITION, AT LEAST EIGHT (8) DIAMETERS OF STRAIGHT PIPE ARE REQUIRED AT THE INLET END.

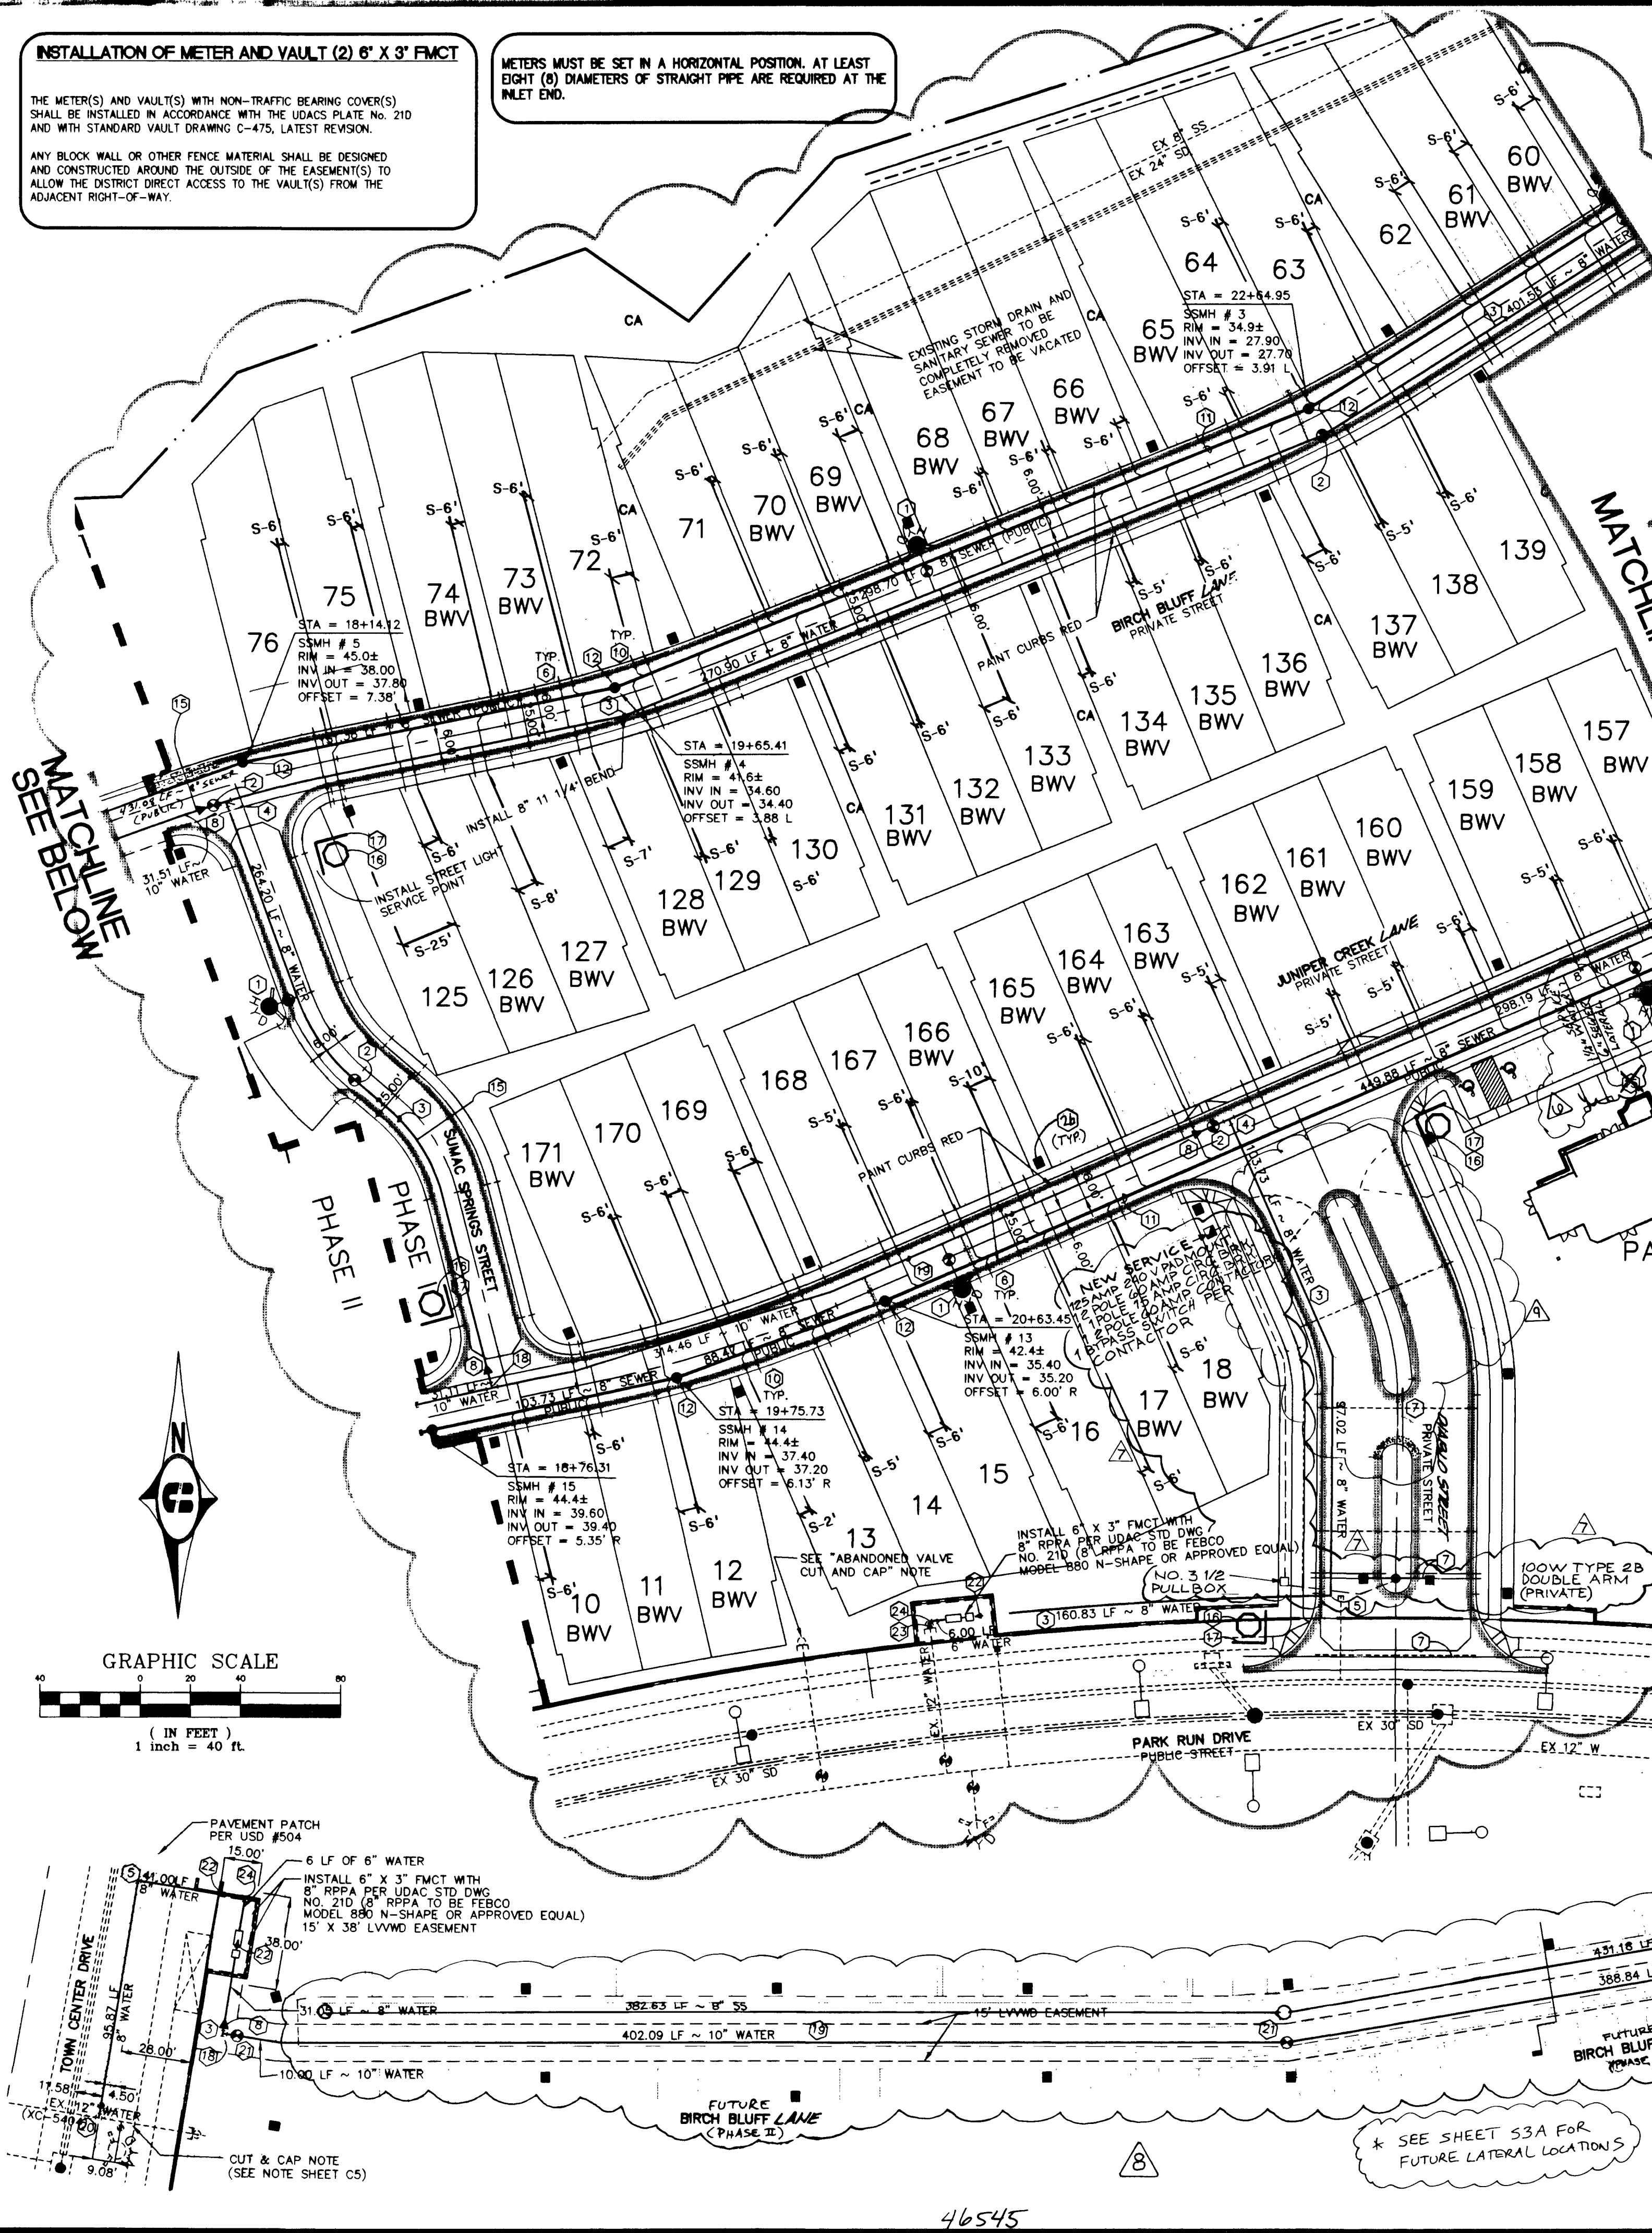


DRIVEWAY AND LATERAL STATION TABLE			
* ALL STATIONS IN THIS TABLE ARE AT BACK OF CURB			
LOT NUMBER	DRIVEWAY CENTERLINE STATION	SEWER LATERAL STATION	WATER LATERAL STATION
10	STA: 19+26.74	STA: 19+08.78	STA: 19+13.82
11	STA: 19+53.78	STA: 19+38.93	STA: 19+43.81
12	STA: 19+83.83	STA: 19+71.20	STA: 19+66.10
13	STA: 20+02.00	STA: 20+02.77	STA: 20+07.56
14	STA: 20+46.88	STA: 20+31.98	STA: 20+36.86
15	STA: 20+77.66	STA: 20+64.66	STA: 20+59.66
16	STA: 21+18.64	STA: 21+01.66	STA: 21+06.66
17	STA: 21+46.88	STA: 21+31.66	STA: 21+36.66
18	STA: 21+77.66	STA: 21+59.66	STA: 21+64.66

FIRE HYDRANT INSTALLATION

FIRE HYDRANTS TO BE INSTALLED IN ACCORDANCE WITH THE UDACS STANDARD PLATE NO. 7.

FOR DRIVEWAY AND LATERAL STATIONS FOR LOTS 77 THROUGH 124 SEE SHEET 33A.

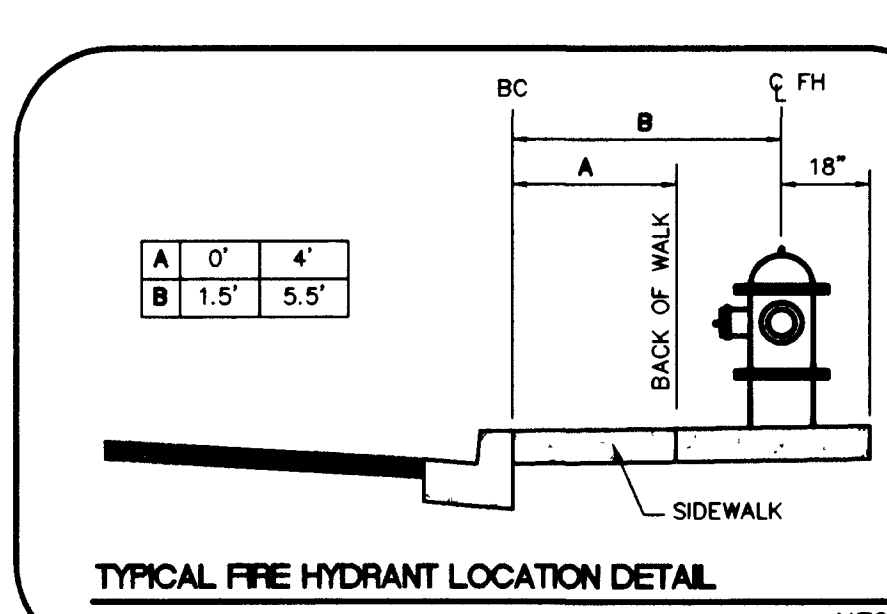

- WATER UTILITY CONSTRUCTION NOTES**
- 1" 6" F.H. ASSEMBLY (INCLUDES 8" x 6" TEE AND 6" GATE VALVE)
 - 2" 8" GATE VALVE
 - 3" 8" WATER MAIN
 - 4" 8" x 8" x 8" TEE WITH THRUST BLOCK
 - 5" 8" 90° BEND WITH THRUST BLOCK
 - 6" 1" WATER SERVICE
 - 7" IRRIGATION SLEEVES PER SIS# U-18
 - 8" 8" x 10" REDUCER
 - 9" 8" 18" FABRICATED BEND
 - 10" 1" WATER SERVICE WITH RPPA PER UDACS PLATE NO. 10 AND IRRIGATION POWER SOURCE
 - 11" 10" GATE VALVE
 - 12" 8" x 6" REDUCER
 - 13" 2" WATER SERVICE WITH RPPA PER UDACS PLATE NO. 10 AND IRRIGATION POWER SOURCE
- WATER**
- 14" 10" x 10" x 10" TEE W/THRUST BLOCK
 - 15" 10" WATER MAIN
 - 16" 12" x 8" TAPPING TEE AND VALVE
 - 17" 12" x 6" REDUCER
 - 18" 6" 90° BEND
- SEWER**
- 19" 4" SEWER LATERAL
 - 20" 8" SEWER
 - 21" 48" SEWER MANHOLE
- STREET WORK**
- 22" 3" 1/2" PULLBOX
 - 23" 1 1/4" CONDUIT WITH 2" 1/4" AND 1" 1/2" CONDUIT
 - 24" STREET SIGNS
 - 25" STOP SIGN (R-1)
 - 26" STREET NAME SIGN (D-3)

APPROVALS

APPROVAL OF THESE PLANS SHALL NOT BE CONSTRUED TO BE A PERMIT FOR OR AN APPROVAL OF ANY VIOLATION OF ANY OF THE PROVISIONS OF THE STATE OR COUNTY LAWS.

CLV: [Signature] FIRE DEPARTMENT: [Signature] DATE: 1-29-99
LAS VEGAS VALLEY WATER DISTRICT: [Signature] DATE: 2-09-99

ABANDONED VALVE CUT AND CAP

ALL VALVES TO BE ABANDONED IN THE CLOSED POSITION, UNLESS OTHERWISE, BY REMOVING A MINIMUM OF THE TOP 12 INCHES OF THE VALVE BOX AND THEN FILLING THE REMAINING PORTION OF THE VALVE BOX WITH CONCRETE HAVING A COMPRESSIVE STRENGTH OF AT LEAST 2,000 PSI.

THE CONTRACTOR SHALL CUT THE EXISTING PIPE 3' BEYOND THE ABANDONED VALVE AND INSTALL A CAP, WHERE A JOINT OR COUPLING IN THE EXISTING PIPE IS UNCOVERED AT THE CUT AND CAP LOCATION, THE INSTALLATION OF A PLUG MAY BE PERMITTED WITH DISTRICT APPROVAL. THE CONTRACTOR SHALL INSTALL A CONCRETE THRUST BLOCK IN ACCORDANCE WITH THE PROVISIONS OF THE UDACS PLATE NO. 5 AT ALL CAP OR PLUG LOCATIONS.

REDUCED PRESSURE PRINCIPLE ASSEMBLY (2) 8"

APPROVED REDUCED PRESSURE PRINCIPLE ASSEMBLY(S) SHALL BE INSTALLED PER THE UDACS PLATE NO. 118. NO WATER SHALL BE TAKEN FROM A SERVICE REQUIRING BACKFLOW PREVENTION UNTIL THE REDUCED PRESSURE PRINCIPLE ASSEMBLY HAS BEEN SUCCESSFULLY TESTED BY THE LVWD.

ANY BLOCK WALL OR OTHER FENCE MATERIAL SHALL BE DESIGNED AND CONSTRUCTED DIRECTLY OUTSIDE OF THE EASEMENT(S) TO ALLOW DISTRICT DIRECT ACCESS FROM THE ADJACENT RIGHT-OF-WAY.

CITY OF LAS VEGAS FIRE DEPARTMENT FIRE FLOW DATA

TYPE OF CONSTRUCTION	V-N
NO. OF STORIES	2