


PLAN
 SURVEYED
 PLOTTED
 NOTE BOOK ALIGNMENT CHECKED
 NO. OF WAY CHECKED

PLAN
 SURVEYED
 PLOTTED
 NOTE BOOK ALIGNMENT CHECKED
 NO. OF WAY CHECKED

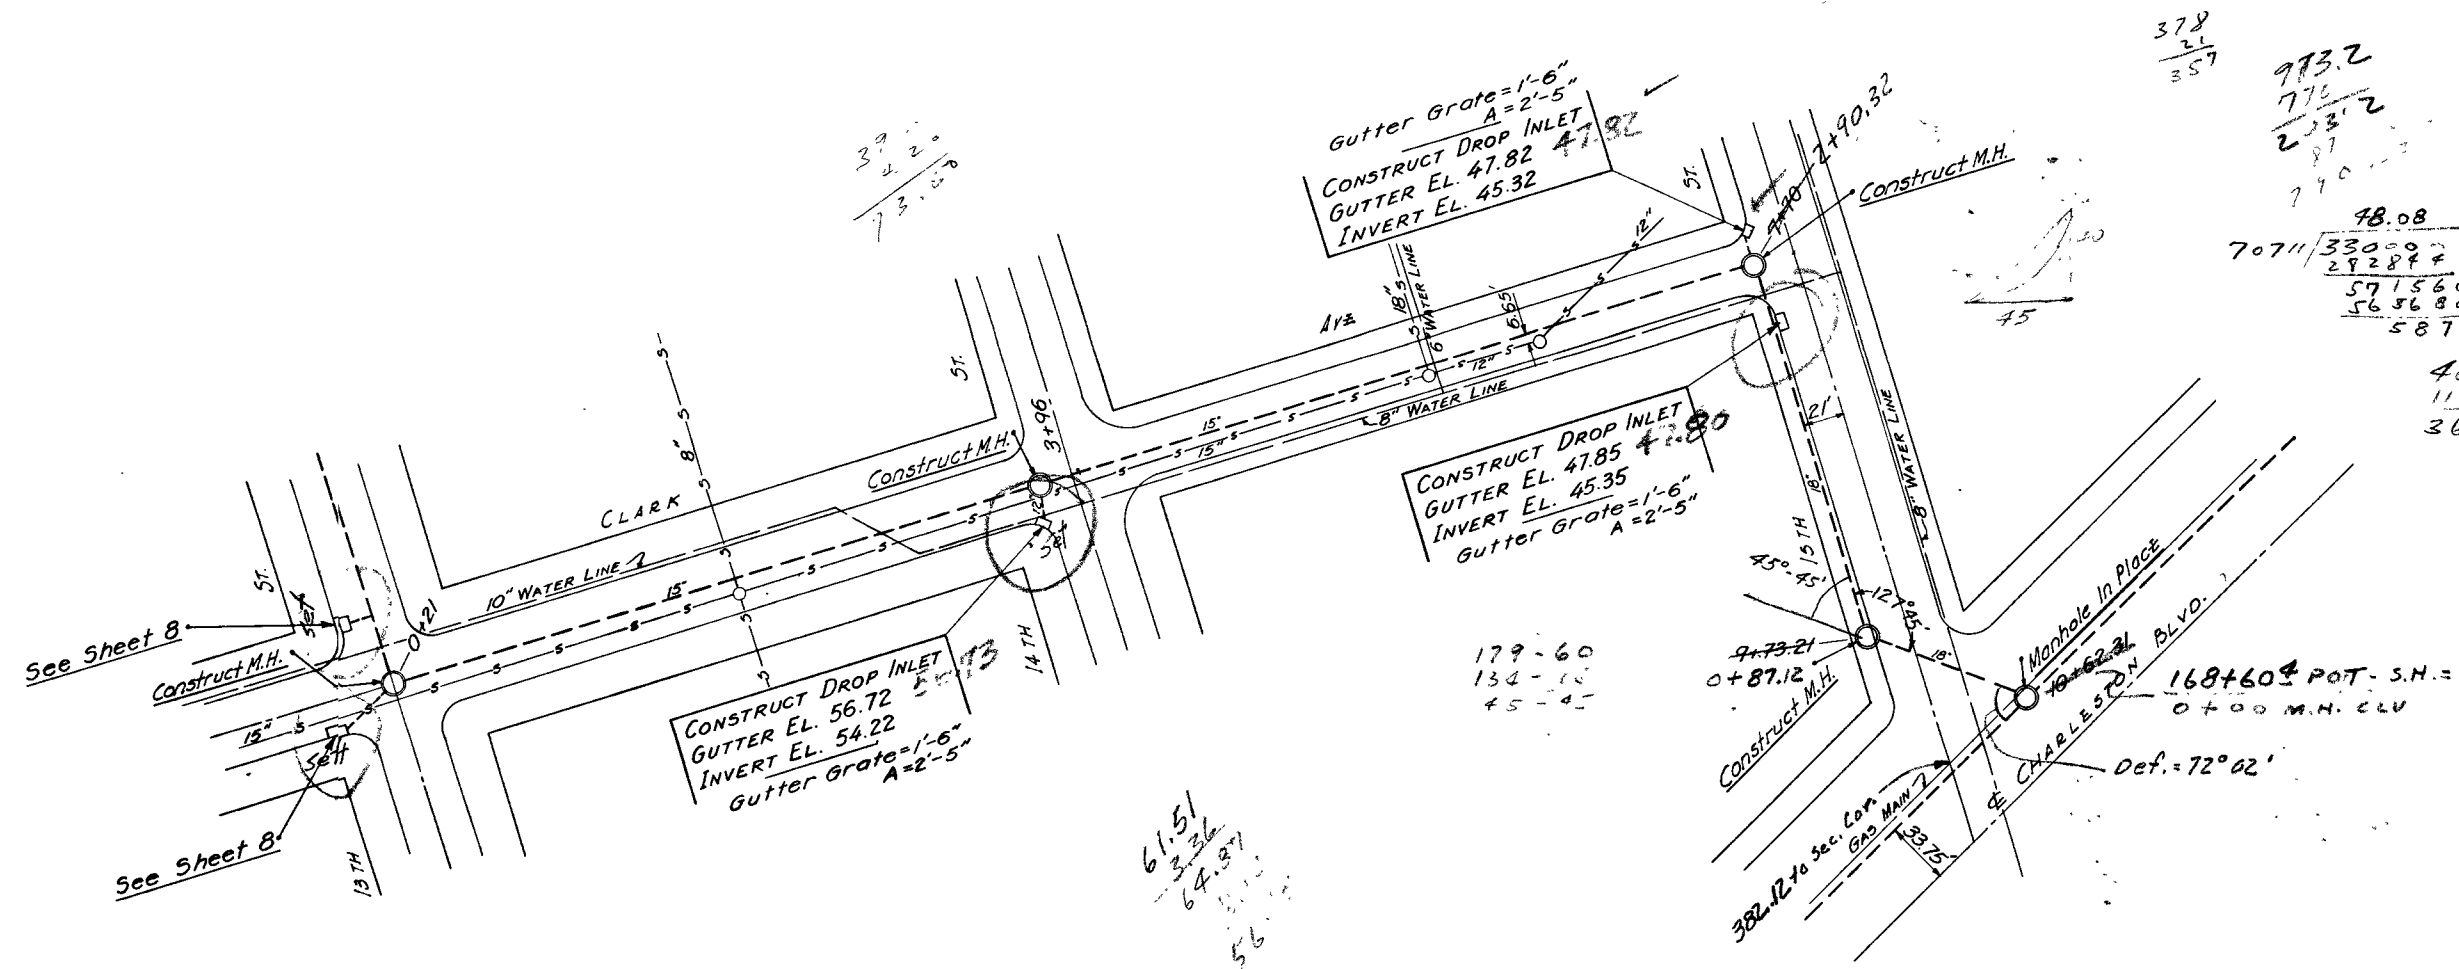

378
 21
 357

973.2
 775
 253.2

16750.4
 110.4
 16860.4

179-60
 107-58
 72.02

48.08
 70711/33000
 292897
 571560
 565688
 587200

44.53
 45.87
 3.66


48.08
 11.50
 36.58

3314

110.24

3460
 3314
 14600
 13256
 13440

SCALE 1"=50'

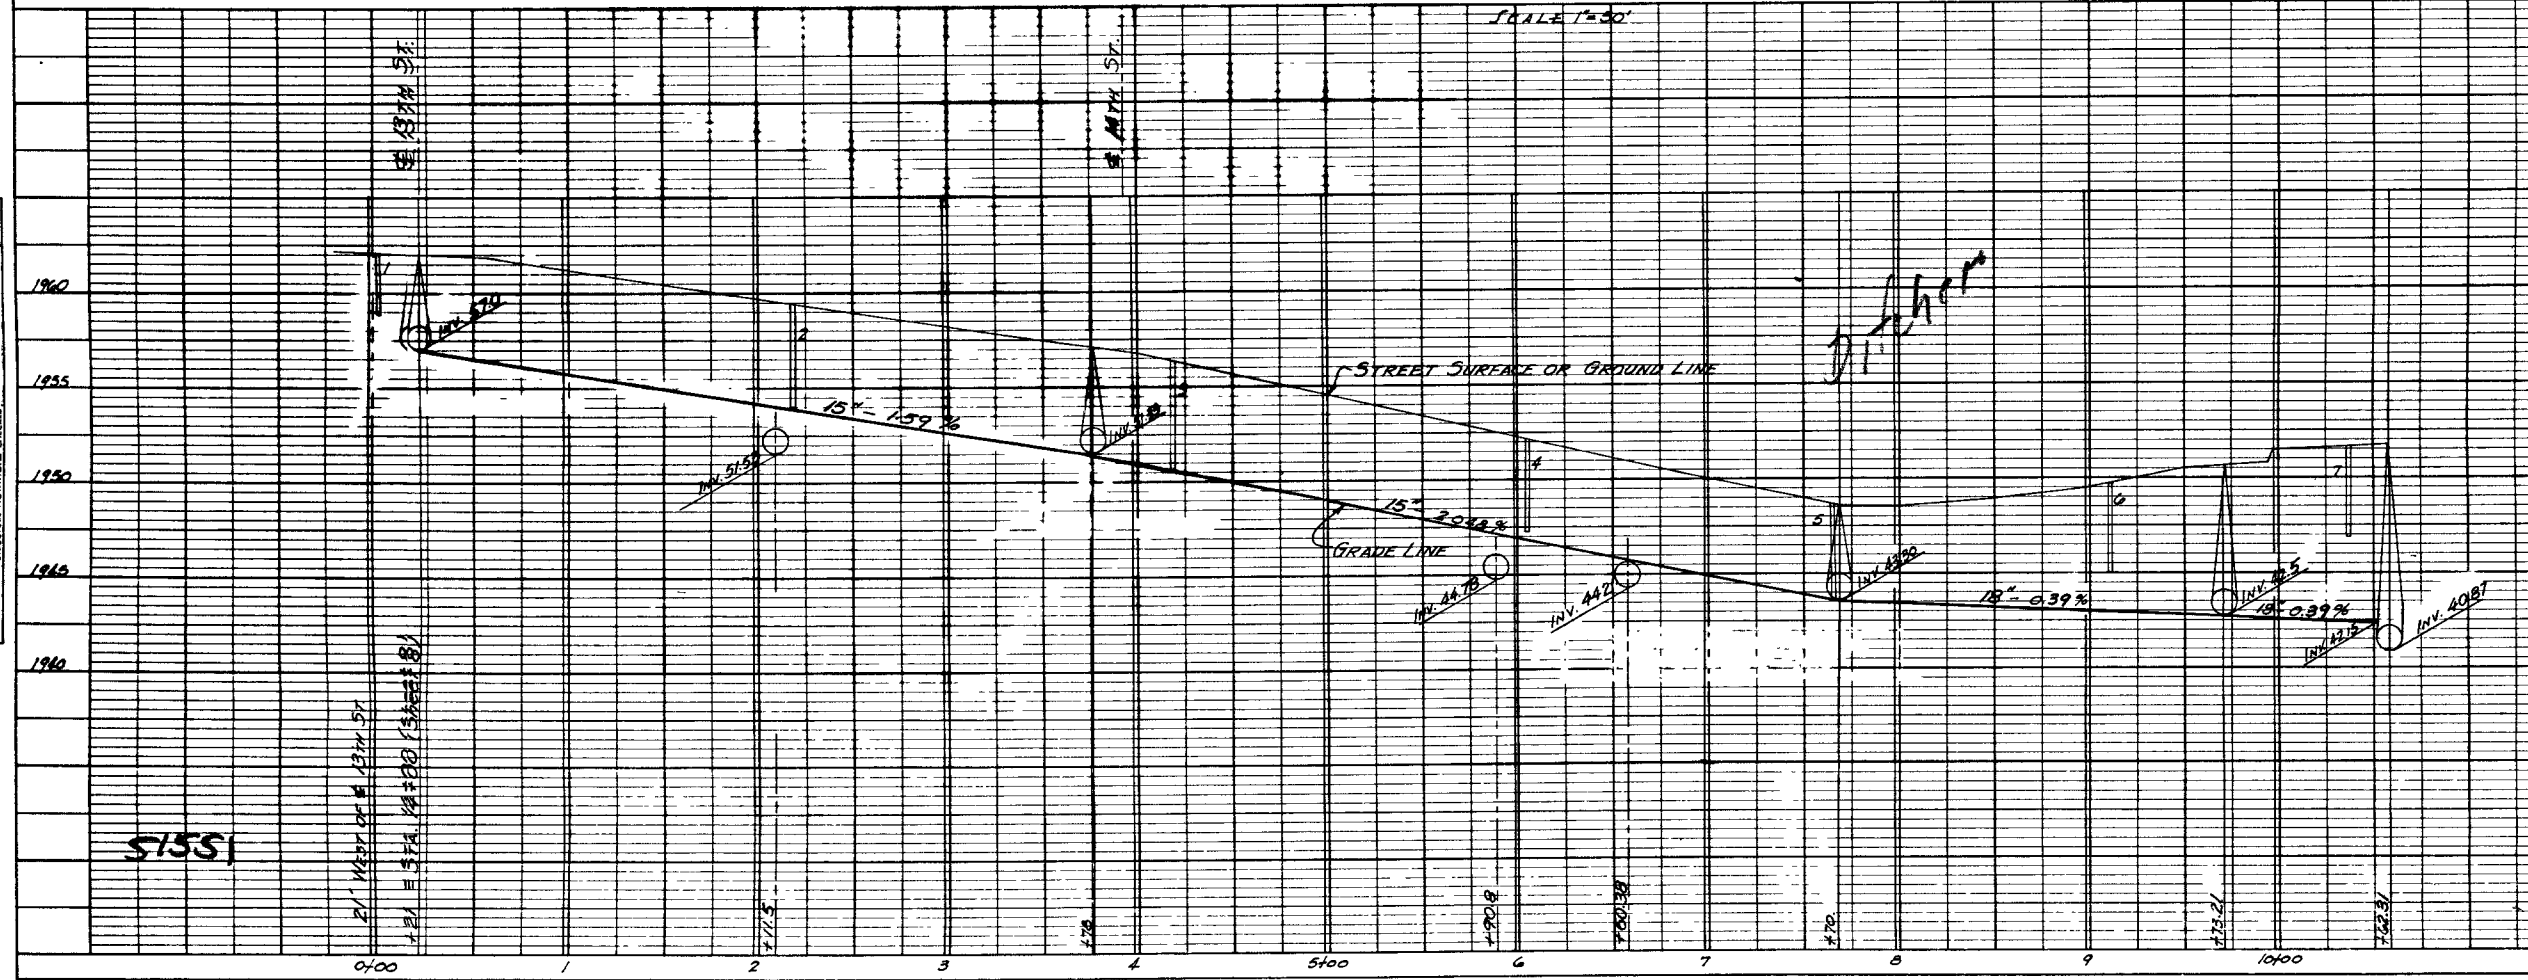

REFERENCES

BOOK	PAGE	ITEM
STREET PLANN		PROFILE
10388	31,32	"
10382	1-10	"
10388	17,38	SOIL TEST BORINGS
1042	10,38-34	SANITARY SEWER LOCATIONS

BM #28 ELEVATION 1942.18
 NE CORNER 15TH & CHARLESTON BLVD.

SOIL TEST

11	0' TO 2.5'	GRAVEL AND CLAY, 2.5' CALICHE	1960	
12	2.5'	10' TO 5.0'	SAND & CLAY	1955
13	5.0'	SAND AND CLAY		
14	5.0'	1.5' TO 5.0'	CLAY	
15	5.0'	SAND AND CLAY		
16	5.0'	2.5' TO 5.0'	CLAY	1950

SANITARY SEWERS - Saddle with covered
 ground when pipe clearance is less than
 0.5 foot.

NOTE: Location of water mains are
 approximate. Service connections
 to water mains and sanitary sewers
 are not shown.

102-V-369