


LOT GRADING CRAIG ROAD & TIOGA WAY

NOTE:
FOR RETAINING WALLS SEE CLARK COUNTY
BUILDING DEPARTMENT DWG. B-101.

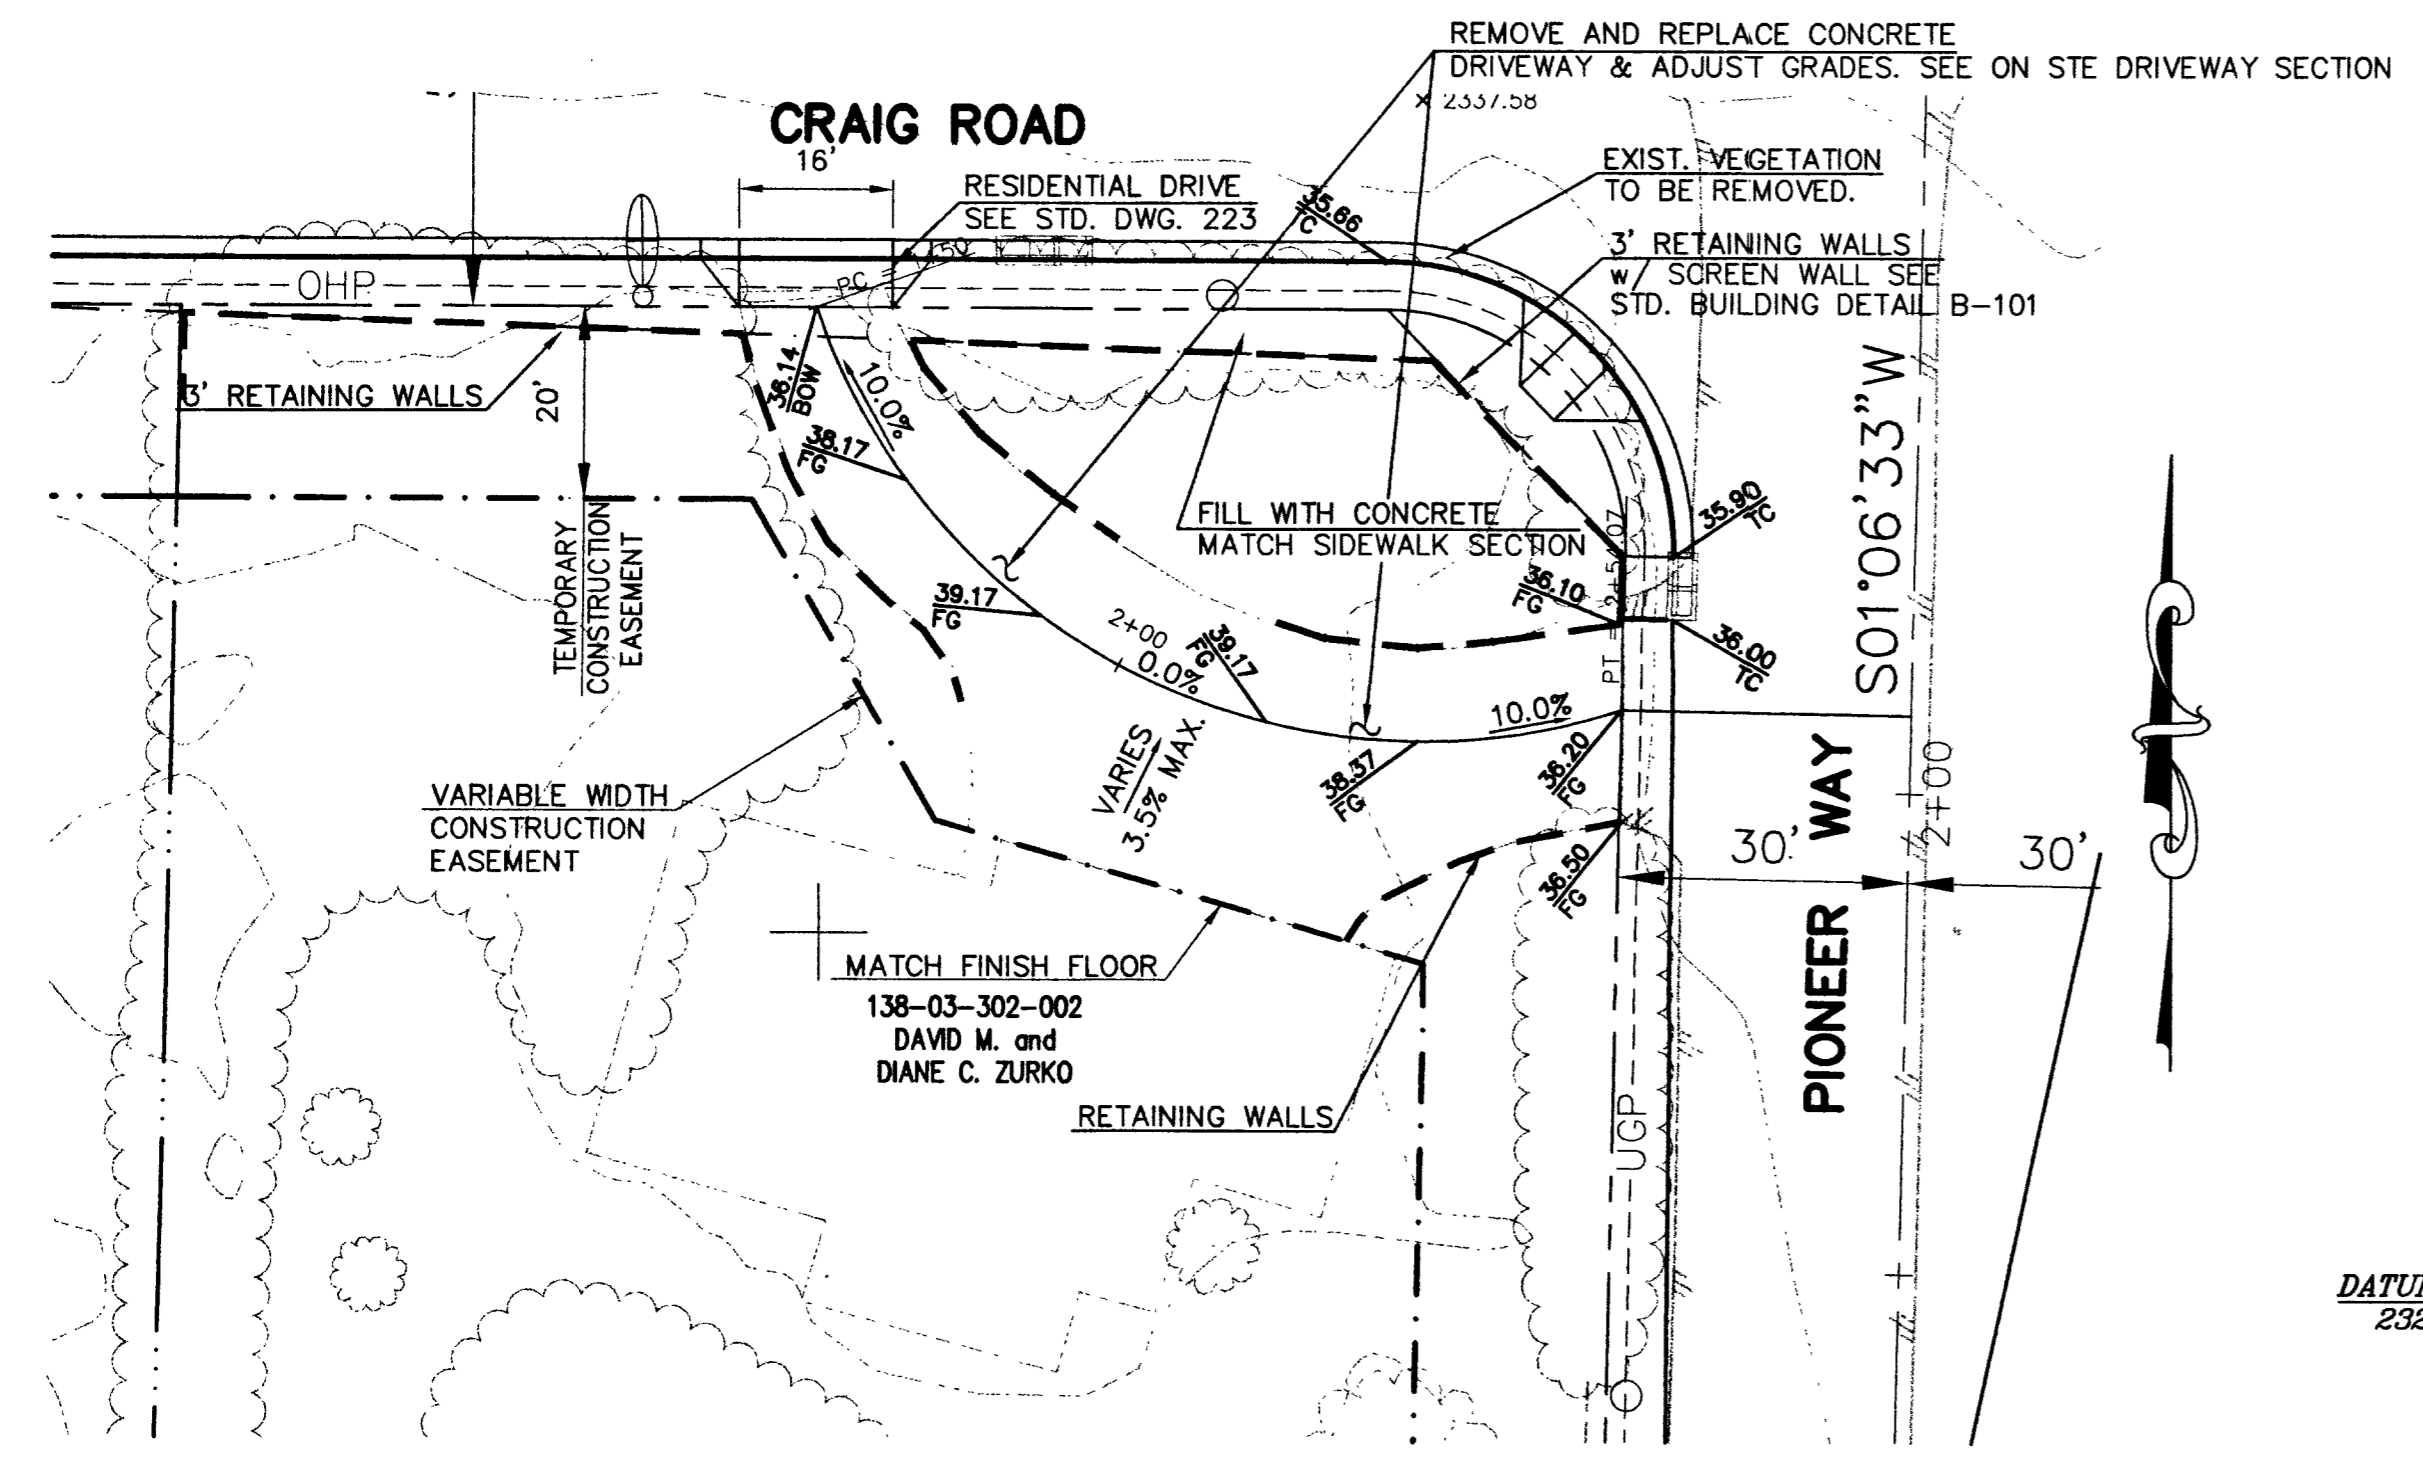



NOTE:
CONTRACTOR TO VERIFY LOCATION OF SEPTIC
TANK BEFORE CONSTRUCTION OF DRIVEWAY.

LOT GRADING CRAIG ROAD & PIONEER WAY

DRIVEWAY PLAN & PROFILE

SCALE:
HORIZ: 1" = 20'
VERT: 1" = 10'

NOTE:
FOR RETAINING WALLS SEE CLARK COUNTY
BUILDING DEPARTMENT DWG. B-101.

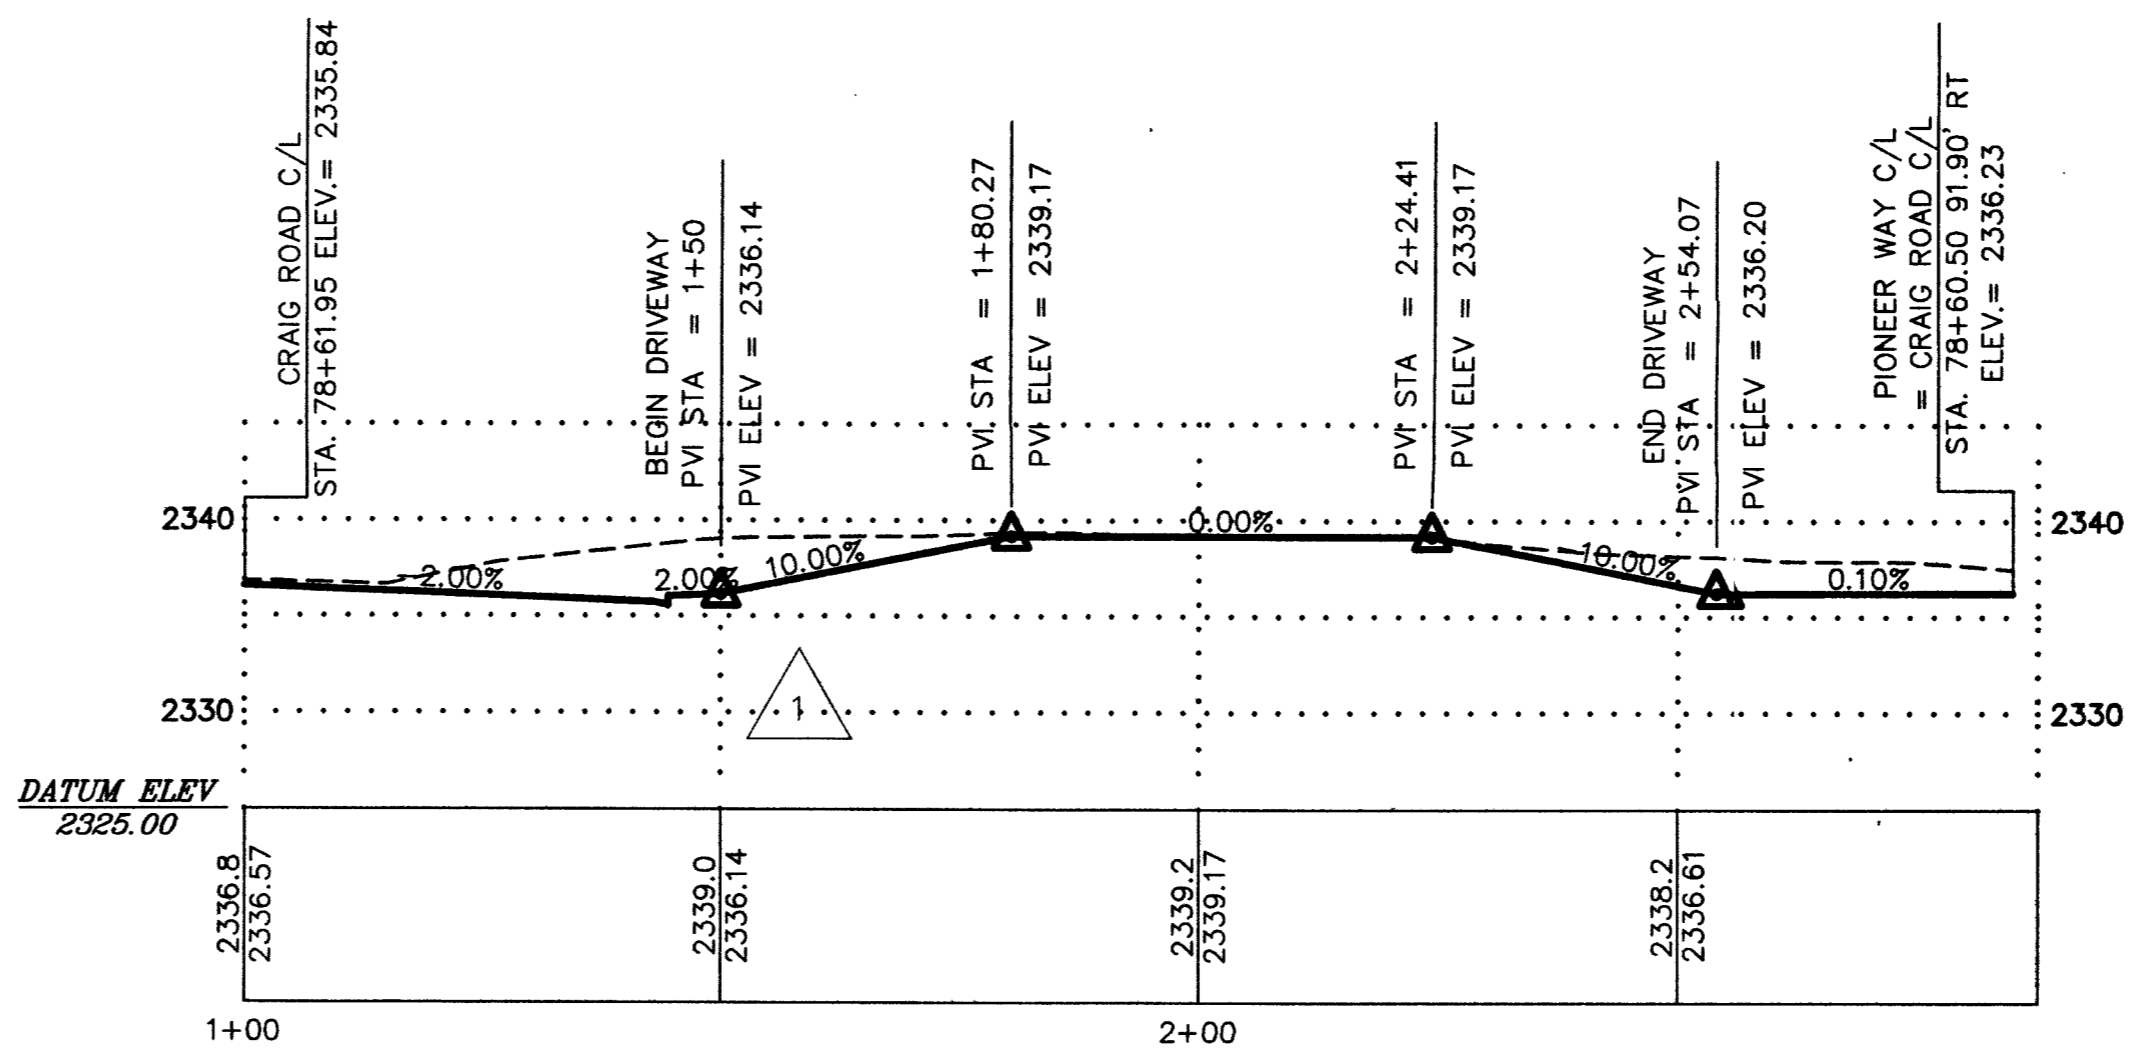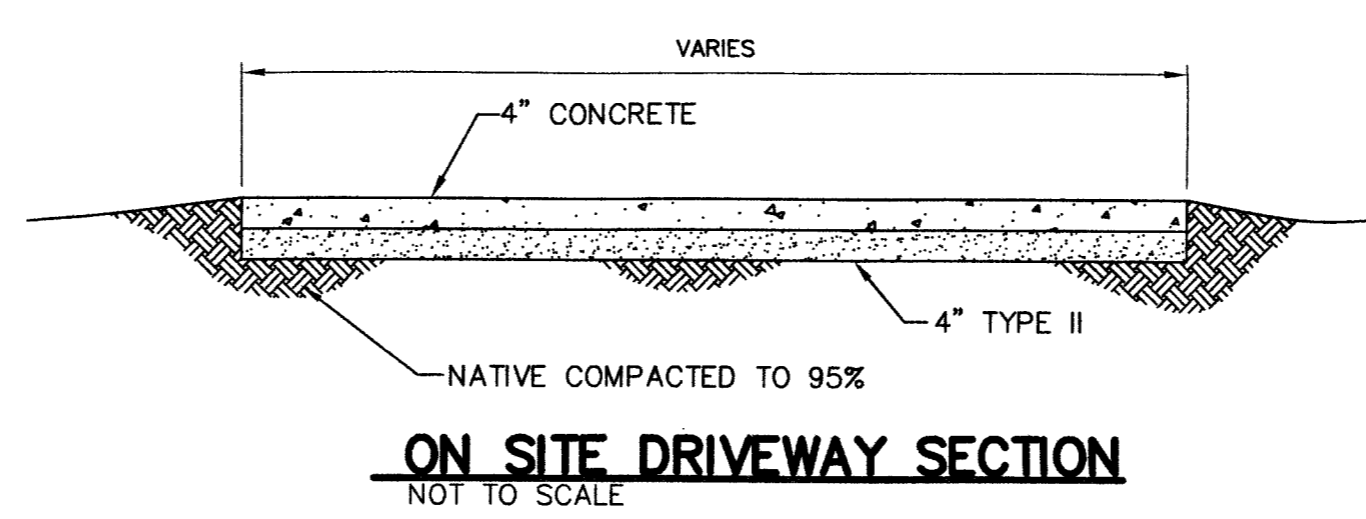

CITY OF LAS VEGAS 731 SOUTH FOURTH STREET LAS VEGAS, NEVADA 89101		URS Greiner 2785 EAST DESERT INN ROAD LAS VEGAS, NEVADA 89121 (702)-796-7775 FAX (702)-796-1803	
PRIVATE LOT GRADING		CRAIG ROAD IMPROVEMENTS BID NO. 00.1730.23	
DRAWN BY: DMS/MRA	DESIGNED BY: DMS/MRA	CHECKED BY: DM	PROJECT NO: 44300
DATE: 7/20/98	DATE: 7/20/98	DATE: 7/20/98	SCALE: 1" = 20 HOR NONE VERT
SHEET 52 OF 55 SHEETS		DRAWING NO. 107-V3048	

56327