



124142

1 CITY PARKWAY SITE PLAN
SCALE: 1/16" = 1'-0"

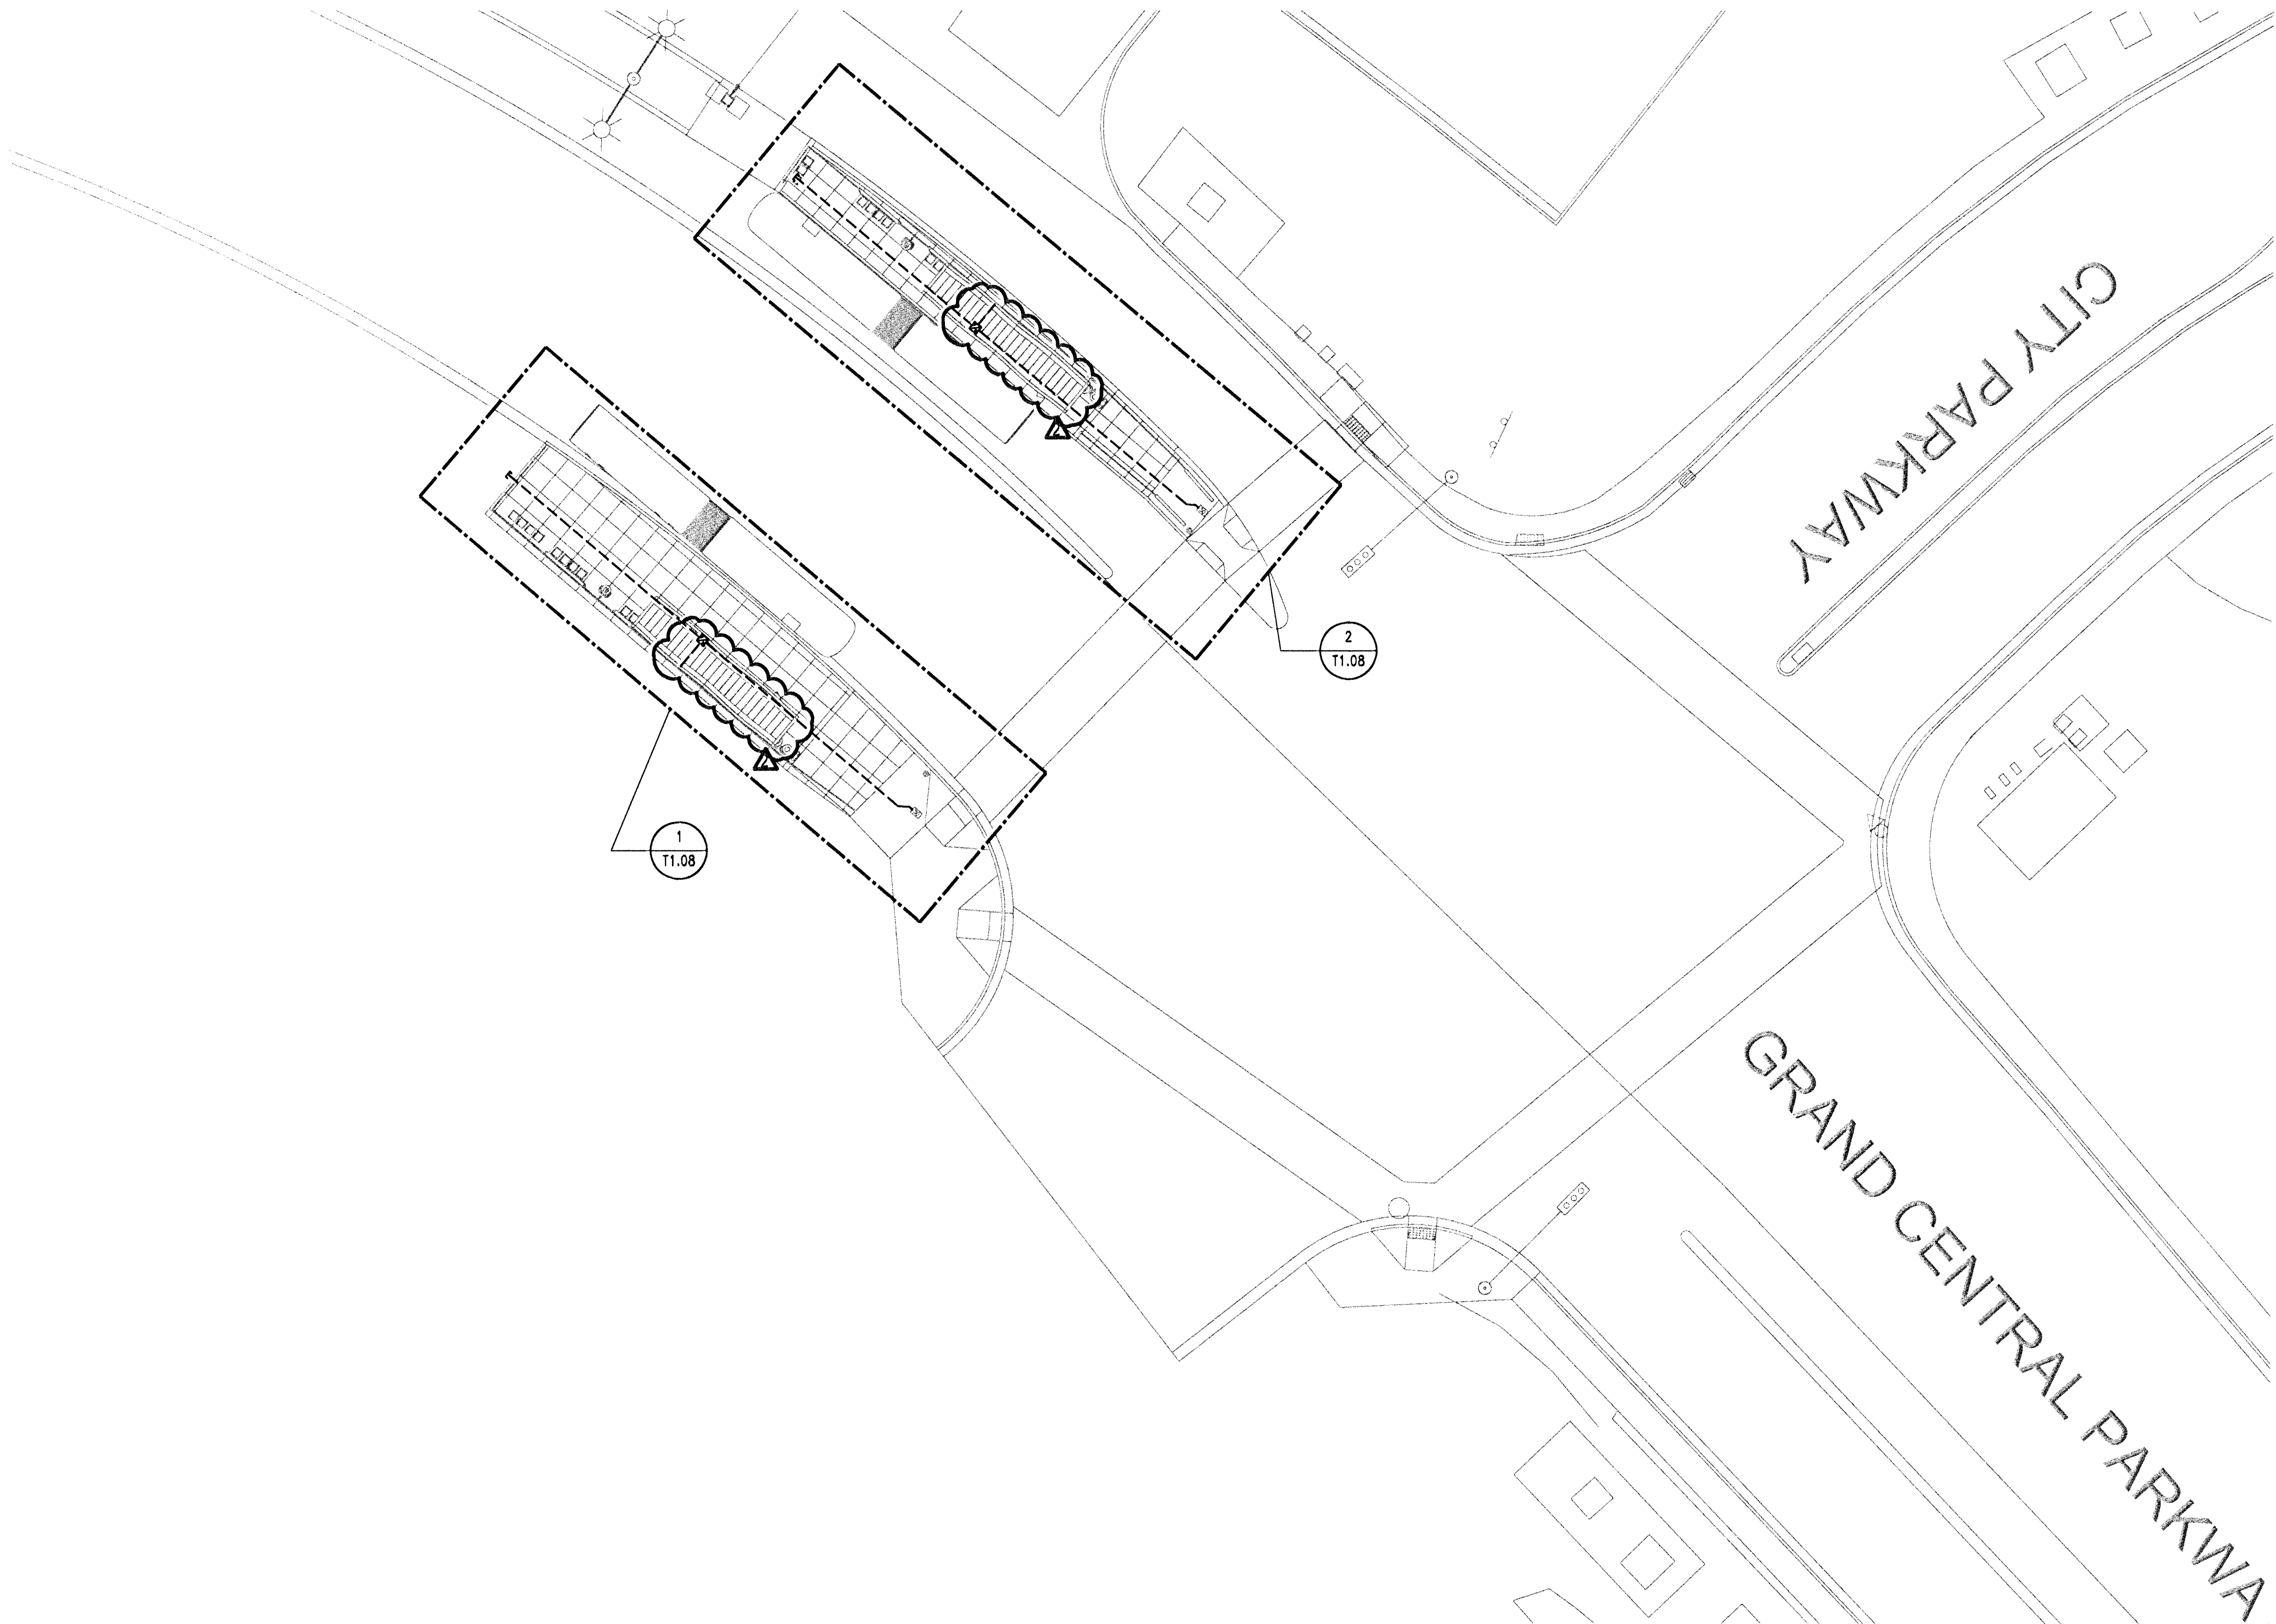


101 Convention Center
Drive, Suite 1100
Las Vegas, NV 89109
Phone: (702) 733-7120
Fax: (702) 733-9487
www.ibigroup.com

11/9/137

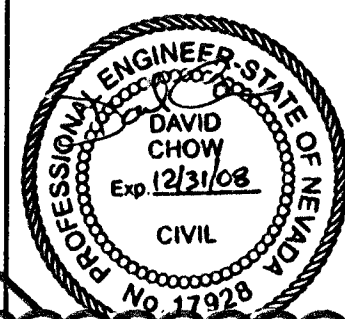

CITY PARKWAY SITE PLAN
ITS CONDUIT ROUTES

CASINO CENTER
BUS RAPID TRANSIT

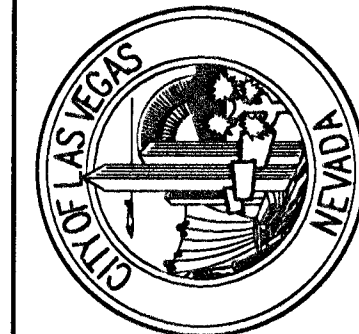

DEPARTMENT OF PUBLIC WORKS

TATE SNYDER KIMSEY ARCHITECTS

7700 Valley Verde, Court Henderson, Nevada 89014 phone: 702.455.3000 fax: 702.866.6209
www.tatesnyderkimsey.com
THESE DRAWINGS AND SPECIFICATIONS ARE THE PROPERTY OF THE ARCHITECTS AND MAY NOT BE REPRODUCED OR USED
FOR ANY PURPOSE WITHOUT THE ARCHITECTS WRITTEN CONSENT. AS INSTRUMENTS OF SERVICE, THESE DOCUMENTS ARE
TO REMAIN THE PROPERTY OF THE ARCHITECTS. UNLESS THEY ARE SCALE, SHOWN AND DATED
copyright Tate Snyder Kimsey, Ltd 2007

PLEASE RECYCLE

REVISIONS			
NO	DATE	DESCRIPTION	BY
1	06.18.08	T.M. REVISIONS	RG
2	03.31.08	ADDENDUM 1	RG