
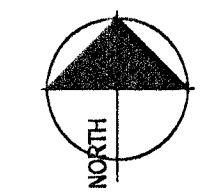



124143

1 DISCOVERY DRIVE SITE PLAN
SCALE: 1/16" = 1'-0"

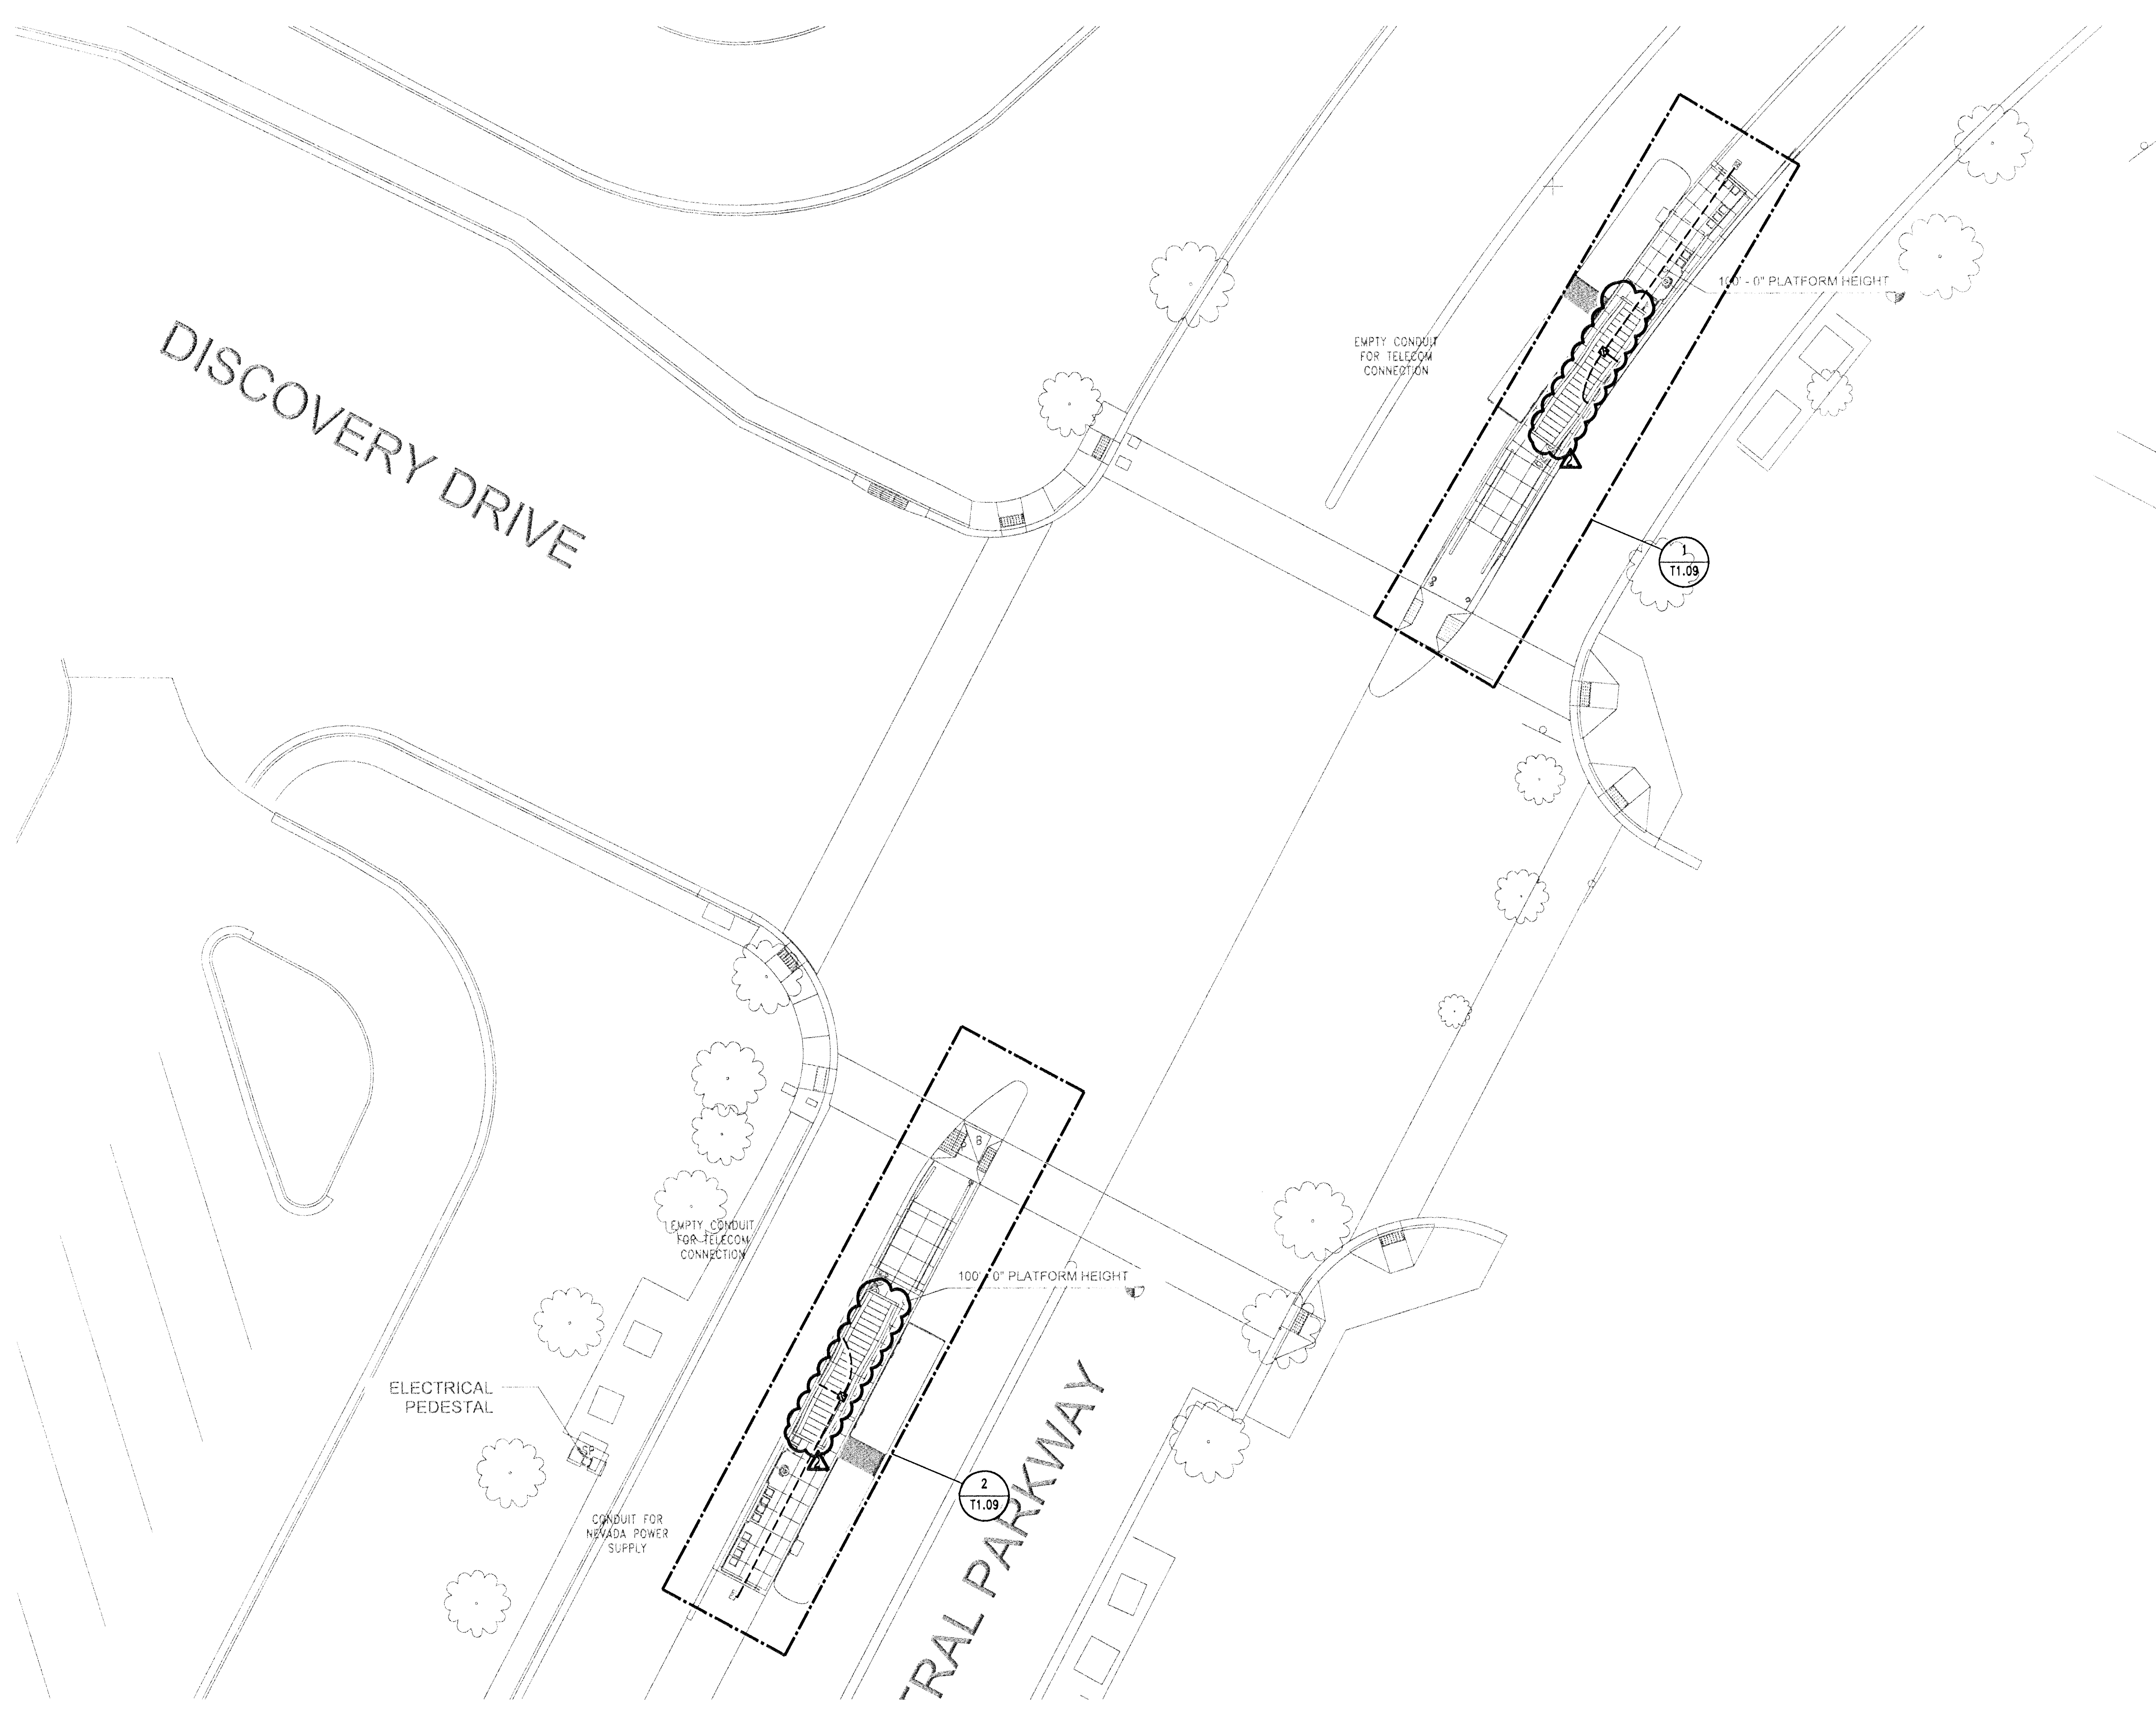

IBI GROUP
 101 Convention Center Drive, Suite 1100
 Las Vegas, NV 89109
 Phone: (702) 733-7120
 Fax: (702) 733-9487
 www.ibigroup.com

120/137

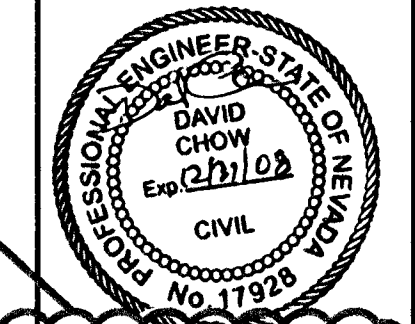


Sheet No:
TS1.09
 Drawing No: 107V4882

DEPARTMENT OF PUBLIC WORKS

**DISCOVERY DRIVE SITE PLAN
ITS CONDUIT ROUTES**

**CASINO CENTER
BUS RAPID TRANSIT**

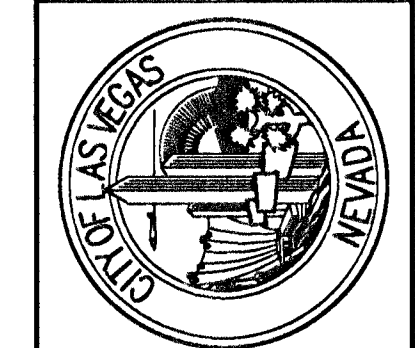

SCALE (R): 1:1
 SCALE (V): N/A
 DESIGNED BY: R. GULLICK
 CHECKED BY: P. LAVALLEE
 PROJECT NO: TSK 07 019
 PROJECT BID NO. OR ITRM ID: 081726.10
TATE SNYDER KIMSEY ARCHITECTS
 709 Valle Verde Court Henderson, Nevada 89014 phone: 702.456.3000 fax: 702.886.6209
 www.tatesnyderkimsey.com
 THESE DRAWINGS AND SPECIFICATIONS ARE THE PROPERTY OF THE ARCHITECTS AND MAY NOT BE REPRODUCED OR USED
 IN ANY MANNER WITHOUT THE WRITTEN PERMISSION OF THE ARCHITECTS. THIS DOCUMENT IS PRELIMINARY
 AND NOT FOR CONSTRUCTION. NO TIME AND READY FOR USE, AND THEREFORE NOT VALID, UNLESS THEY ARE SIGNED AND DATED.
 copyright Tate Snyder Kimsey, Ltd 2007

PLEASE RECYCLE

NO	DATE	DESCRIPTION	BY
08.18.08		T.M. REVISIONS	RG
03.31.08		ADDENDUM 1	RG