

HONOLULU STREET

BONANZA ROAD

SOCCER

EXISTING GRAGSON  
ELEMENTARY SCHOOL



**PLANTING LEGEND**

SYMBOL	BOTANICAL-COMMON NAME
	FRAXINUS OXYCARPA 'RAYWOOD' RAYWOOD ASH - STD.
	FRAXINUS VELUTINA 'RIO GRANDE' FAN-TEX ASH (LARGE) - STD.
	FRAXINUS VELUTINA 'RIO GRANDE' FAN-TEX ASH - STD.
	OLEA EUROPAEA 'SWAN HILL' SWAN HILL OLIVE - MULTI.
	PINUS ELDARICA MONDEL PINE
	PISTACIA CHINENSIS CHINESE PISTACHE - STD.
	PYRUS KAWAKAMII EVERGREEN PEAR
	ROBINIA AMBIGUA 'PURPLE ROBE' PURPLE ROBE LOCUST - STD.
	EXISTING TREE PROTECT IN PLACE
	EXISTING TREE TO BE DEMOLISHED
	ACACIA REDOLENS 'DESERT CARPET' DESERT CARPET PROSTRATE ACACIA
	CASSIA ARTEMISIOIDES FEATHERY CASSIA
	HESPERALOE PARVIFLORA 'DUET' RED/YELLOW HESPERALOE
	LEUCOPHYLLUM LAEVIGATUM CHIHUAHUAN SAGE
	MUHLENBERGIA LINDHEIMERI 'AUTUMN GLOW' AUTUMN GLOW DEER GRASS
	MYRTUS COMMUNIS 'COMPACTA' COMPACT GREEK MYRTLE
	NOLINA MICROCARPA BEARGRASS
	ROSMARINUS OFFICINALIS ROSEMARY
	BERMUDA SOD
	CYNODON SPECIES 'TIFWAY II' TIFWAY II HYBRID BERMUDA
	3" SCREENED GRANITE COBBLE, 6" DEEP. COLOR TO MATCH DECOMPOSED GRANITE COLOR.
	STABILIZED DECOMPOSED GRANITE. INSTALL 2" LAYER OF 1/4" MINUS DECOMPOSED GRANITE TO MATCH GRANITE COLOR SPECIFIED IN NOTE #1 BELOW WITH STABILIZER AT 12 LBS. PER TON. INSTALL PER MANUFACTURERS RECOMMENDATIONS.

MATCHLINE - SEE SHEET L1.02  
MATCHLINE - SEE SHEET L1.01

**NOTES:**

- 1) DECOMPOSED GRANITE (D.G.) - INSTALL A 2" LAYER OF 3/8" MINUS (30% 3/4", 30% 1/2", 40% MINUS) GOLD/TAN COLOR DECOMPOSED GRANITE CONTINUOUS IN ALL PLANTERS UNDER ALL TREES AND SHRUBS. BEFORE PLACING GRANITE, COMPACT SUB-GRADE TO 85% AND APPLY A PRE-EMERGENT HERBICIDE TO SOIL. AFTER PLACING GRANITE: RAKE SMOOTH, WET TO ENTIRE DEPTH, ALLOW TO DRY, THEN LIGHTLY SCARIFY SURFACE WITH A LEAF RAKE. APPLY A SECONDARY APPLICATION OF PRE-EMERGENT HERBICIDE TO TOP OF GRANITE. KEEP TOP OF GRANITE 1" BELOW ADJACENT WALKS AND CURBS. DO NOT ALLOW GRANITE TO TOUCH THE TRUNK OF ANY PLANT. INSTALL AFTER INSTALLATION OF PLANT MATERIAL. SEE DETAIL 'K', SHEET L5.01. SUBMIT COLOR SAMPLE FOR APPROVAL.
- 2) SEE SHEET L5.01 FOR PLANTING DETAILS, PLANT SIZES, AND PLANT QUANTITIES.

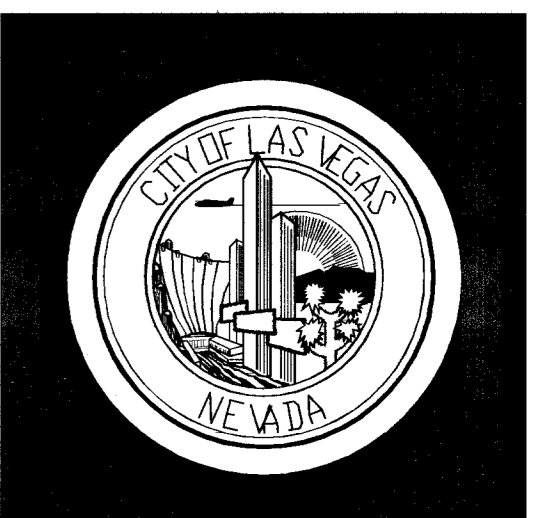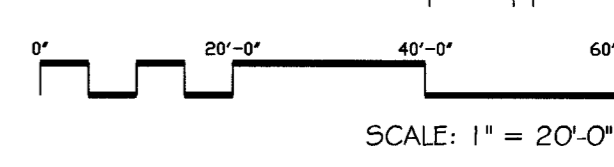

REVISIONS

NO.	DATE	DESCRIPTION

CONSULTANT

**SOUTHWICK LANDSCAPE ARCHITECTS**  
6862 McLeod Drive, Suite 3  
Las Vegas, NV 89120  
702.597.3108

BONANZA-SANDHILL PARK

PLANTING PLAN  
CONSTRUCTION SET

STAMP

**RECORD DRAWINGS  
NOT FOR CONSTRUCTION**

1) TO ALTER THESE DOCUMENTS FOR ANOTHER PROJECT BY ANYONE OTHER THAN THE ORIGINAL ARCHITECT IS A VIOLATION OF THE LAW.

2) THIS RECORD DRAWING HAS BEEN PREPARED BY THE ARCHITECT OR ARCHITECTS ASSOCIATE IN ACCORDANCE WITH THE REQUIREMENTS OF THE ARCHITECTURAL PROFESSIONAL BOARD OF THE STATE OF NEVADA. THE ARCHITECT ASSOCIATE HAS REVIEWED THIS DRAWING FOR ACCURACY AND COMPLIANCE WITH THE REQUIREMENTS OF THE ARCHITECTURAL PROFESSIONAL BOARD OF THE STATE OF NEVADA. THE ARCHITECT ASSOCIATE DOES NOT WARRANT THE ACCURACY OF THIS INFORMATION.

3) INFORMATION THAT MAY BE INCLUDED WOULD BE SUBJECT TO CHANGE TO REFLECT THE LATEST INFORMATION AVAILABLE TO THE ARCHITECT AND ARCHITECTS ASSOCIATE. ANY CHANGES TO THE INFORMATION WOULD BE INDICATED BY A REVISION.

OWNER: CITY OF LAS VEGAS  
DEPARTMENT OF PUBLIC WORKS  
ARCHITECTURAL SERVICES

400 EAST STEWART AVENUE  
LAS VEGAS, NEVADA 89101  
PHONE: (702) 229-8535  
FAX: (702) 382-2222  
TDD: (702) 386-9108

DRAWN: EAL  
FILE: L02-016.DWG  
DATE: 08-23-02  
SCALE: 1" = 20'-0"  
BID NO: 021534107  
CLW DWN NO: 65069

26

SHT NO: L2.01

66578