




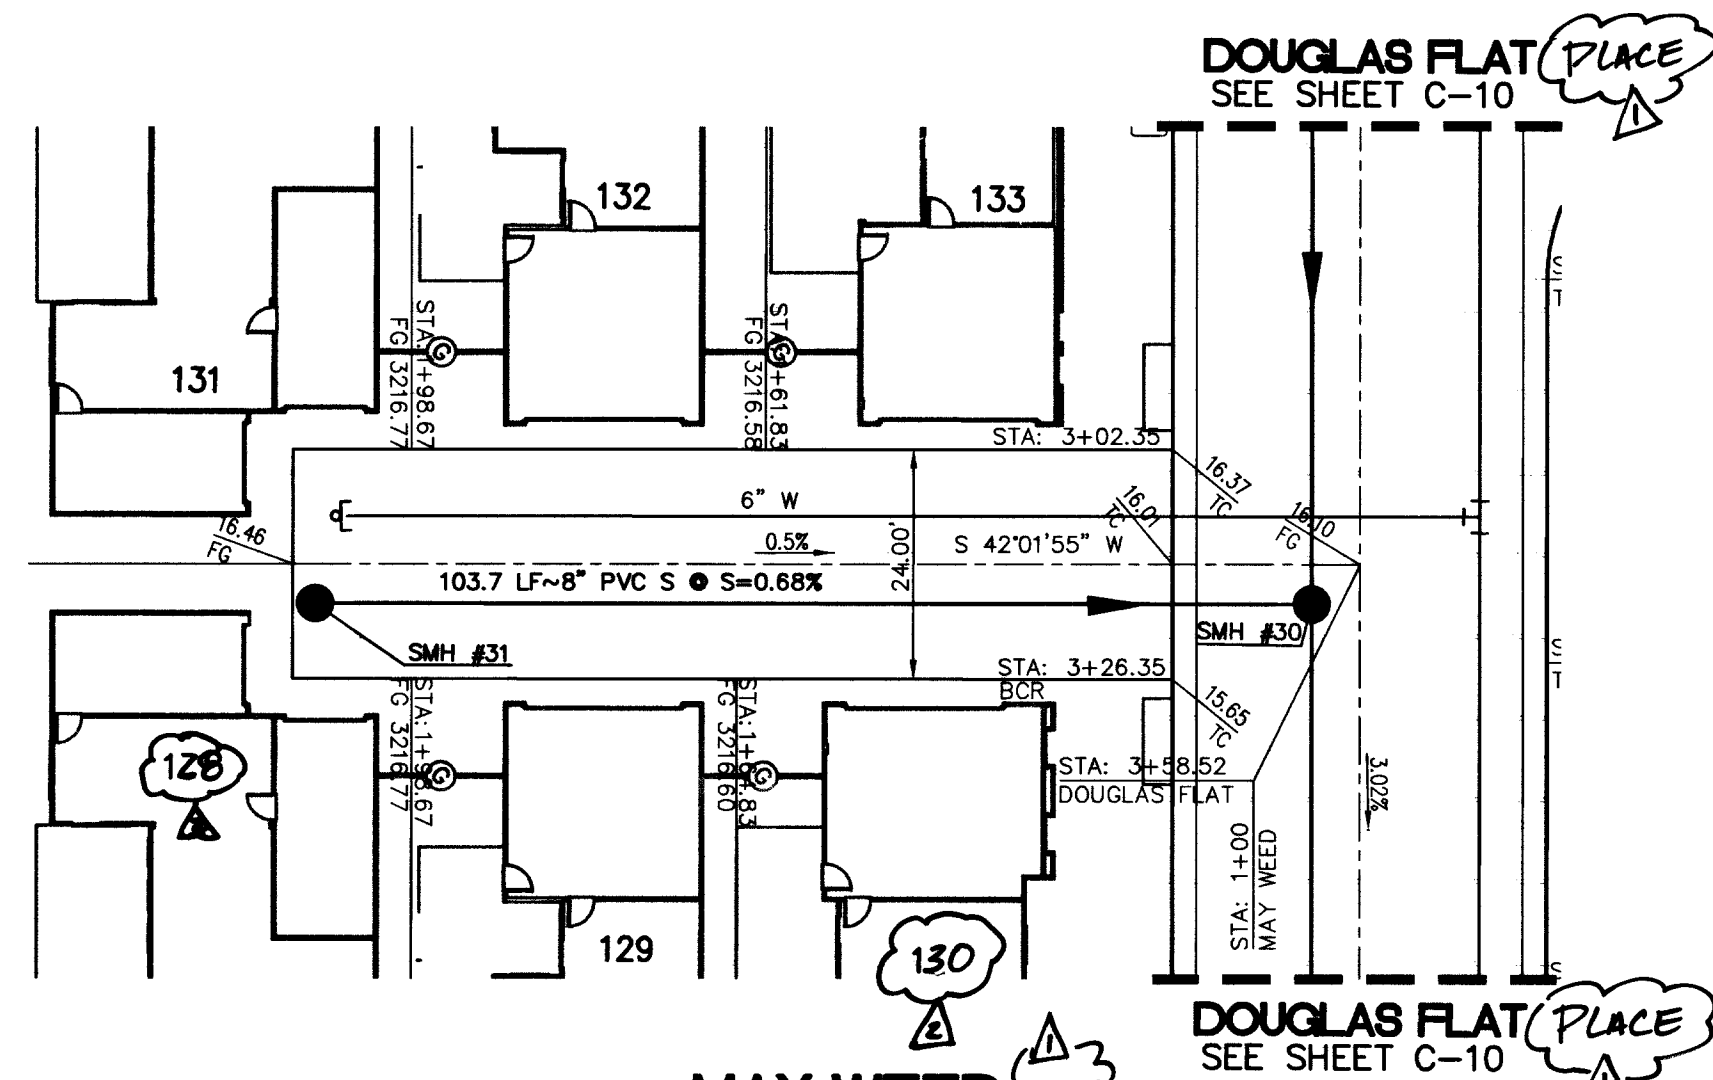


SCALE
HORIZ. 1" = 20'
VERT. 1" = 2'

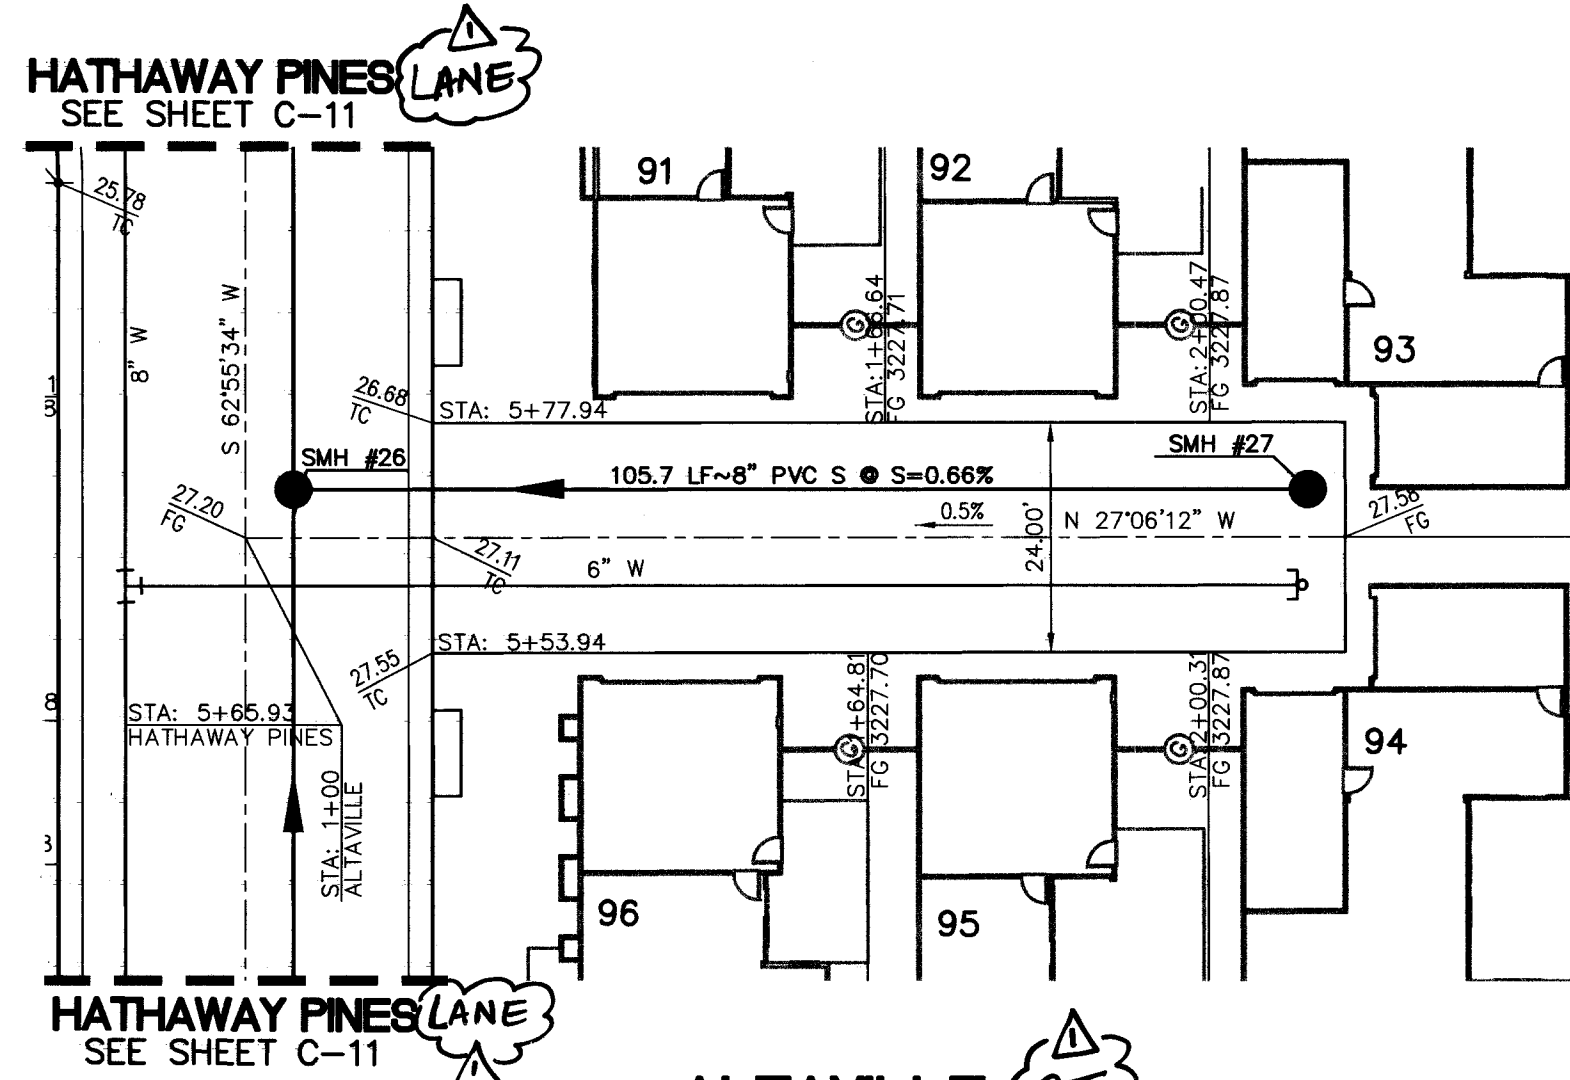

SCALE
HORIZ. 1" = 20'
VERT. 1" = 2'

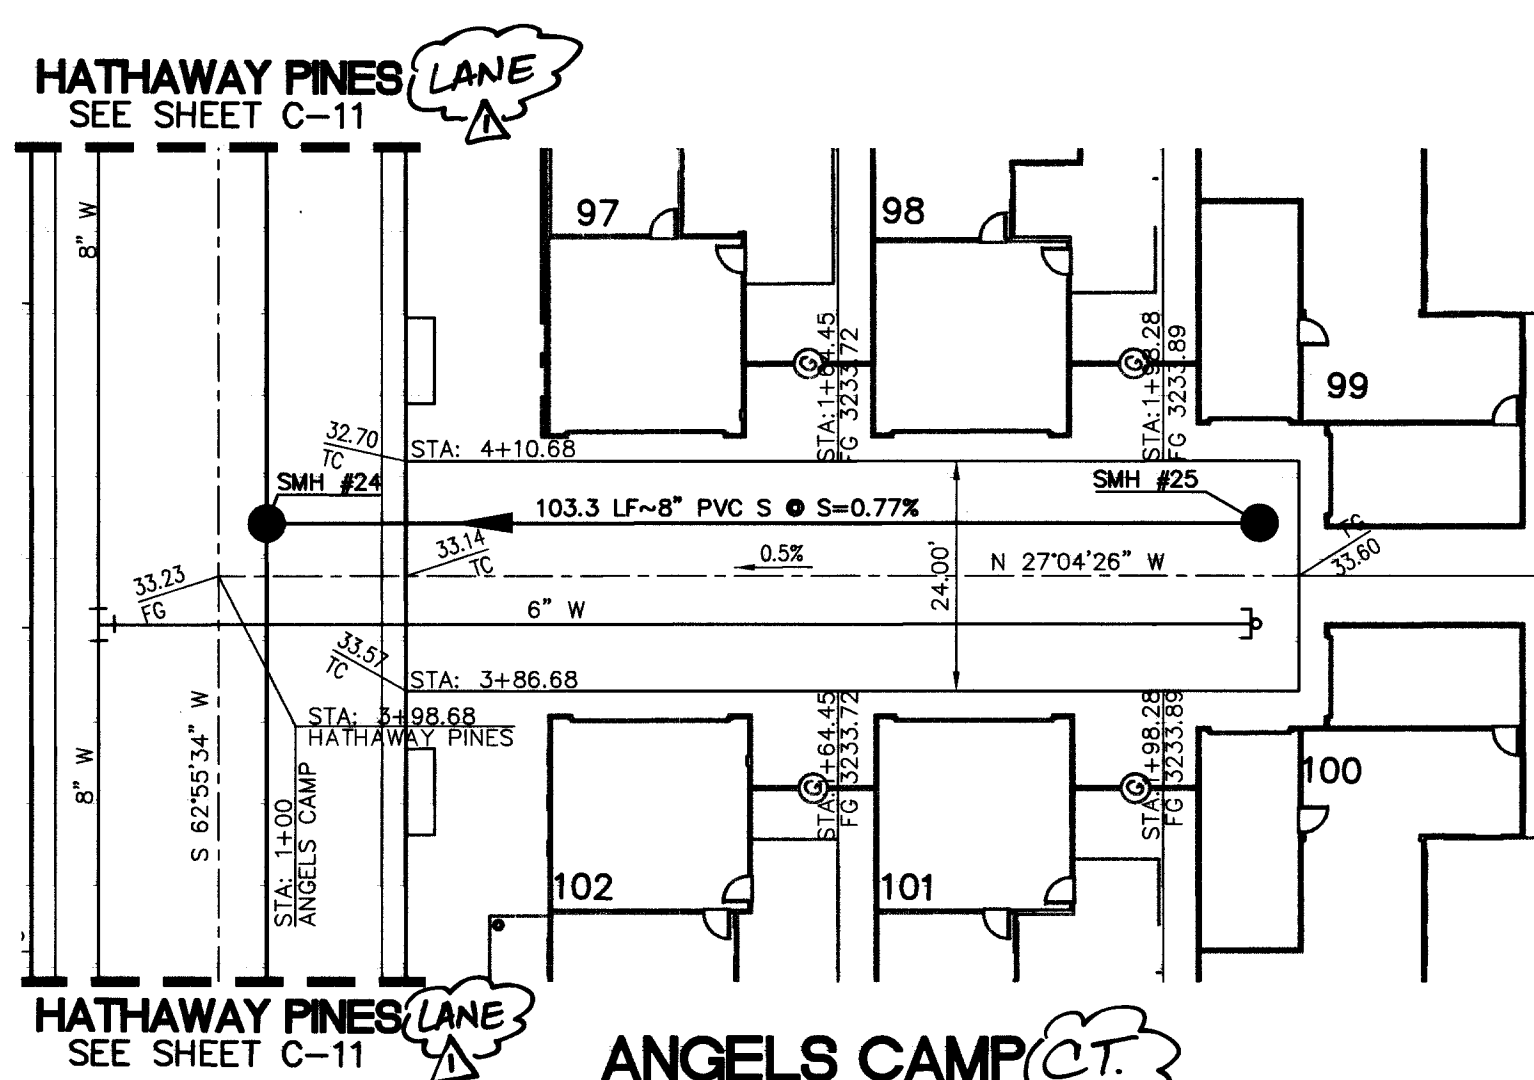

SCALE
HORIZ. 1" = 20'
VERT. 1" = 2'

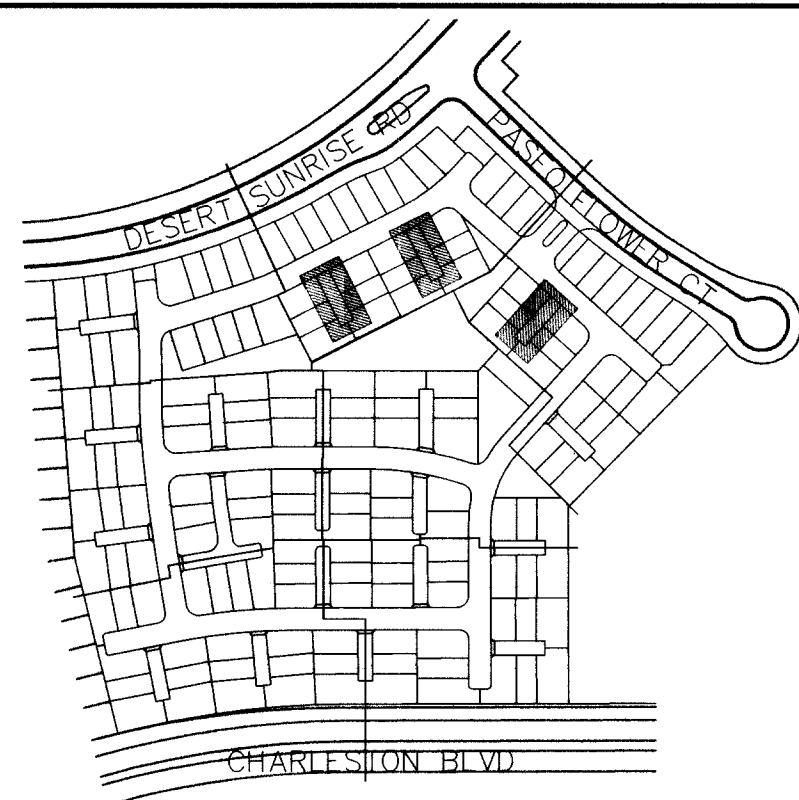

KEY MAP

PROJECT BENCHMARK:




CITY OF LAS VEGAS BENCHMARK: D368 3
NAVD 88 ELEVATION: 989.599 (M)-3246.71 (F)

U.S.C. & G.S. BRASS DISC SET IN ROCK ON THE EAST SIDE OF
CHARLESTON BOULEVARD AND SOUTH OF THE RED ROCK DETENTION
BASIN.

BASIS OF BEARING:

NORTH 89°45'05" EAST BEING THE SOUTH LINE OF THE SOUTHWEST QUARTER (SW 1/4) OF SECTION 35, TOWNSHIP 20, RANGE 59 EAST, M.D.M., AS SHOWN BY MAP ON FILE IN FILE 91, PAGE 28 OF PARCEL MAPS IN THE CLARK COUNTY RECORDER'S OFFICE, CLARK COUNTY, NEVADA.

NOTE:
ALL PRIVATE STREETS & DRIVES ARE PUBLIC SEWER EASEMENTS, PUBLIC UTILITY EASEMENTS AND PUBLIC DRAINAGE EASEMENTS TO BE PRIVATELY MAINTAINED.

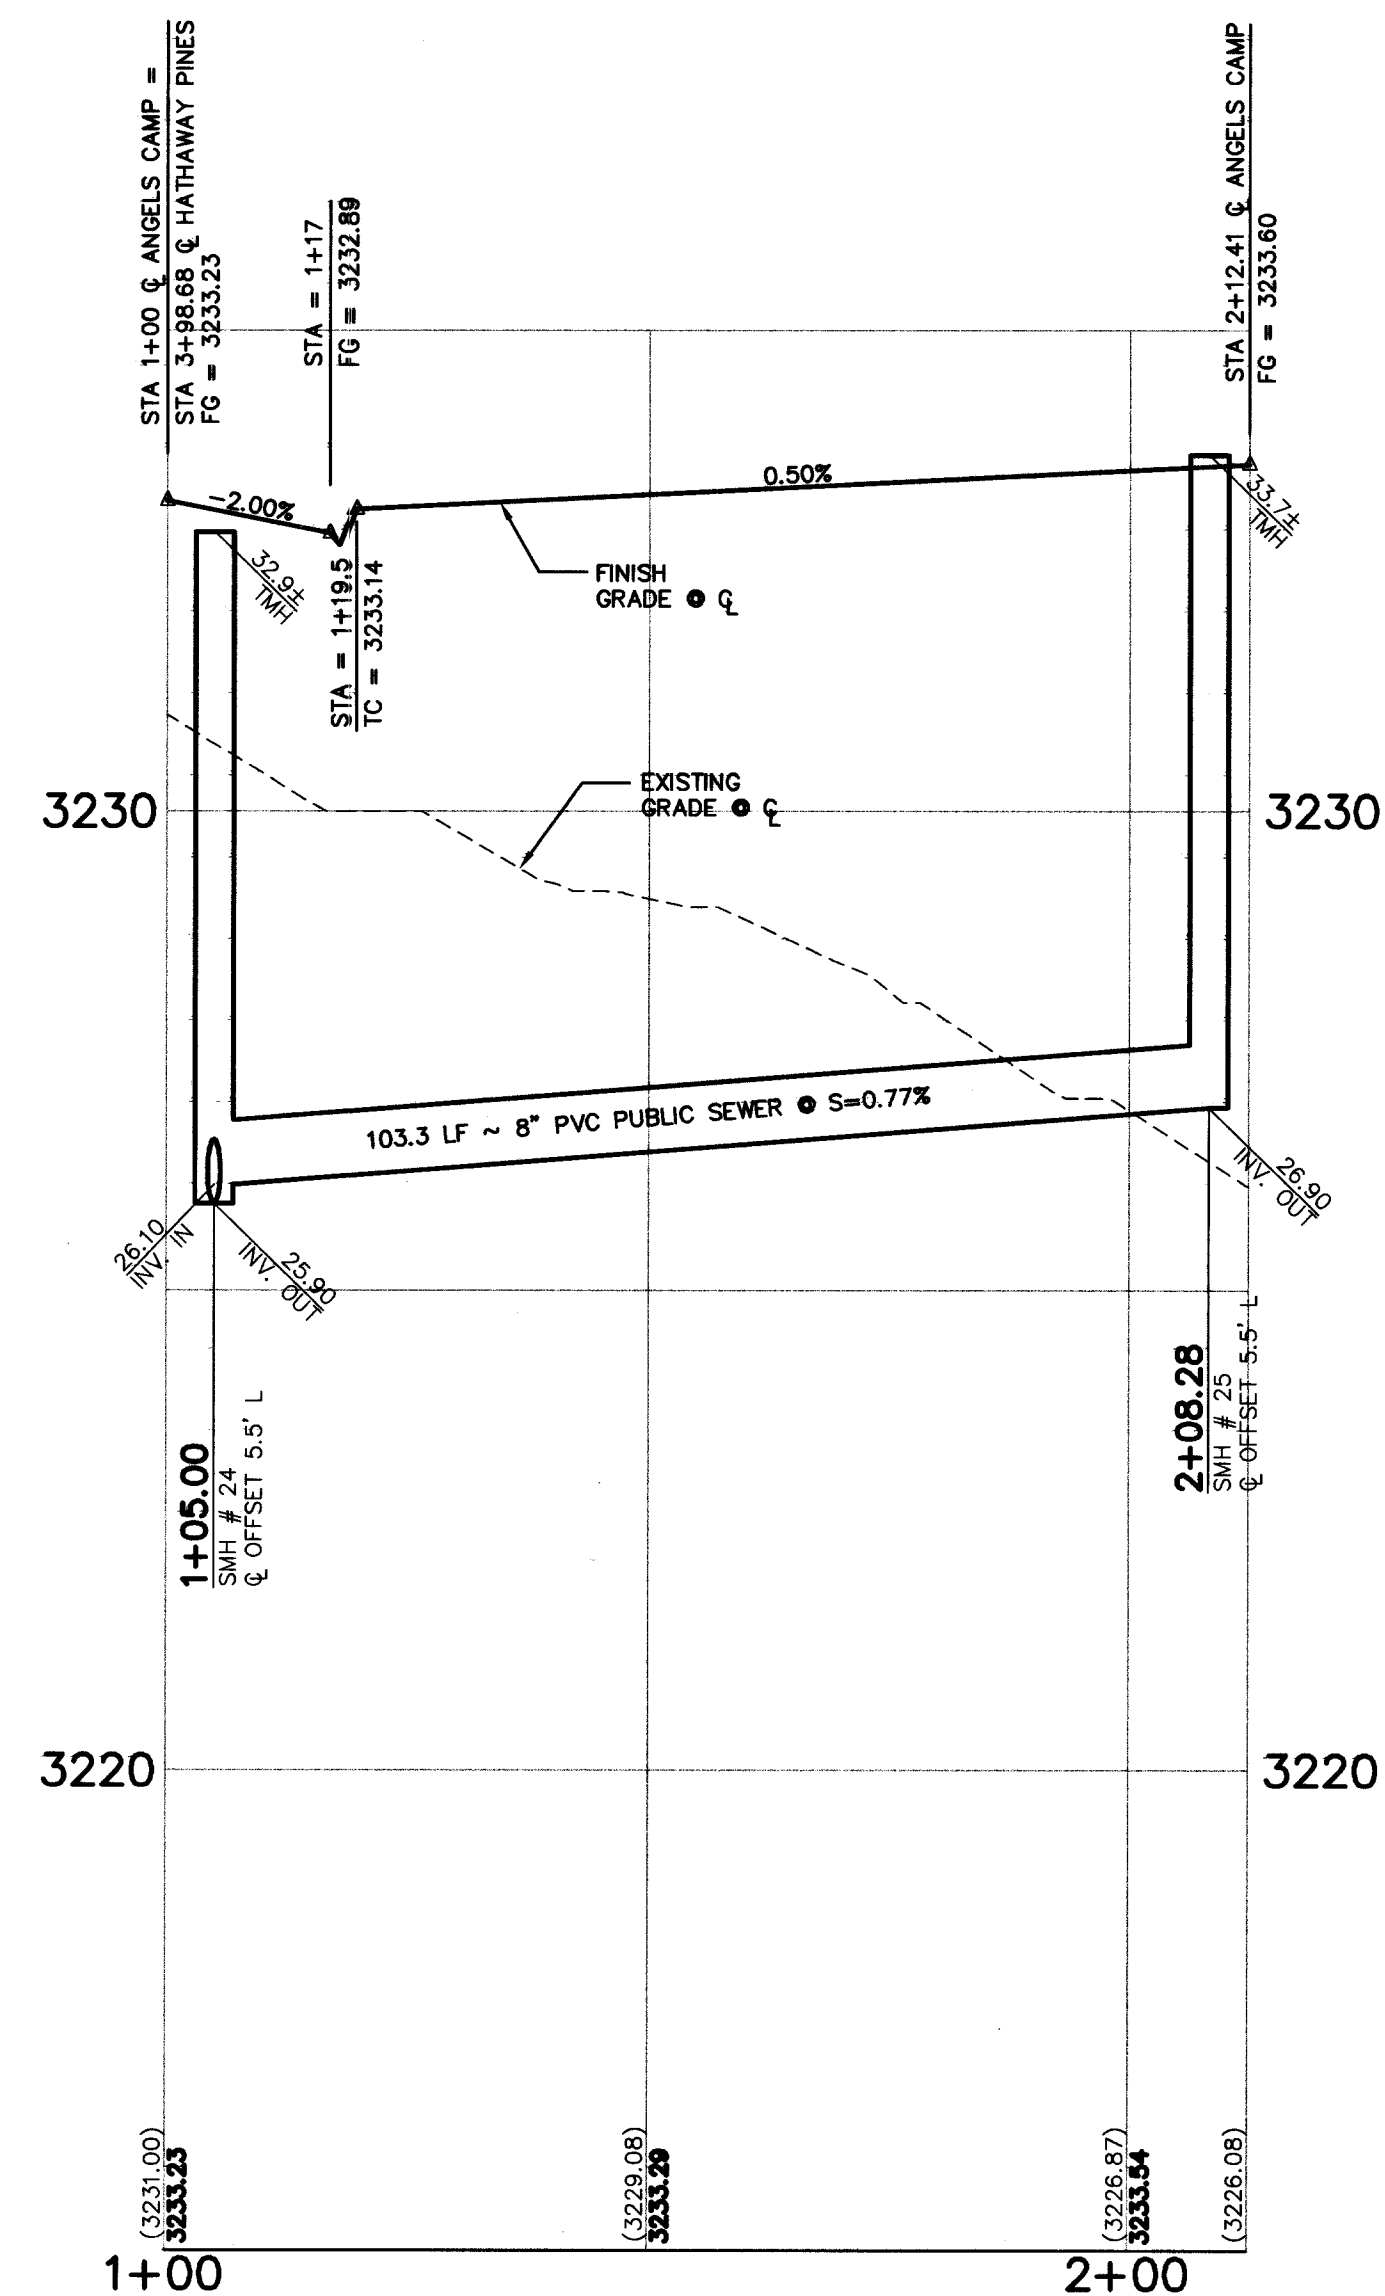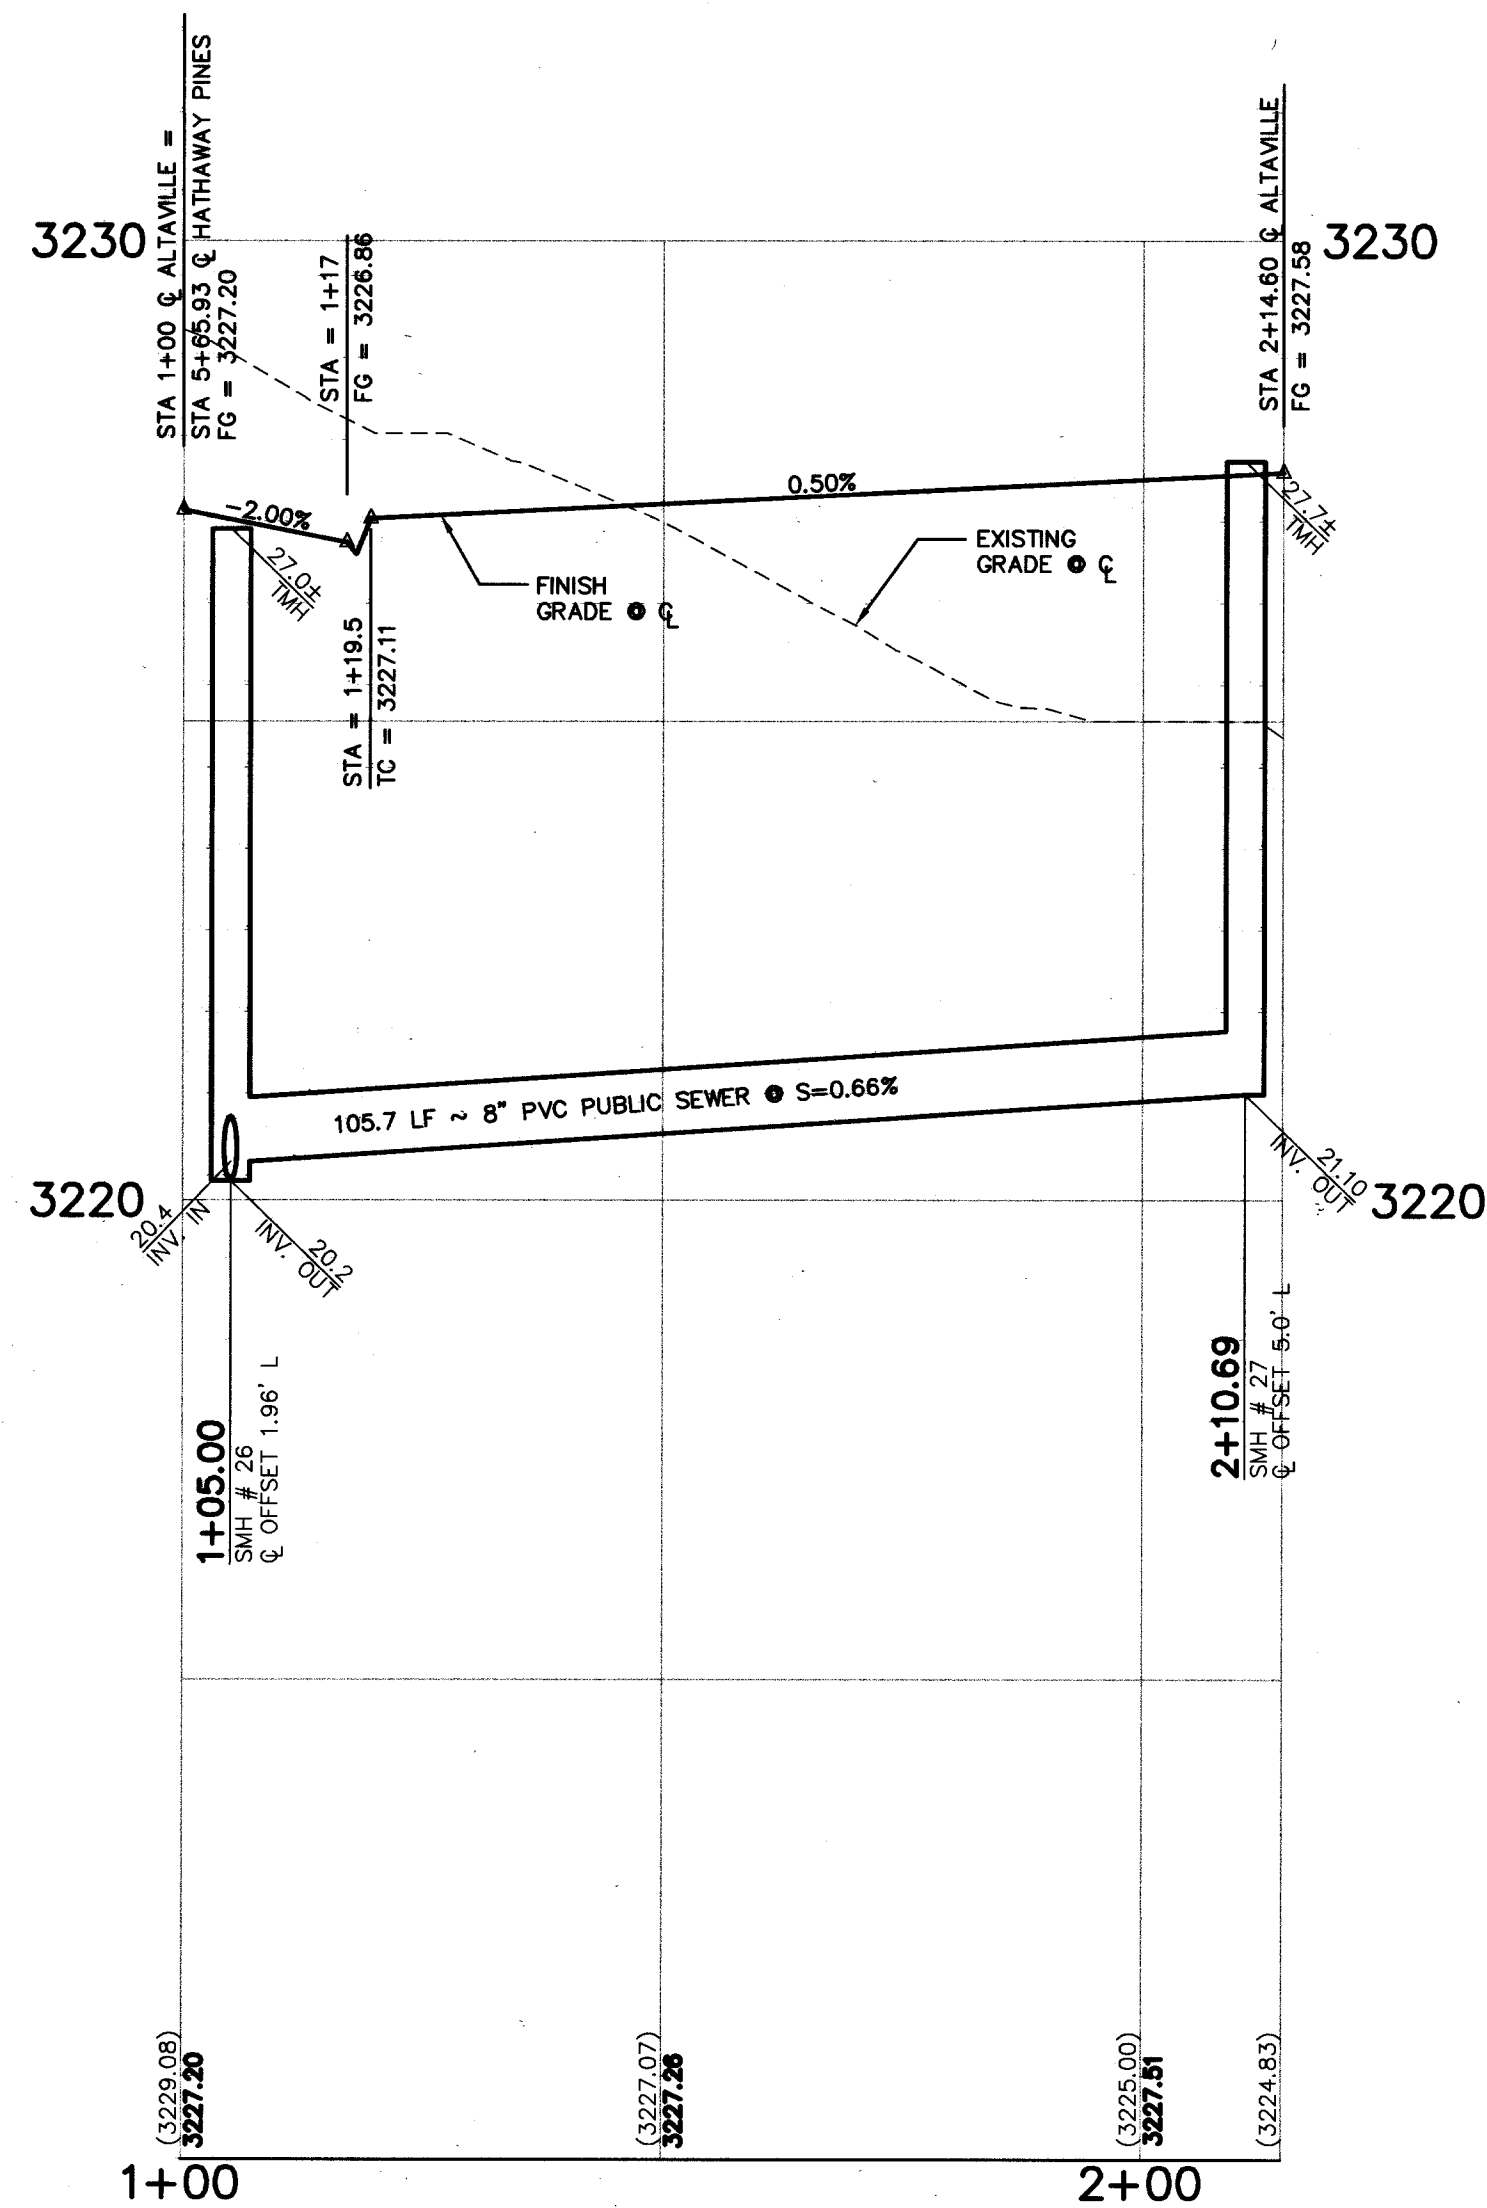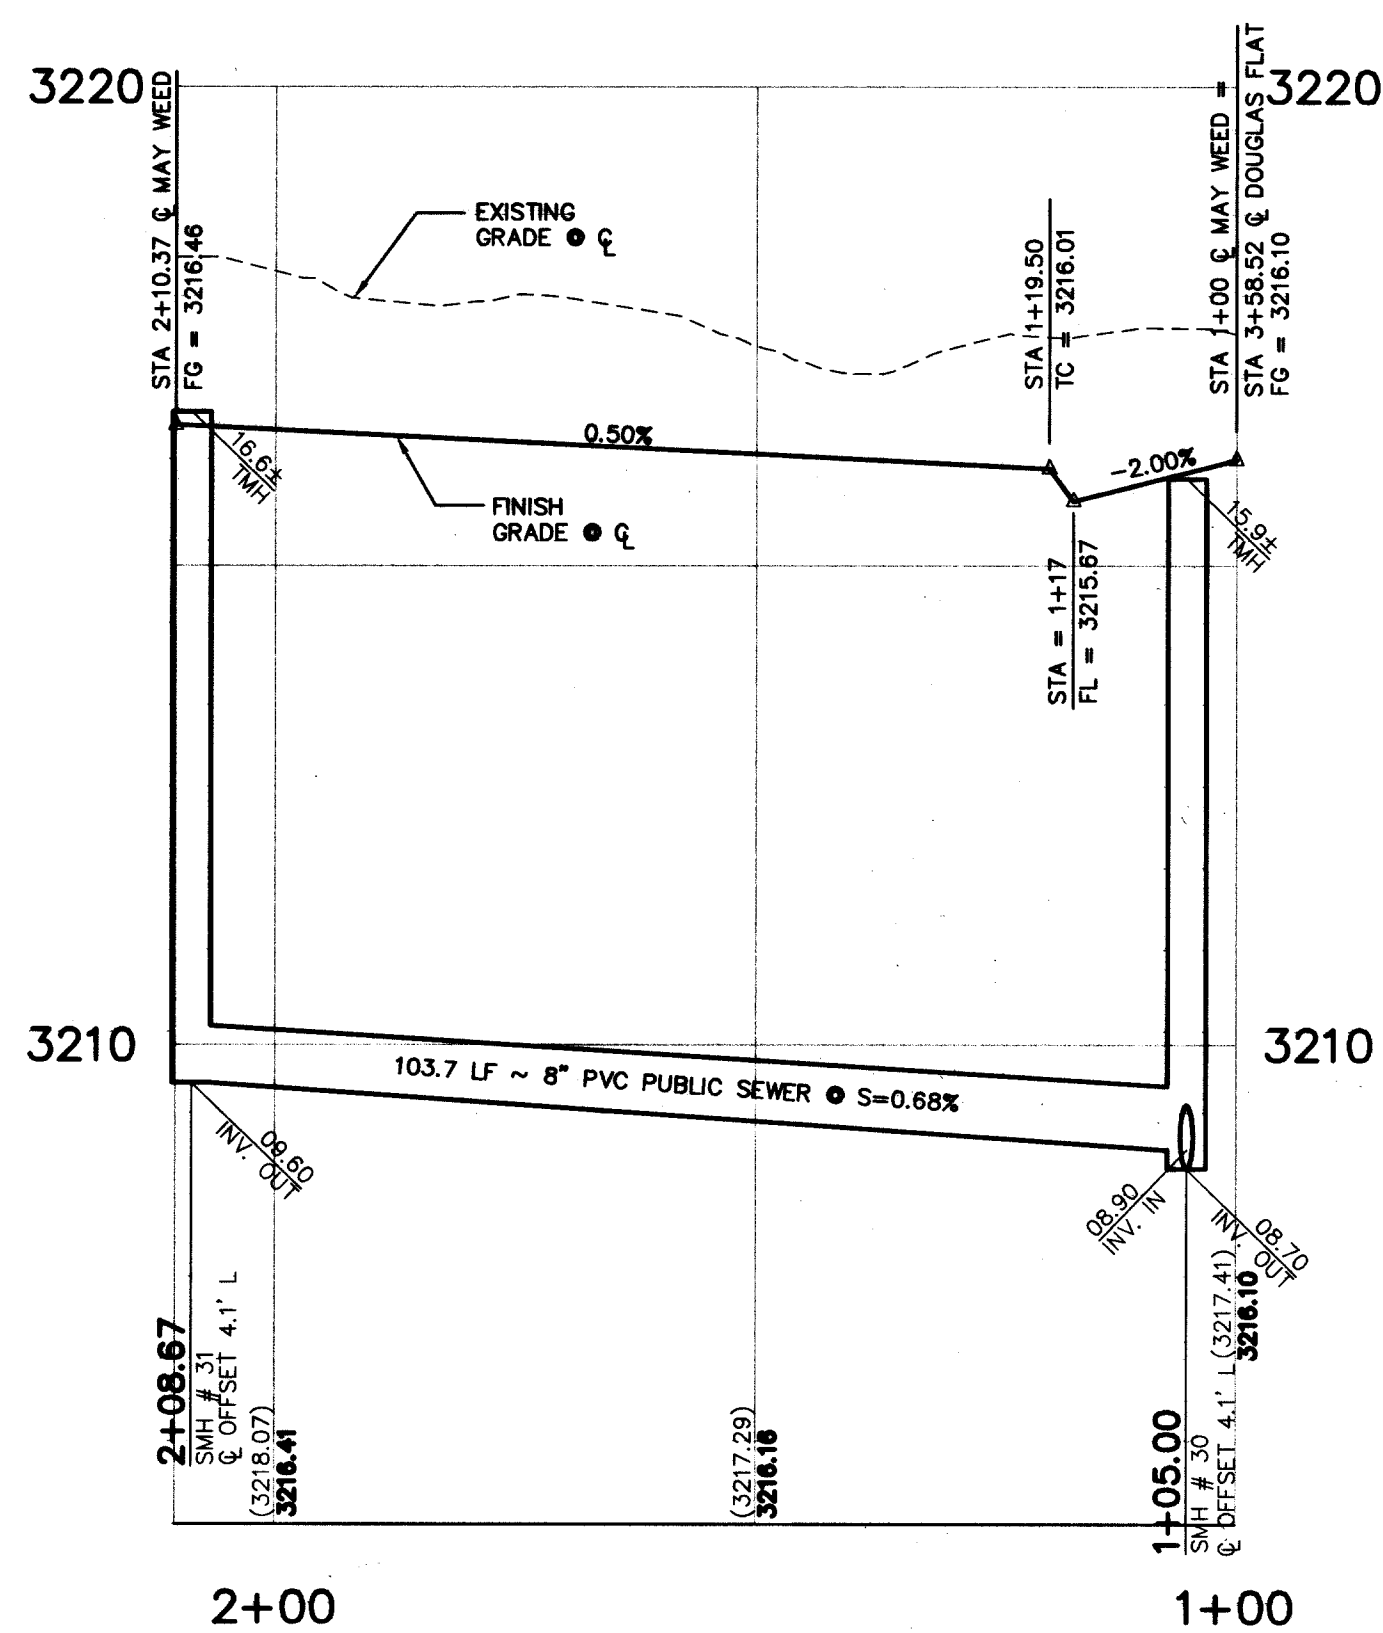


10744778

Avoid cutting underground utility lines. It's costly.

Call
before you
Dig

1-800-227-2600

UNDERGROUND SERVICE (USA)

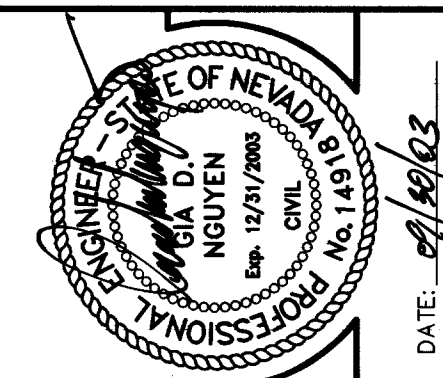

REV	DATE	DESCRIPTION
2	4/13/04	REVISED LOT NUMBERS
1	12/31/03	CHANGED STREET SUFFIXES.

DESIGN: _____
DRAWN: _____
CHECK: _____
SSUE DATE: _____
SSUE EDITOR: _____
PLOT DATE: 09-25-03
PLOT TIME: 14:22:22

G.C. WALLACE, INC.
Engineers/Planners/Surveyors
1555 SOUTH RAINBOW BLVD./LAS VEGAS, NEVADA 89146
TELEPHONE: (702) 804-2000 • FAX: (702) 804-2239

CALAVERA

RICHMOND AMERICAN HOMES

MAY WEED, ALTAVILLE, ANGELS CAMP
PLAN + PROFILE

SHEET
C-24
24 OF 41 SHTS

24 OF 41 SHOTS