

ASTORIA AT TOWN CENTER NORTH - UNIT 1
MONUMENTATION TIE MAP

(A COMMON INTEREST COMMUNITY)
BEING A SUBDIVISION OF A PORTION OF GOVERNMENT LOT 5 AND A PORTION OF GOVERNMENT LOT 6 OF SECTION 17,
TOWNSHIP 19 SOUTH, RANGE 60 EAST, M.D.M., CITY OF LAS VEGAS, CLARK COUNTY, NEVADA.



MATCHLINE SEE SHEET 2 OF 5



I, ANTHONY ZICARI, A PROFESSIONAL LAND SURVEYOR LICENSED IN THE STATE OF NEVADA, DO HEREBY CERTIFY THAT THE MONUMENTS HAVE BEEN SET AND THE TIE DISTANCES ESTABLISHED AS SHOWN HEREON. THIS SURVEY WAS COMPLETED ON JULY 7, 2011.



ANTHONY ZICARI, P.L.S.
NEVADA LICENSE NO. 11449

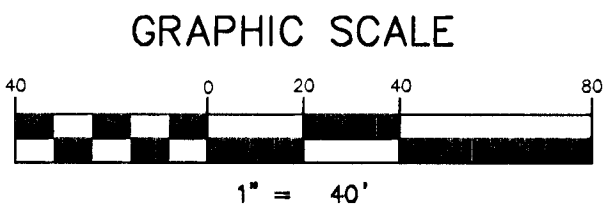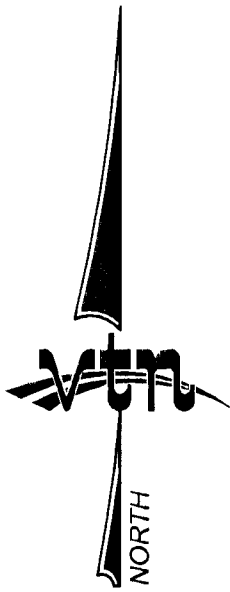

NOTES

SEE FINAL MAP FOR BEARING AND DISTANCES.
(BOOK 119, PAGE 45)

LEGEND

- 2 LOT NUMBER
- (X) BLOCK NUMBER
- RIGHT OF WAY
- LOT LINES
- SUBDIVISION BOUNDARY LINE
- STREET CENTERLINE
- BACK OF CURB LINE
- 5/8" REBAR AND AL. CAP STAMPED "VTN PLS 11449" WITH REFERENCE MONUMENTS IN TOP BACK OF CURB
- REFERENCE MONUMENTS STAMPED "VTN PLS 11449" IN TOP OF CURB (UNLESS OTHERWISE NOTED)
- FOUND MONUMENT AS DESCRIBED

SHEET 1 OF 5

CONSULTING ENGINEERS • PLANNERS • LAND SURVEYORS
2727 SOUTH RAINBOW BOULEVARD
LAS VEGAS, NEVADA 89102
(702) 873 - 7550 FAX (702) 362 - 2597

MONUMENTATION TIE MAP
FOR
ASTORIA AT TOWN CENTER NORTH - UNIT 1
(BOOK 119 OF PLATS, PAGE 45)
LOCATED IN A PORTION OF GOVERNMENT LOT 5 AND LOT 6
S. 17, T. 19 S., R. 60 E., M.D.M., CITY OF LAS VEGAS,
CLARK COUNTY, NEVADA

SCALE: 1" = 40'	W.O.# 6049	DATE 7/12/2011	SHEET	OF
FILE: 6049MTM	DRN. BY: JCB	REV.:	1	5
	CKD. BY:			

058-4833

Fmp 27433