


ASTORIA AT TOWN CENTER NORTH - UNIT 1 MONUMENTATION TIE MAP

(A COMMON INTEREST COMMUNITY)
BEING A SUBDIVISION OF A PORTION OF GOVERNMENT LOT 5 AND A PORTION OF GOVERNMENT LOT 6 OF SECTION 17,
TOWNSHIP 19 SOUTH, RANGE 60 EAST, M.D.M., CITY OF LAS VEGAS, CLARK COUNTY, NEVADA.

FOUND 2" BRASS CAP IN CONCRETE STAMPED "PLS 15348"
WITH PLS 15348 REFERENCE MONUMENTS IN TOP BACK OF CURB

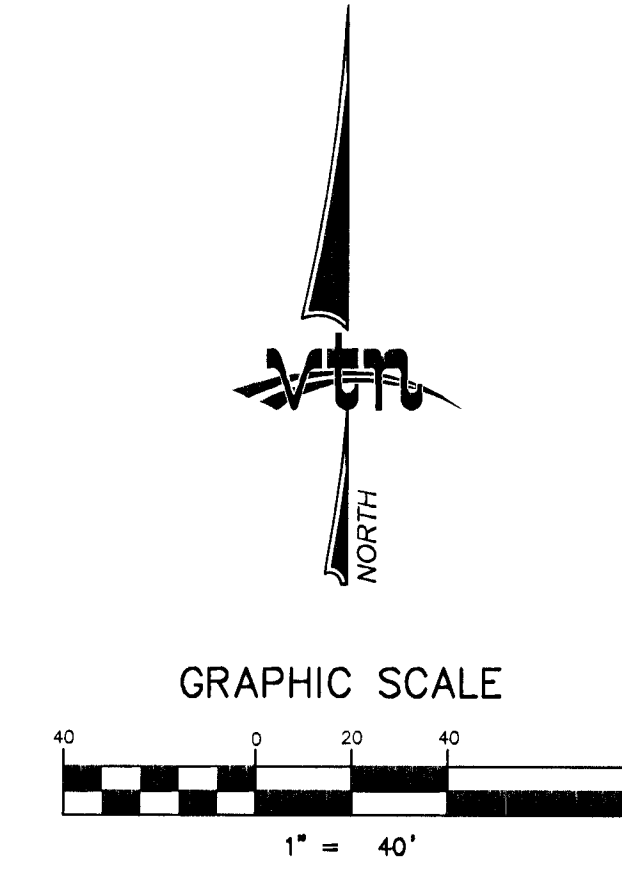

MATCHLINE SEE SHEET 3 OF 5

MATCHLINE SEE SHEET 1 OF 5

NOTES

SEE FINAL MAP FOR BEARING AND DISTANCES.
(BOOK 119, PAGE 45)

LEGEND

- 2 LOT NUMBER
- BLOCK NUMBER
- RIGHT OF WAY
- LOT LINES
- SUBDIVISION BOUNDARY LINE
- STREET CENTERLINE
- BACK OF CURB LINE
- 5/8" REBAR AND AL. CAP STAMPED "VTN PLS 11449"
WITH REFERENCE MONUMENTS IN TOP BACK OF CURB
- REFERENCE MONUMENTS STAMPED "VTN PLS 11449"
IN TOP OF CURB (UNLESS OTHERWISE NOTED)
- FOUND MONUMENT AS DESCRIBED

SHEET 2 OF 5

CONSULTING ENGINEERS • PLANNERS • LAND SURVEYORS 2727 SOUTH RAINBOW BOULEVARD LAS VEGAS, NEVADA 89102 (702) 873 - 7550 FAX (702) 362 - 2597				
MONUMENTATION TIE MAP FOR ASTORIA AT TOWN CENTER NORTH - UNIT 1 (BOOK 119 OF PLATS, PAGE 45) LOCATED IN A PORTION OF GOVERNMENT LOT 5 AND LOT 6 S. 17, T. 19 S., R. 60 E., M.D.M., CITY OF LAS VEGAS, CLARK COUNTY, NEVADA				
SCALE: 1" = 40'	W.O.# 6049	DATE: 7/12/2011	SHEET	OF
FILE: 6049MTM	DRN. BY: JCB	REV.:	2	5
	CKD. BY:			

127491